


NOTE:
1. PROVIDE PERMITS FROM TxDOT FOR 140R&K IN THE STATE R.O.W.

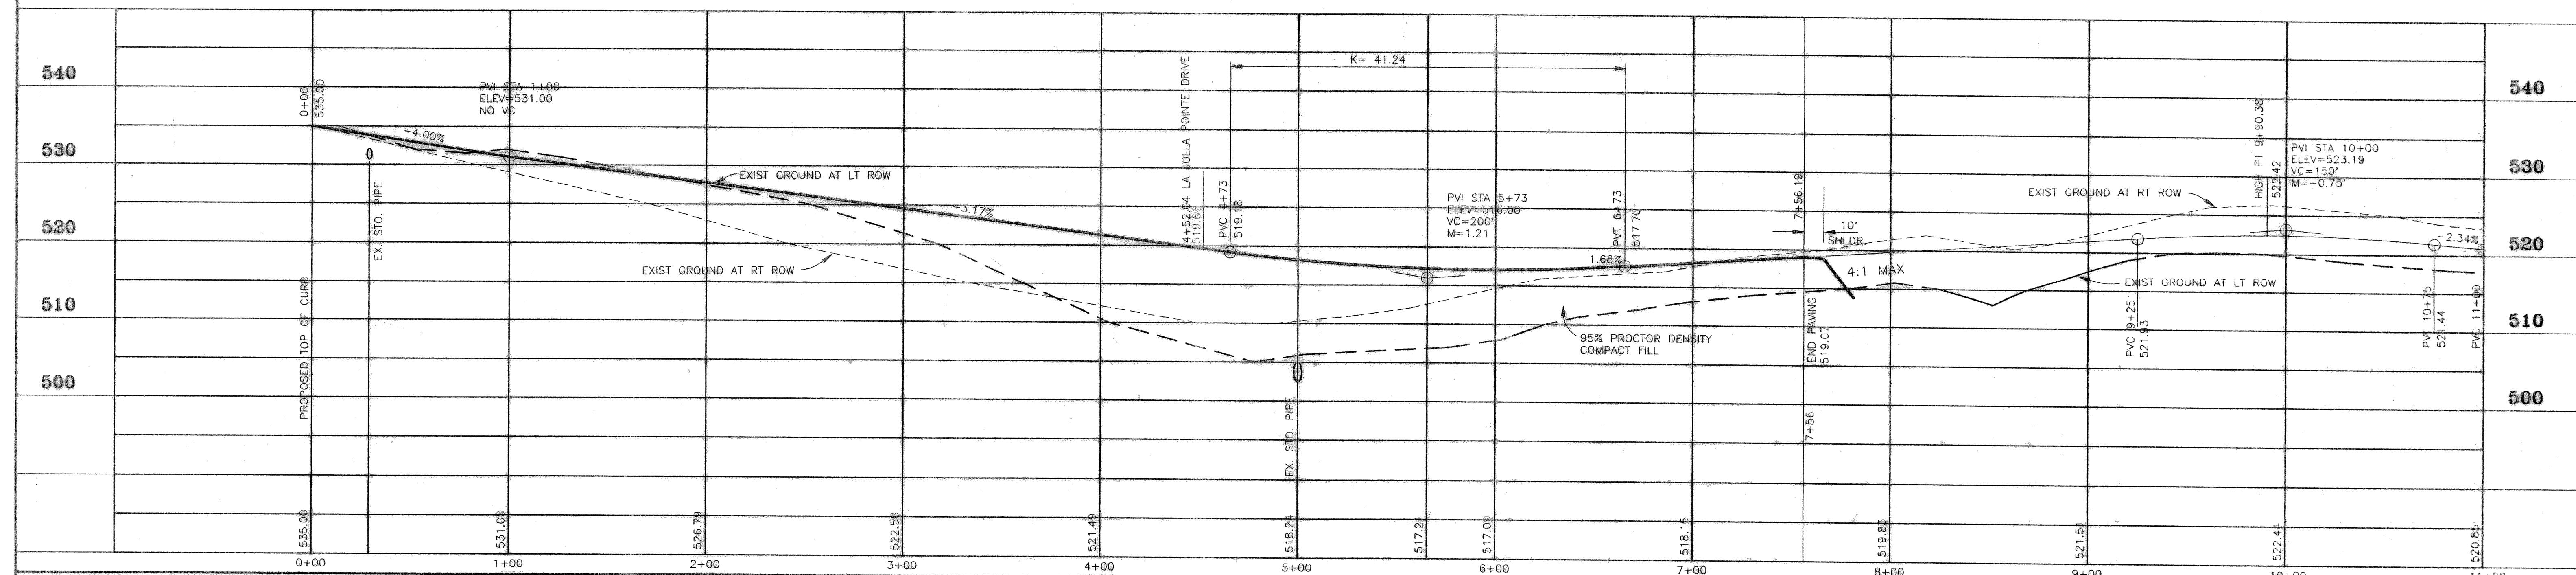


BENCH MARK(S) :
EXISTING SQUARE CUT ON TOP OF WEST CURB OF LAKESIDE DRIVE LOCATED APPROXIMATELY 120 FEET NORTH OF RAILROAD, AT THE NORTHWEST CORNER. ELEV=506.23

LEGEND :

PROP. STM. SWR.	RIGHT-OF-WAY	PROP. FIRE HYDRANT	EXIST. FIRE HYDRANT
EX. STM. SWR.	LOT LINE	PROP. GATE VALVE	EXIST. GATE VALVE
PROP. SAN. SWR.	DITCH FLOWLINE	PROP. MANHOLE	EXIST. MANHOLE
EX. SAN. SWR.	EX. GAS	POWER POLE	CLEANOUT
PROP. WATER	EX. BURIED TELEPHONE	CUT WIRE	WATER METER
EX. WATER	EX. BURIED ELECTRICAL	PHONE BOX	GAS METER
FENCE		ROW-MARKER	ROAD SIGN
		IRON PIN	BENCHMARK
		TRAVERSE POINT	TREE
		MALIBOX	

REVISIONS

REV. NO.	DESCRIPTION	DATE	DRWN. BY

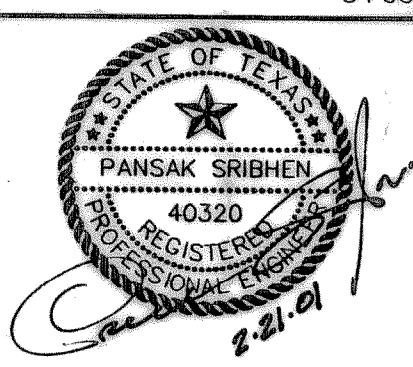

ASA ENGINEERING
17819 DAVENPORT RD., SUITE 215
DALLAS, TEXAS 75252
(972) 248-9651 FAX (972) 248-9681

**CITY OF ROCKWALL, TEXAS
LA JOLLA POINTE ADDITION**

**CATALINA DRIVE
PAVING AND DRAINAGE IMPROVEMENTS**

DESIGN	DRAWN	DATE	SCALE	PROJ. No	SHEET No.
PSA	MIR	2-21-01	1"=40' H 1"=10' V	2001.LJP	P-1

C:\2000\2001\LJD\02-21-02\1-1.dwg Mid Feb 21 10:42:20 2001 MIRALLI
HP DesignPlot 1000C Hewlett-Packard HP-GL/2 Device, ADI 4.3 (V4.1) - JUL 22 1998