

APPROVED FOR CONSTRUCTION
 OCT 3 2000
 City of Rockwall Engineering Dept.
 City Engineer: _____


BENCH MARK(S) :
 EXISTING SQUARE CUT ON TOP OF WEST CURB OF LAKESIDE DRIVE LOCATED APPROXIMATELY 120 FEET NORTH OF RAILROAD, AT THE NORTHWEST CORNER. ELLV=506.23

LEGEND :

PROP. STM. SWR.	RIGHT-OF-WAY	PROP. FIRE HYDRANT
EX. STM. SWR.	LOT LINE	PROP. GATE VALVE
PROP. SAN. SWR.	DITCH FLOWLINE	PROP. MANHOLE
EX. SAN. SWR.	EX. GAS	POWER POLE
PROP. WATER	EX. BURIED TELEPHONE	CLY WIRE
EX. WATER	EX. BURIED ELECTRICAL	PHONE BOX
FENCE		ROW-MARKER
		IRON PIN
		TRAVERSE POINT
		MAILBOX
		EXIST. FIRE HYDRANT
		EXIST. GATE VALVE
		EXIST. MANHOLE
		CLEANOUT
		WATER METER
		GAS METER
		ROAD SIGN
		BENCHMARK
		TREE

REVISIONS

REV. NO.	DESCRIPTION	DATE	DRAWN

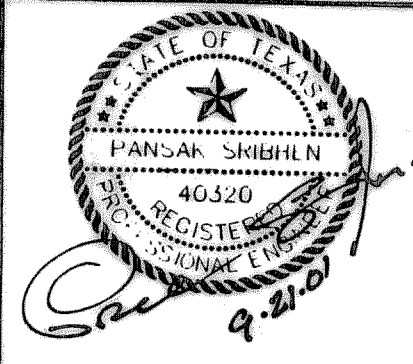

ASA ENGINEERING
 17819 DAVENPORT RD, SUITE 215
 DALLAS, TEXAS 75252
 (972) 248-9651 FAX (972) 248-9681

CITY OF ROCKWALL, TEXAS
LA JOLLA POINTE ADDITION
LAGUNA DRIVE
PAVING AND DRAINAGE IMPROVEMENTS

DESIGN	DRAWN	DATE	SCALE	PROJ. No.	SHEET No.
PSA	MIR	9-21-00	1"=40' H 1"=10' V	2001.LJP	P-3