



Record Drawing
 These plans have been revised
 to reflect changes as
 indicated by construction records
 11-16-06 RDC

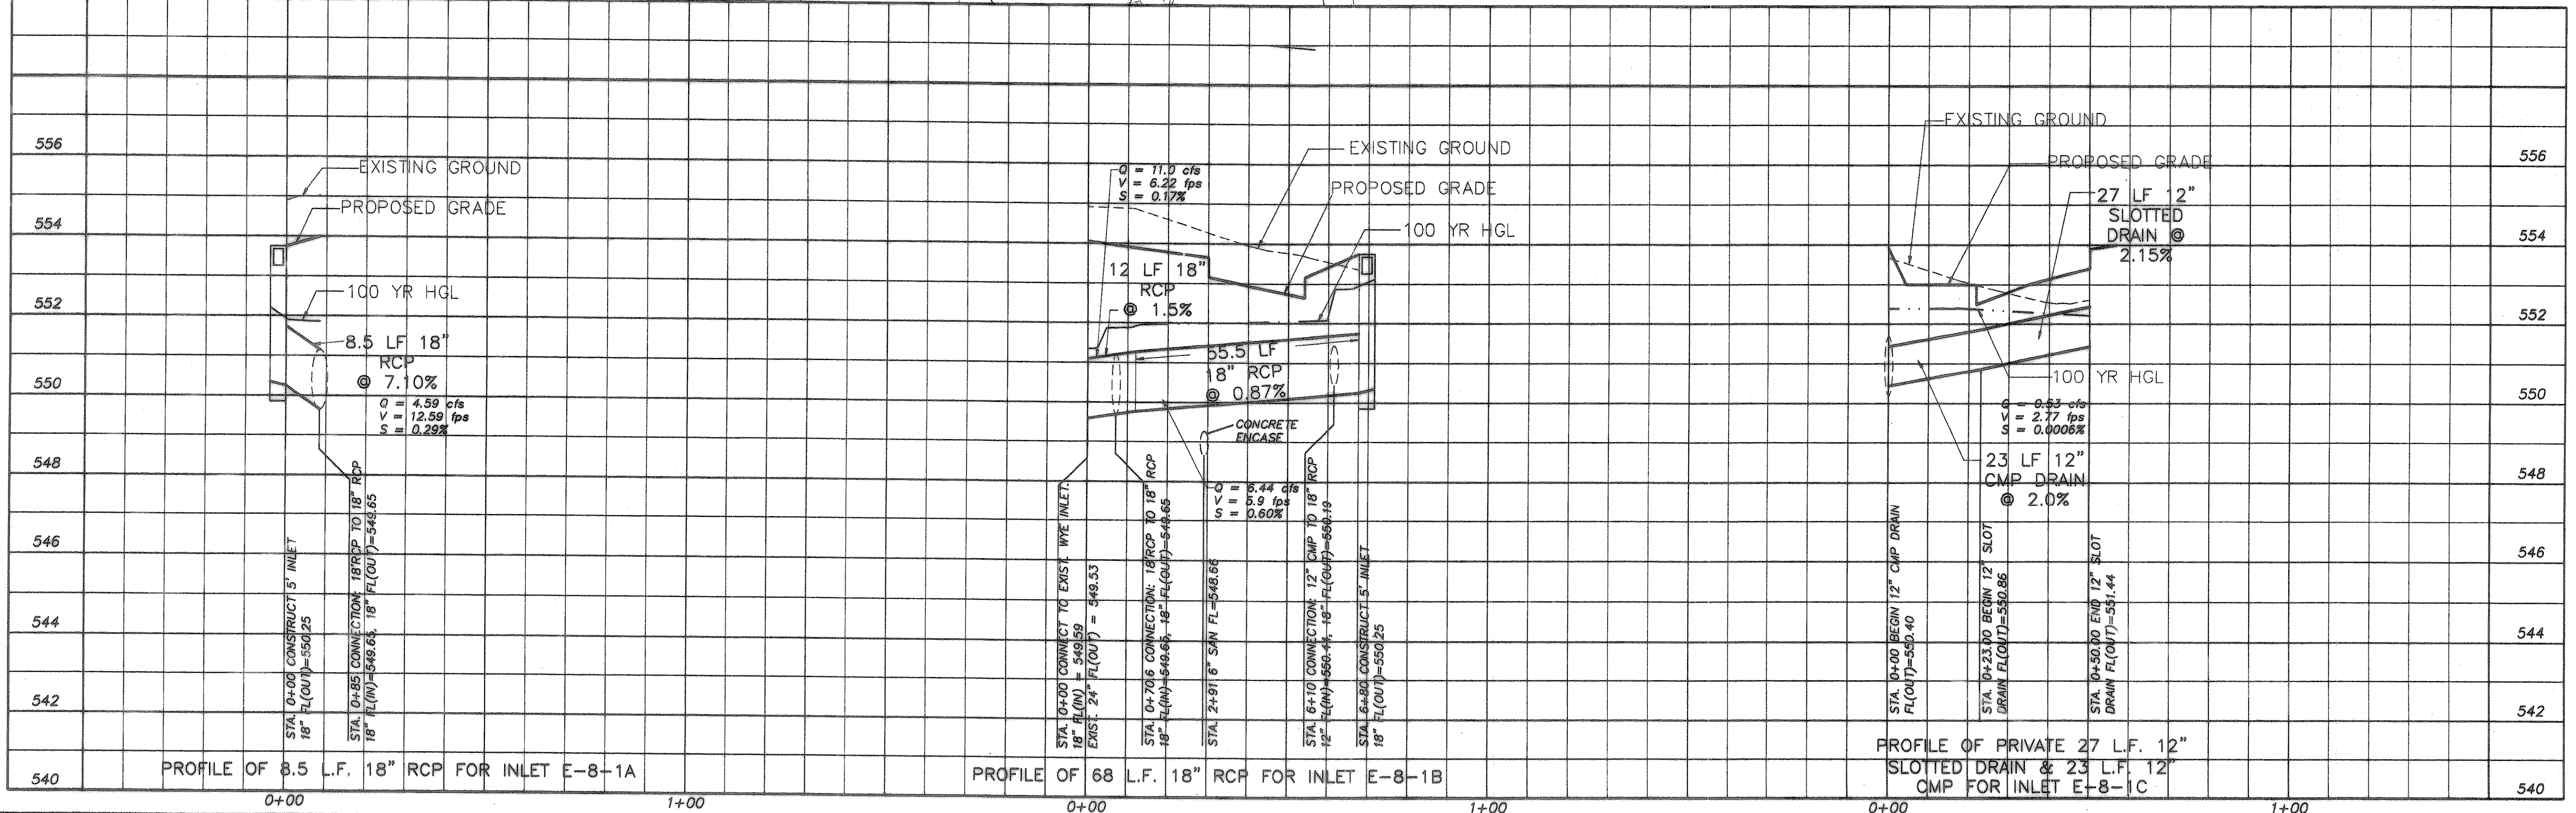

REV	DATE	BY	DESCRIPTION

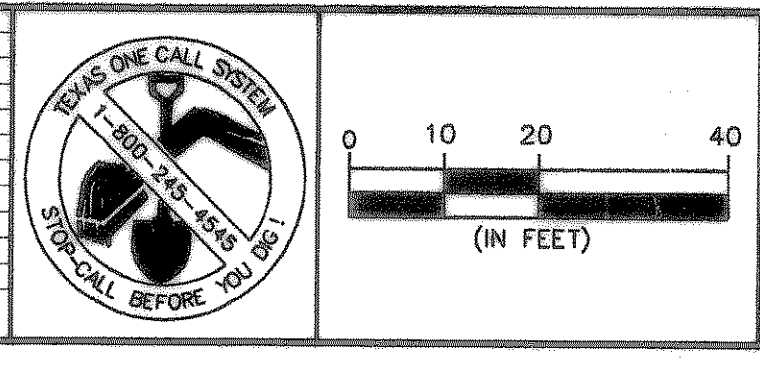

DESIGNED: X
 DRAWING: X
 CHECKED: X

THE SEAL APPEARING ON THIS DOCUMENT WAS AUTHORIZED BY
 ROBERT DANIEL CALDERON
 ON THE DATE SHOWN ON THE DRAFTER'S
 ALTERATION OF A SEALED DOCUMENT WITHOUT PROPER NOTIFICATION TO THE RESPONSIBLE
 ENGINEER IS AN OFFENSE UNDER THE TEXAS ENGINEERING PRACTICE ACT

5-24-06 RDC

ENGINEERS ARCHITECTS
 SURVEYORS PLANNERS
THE WALLACE GROUP INC.

LA MADELINE RESTAURANT
 ROCKWALL CROSSING
STORM DRAINAGE PLAN & PROFILES

SHEET
 C-5.1
 OF 15 SHEETS