

BM: CITY OF ROCKWALL CONTROL MONUMENT "COR-1" CALLED ELEV. 523.27.
MEASURED ELEV. = 523.56

BM: CITY OF ROCKWALL CONTROL MONUMENT "COR-2" CALLED ELEV. 529.10.
MEASURED ELEV. = 529.37

GENERAL NOTES

1. ALL RESPONSIBILITIES FOR ADEQUACY OF DESIGN REMAINS WITH THE DESIGN ENGINEER. THE CITY OF ROCKWALL, IN REVIEWING AND RELEASING PLANS FOR CONSTRUCTION, ASSUMES NO RESPONSIBILITY FOR ADEQUACY OR ACCURACY OF DESIGN.
2. RETAINING WALL OVER 3' IN HEIGHT (INCLUDING THE FOOTING) MUST BE DESIGNED BY A LICENSED STRUCTURAL ENGINEER.
3. STRUCTURAL ENGINEER TO PROVIDE DETAIL DESIGN DRAWINGS TO THE CITY FOR REVIEW. CONTRACTOR SHALL NOT BEGIN RETAINING WALL CONSTRUCTION UNTIL CITY'S APPROVAL OF DESIGN.
4. PRIOR TO ACCEPTANCE STRUCTURAL ENGINEER IS TO PROVIDE VERIFICATION LETTER TO CITY FOR RETAINING WALLS.
5. STRUCTURAL ENGINEER TO PROVIDE DESIGN SHEETS FOR INCLUSION IN AS-BUILTS.
6. ALL WALLS TO BE STONE, ROCK, OR OTHER KIND OF MASONRY. NO SMOOTH WALLS ALLOWED.
7. ALL CITY R.O.W. TO BE SODDED PRIOR TO ACCEPTANCE.
8. CONTRACTOR TO PROVIDE A DETAILED DOWNSPOUT PLAN AT TIME OF BUILDING PERMIT SHOWING THE ROOF DRAINS TYING INTO POP-UP EMITTER EITHER AT THE FRONT OR BACK OF HOUSE. PER THE PROPOSED DRAINAGE AREA MAP.
9. FOR MORE INFORMATION ON THE CROSS SECTIONS FOR THE ULTIMATE 100 YR FLOODPLAIN REFER TO "HYDROLOGIC AND HYDRAULIC STUDY IN SUPPORT OF LADERA ROCKWALL DEVELOPMENT" PREPARED BY JEA-HYDROTECH ENGINEERING, INC.

AS-BUILT RECORD DRAWING


TO THE BEST OF OUR KNOWLEDGE, THE JOHN R. MCADAMS COMPANY, INC. HEREBY STATES THAT THIS PLAN IS AS-BUILT. THIS INFORMATION PROVIDED IS BASED ON SURVEYING AT THE SITE AND INFORMATION PROVIDED BY THE CONTRACTOR.

MCADAMS,
Date: 5/2/2020

MCADAMS
The John R. McAdams Company, Inc.
111 Hillside Drive
Lewisville, Texas 75057
972.435.9712
201 Country View Drive
Rockwall, TX 75087
TBP# 19762 TBPUS: 10194440
www.mcadamsco.com

LADERA ROCKWALL PHASE 1
Lot 1, Block A & Lot 1, Block B
LADERA ROCKWALL
47.694 Acres
in the
M. JONES SURVEY, ABSTRACT NO. 122
CITY OF ROCKWALL
ROCKWALL COUNTY, TEXAS

OVERALL GRADING & RETAINING WALL PLAN (PHI-PHII)

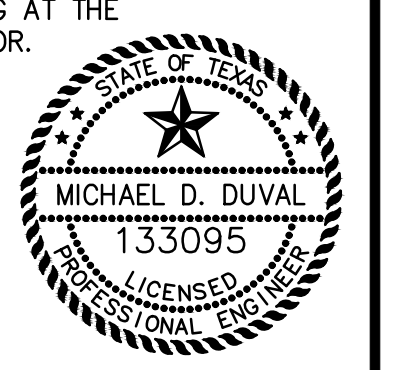

MCADAMS
TBP# 19762

Drawn By: MD
Date: 02/23/2018
Scale: 1"=80'
Revisions:
04/23/2018
07/16/2018
09/06/2018
01/28/2019
02/11/2019
03/11/2019 Signed
04/17/2019

17191

C24

OWNER/DEVELOPER
RW LADERA, LLC
361 W. BYRON NELSON BLVD, STE 104
ROANOKE, TX 76262
Ph. 817.430.3318
Contact: John Dellin

File: 2:2017(17191) (Overall Grading & Retaining Wall) (Overall Grading & Retaining Wall)
Printed: 6/7/2020 3:17 PM, by: mford