

0 60 120 180 Feet
SCALE: 1"=60'

BM: CITY OF ROCKWALL CONTROL MONUMENT "COR-1" CALLED ELEV. 523.27.
MEASURED ELEV. = 523.56

BM: CITY OF ROCKWALL CONTROL MONUMENT "COR-2" CALLED ELEV. 529.10.
MEASURED ELEV. = 529.37

GENERAL NOTES


1. ALL RESPONSIBILITIES FOR ADEQUACY OF DESIGN REMAINS WITH THE DESIGN ENGINEER. THE CITY OF ROCKWALL, IN REVIEWING AND RELEASING PLANS FOR CONSTRUCTION, ASSUMES NO RESPONSIBILITY FOR ADEQUACY OR ACCURACY OF DESIGN.
2. COMPACT FILL DIRT TO BE 95% STD PROCTOR IN 8" LIFTS.
3. REFER TO SHEET C35-C37 FOR MORE DETAIL INFORMATION ON PONDS.
4. RETAINING WALL OVER 3' IN HEIGHT (INCLUDING THE FOOTING) MUST BE DESIGNED BY A LICENSED STRUCTURAL ENGINEER.
5. STRUCTURAL ENGINEER TO PROVIDE DETAIL DESIGN DRAWINGS TO THE CITY FOR REVIEW. CONTRACTOR SHALL NOT BEGIN RETAINING WALL CONSTRUCTION UNTIL CITY'S APPROVAL OF DESIGN.
6. PRIOR TO ACCEPTANCE STRUCTURAL ENGINEER IS TO PROVIDE VERIFICATION LETTER TO CITY FOR RETAINING WALLS.
7. STRUCTURAL ENGINEER TO PROVIDE DESIGN SHEETS FOR INCLUSION IN AS-BUILTS.
8. ALL WALLS TO BE STONE, ROCK, OR OTHER KIND OF MASONRY. NO SMOOTH WALLS ALLOWED.
9. ALL CITY R.O.W. TO BE SODDED PRIOR TO ACCEPTANCE.
10. FOR MORE INFORMATION ON THE CROSS SECTIONS FOR THE ULTIMATE 100 YR FLOODPLAIN REFER TO "HYDROLOGIC AND HYDRAULIC STUDY IN SUPPORT OF LADERA ROCKWALL DEVELOPMENT" PREPARED BY JEA-HYDROTECH ENGINEERING, INC.
11. CONTRACTOR TO CONTACT NTMWD LINE LOCATES AT 469-626-4569 AT LEAST 72 HOURS PRIOR TO WORKING IN THE NTMWD EASEMENT.

**AS-BUILT
RECORD DRAWING**

TO THE BEST OF OUR KNOWLEDGE, THE JOHN R. MCADAMS COMPANY, INC. HEREBY STATES THAT THIS PLAN IS AS-BUILT. THIS INFORMATION PROVIDED IS BASED ON SURVEYING AT THE SITE AND INFORMATION PROVIDED BY THE CONTRACTOR.

MCADAMS,

Date: 5/21/2020

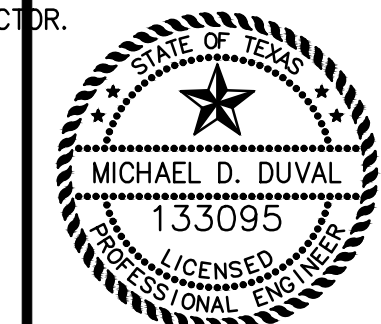

MCADAMS
TBPE: 19762

Drawn By: MD
Date: 02/23/2018
Scale: 1"=60'
Revisions:
04/23/2018
07/16/2018
09/06/2018
01/28/2019
02/11/2019
03/11/2019 Signed
03/25/2019

OWNER/DEVELOPER
RW LADERA, LLC.
361 W. BYRON NELSON BLVD, STE. 104
ROANOKE, TX 76262
Ph. 817.430.3318
Contact: John Dellin

17191

C28

LADERA ROCKWALL PHASE 1
Lot 1, Block A & Lot 1, Block B
LADERA ROCKWALL
47.694 Acres
in the

M. JONES SURVEY, ABSTRACT NO. 122
CITY OF ROCKWALL
ROCKWALL COUNTY, TEXAS

The John R. McAdams Company, Inc.
(DBA: G&A McAdams)
111 Hillside Drive
Levelland, TX 75041
972.436.9715
201 Country View Drive
Roanoke, Texas 76262
940.240.1012
TBPE: 19762 TBPLS: 10194440
www.mcadamsco.com

LADERA ROCKWALL PHASE 1

File: 2_20171710 (04/04/20) 014-504-0100a (Rev) (04/17/19) OFF (EP)
Printed: 5/21/2020 11:56 AM by: J. Miller, Sheet: 2/23/2019 5:52 PM by: mdellin