

NORTH REGIONAL DETENTION POND

Detention Computations for 5 yr Proposed Development						
City of Rockwall						
	Undeveloped	Developed	Bypass			
Area	A= 14.320 AC	13.120 AC	2.780			
Runoff Coefficient	C= 0.35	0.80	0.80			
Time of Concentration	Tc= 20.0 MIN	10.0 MIN	10.0			
Rainfall Intensity	I5= 4.90 IN/HR	6.70 IN/HR	6.10			
Peak Rate of Runoff	Q5= 24.6 CFS	64.0 CFS	13.6			
Allowable Outflow	Q5= 11.0 CFS	11.0 CFS				
Tc	I5	Q5	Inflow	Outflow	Storage	Required
MIN	IN/HR	CFS	CF	CF	CF	AC-FT
5	7.00	73.5	22,042	4,947	17,095	0.392
10	6.10	64.0	38,415	6,595	31,820	0.730
15	5.50	57.7	51,955	8,244	43,711	1.003
20	4.90	51.4	61,716	9,893	51,823	1.190
30	4.10	43.0	77,460	13,191	64,270	1.475
40	3.40	35.7	85,647	16,489	69,159	1.588
50	2.80	29.4	88,166	19,786	68,380	1.570
60	2.60	27.3	98,243	23,084	75,159	1.725
90	2.10	22.0	119,025	32,977	86,047	1.975
100	1.90	19.9	119,654	36,275	83,379	1.914
110	1.80	18.9	124,692	39,573	85,120	1.954
120	1.60	16.8	120,914	42,870	78,044	1.792

Detention Computations for 25 yr Proposed Development						
City of Rockwall						
	Undeveloped	Developed	Bypass			
Area	A= 14.320 AC	13.120 AC	2.780			
Runoff Coefficient	C= 0.35	0.80	0.80			
Time of Concentration	Tc= 20.0 MIN	10.0 MIN	10.0			
Rainfall Intensity	I25= 6.60 IN/HR	8.30 IN/HR	8.30			
Peak Rate of Runoff	Q25= 33.1 CFS	87.1 CFS	18.5			
Allowable Outflow	Q25= 14.6 CFS	14.6 CFS				
Tc	I25	Q25	Inflow	Outflow	Storage	Required
MIN	IN/HR	CFS	CF	CF	CF	AC-FT
5	9.30	97.6	29,284	6,579	22,705	0.521
10	8.30	87.1	52,270	8,772	43,498	0.999
15	7.50	78.7	70,848	10,965	59,883	1.375
20	6.60	69.3	83,128	13,158	69,970	1.606
30	5.50	57.7	103,910	17,544	86,366	1.983
40	4.60	48.3	115,876	21,930	93,946	2.157
50	4.00	42.0	125,952	26,316	99,636	2.287
60	3.50	36.7	132,250	30,702	101,548	2.331
90	2.90	30.4	164,367	43,860	120,507	2.766
100	2.70	28.3	170,035	48,246	121,789	2.796
110	2.50	26.2	173,184	52,632	120,552	2.767
120	2.20	23.1	166,257	57,018	109,239	2.508

Detention Computations for 100 yr Proposed Development						
City of Rockwall						
	Undeveloped	Developed	Bypass			
Area	A= 14.320 AC	13.120 AC	2.780			
Runoff Coefficient	C= 0.35	0.80	0.80			
Time of Concentration	Tc= 20.0 MIN	10.0 MIN	10.0			
Rainfall Intensity	I100= 8.30 IN/HR	9.80 IN/HR	9.80			
Peak Rate of Runoff	Q100= 41.6 CFS	102.9 CFS	21.8			
Allowable Outflow	Q100= 19.8 CFS	19.8 CFS				
Tc	I100	Q100	Inflow	Outflow	Storage	Required
MIN	IN/HR	CFS	CF	CF	CF	AC-FT
5	10.70	112.3	33,692	8,912	24,780	0.569
10	9.80	102.9	61,716	11,883	49,834	1.144
15	9.00	94.5	85,018	14,853	70,164	1.611
20	8.30	87.1	104,540	17,824	86,716	1.991
30	6.90	72.4	130,360	23,765	106,595	2.447
40	5.80	60.9	146,104	29,707	116,398	2.672
50	5.00	52.5	157,440	35,648	121,792	2.796
60	4.50	47.2	170,035	41,589	128,446	2.949
90	3.50	36.7	198,374	59,413	138,961	3.190
100	3.40	35.7	214,118	65,355	148,764	3.415
110	3.20	33.6	221,676	71,296	150,380	3.452
120	2.70	28.3	204,042	77,237	126,805	2.911

Detention Computations for 10 yr Proposed Development						
City of Rockwall						
	Undeveloped	Developed	Bypass			
Area	A= 14.320 AC	13.120 AC	2.780			
Runoff Coefficient	C= 0.35	0.80	0.80			
Time of Concentration	Tc= 20.0 MIN	10.0 MIN	10.0			
Rainfall Intensity	I10= 5.90 IN/HR	7.70 IN/HR	7.10			
Peak Rate of Runoff	Q10= 29.6 CFS	74.5 CFS	15.8			
Allowable Outflow	Q10= 13.8 CFS	13.8 CFS				
Tc	I10	Q10	Inflow	Outflow	Storage	Required
MIN	IN/HR	CFS	CF	CF	CF	AC-FT
5	8.30	87.1	26,135	6,201	19,934	0.458
10	7.10	74.5	44,713	8,268	36,445	0.837
15	6.50	68.2	61,402	10,335	51,066	1.172
20	5.90	61.9	74,312	12,402	61,909	1.421
30	4.80	50.4	90,685	16,536	74,149	1.702
40	4.00	42.0	100,762	20,671	80,091	1.839
50	3.50	36.7	110,208	24,805	85,403	1.961
60	3.00	31.5	113,357	28,939	84,418	1.938
90	2.50	26.2	141,696	41,341	100,355	2.304
100	2.40	25.2	151,142	45,475	105,667	2.426
110	2.30	24.1	159,329	49,609	109,720	2.519
120	1.70	17.8	128,471	53,744	74,727	1.616

Detention Computations for 50 yr Proposed Development						
City of Rockwall						
	Undeveloped	Developed	Bypass			
Area	A= 14.320 AC	13.120 AC	2.780			
Runoff Coefficient	C= 0.35	0.80	0.80			
Time of Concentration	Tc= 20.0 MIN	10.0 MIN	10.0			
Rainfall Intensity	I50= 7.50 IN/HR	9.00 IN/HR	9.00			
Peak Rate of Runoff	Q50= 37.6 CFS	94.5 CFS	20.0			
Allowable Outflow	Q50= 17.6 CFS	17.6 CFS				
Tc	I50	Q50	Inflow	Outflow	Storage	Required
MIN	IN/HR	CFS	CF	CF	CF	AC-FT
5	10.00	105.0	31,488	7,908	23,580	0.541
10	9.00	94.5	56,678	10,544	46,134	1.059
15	8.10	85.0	76,516	13,181	63,335	1.454
20	7.50	78.7	94,464	15,817	78,647	1.805
30	6.10	64.0	115,246	21,089	94,157	2.162
40	5.20	54.6	130,990	26,361	104,629	2.402
50	4.50	47.2	141,696	31,633	110,063	2.527
60	3.90	40.9	147,364	36,905	110,458	2.536
90	3.30	34.6	187,039	52,722	134,317	3.083
100	3.00	31.5	188,928	57,994	130,934	3.006
110	2.90	30.4	200,893	63,266	137,627	3.159
120	2.40	25.2	181,371	68,539	112,832	2.590

Rockwall, Texas				
Overall Detention Computations for Ladera RW North Pond 17191				
	Undeveloped	Developed	Bypass	
Area	A(ac)= 14.320	13.120	2.780	
Runoff Coefficient	C= 0.350	0.800	0.800	
Time of Concentration	Tc(min)= 20.0	10.0	10.0	


STORM YEAR	I IN/HR	Qundev CFS	I IN/HR	Qin CFS	Qbypass CFS	Qout CFS	REQUIRED AC-FT	REQUIRED CF
5	4.90	24.6	6.70	64.0	13.6	1.9754	86047.44	86047.44
10	5.90	29.6	7.70	74.5	15.8	2.5188	109719.84	109719.84
25	6.60	33.1	8.30	87.1	18.5	2.7959	121789.20	121789.20
50	7.50	37.6	9.00	94.5	20.0	3.1595	137627.04	137627.04
100	8.30	41.6	9.80	102.9	21.8	3.4522	150379.68	150379.68

* THE UNDEVELOPED ACREAGE IS BASED ON EXISTING DRAINAGE AREAS A1 & D1, REFER TO SHEET C32

** THE DEVELOPED ACREAGE BASED ON THE PROPOSED DRAINAGE AREAS A1-A12 WITH THE BYPASS ACREAGE BASED ON E1 & E6 REFER TO SHEET C33


North Pond Storage Summary

Year	Ex. Q** (cfs)	Allowed Q* (cfs)	Pond Elev. (ft.)	Outlet Elev. (ft.)	Q Released (cfs.)	Storage (cf.)
5	24.60	11.00	504.46	499.20	11.00	99,835
10	29.60	13.80	504.99	499.20	13.80	117,545
25	33.10	14.60	505.13	499.20	14.60	122,405
50	37.60	17.60	505.65	499.20	17.60	141,115
100	41.60	19.80	506.02	499.20	19.80	155,060

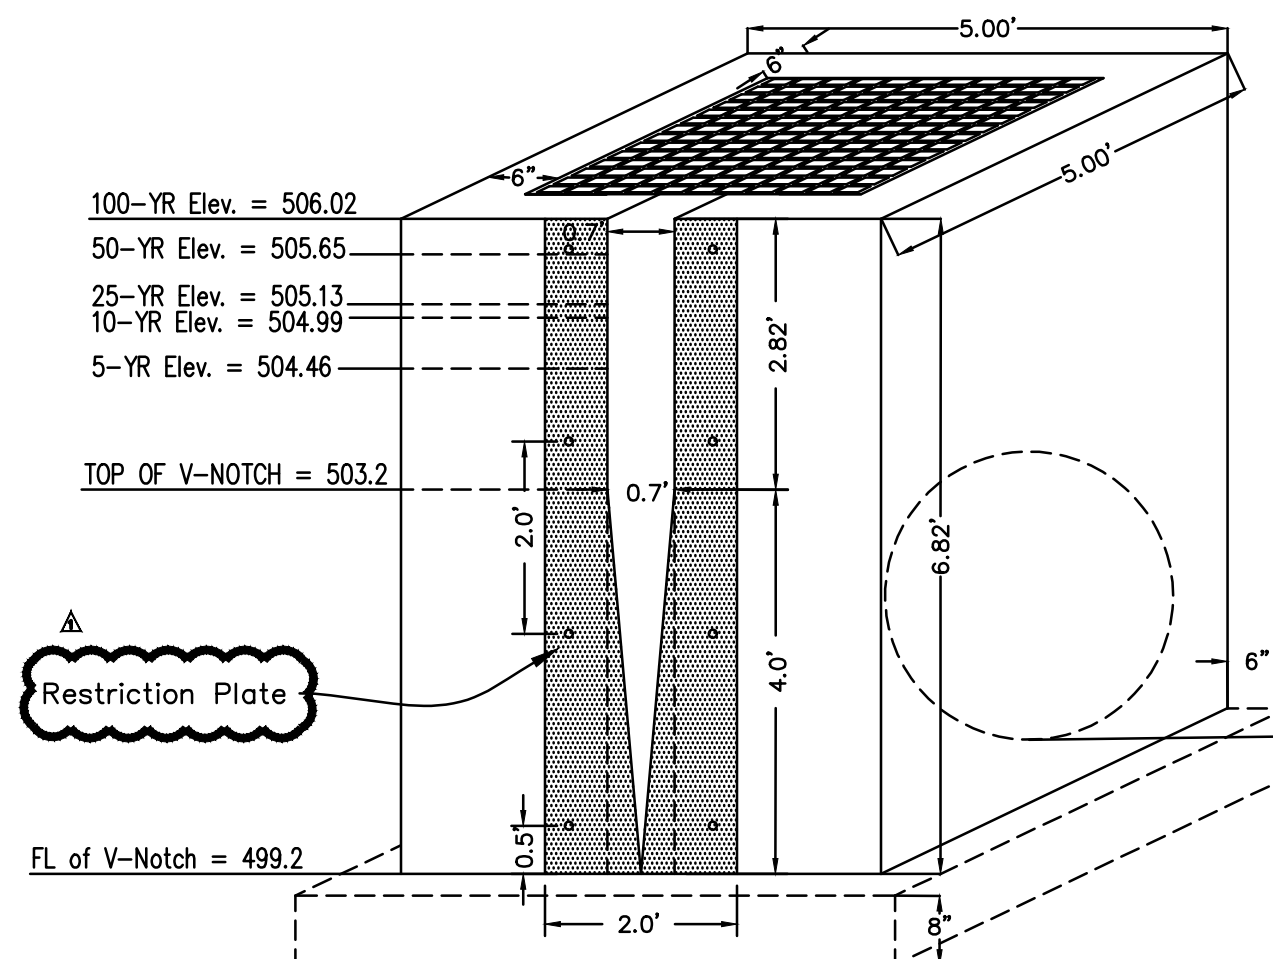

Detail of Proposed North Detention Pond Structure (N.T.S.)

- Notes:
- 4,200 psi conc. w/ #4 bars 12" O.C.E.W. min 7.0 sack mix
 - The sides and front of the outlet structure is to be clad in stone.
 - Outlet pipe to be a 36" RCP FL=499.20
 - Openings are to be field cored or factory furnished
 - V-Notch Restriction Plate to be 1/2" thick steel plate, affixed to the outlet structure with 1/2" stainless steel bolts drilled & epoxied into place.

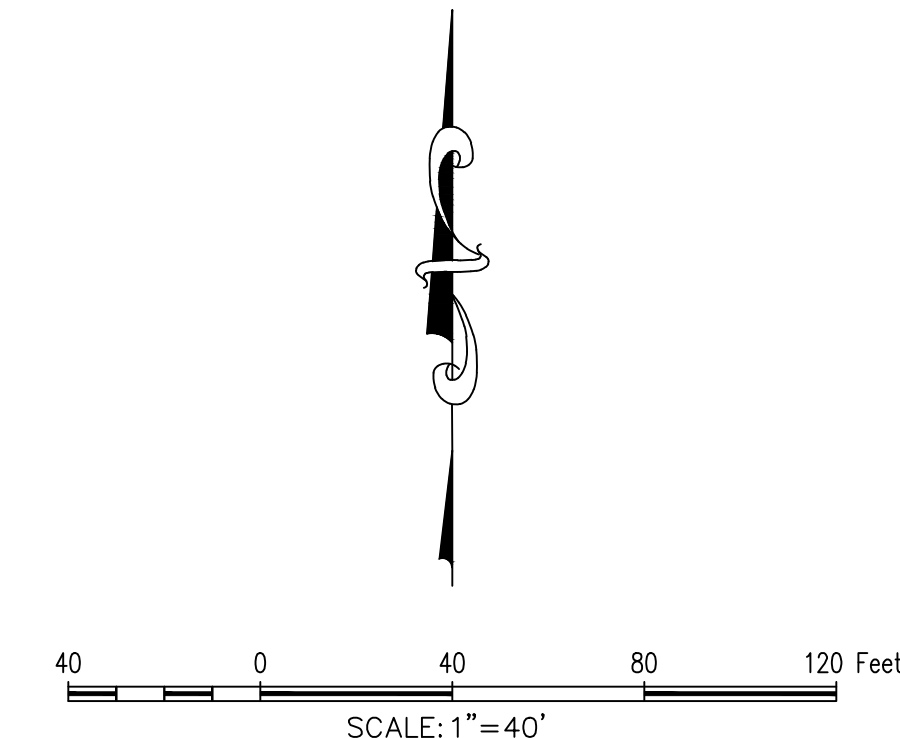


BM: CITY OF ROCKWALL CONTROL MONUMENT "COR-1" CALLED ELEV. 523.27. MEASURED ELEV. = 523.56

BM: CITY OF ROCKWALL CONTROL MONUMENT "COR-2" CALLED ELEV. 529.10. MEASURED ELEV. = 529.37

GENERAL NOTES

- ALL RESPONSIBILITIES FOR ADEQUACY OF DESIGN REMAINS WITH THE DESIGN ENGINEER. THE CITY OF ROCKWALL, IN REVIEWING AND RELEASING PLANS FOR CONSTRUCTION, ASSUMES NO RESPONSIBILITY FOR ADEQUACY OR ACCURACY OF DESIGN.
- REGIONAL DETENTION PONDS SIZED FOR RESIDENTIAL DEVELOPMENT, WILL NEED TO BE RESIZED FOR FUTURE COMMERCIAL DEVELOPMENT.
- FOR MORE INFORMATION ON THE CROSS SECTIONS FOR THE ULTIMATE 100 YR FLOODPLAIN REFER TO "HYDROLOGIC AND HYDRAULIC STUDY IN SUPPORT OF LADERA ROCKWALL DEVELOPMENT" PREPARED BY JEA-HYDROTECH ENGINEERING, INC.

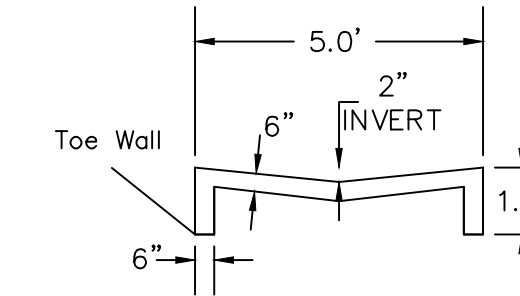

5' PILOT FLUME DETAIL (N.T.S.)

LENGTH = 155 FT
WIDTH = 5 FT
6" 3000 PSI CONCRETE (6.5 SACK MIX)
W/ #3 REBAR 18" O.C.E.W. & 12" TOE WALLS

AS-BUILT RECORD DRAWING

TO THE BEST OF OUR KNOWLEDGE, THE JOHN R. MCADAMS COMPANY, INC. HEREBY STATES THAT THIS PLAN IS AS-BUILT. THIS INFORMATION PROVIDED IS BASED ON SURVEYING AT THE SITE AND INFORMATION PROVIDED BY THE CONTRACTOR.

MCADAMS, *Michael D. Duval*
Date: *5/2/2020*

The John R. McAdams Company, Inc.
111 Hillside Drive
Lewisville, Texas 75057
972.436.9712
201 Country View Drive
Rockwall, Texas 75087
940.240.1012
TBP# 19762 TBP#S: 10194440
www.mcadamsco.com

MCADAMS

LADERA ROCKWALL PHASE 1

LADERA ROCKWALL PHASE 1
Lot 1, Block A & Lot 1, Block B
LADERA ROCKWALL
47,694 Acres
in the
M. JONES SURVEY, ABSTRACT NO. 122
CITY OF ROCKWALL
ROCKWALL COUNTY, TEXAS

DETENTION CALCULATIONS

AS-BUILT RECORD DRAWING

TO THE BEST OF OUR KNOWLEDGE, THE JOHN R. MCADAMS COMPANY, INC. HEREBY STATES THAT THIS PLAN IS AS-BUILT. THIS INFORMATION PROVIDED IS BASED ON SURVEYING AT THE SITE AND INFORMATION PROVIDED BY THE CONTRACTOR.

MCADAMS, *Michael D. Duval*
Date: *5/2/2020*

STATE OF TEXAS
MICHAEL D. DUVAL
133095
LICENSED PROFESSIONAL ENGINEER

MCADAMS
TBP# 19762

Drawn By: MD
Date: 02/23/2018
Scale: 1"=40'
Revisions:
04/23/2018
07/16/2018
09/06/2018
01/28/2019
02/11/2019
03/11/2019 Signed
04/17/2019

17191

OWNER/DEVELOPER
RW LADERA, LLC.
361 W. BYRON NELSON BLVD, STE 104
ROANOK, TX 76282
Ph. 817.430.3318
Contact: John Dellin

C35