



File: 2_2019\17191\17191.dwg Date: 02/23/2018 10:00:00 AM
 Plotted: 5/2/2020 9:23 AM by Plotter: Sewer 2/26/2019 2:18 PM by dca

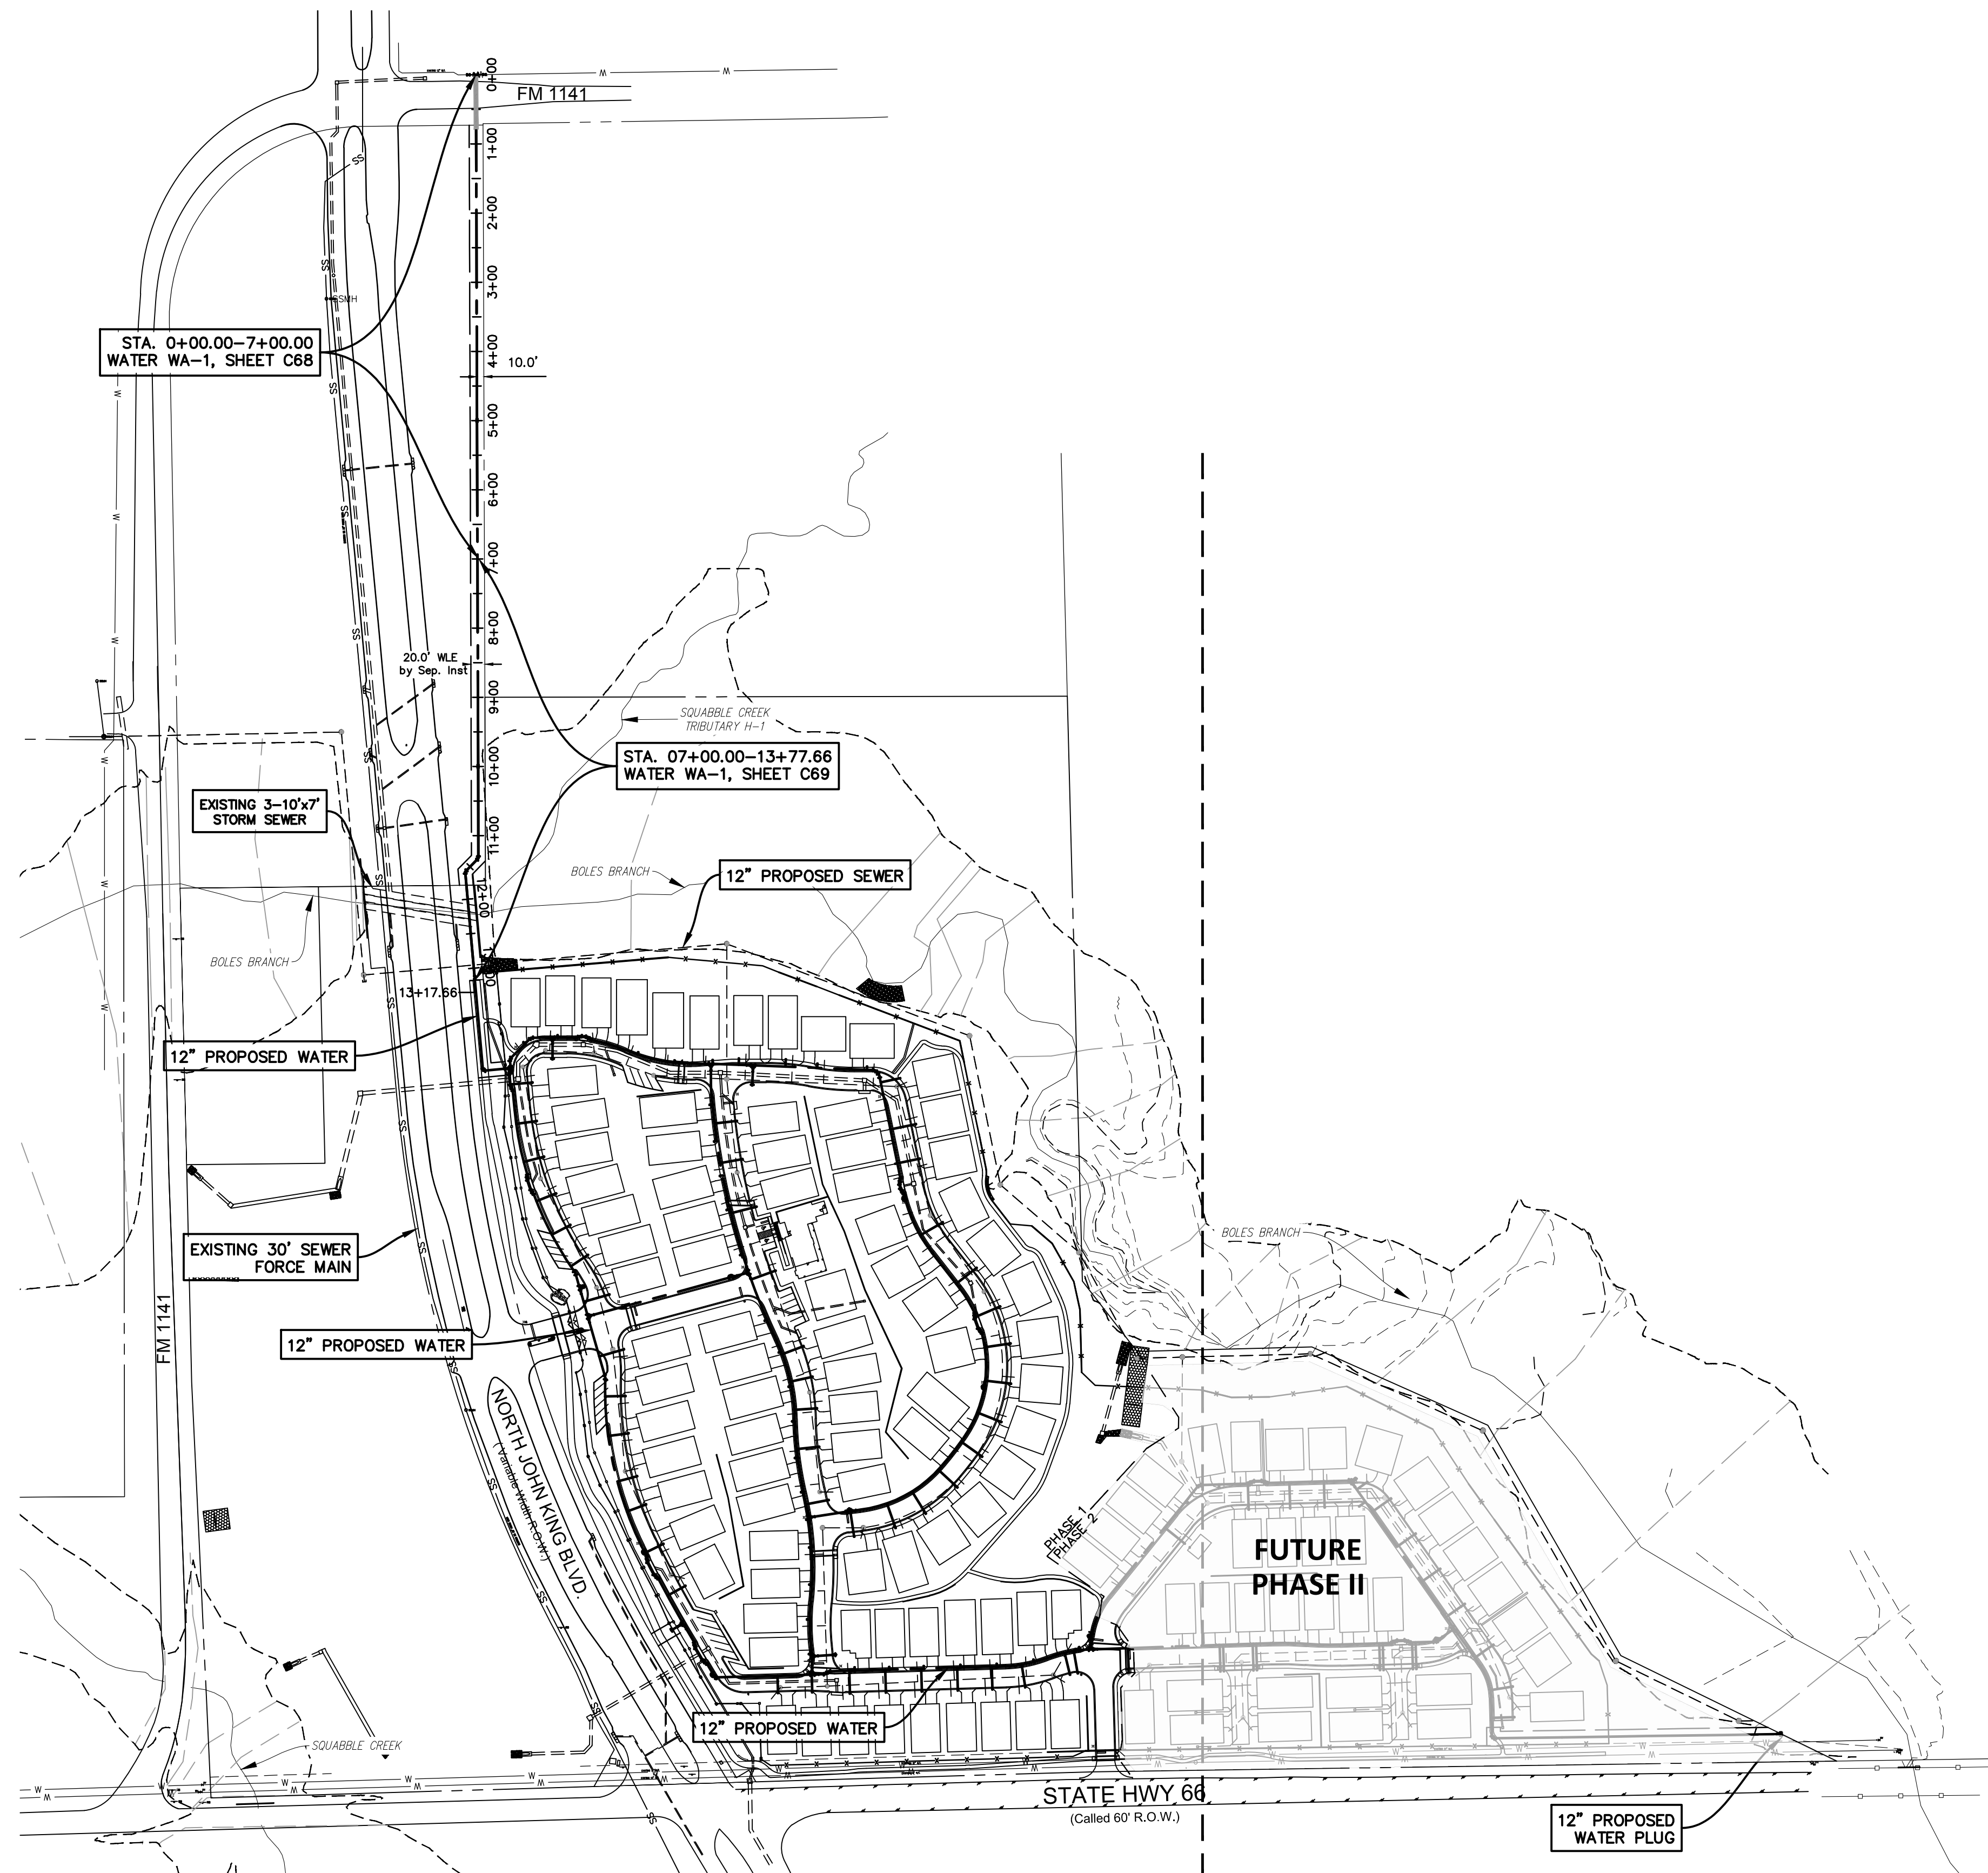

WATER
 SCALE 1"= 150'

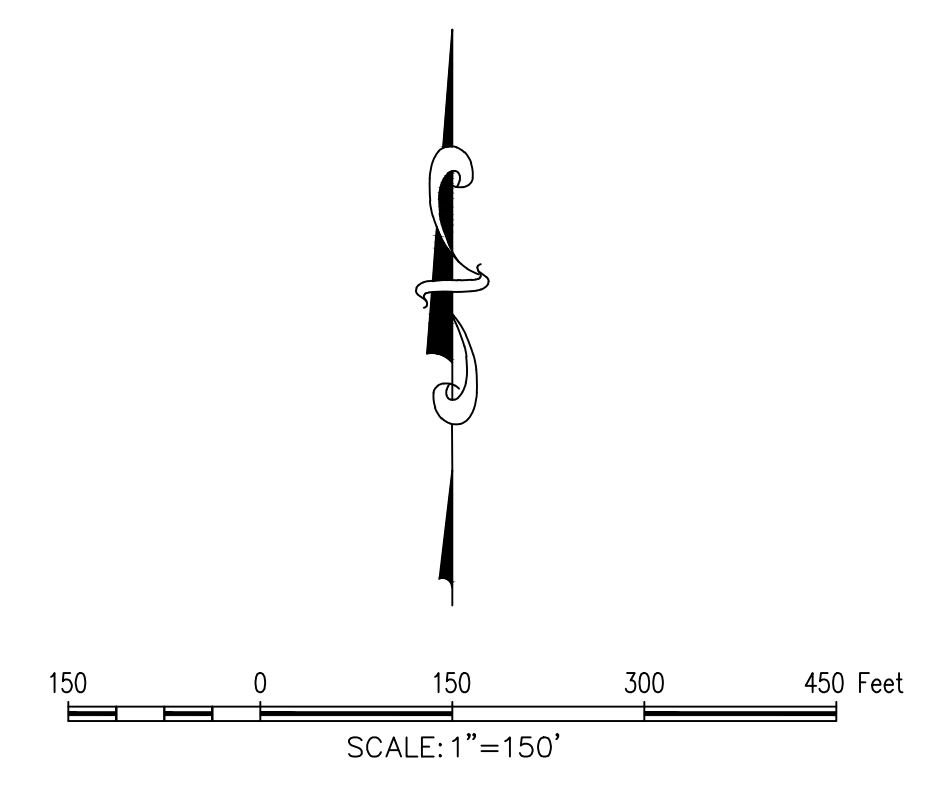

BM: CITY OF ROCKWALL CONTROL MONUMENT "COR-1" CALLED ELEV. 523.27.
 MEASURED ELEV. = 523.56
 BM: CITY OF ROCKWALL CONTROL MONUMENT "COR-2" CALLED ELEV. 529.10.
 MEASURED ELEV. = 529.37

GENERAL NOTES
 1. ALL RESPONSIBILITIES FOR ADEQUACY OF DESIGN REMAINS WITH THE DESIGN ENGINEER. THE CITY OF ROCKWALL, IN REVIEWING AND RELEASING PLANS FOR CONSTRUCTION, ASSUMES NO RESPONSIBILITY FOR ADEQUACY OR ACCURACY OF DESIGN.

**AS-BUILT
 RECORD DRAWING**

TO THE BEST OF OUR KNOWLEDGE, THE JOHN R. MCADAMS COMPANY, INC. HEREBY STATES THAT THIS PLAN IS AS-BUILT. THIS INFORMATION PROVIDED IS BASED ON SURVEYING AT THE SITE AND INFORMATION PROVIDED BY THE CONTRACTOR.


MCADAMS,
 Date: 5/2/2020

The John R. McAdams Company, Inc.
 (DBA: G&A McAdams)
 111 Hillside Drive
 Leander, TX 78647
 817.436.9715
 201 Country View Drive
 Roanoke, Texas 76282
 840.240.1012
 TBPE: 19782 TBPLS: 10194440
 www.mcadamsco.com




LADERA ROCKWALL PHASE 1
 Lot 1, Block A & Lot 1, Block B
 LADERA ROCKWALL
 47.694 Acres
 in the
 M. JONES SURVEY, ABSTRACT NO. 122
 CITY OF ROCKWALL
 ROCKWALL COUNTY, TEXAS

OVERALL OFFSITE WATER

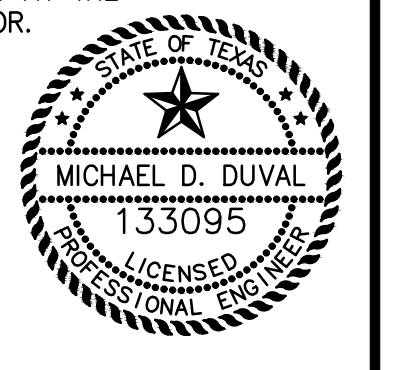

MCADAMS
 TBPE: 19782

Drawn By:	ASC
Date:	02/23/2018
Scale:	1"=150'
Revisions:	
	04/23/2018
	07/16/2018
	09/06/2018
	01/28/2019
	02/11/2019
	03/11/2019 Signed

17191

C67

OWNER/DEVELOPER
 RW LADERA, LLC.
 361 W. BYRON NELSON BLVD, STE. 104
 ROANOKE, TX 76282
 Ph. 817.430.3318
 Contact: John Dellin

LADERA ROCKWALL PHASE 1