


BM: CITY OF ROCKWALL CONTROL MONUMENT "COR-1" CALLED ELEV. 523.27, MEASURED ELEV. = 523.56

BM: CITY OF ROCKWALL CONTROL MONUMENT "COR-2" CALLED ELEV. 529.10, MEASURED ELEV. = 529.37

GENERAL NOTES

1. ALL RESPONSIBILITIES FOR ADEQUACY OF DESIGN REMAINS WITH THE DESIGN ENGINEER. THE CITY OF ROCKWALL, IN REVIEWING AND RELEASING PLANS FOR CONSTRUCTION, ASSUMES NO RESPONSIBILITY FOR ADEQUACY OR ACCURACY OF DESIGN.

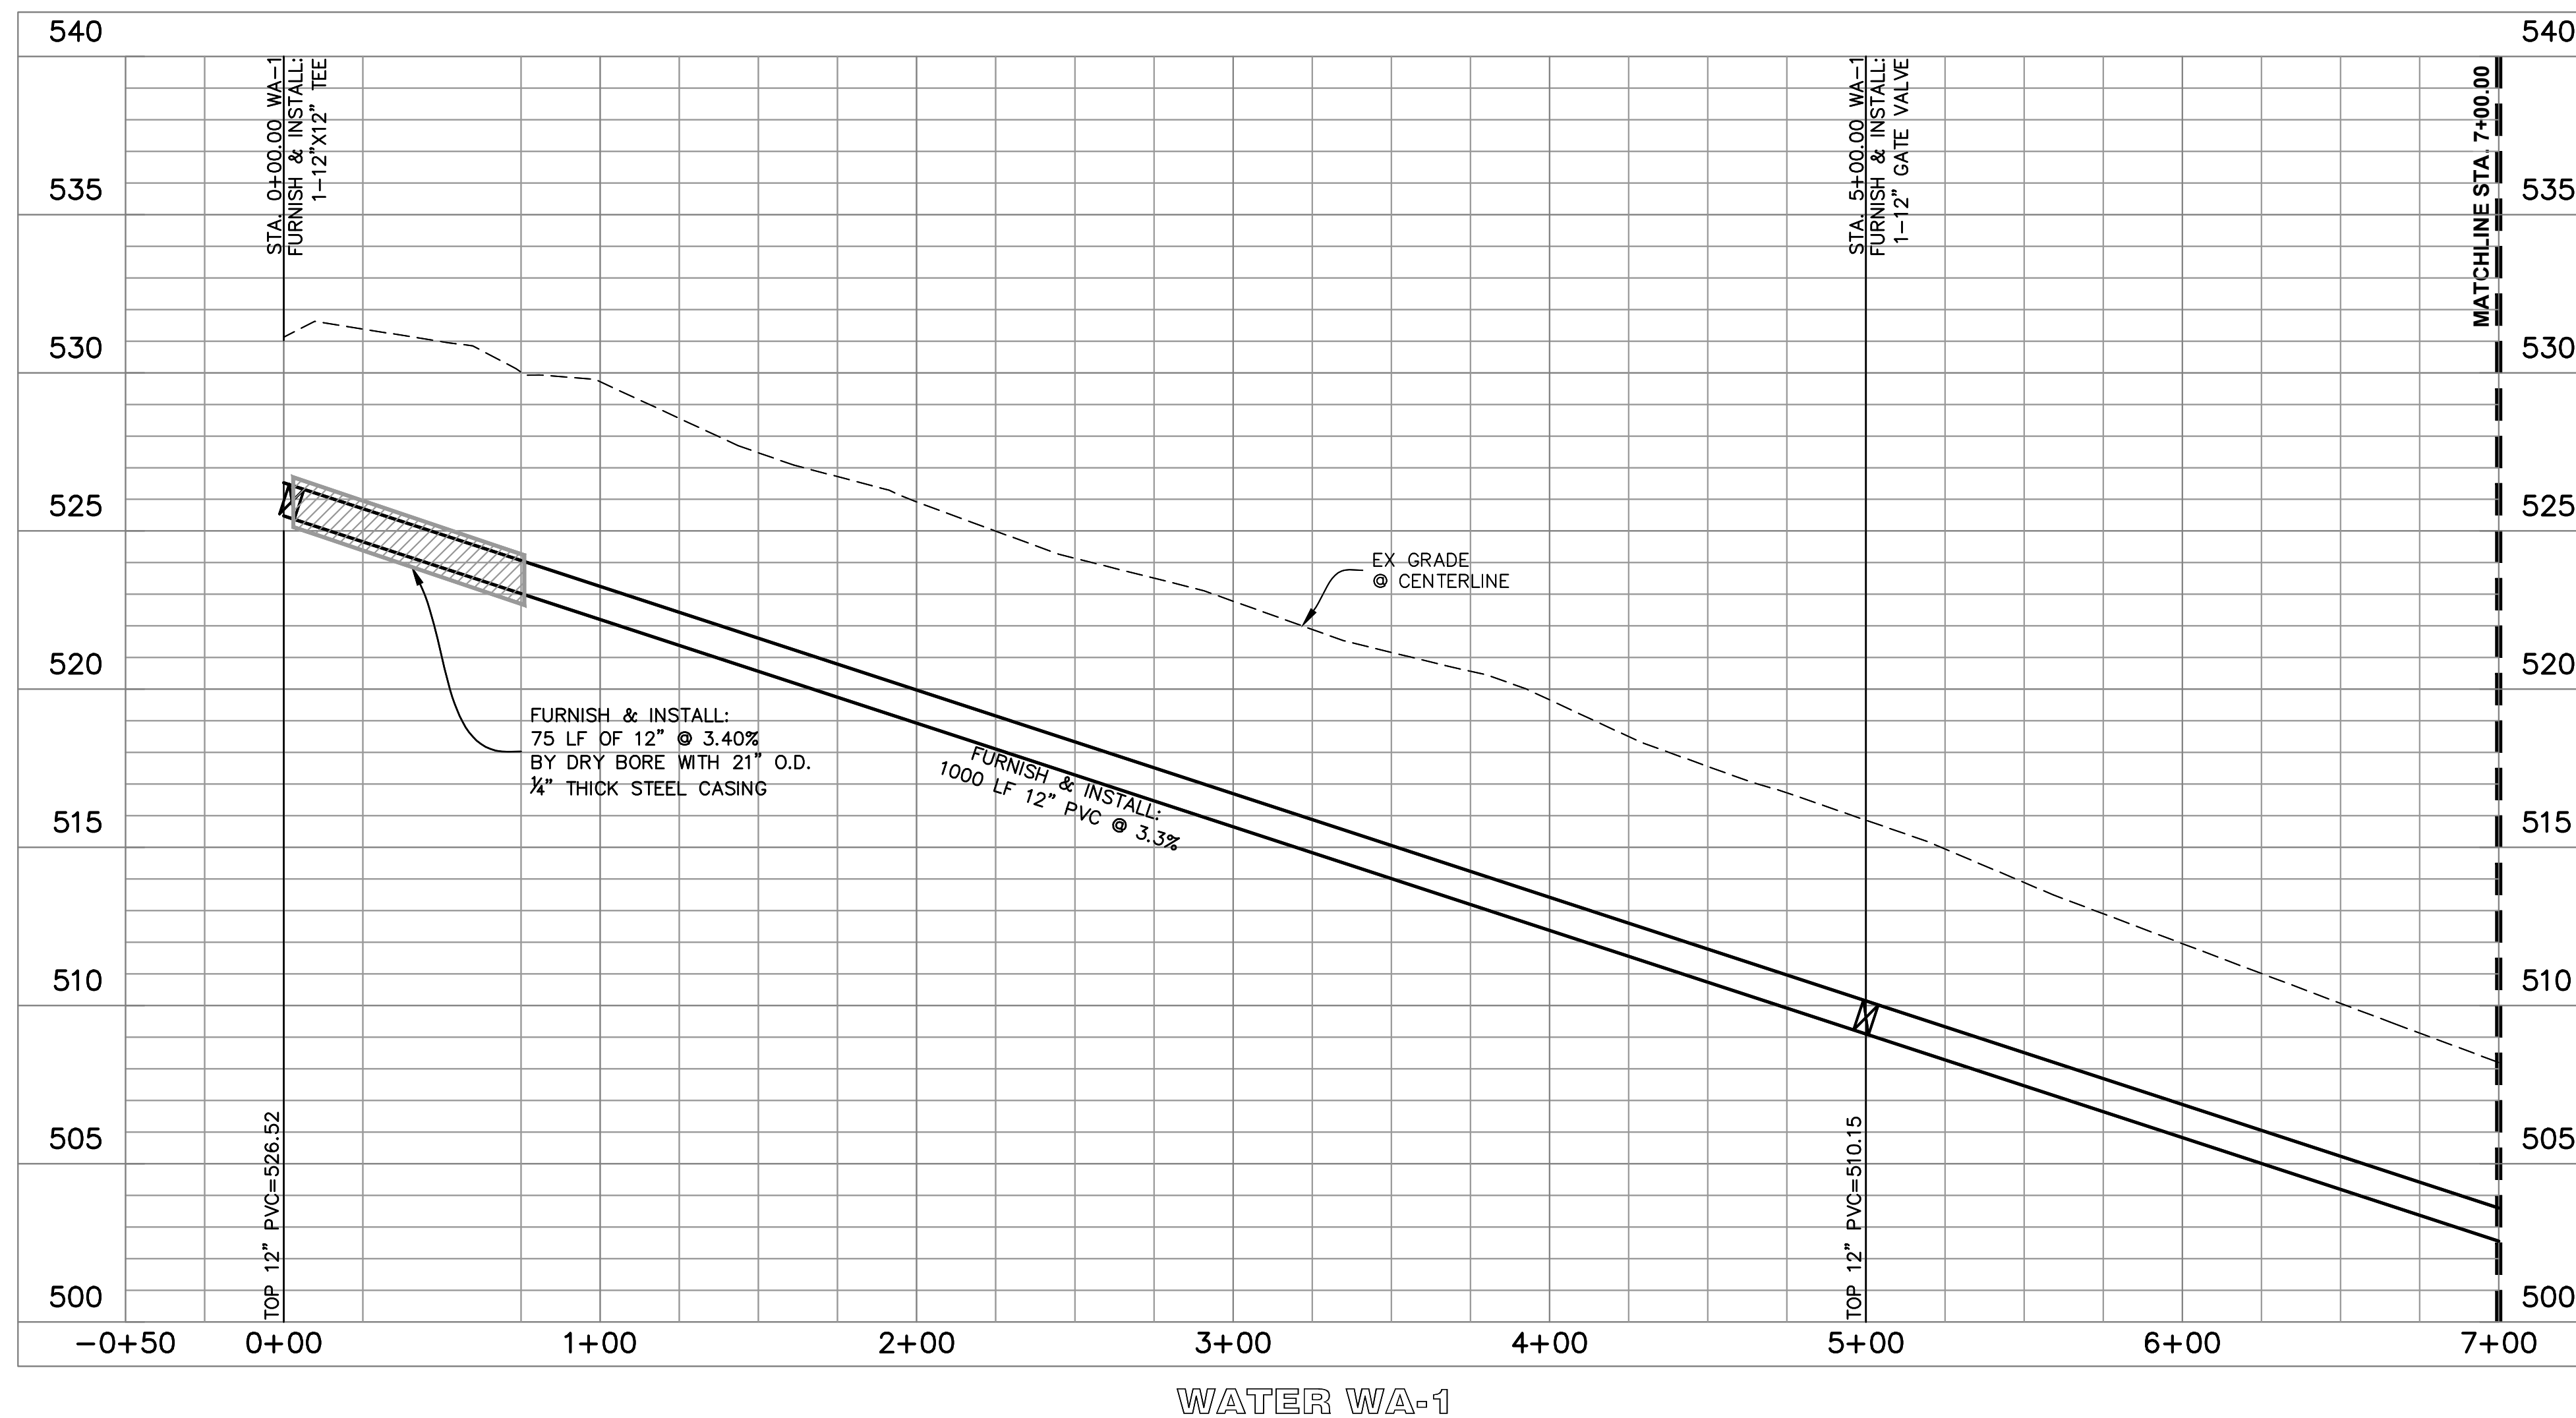

AS-BUILT RECORD DRAWING

TO THE BEST OF OUR KNOWLEDGE, THE JOHN R. MCADAMS COMPANY, INC. HEREBY STATES THAT THIS PLAN IS AS-BUILT. THIS INFORMATION PROVIDED IS BASED ON SURVEYING AT THE SITE AND INFORMATION PROVIDED BY THE CONTRACTOR.


MCADAMS,

Date: 5/21/2020

The John R. McAdams Company, Inc.
(DBA: G&A McAdams)
111 Hillside Drive
Levelland, TX 75047
972.436.9715
201 Country View Drive
Roanoke, Texas 76282
940.240.1012
TBPE: 19782 TBPE L.S. 10194440
www.mcadamsco.com

LADERA ROCKWALL PHASE 1
Lot 1, Block A & Lot 1, Block B
LADERA ROCKWALL
47.694 Acres
in the
M. JONES SURVEY, ABSTRACT NO. 122
CITY OF ROCKWALL
ROCKWALL COUNTY, TEXAS

OFFSITE PLAN & PROFILE
WATER WA-1, STA 0+00-10+00

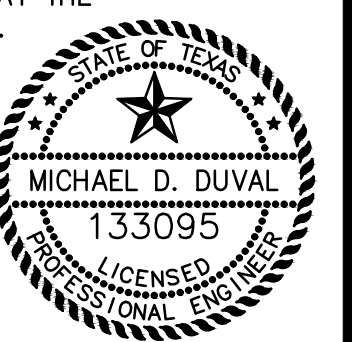

MCADAMS
TBPE: 19782

Drawn By: ASC
Date: 02/23/2018
Scale: H1=40' V 1"=4'
Revisions:
04/23/2018
07/16/2018
09/06/2018
01/28/2019
02/11/2019
03/11/2019 Signed

17191



OWNER/DEVELOPER
RW LADERA, LLC.
361 W. BYRON NELSON BLVD, STE. 104
ROANOKE, TX 76282
Ph. 817.430.3318
Contact: John Dellin