



rawing: C:\Reaves Consulting, LLC\Reaves Consulting LLC\Projects\Ladera Rockwall\Ladera Rockwall-13' Max.Ret. Wall REV 19-4-18.dwg aved By: Richard Save Time: 4/18/2019 5:15 PM


otted by: ####### Plot Date: 4/18/2019 5:16 PM

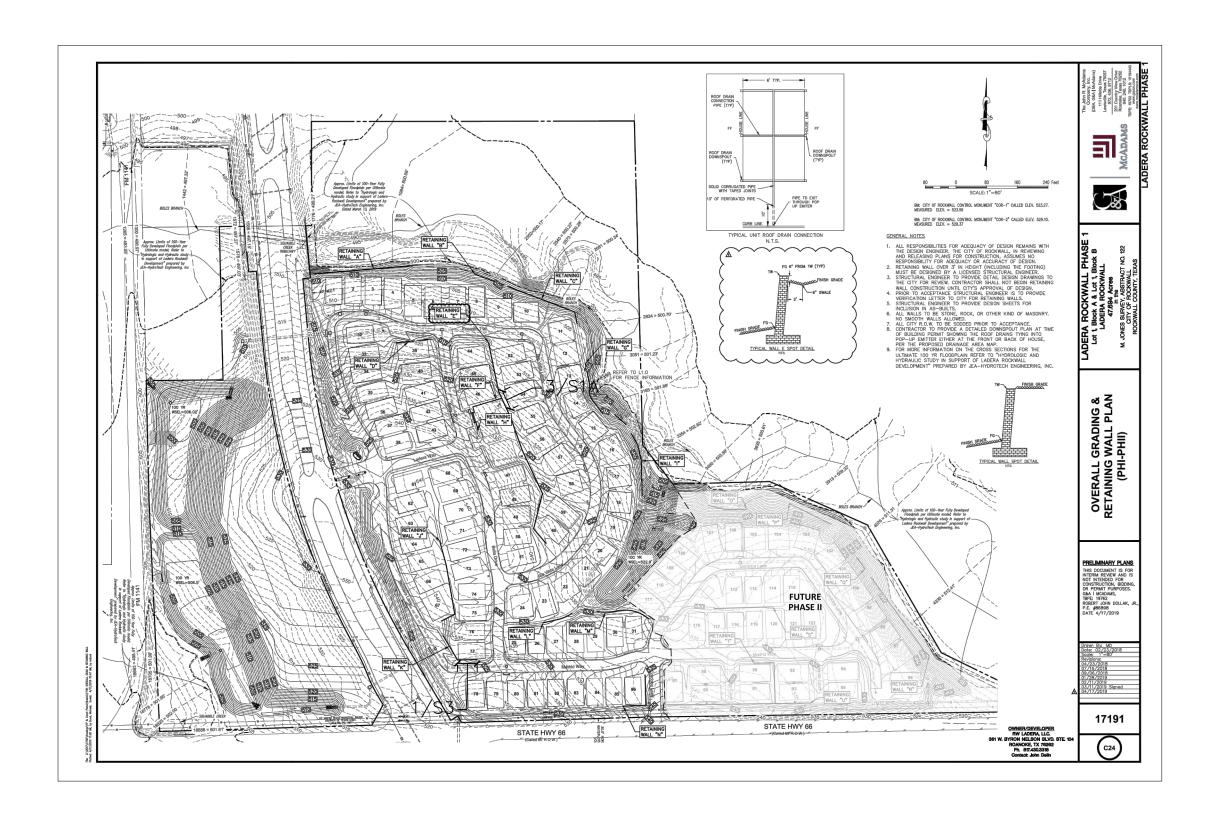

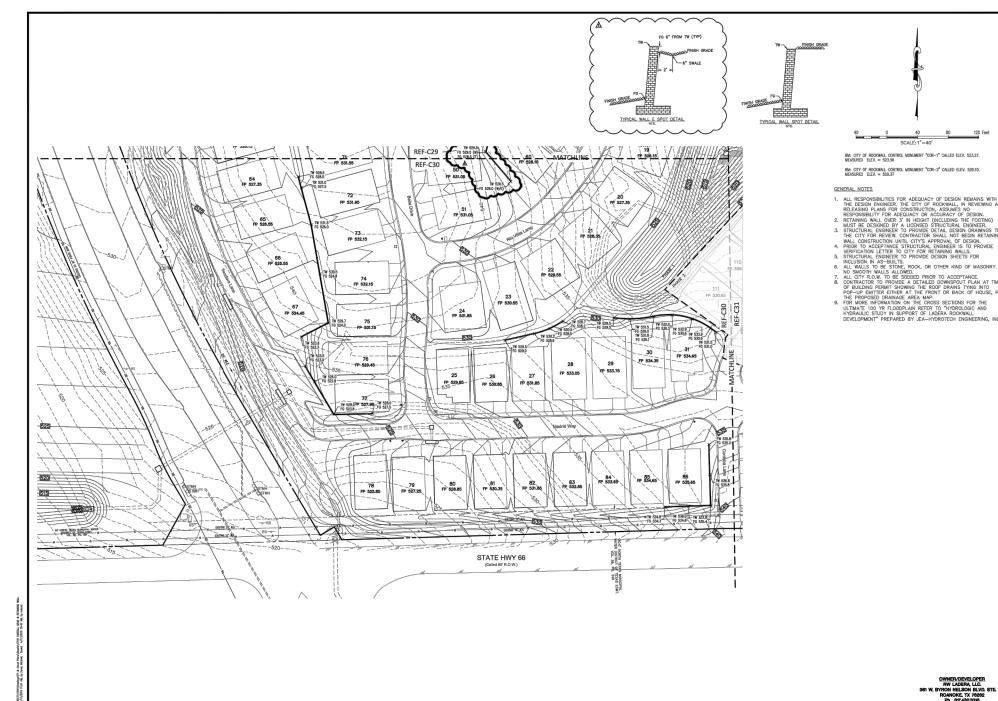

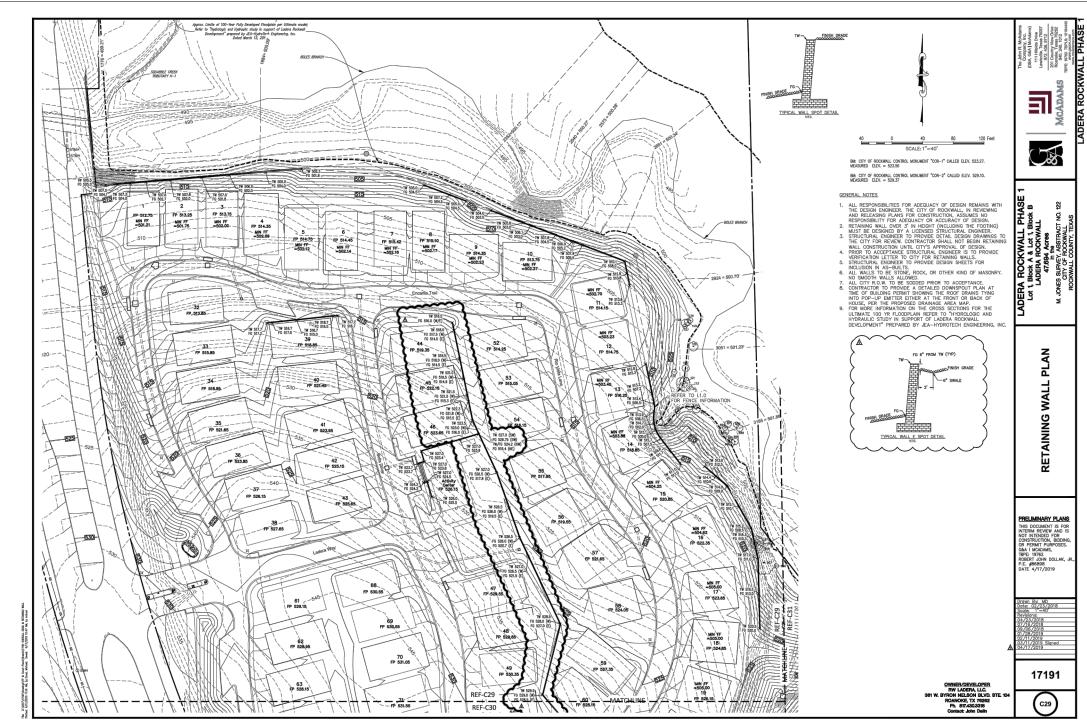

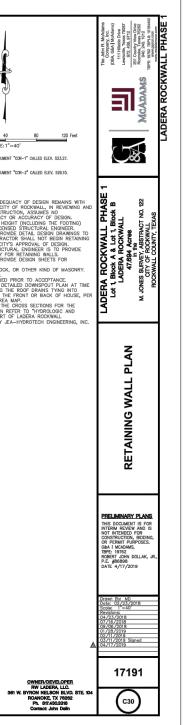

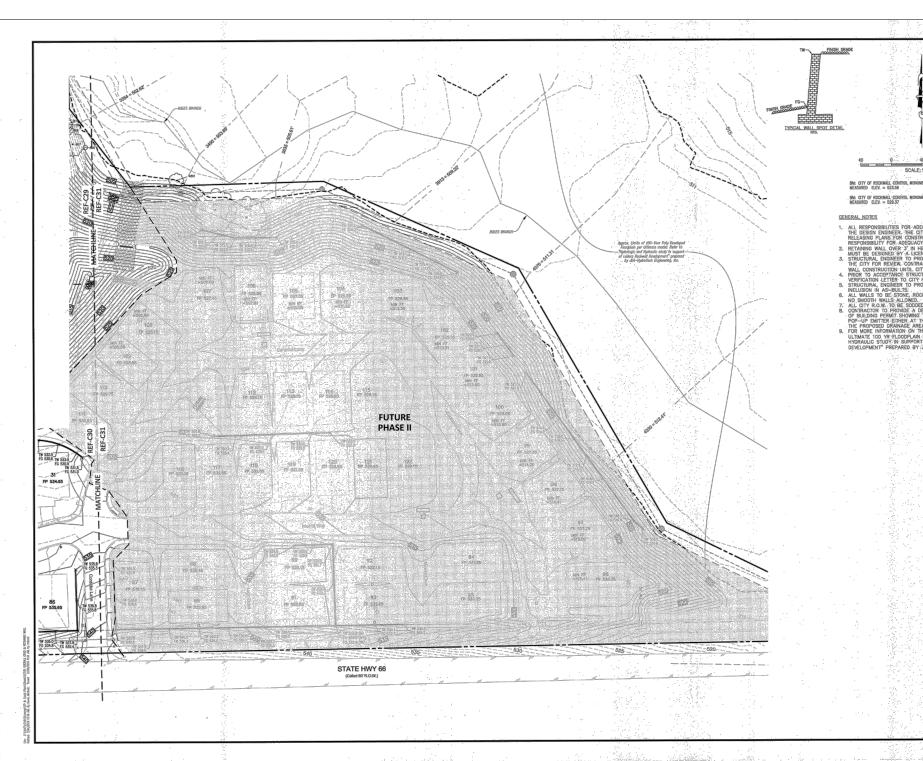

	07/8/2018 09/06/2018 07/28/2019 07/28/2019 07/28/2019 02/17/2019 02/17/2019 04/17/2019	
OWNER/DEVELOPER RW LADERA, LLC. 361 W. BYRON NELSON BLVD. STE 1 R ROMOKE, TX 78262 Ph. 817/430.3316 Contact John Delin	17191 •• C29	
	The John R. Modulant Company, Inc. Company, Inc. Cash San Mangara (1997) (1998)	
55 0	MCADAMS	
NI "COR-2" CALLED ELEX. \$20.10. NACY OF DESIGN REMAINS WITH LOCT ROCKNELL IN REMEMBING AND DUTION, ASSUMES NO- OF ROCKNELLY OF DESIGN (GAT, (INCLUDING THE FOOTING) UPA OF ACURACY OF DESIGN DUPA DE DESIN DRAWINGS TO TOTOR SHALL NOT BEGIN RETAINING S'A APPROVAL OF DESIGN. UPAL ENDINEER IS TO PROVIDE UPAL ENDINEER IS TO PROVIDE UPAL ENDINEER IS TO PROVIDE WIDE DESINS DRAWINGS TO STOR SHALE NOT DESIGN. TALED DOWNSERETS FOR K. OR OTHER KIND OF MASONRY. PRIOR TO ACCEPTANCE. TALED DOWNSERTS TIME INTO MAP. OR OF HOUSE, PER MAP. OR OF HOUSE, PER C. GROSS SECTIONS FOR THE REFER TO "WORKLOSG AND PF LAREDA ROCKIAL.	LADERA ROCKWALL PHASE 1 Lot 1 Block A & Lot 1 Block B LUDERA ROCKWALL 47694 Acres M. JONES SURVEY, ABSTROT NO. 122 M. JONES SURVEY, ABSTROT NO. 122 ROCKWALL COUNTY, TEXAS	
	RETAINING WALL PLAN (PHII)	
	ALL ACADAS ALL AC	
	02/11/2019 03/11/2019 Signed	

Ladera Rockwall-Wall & Detail Tab						
Wall	Detail					
<u>Wall</u>	Detail					
A B	3/S2 3/S2					
Б С	3/S2 3/S2					
D	3/S2 3/S1					
E	**1/S1A & 2/S1A (PARTIAL) & 3/S1A (PARTIAL)					
F	*NOT INCLUDED					
G	1/S3					
н	1/S1 & 2/S1					
1	2/S3 & 3/S3					
J	1/S1 & 2/S1					
ĸ	**1/S1 & 2/S1 (PARTIAL) & 3/S1 (PARTIAL)					
L	1/S1 & 2/S1					
М	1/S1 & 2/S1					
Ν	1/S1 & 2/S1					
ο	1/S2 & 2/S2					
Р	1/S2 & 2/S2					
Q	1/S2 & 2/S2					
R	1/S2 & 2/S2					
S	1/S1 & 2/S1					
Т	1/S1 & 2/S1					
U	1/S1 & 2/S1					
	"F" TO BE REPLACED WITH DROP BEAM DESIGN BY ACTIVITY CENTER ATION ENGINEER PER DEVELOPER.					
FUUND	ATION ENGINEER PER DEVELOPER.					
**DFTAI	L 3/S1A SHALL BE USED FOR SECTION OF WALL "E" (BEHIND ACTIVITY					
	R) AND DETAIL 3/S1 FOR WALL "K" (LOT 77 SIDE YARD) WHERE PAD					
	ARGE IS ANTICIPATED. SEE EXHIBIT FOR LIMITS					

		F-10820	3		
	RICHARD REAVES 91128 CENSE ONAL ENGLACE April 18, 2019	REAVES CONS B31 ARROWHE PROSPER, TEX 972.347.390 RICHARD@REAVES	ULTIN AD E AS 7	DRIVE 5078	
#			BY	' DATE	
1	1 REVISED PER CIVIL GRADING REVISIONS		RI	R 4/18/19	
			DI		
Ħ	# CONSTRUCTION REVISIONS		BY	Z DATE	
Retaining Wall Exhibit			,	PROJECT HRK-172	
SITE RETAINING WALLS-13' MAX				SHEET	
City of Rockwall, Rockwall County, Texas				S4 of 4	