


THE CITY OF ROCKWALL, TEXAS

PAVING, DRAINAGE, WATER AND SANITARY SEWER IMPROVEMENTS

FOR


LAGO VISTA ADDITION

SHEET INDEX

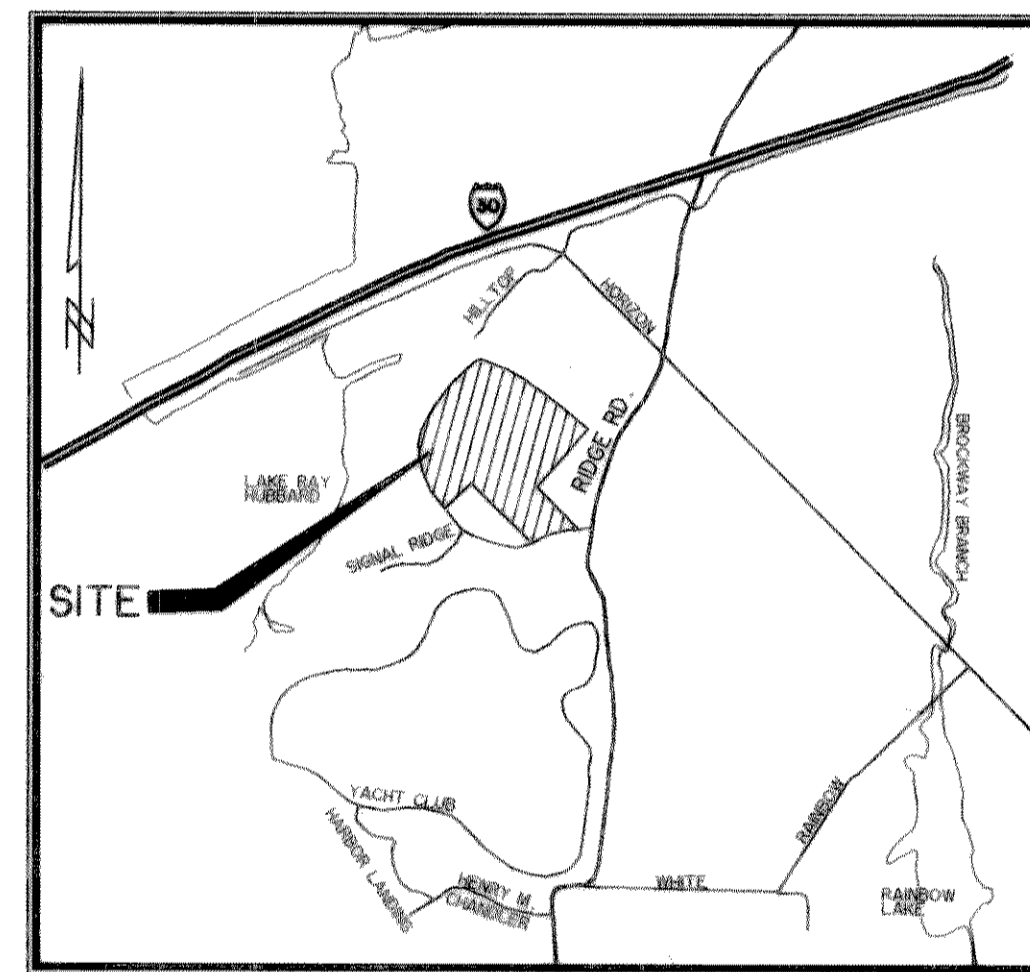

LOCATION MAP
N.T.S.

OWNER - DEVELOPER:
LENMAR DEVELOPMENT CORPORATION
14755 PRESTON ROAD
SUITE 830
DALLAS, TEXAS 75240
(214) 392-3800

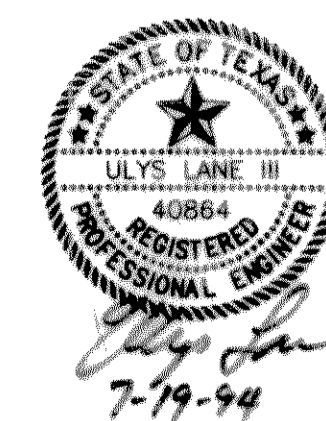

RECORD PLANS
12-18-95

1. COVER SHEET
 2. FINAL PLAT
 - 3A. FINAL PLAT
 - 3B. FINAL PLAT
 4. VACATION PLAT
 5. VACATION PLAT
- PAVING PLANS**
6. TYPICAL SECTION & ALLEY RETURN DETAILS
 7. SUMMER LEE DRIVE PAVING PLAN & PROFILE
STA. 3+00 TO 13+00
 8. SUMMER LEE DRIVE PAVING PLAN & PROFILE
STA. 13+00 TO 21+50
 9. LAKE FRONT TRAIL PAVING PLAN & PROFILE
STA. 0+00 TO 11+00
 10. LAGO VISTA LANE PAVING PLAN & PROFILE
STA. 0+00 TO 11+00
 11. LAGO VISTA LANE PAVING PLAN & PROFILE
STA. 11+00 TO END
PARKSIDE CIRCLE PAVING PLAN & PROFILE
STA. 0+00 TO END
 12. MIRA VISTA LANE PAVING PLAN & PROFILE
STA. 0+00 TO 10+00
 13. MIRA VISTA LANE PAVING PLAN & PROFILE
STA. 10+00 TO END
LA COSTA DRIVE PAVING PLAN & PROFILE
STA. 0+00 TO END
 14. SHADY GROVE CIRCLE PAVING PLAN & PROFILE
STA. 0+00 TO END
 15. MARCIE LANE PAVING PLAN & PROFILE
STA. 0+00 TO END
 16. ALLEY PROFILES - ALLEYS "A", "B" & "C"
 17. ALLEY PROFILES - ALLEYS "D", "E" & "F"
- STORM DRAINAGE**
18. OFF-SITE DRAINAGE AREA MAP
 19. DRAINAGE AREA MAP
 20. DRAINAGE CALCULATIONS
 21. CULVERT PLAN & PROFILE
S. D. SYSTEM "E"
 22. S. D. LINE "C"
 23. S. D. LINE "D"
 24. S. D. LINE "A", "A-1", & "B"
 25. S. D. LATERAL PROFILES
 26. SPECIAL INLET DETAILS
- WATER & SANITARY SEWER**
27. WATER & SANITARY SEWER LAYOUT
 28. SANITARY SEWER PROFILES - LINE "A" & "E"
 29. SANITARY SEWER PROFILES - LINE "C" & "D"
 30. SANITARY SEWER PROFILES - LINE "B" & "F"

GRADING, RETAINING WALL & EROSION CONTROL

31. GRADING & EROSION CONTROL PLAN EAST
32. GRADING & EROSION CONTROL PLAN WEST
33. GRADING & EROSION CONTROL PLAN NORTH
34. TEMPORARY SEDIMENTATION BERM
35. RETAINING WALL PLAN EAST
36. RETAINING WALL PLAN WEST
37. RETAINING WALL PLAN NORTH
38. STORM WATER POLLUTION PREVENTION PLAN
39. STORM WATER POLLUTION PREVENTION NOTES
40. STORM WATER POLLUTION PREVENTION DETAILS
41. STORM WATER POLLUTION PREVENTION DETAILS
42. CULVERT SECTIONS & HEADWALL DETAILS
43. MISCELLANEOUS STORM DRAIN DETAILS

CITY OF ROCKWALL STANDARD CONSTRUCTION DETAILS
HEREIN INCORPORATED HEREIN BY REFERENCE

PREPARED BY:
WIA WIER & ASSOCIATES, INC.
ENGINEERS SURVEYORS LAND PLANNERS
4300 BELTWAY PLACE SUITE 130 ARLINGTON, TEXAS 76018 METRO (817)467-7700
3908 SOUTH FREEMAN FORT WORTH, TEXAS 76110 (817)926-0212

07-19-94

COVERSHEET