


# LAKEFRONT TRAIL

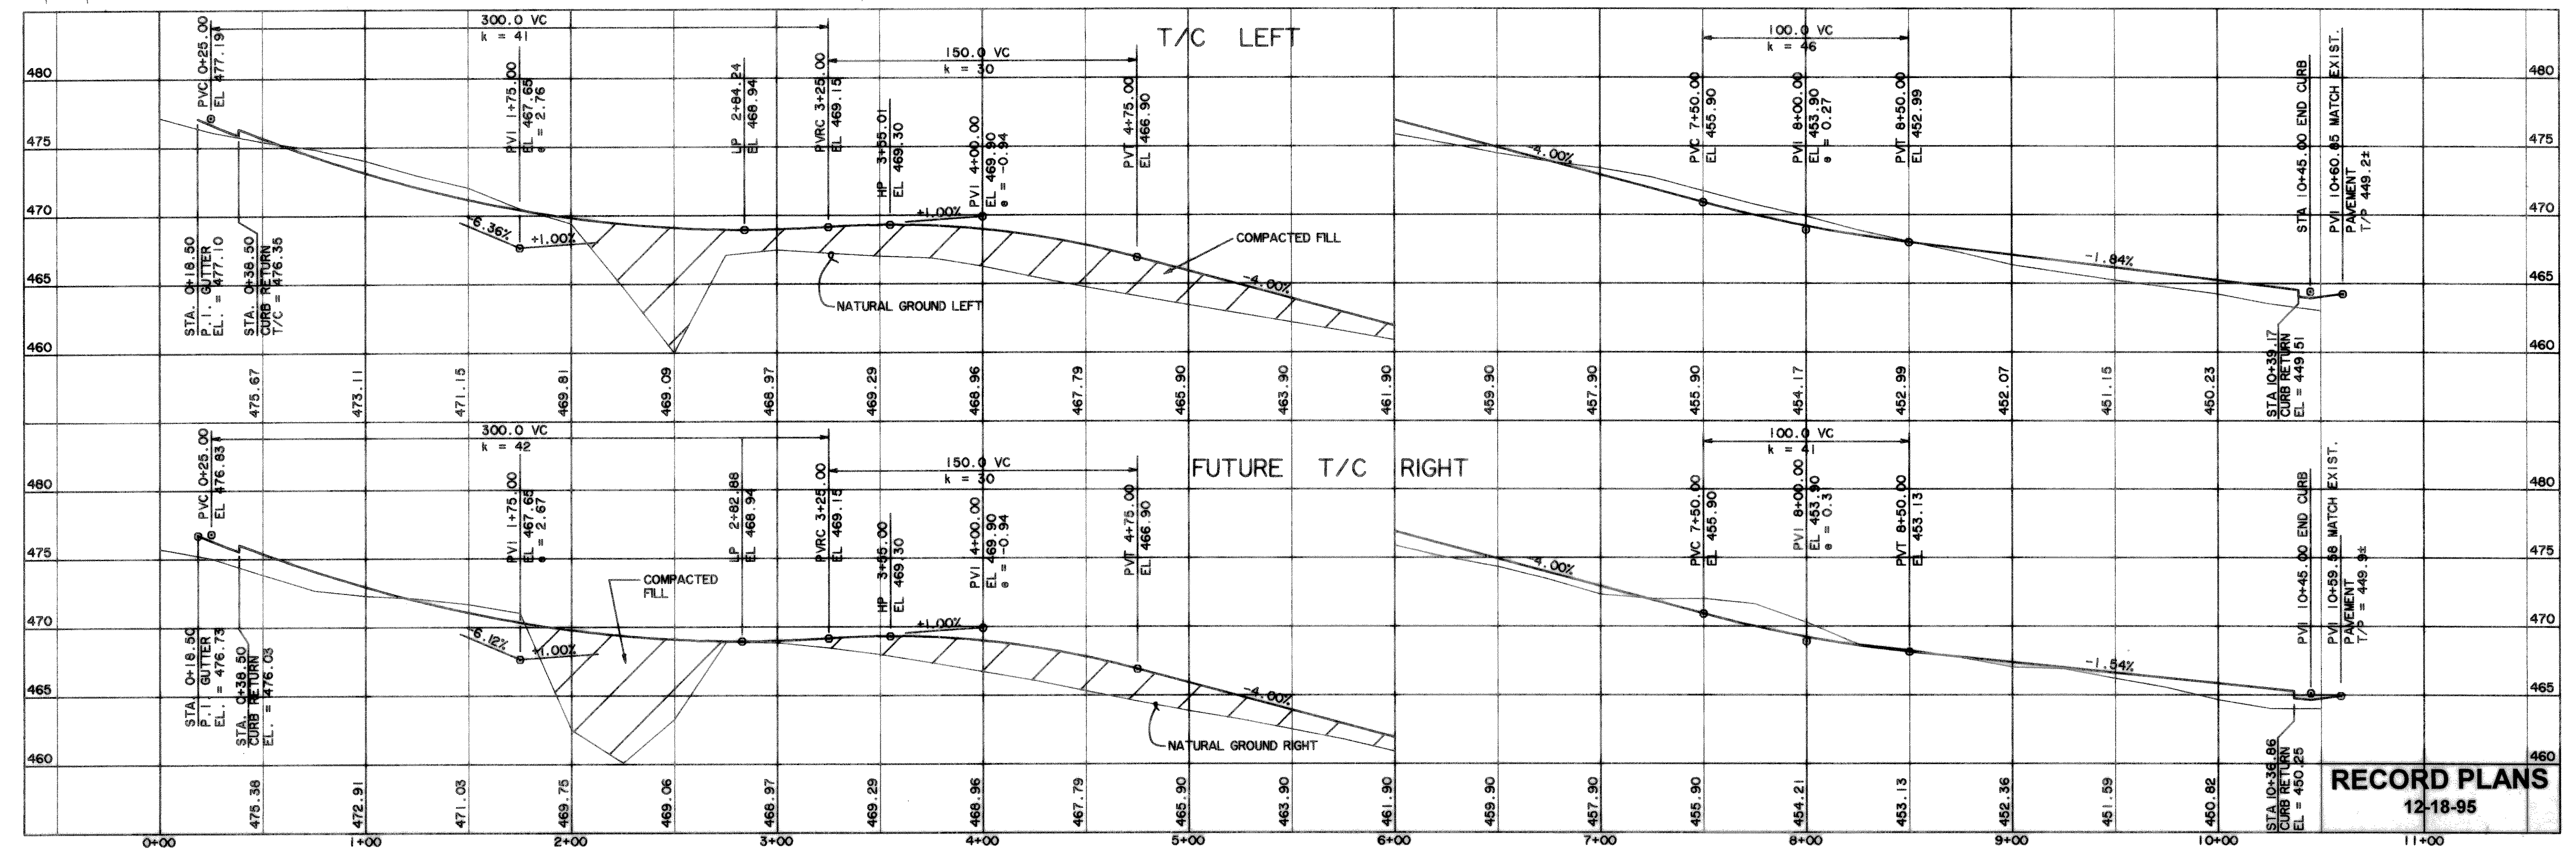


**RECORD PLANS**  
12-18-95

PREPARED BY:  
**VIA WIER & ASSOCIATES, INC.**  
ENGINEERS SURVEYORS LAND PLANNERS  
4300 BELLEVUE PLACE SUITE 130 ARLINGTON, TEXAS 76018 METRO (817) 467-7700  
3908 SOUTH FREEMAN FORT WORTH, TEXAS 76110 (817) 926-0212

**CITY OF ROCKWALL**  
**ROCKWALL COUNTY, TEXAS**

**LAKEFRONT TRAIL**  
**PLAN AND PROFILES**  
**STA. 0+00 TO STA. 11+00**

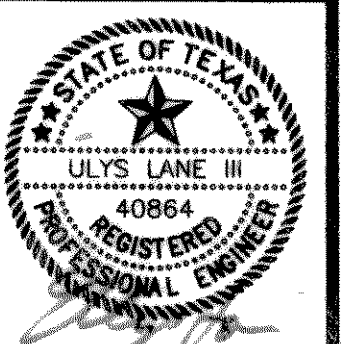

COPYRIGHT © WIER & ASSOCIATES, INC.  
LAST SHEET OF 31 SHEETS  
DATE 07-31-95  
FILE PAVES  
WA# 93045  
**SHEET NO. 9**