


LEGEND
 DENOTES PERFORATED PIPE
 DENOTES SOLID PIPE

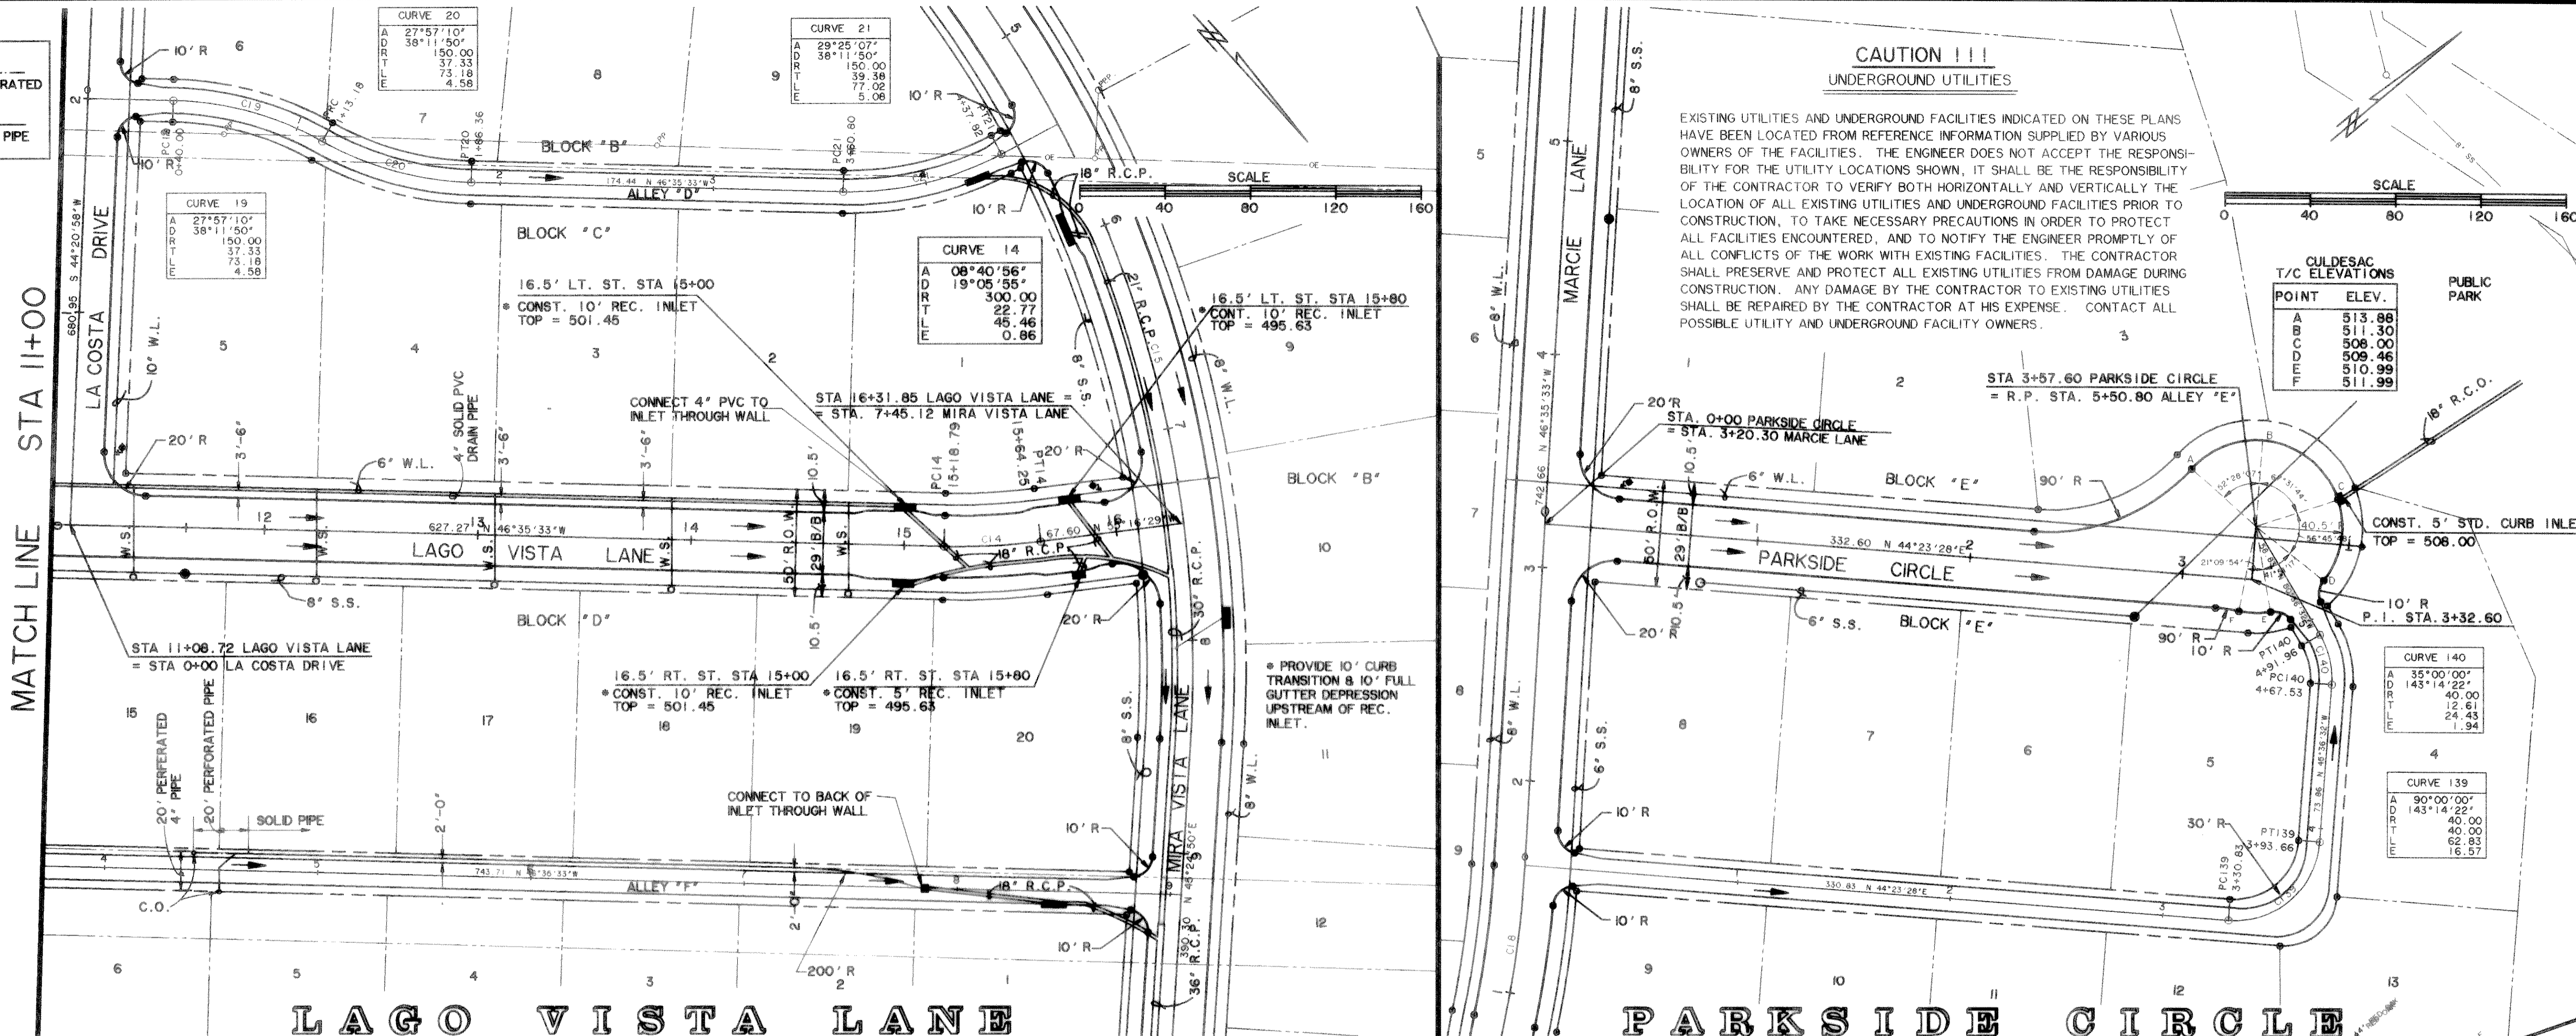

GULDESAC T/C ELEVATIONS


| POINT | ELEV. |
|-------|--------|
| A | 513.88 |
| B | 511.30 |
| C | 508.00 |
| D | 508.46 |
| E | 510.99 |
| F | 511.99 |

CURVE 140

| | |
|---|-----------|
| A | 35°00'00" |
| B | 43°14'22" |
| C | 43.00 |
| D | 12.61 |
| E | 24.43 |
| F | 1.94 |

CURVE 139


| | |
|---|------------|
| A | 90°00'00" |
| B | 143°14'22" |
| C | 40.00 |
| D | 62.83 |
| E | 16.57 |

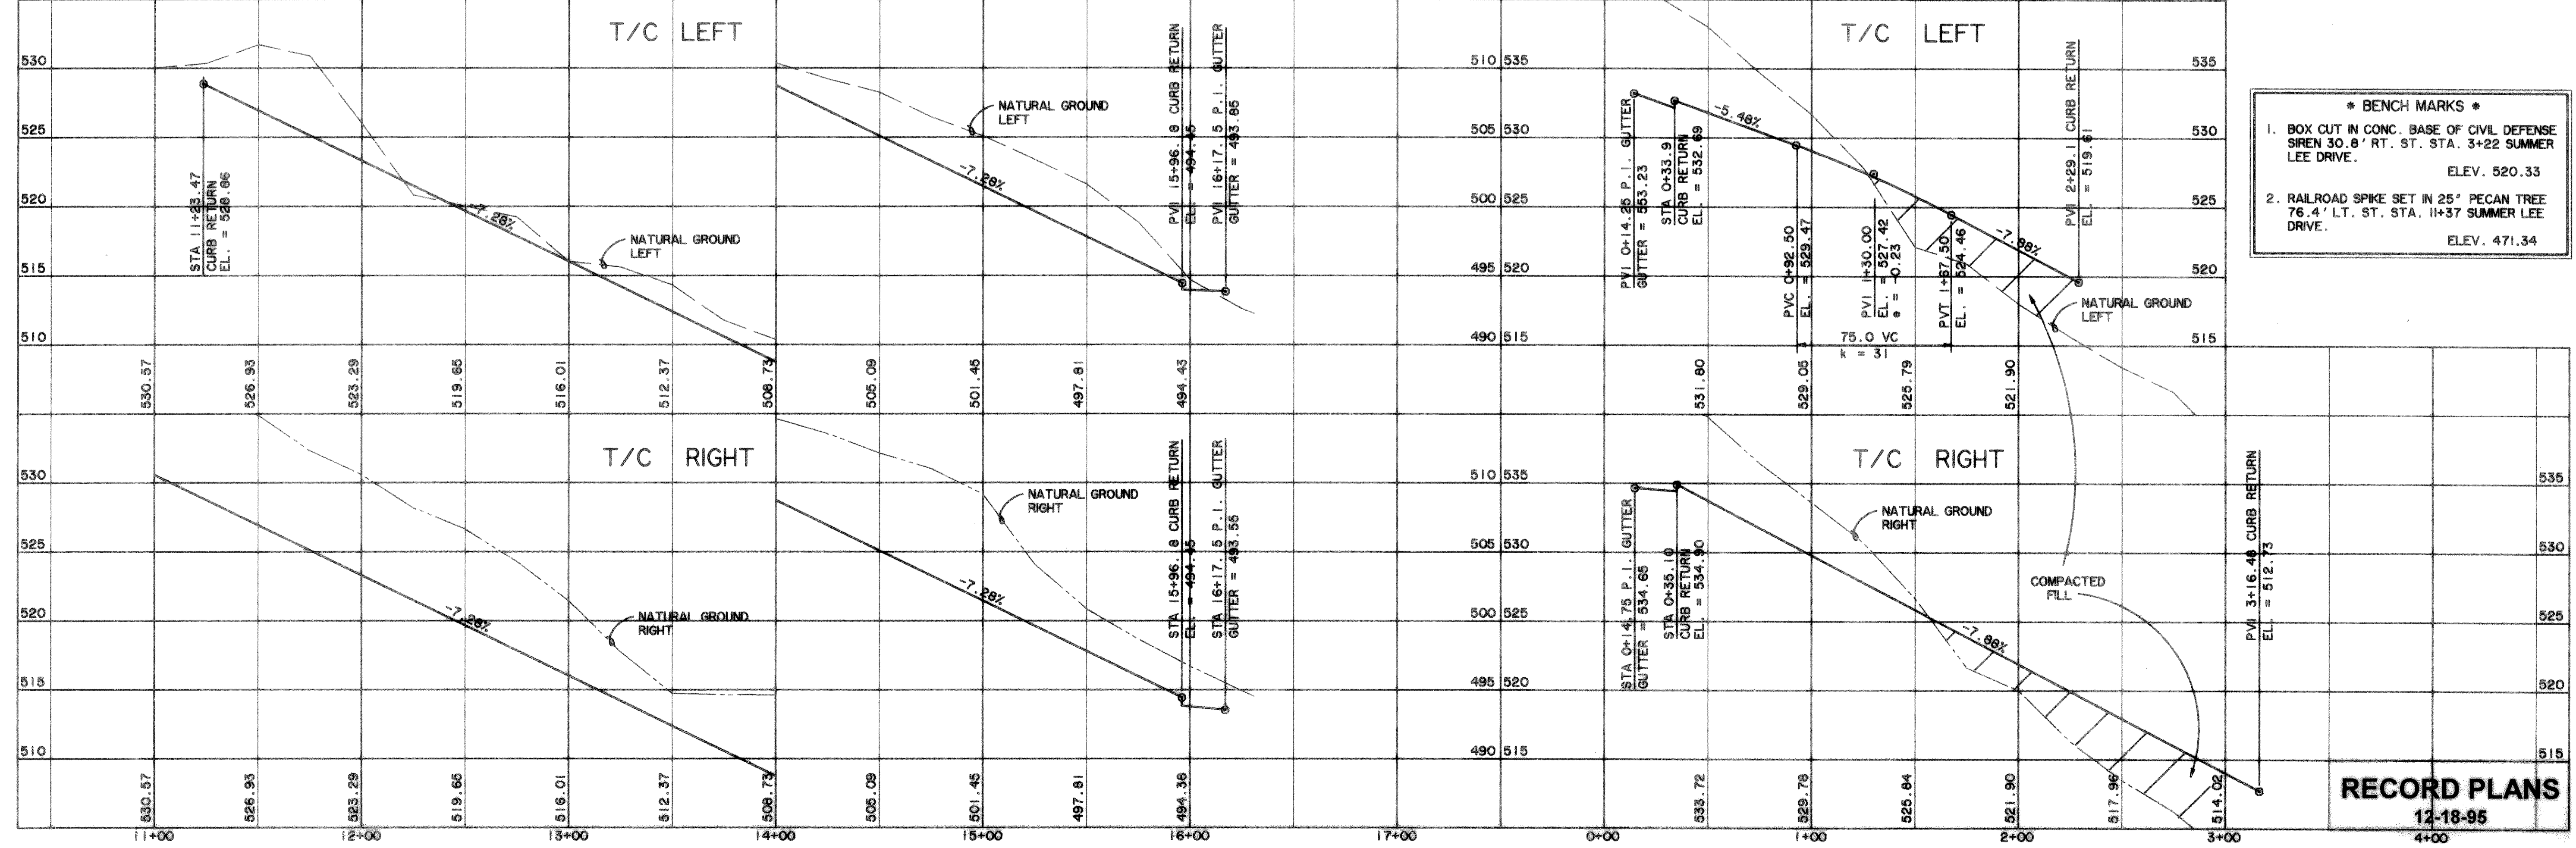

PREPARED BY:
VIA WIER & ASSOCIATES, INC.
 ENGINEERS SURVEYORS LAND PLANNERS
 4300 BELLEVUE PLACE SUITE 130 ARLINGTON TEXAS 76018 METRO (817) 467-7700
 3808 SOUTH FREEWAY FORT WORTH, TEXAS 76110 (817) 926-0212

CITY OF ROCKWALL
ROCKWALL COUNTY, TEXAS

PLAN AND PROFILES
 LAGO VISTA LANE
 STA. 11+00 TO END
 PARKSIDE CIRCLE
 STA. 0+00 TO END

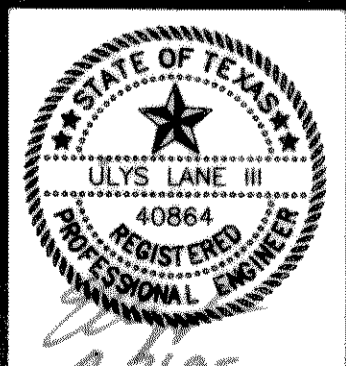

COPYRIGHT ©
 WIER & ASSOCIATES, INC.
 LAST SHEET EDIT
 DATE 04-20-95
 FILE # 94-2
 WAB 93049
SHEET NO.
 11