


SHADY GROVE CIRCLE

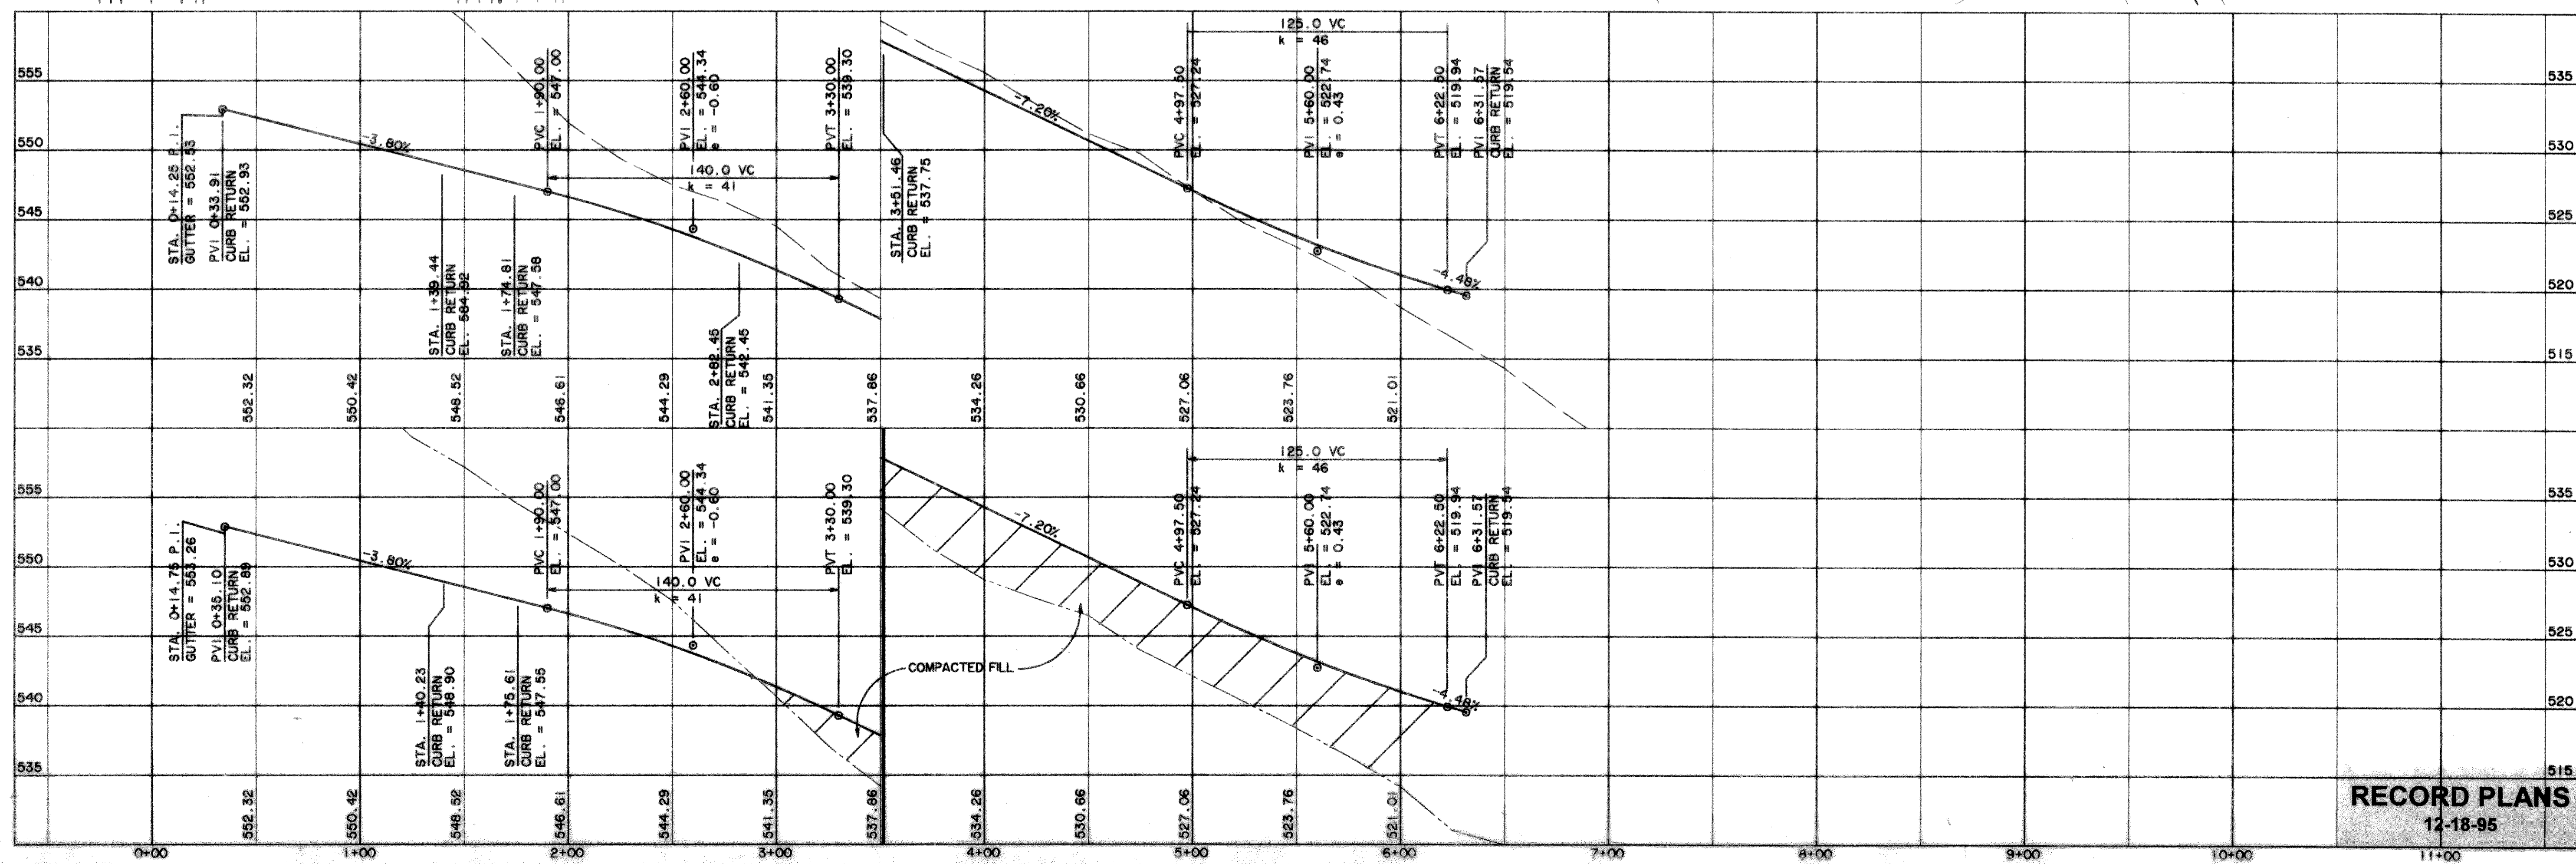

RECORD PLANS
12-18-95

PREPARED BY:
WIER & ASSOCIATES, INC.
ENGINEERS SURVEYORS LAND PLANNERS
430 BELMONT PLACE SUITE 130 ARLINGTON TEXAS 76010 METRO (817)467-7700
3908 SOUTH FREEMAN FORT WORTH, TEXAS 76110 (817)926-0212

CITY OF ROCKWALL
ROCKWALL COUNTY, TEXAS

SHADY GROVE CIRCLE
PLAN AND PROFILES
STA. 0+00 TO STA. END

COPYRIGHT ©
WIER & ASSOCIATES, INC.
LAST SHEET EDIT
DATE: 08-21-94
FILE: 93-21-94
WA# 93049
SHEET NO. 14