
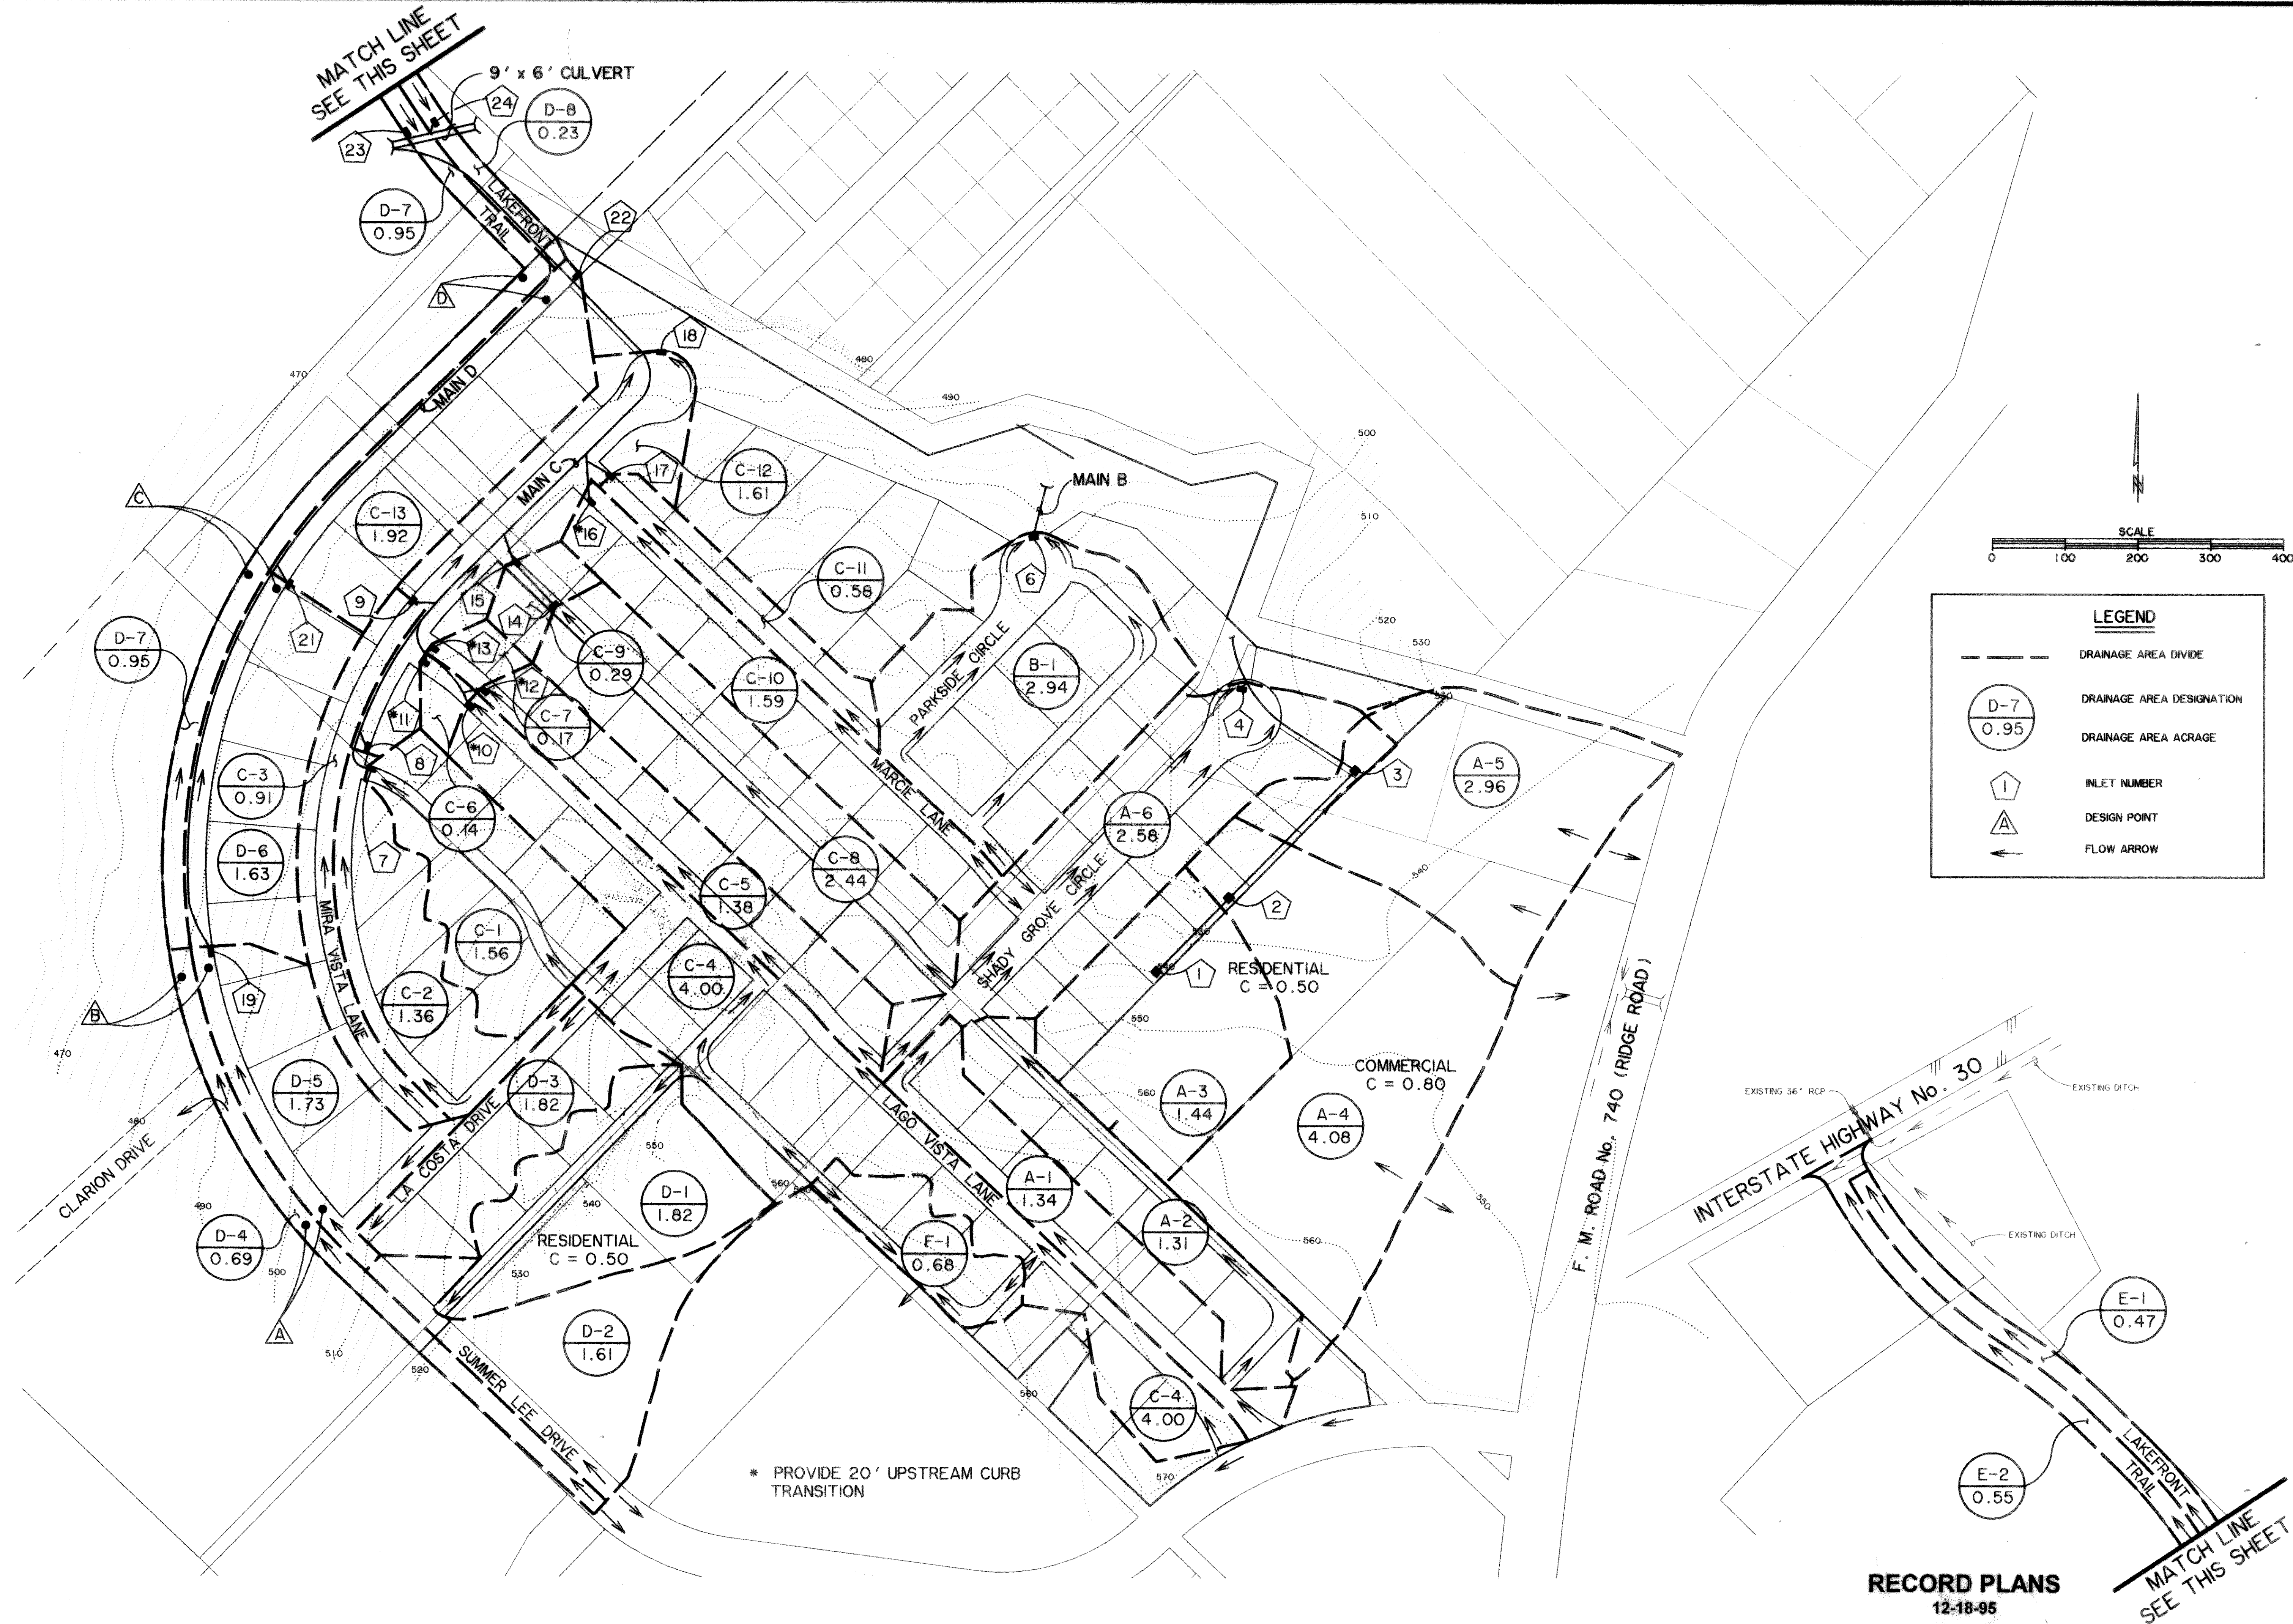


**CITY OF ROCKWALL**  
**ROCKWALL COUNTY, TEXAS**

**DRAINAGE AREA**  
**MAP**

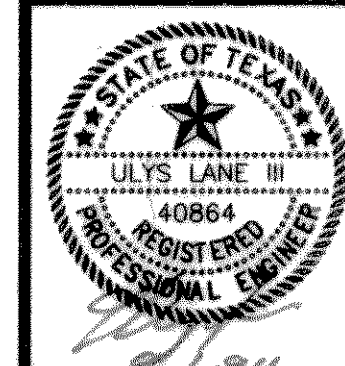

**RECORD PLANS**  
 12-18-95

MATCH LINE  
 SEE THIS SHEET