


MATCH LINE SEE SHEET 33

MATCH LINE SEE SHEET 31

PREPARED BY:  
**VIA WIER & ASSOCIATES, INC.**  
 ENGINEERS SURVEYORS LAND PLANNERS  
 4300 BELLEVUE PLACE SUITE 130 ARLINGTON, TEXAS 76018 METRO (817)467-7700  
 1108 NORTH CARTER BLVD. SUITE 200 FORT WORTH, TEXAS 76155 METRO (817)355-4457


**CITY OF ROCKWALL  
 ROCKWALL COUNTY, TEXAS**

**GRADING & EROSION  
 CONTROL PLAN  
 WEST**

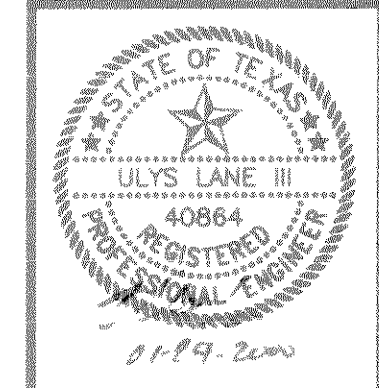

COPYRIGHT ©  
 WIER & ASSOCIATES, INC.  
 LAST SHEET EDIT  
 DATE 08-30-94  
 FILE GRAD2  
 W/A# 93049

**SHEET NO.  
 32**

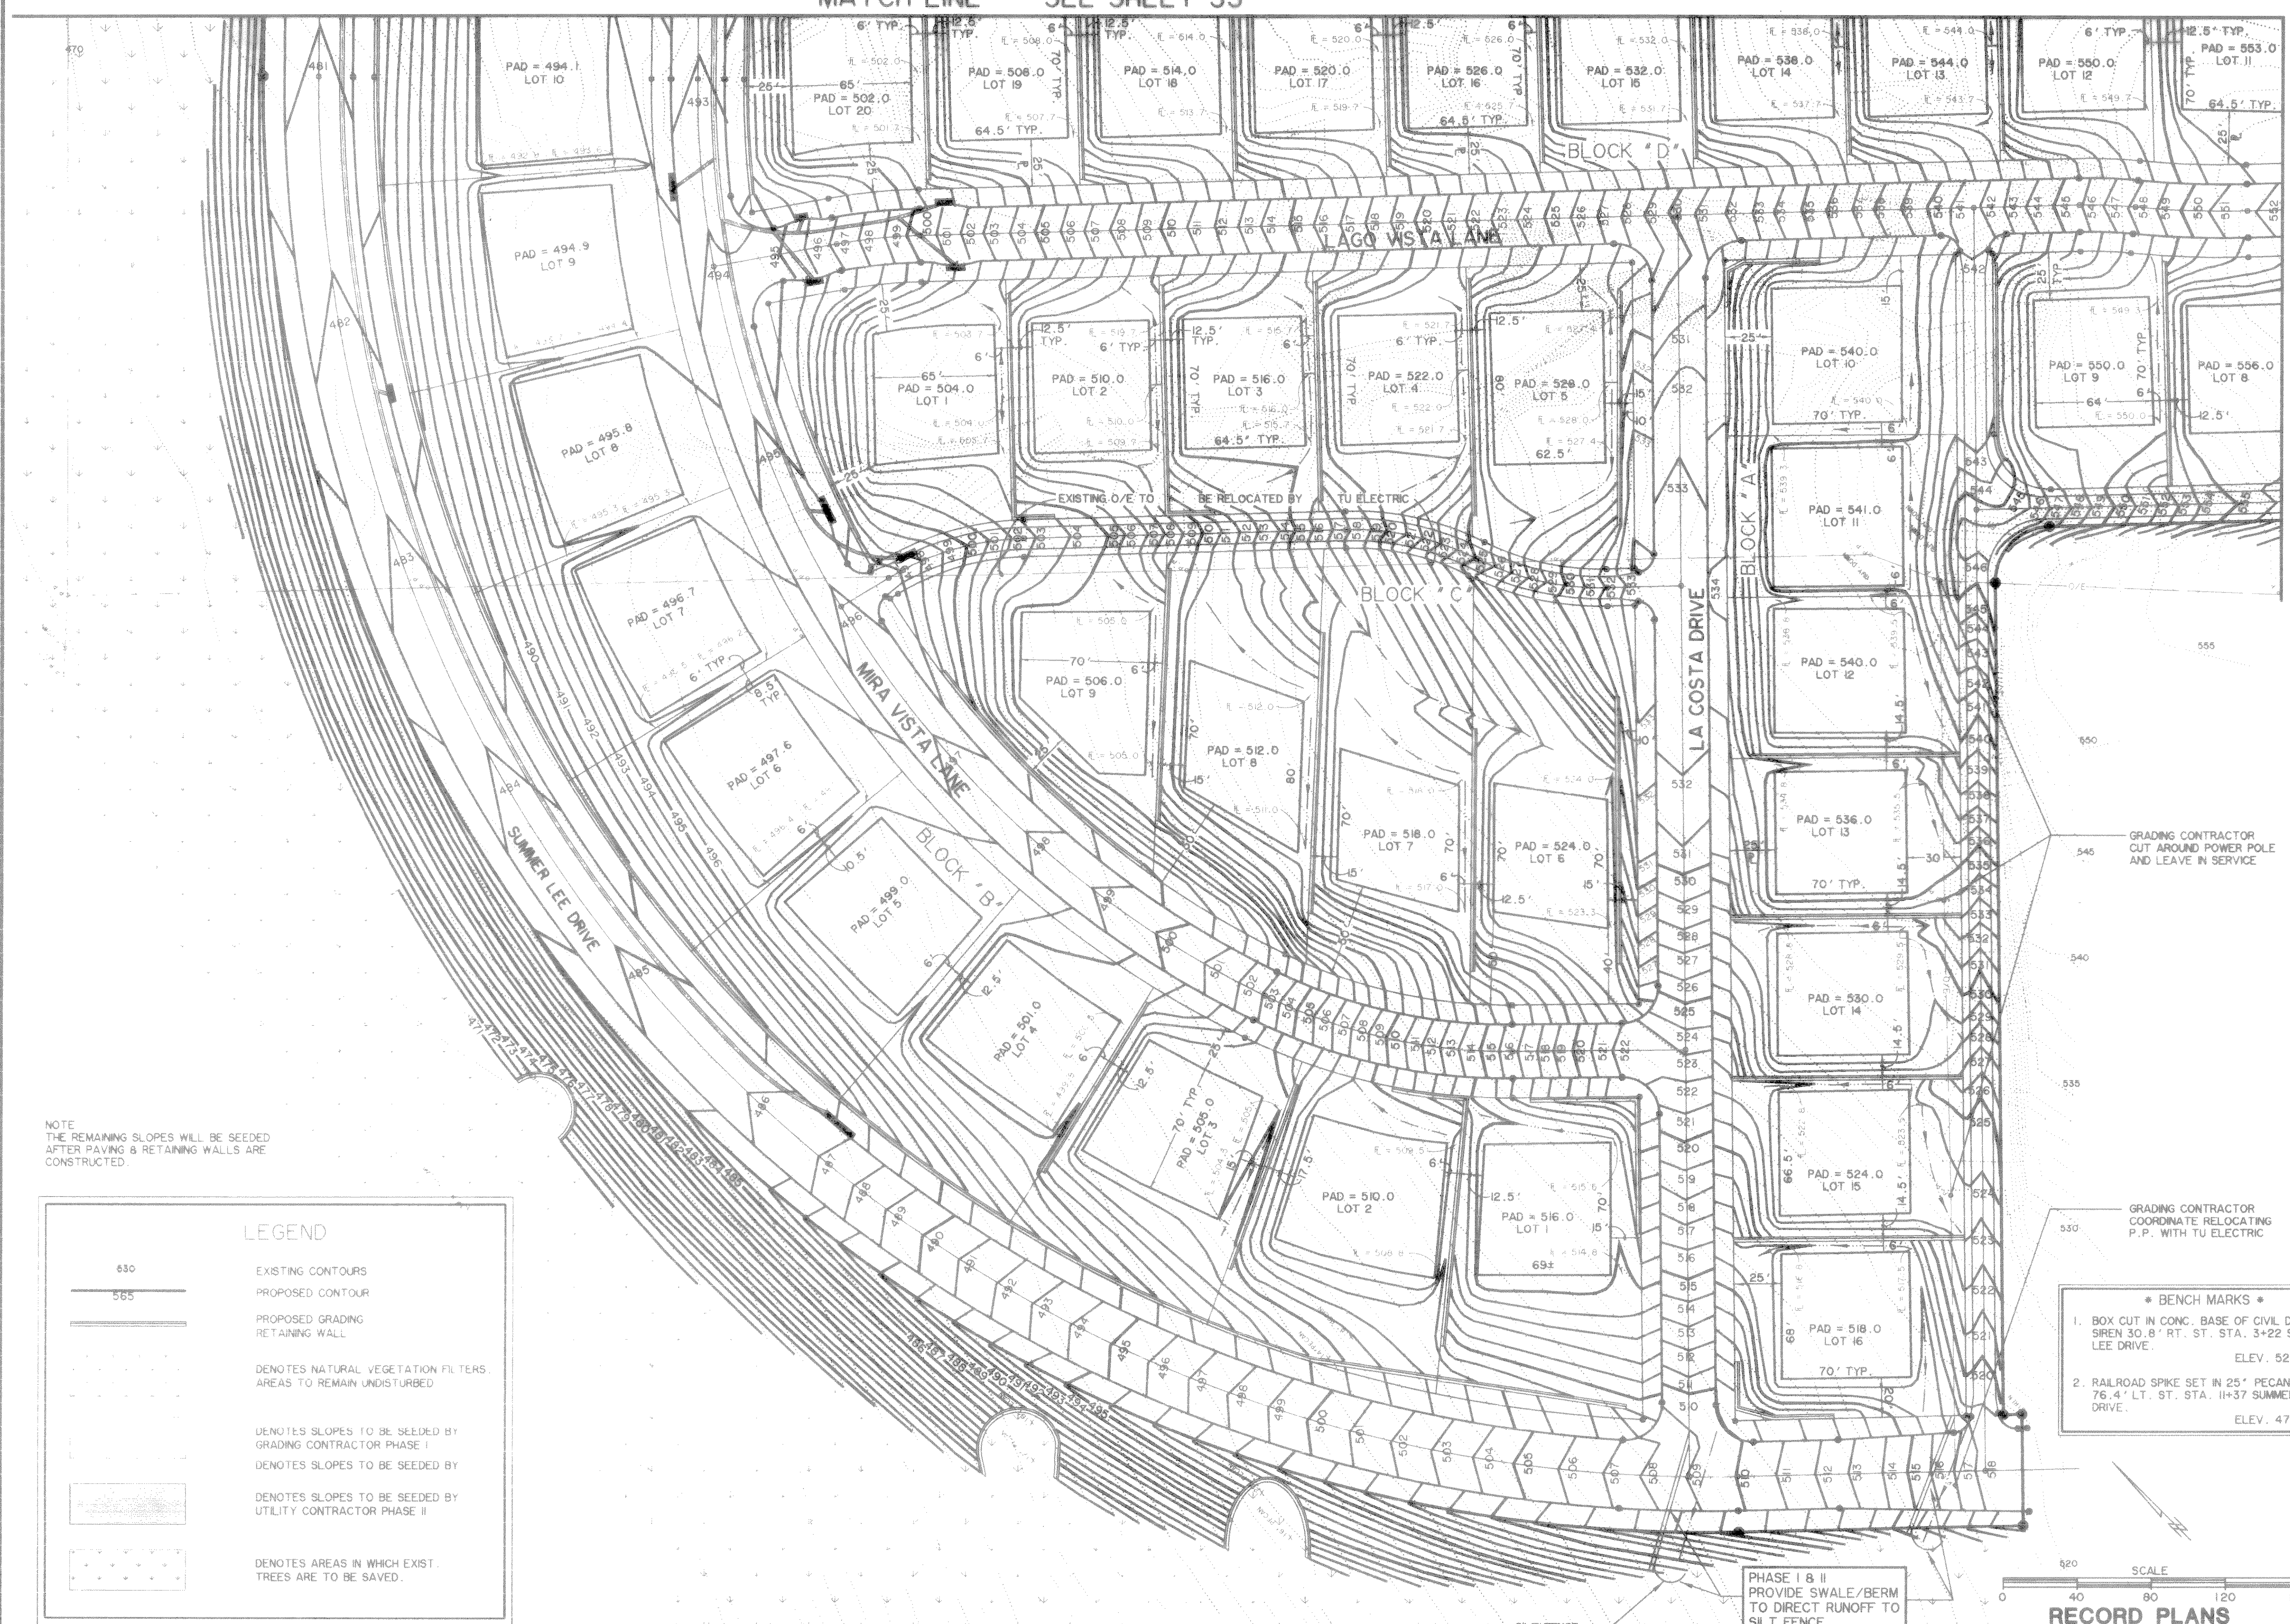

NOTE:  
 THE REMAINING SLOPES WILL BE SEEDED  
 AFTER PAVING & RETAINING WALLS ARE  
 CONSTRUCTED.

**LEGEND**

- 650 EXISTING CONTOURS
- 565 PROPOSED CONTOUR
- PROPOSED GRADING RETAINING WALL
- DENOTES NATURAL VEGETATION FILTERS AREAS TO REMAIN UNDISTURBED
- DENOTES SLOPES TO BE SEEDED BY GRADING CONTRACTOR PHASE I
- DENOTES SLOPES TO BE SEEDED BY UTILITY CONTRACTOR PHASE II
- DENOTES AREAS IN WHICH EXIST. TREES ARE TO BE SAVED.

- \* BENCH MARKS \***
1. BOX CUT IN CONC. BASE OF CIVIL DEFENSE SIREN 30.8' RT. ST. STA. 3+22 SUMMER LEE DRIVE. ELEV. 520.33
  2. RAILROAD SPIKE SET IN 25' PECAN TREE 76.4' LT. ST. STA. 11+37 SUMMER LEE DRIVE. ELEV. 471.34

PHASE I & II  
 PROVIDE SWALE/BERM  
 TO DIRECT RUNOFF TO  
 SILT FENCE.



**RECORD PLANS  
 12-18-95**