
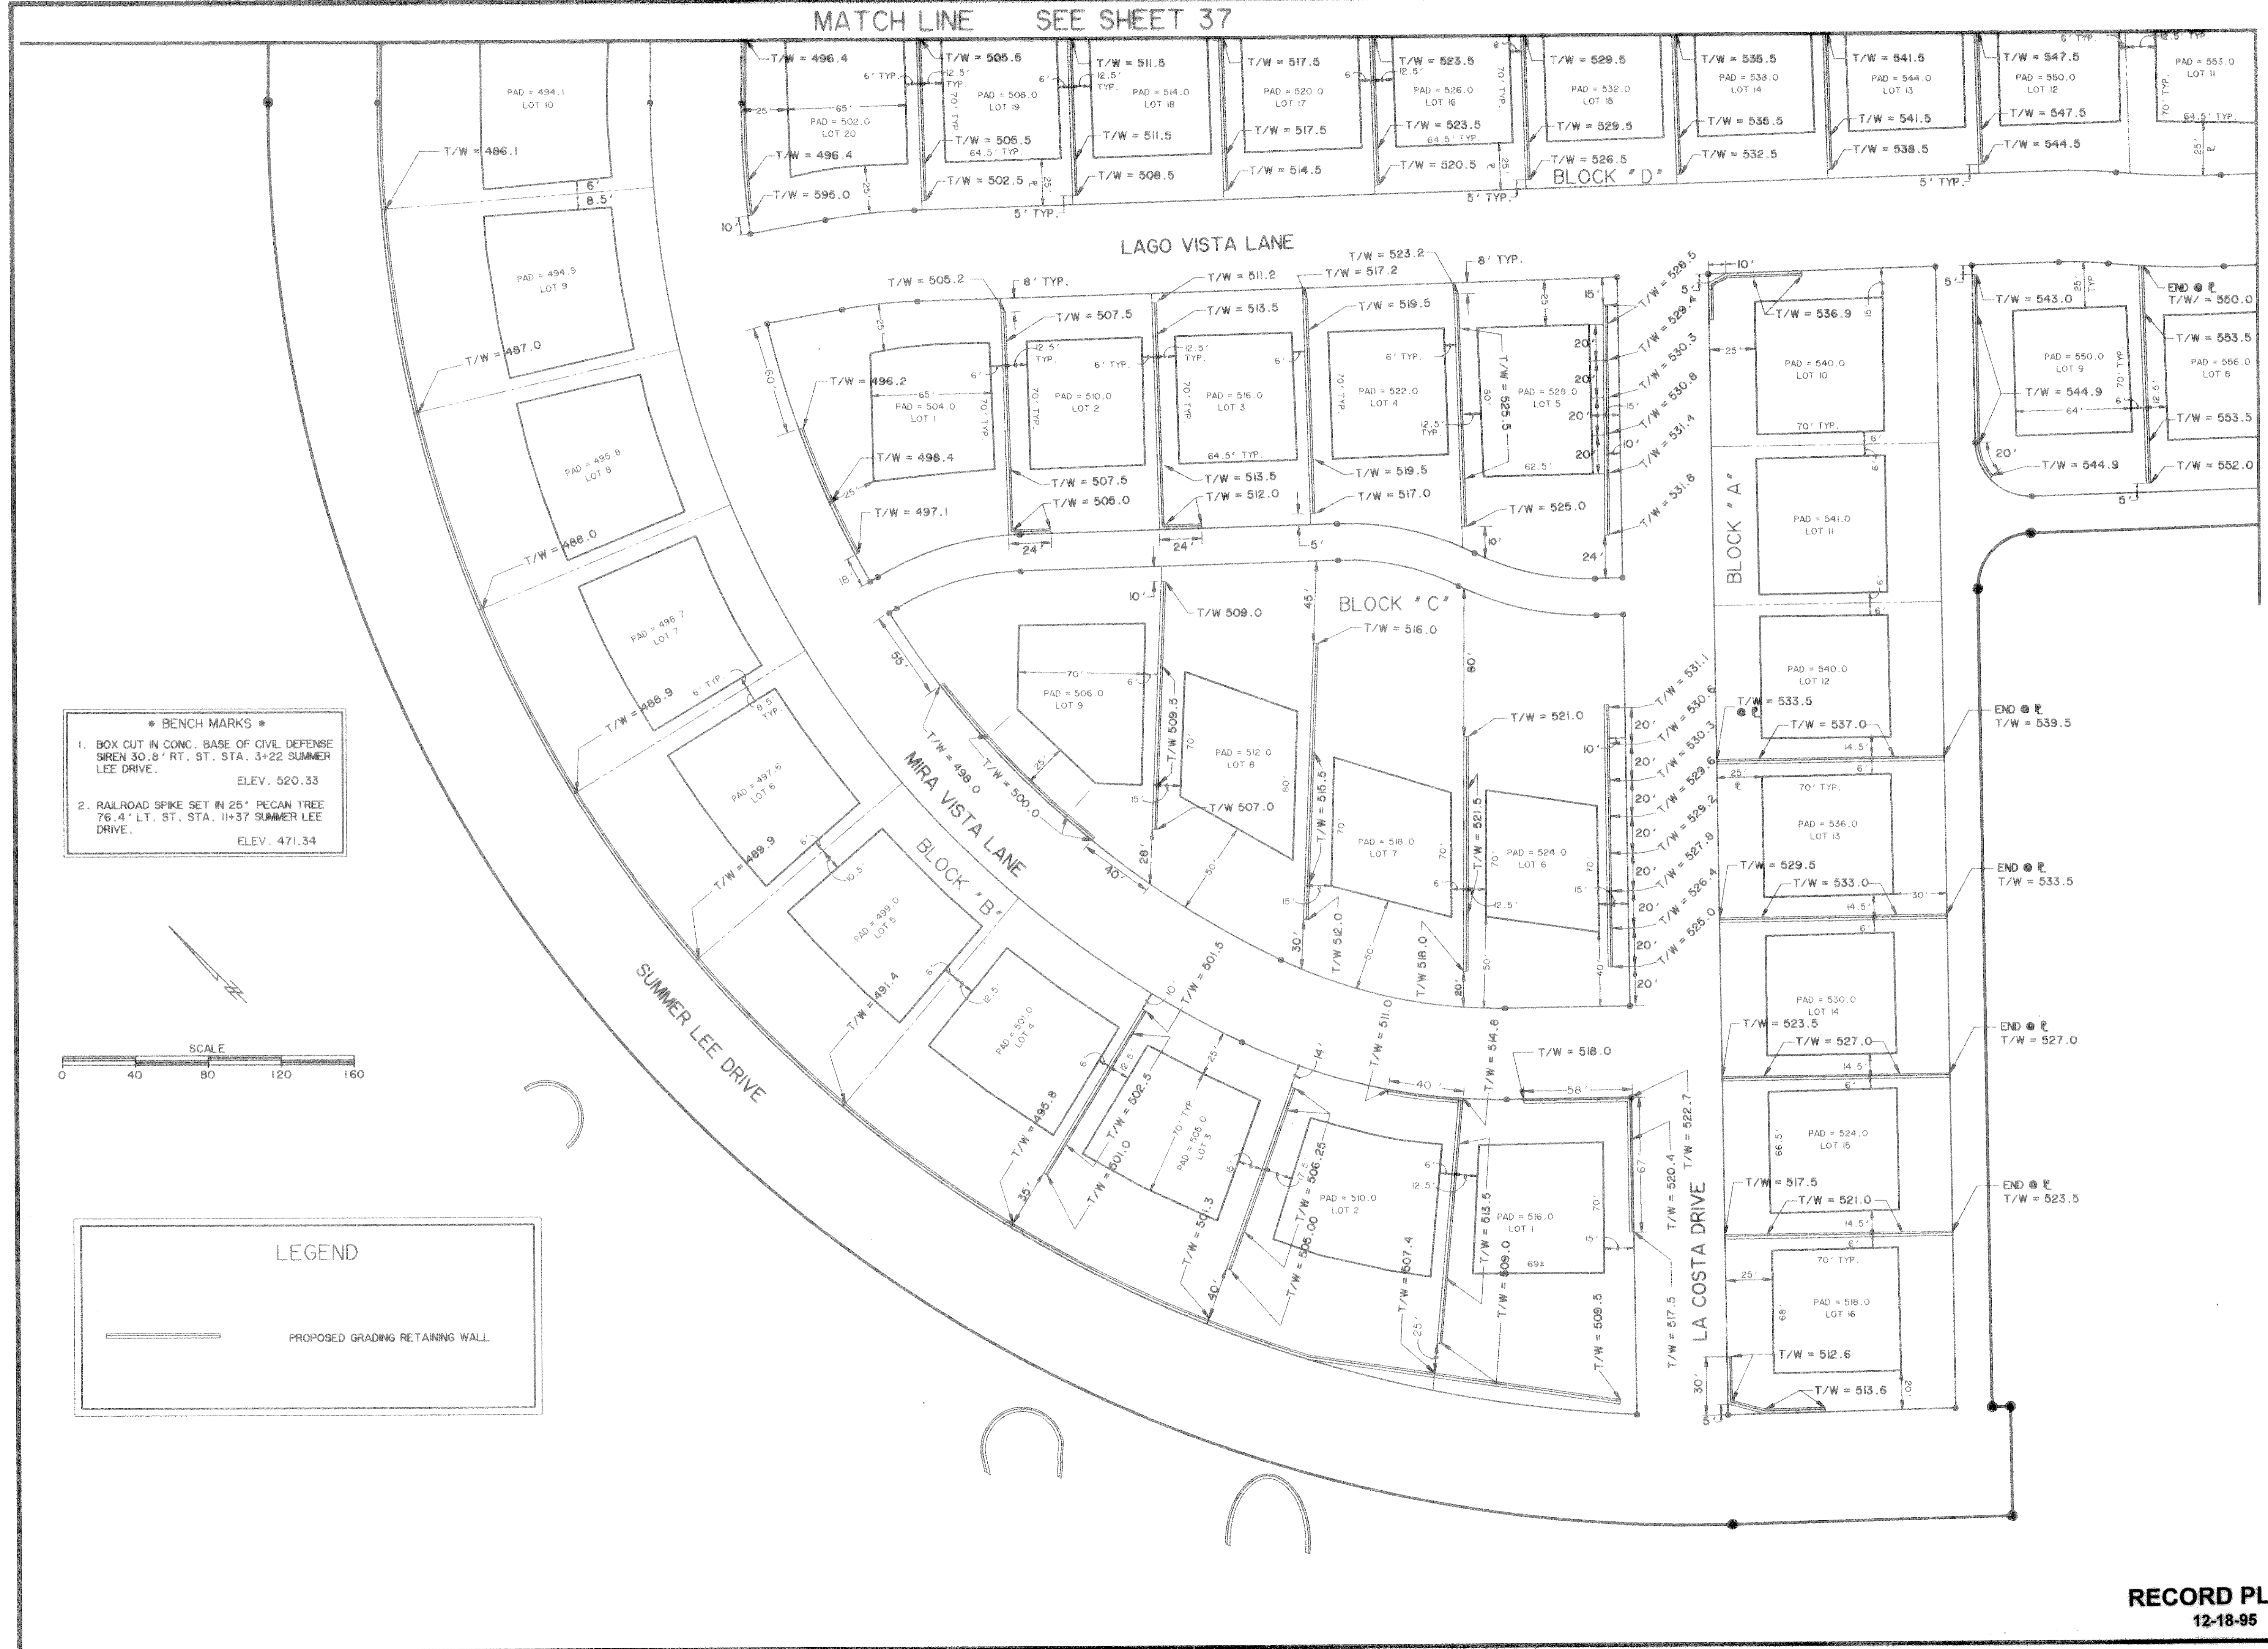
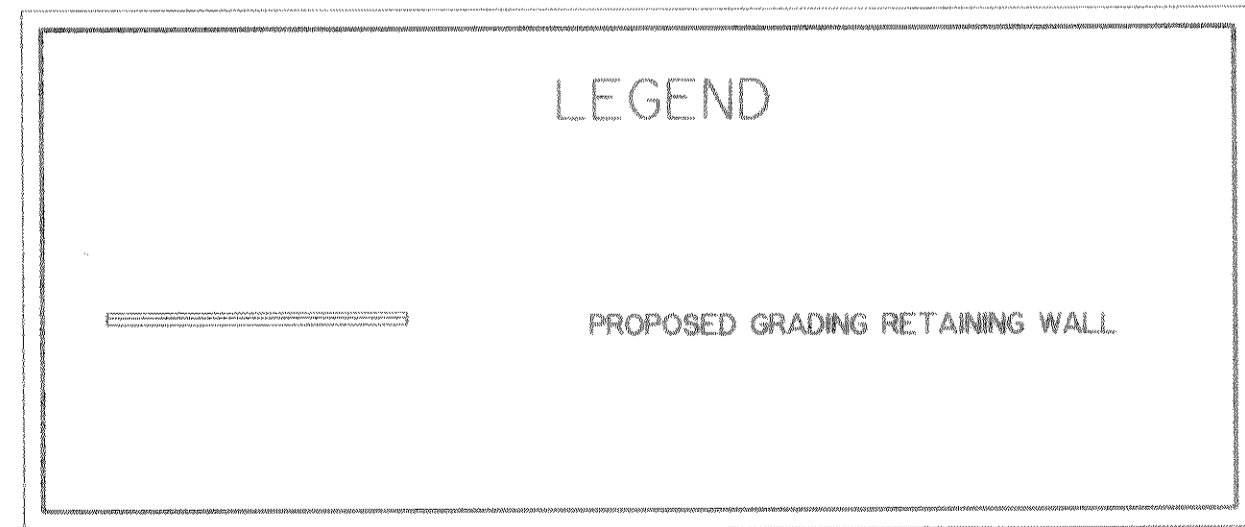


MATCH LINE SEE SHEET 37

MATCH LINE SEE SHEET 35


- * BENCH MARKS *
1. BOX CUT IN CONC. BASE OF CIVIL DEFENSE SIREN 30.8' RT. ST. STA. 3+22 SUMMER LEE DRIVE. ELEV. 520.33
 2. RAILROAD SPIKE SET IN 25" PECAN TREE 76.4' LT. ST. STA. 11+37 SUMMER LEE DRIVE. ELEV. 471.34

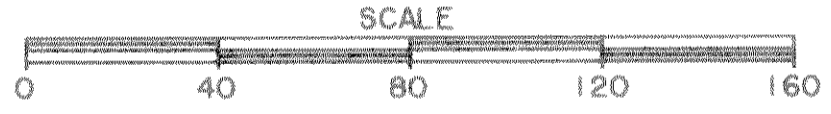

PREPARED BY:
WIA WIER & ASSOCIATES, INC.
 ENGINEERS SURVEYORS LAND PLANNERS
 4300 BELLEVUE PLACE SUITE 130 ARLINGTON, TEXAS 76010 (817)467-7700
 3906 SOUTH FREEMAN FORT WORTH, TEXAS 76110 (817)926-0212

**CITY OF ROCKWALL
 ROCKWALL COUNTY, TEXAS**

**RETAINING WALL
 PLAN
 WEST**

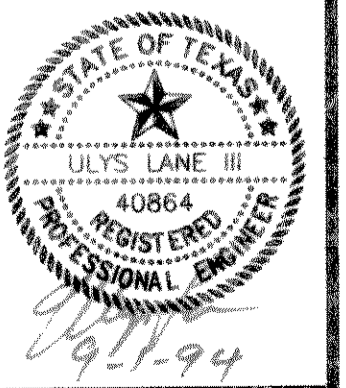

1991.94
 COPYRIGHT ©
 WIER & ASSOCIATES, INC.
 LAST SHEET EDIT
 DATE 08-30-94
 FILE RETWALL2
 WA# 93045
SHEET NO. 36

RECORD PLANS
 12-18-95