



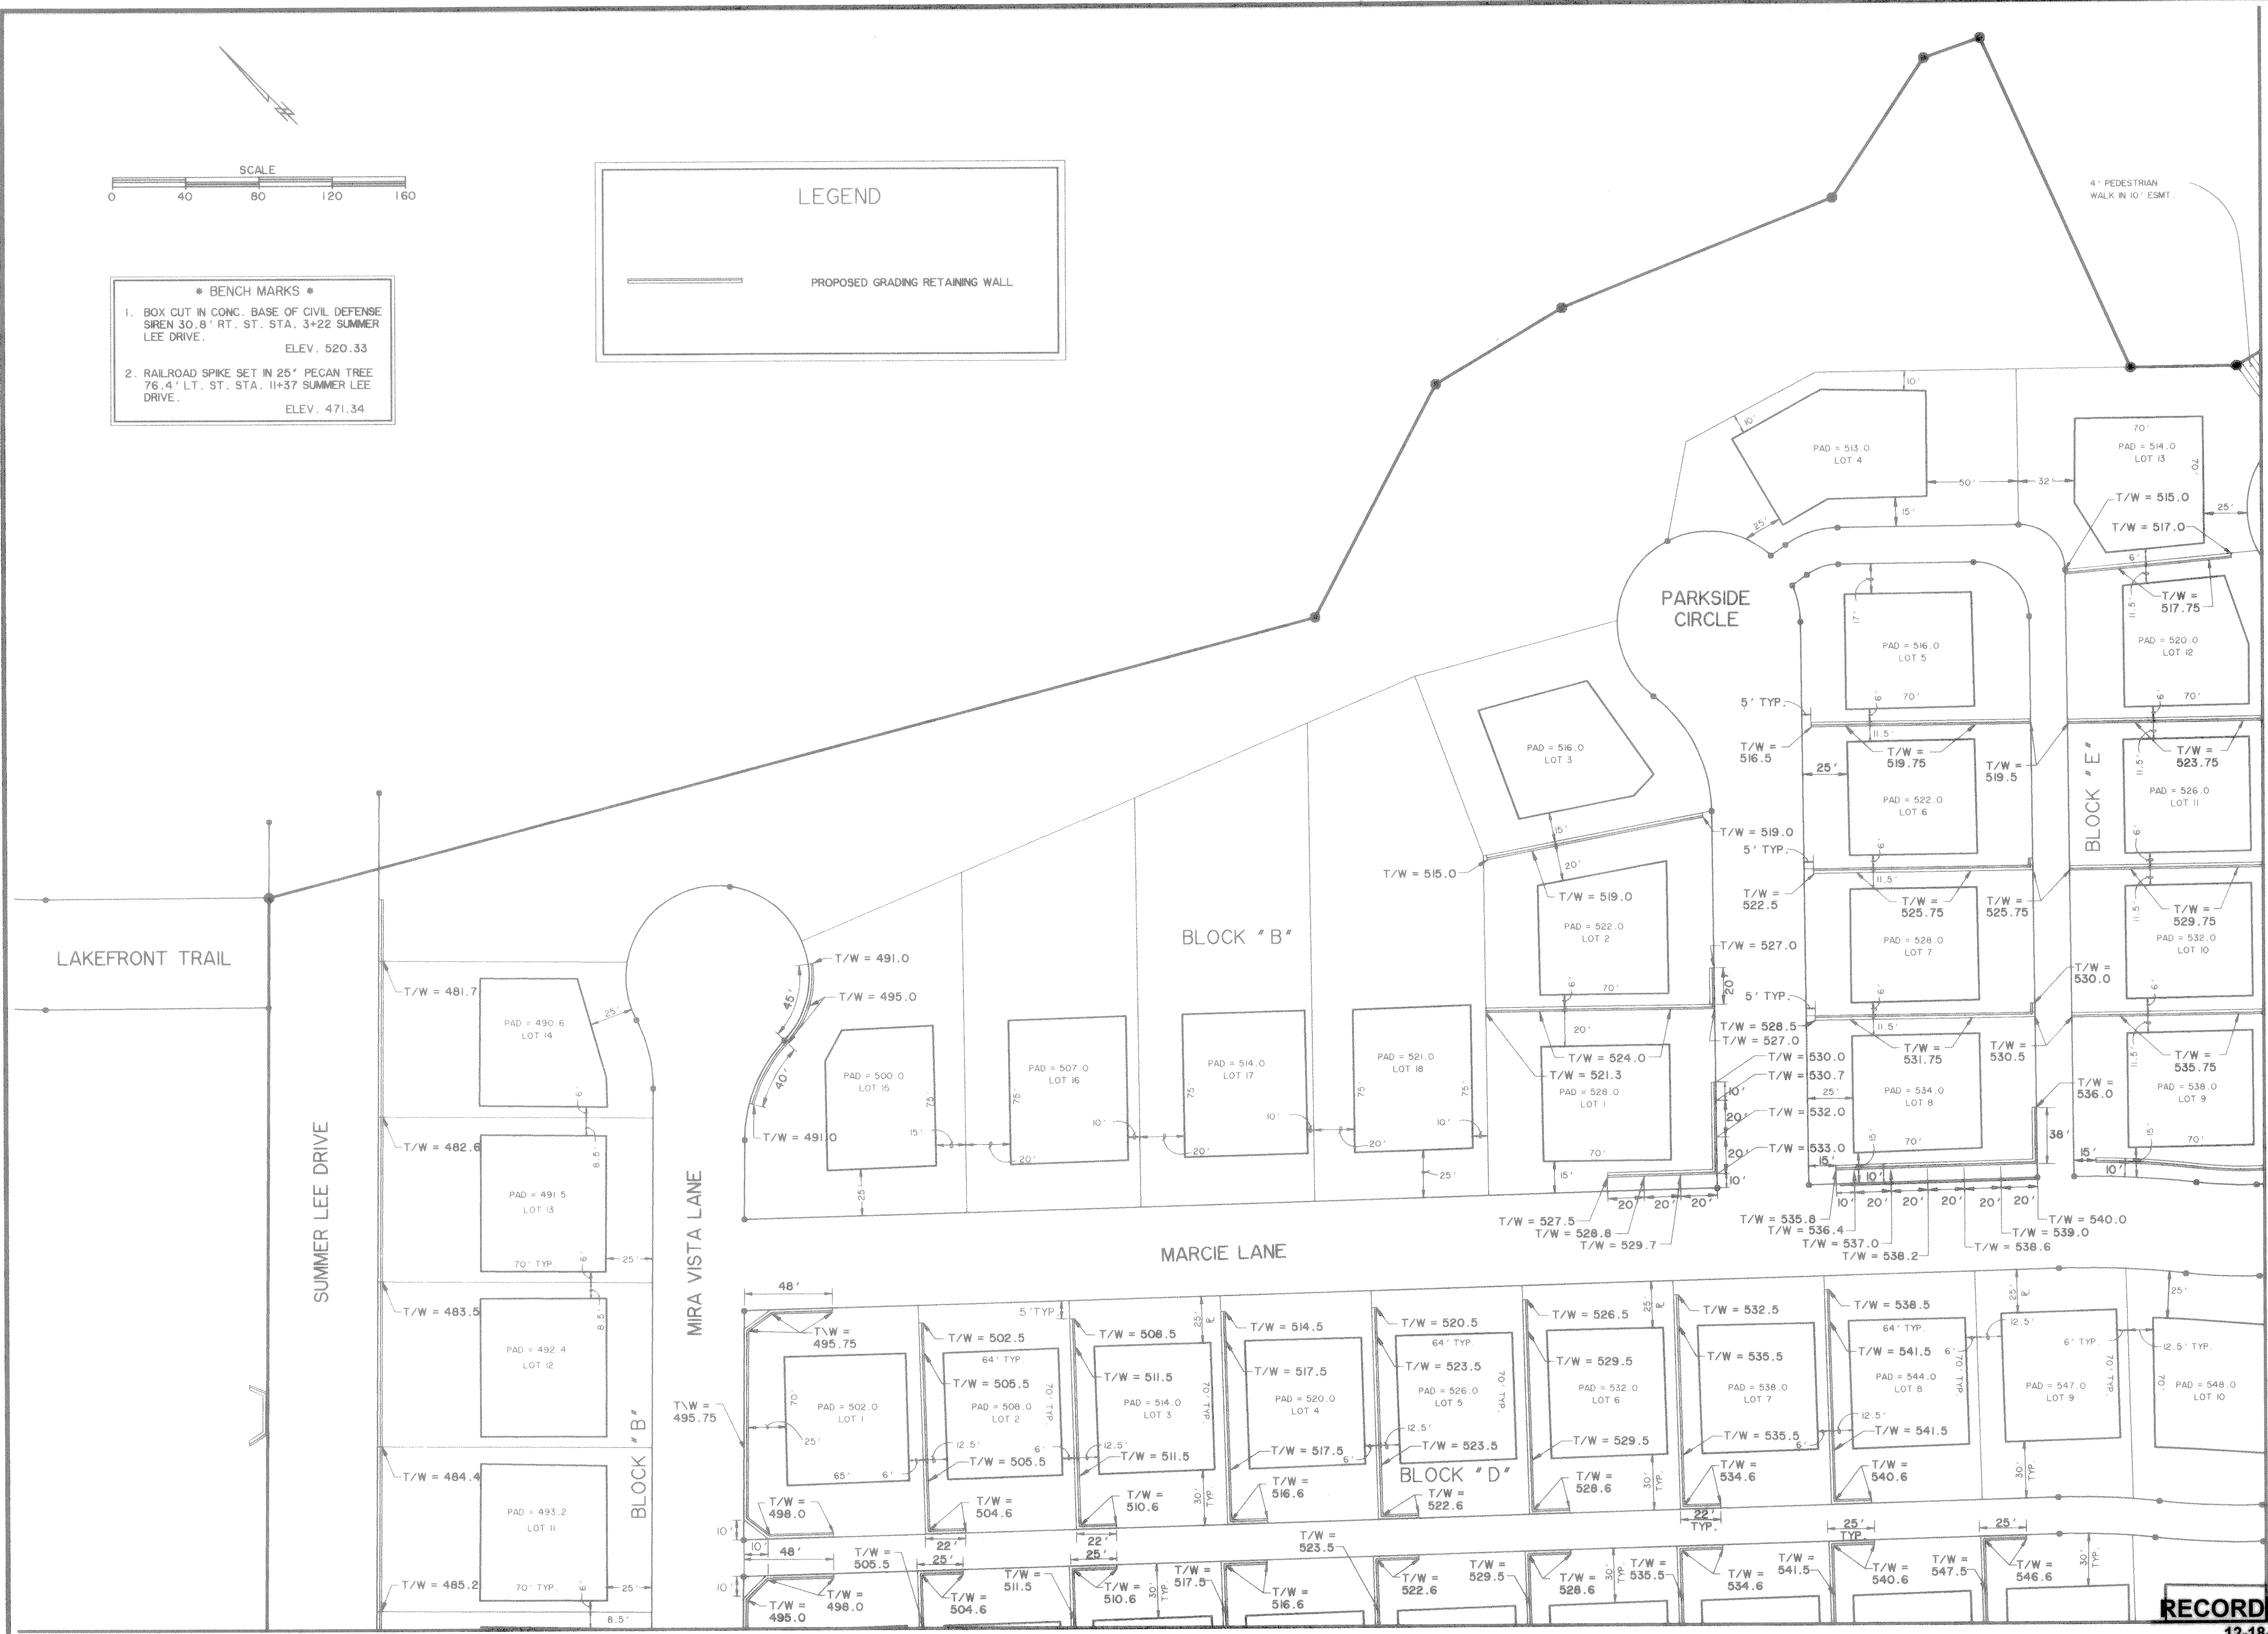

*** BENCH MARKS ***

1. BOX CUT IN CONC. BASE OF CIVIL DEFENSE SIREN 30.8' RT. ST. STA. 3+22 SUMMER LEE DRIVE. ELEV. 520.33
2. RAILROAD SPIKE SET IN 25" PECAN TREE 76.4' LT. ST. STA. 11+37 SUMMER LEE DRIVE. ELEV. 471.34

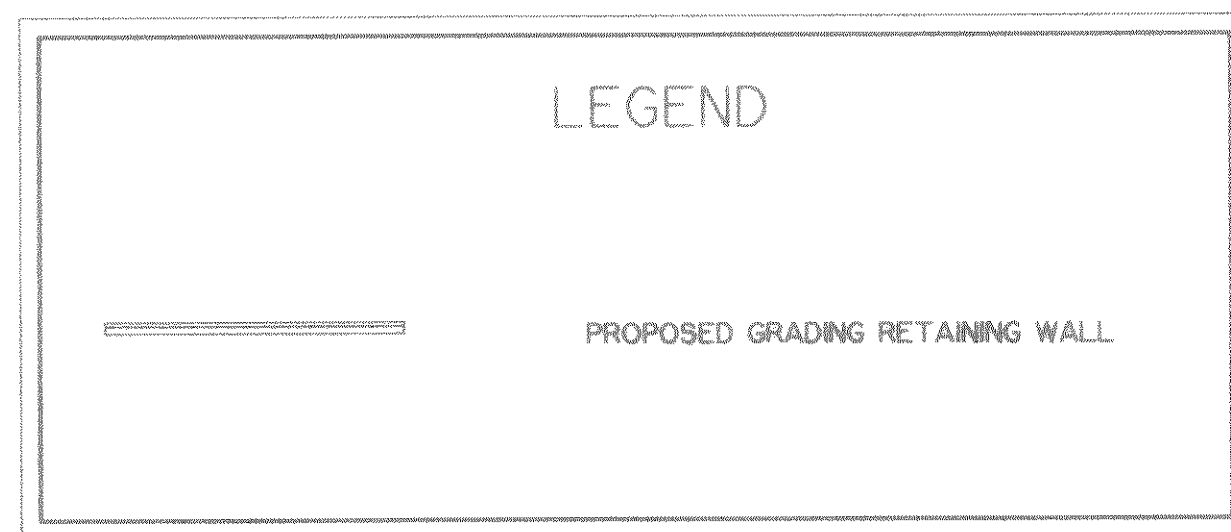


MATCH LINE SEE SHEET 35

MATCH LINE SEE SHEET 36

PREPARED BY:
VIA WIER & ASSOCIATES, INC.
 ENGINEERS SURVEYORS LAND PLANNERS
 4300 BELLEVUE PLACE SUITE 130 ARLINGTON, TEXAS 76010 (817) 461-7700
 3908 SOUTH FREWAY FORT WORTH, TEXAS 76110 (817) 926-0212

**CITY OF ROCKWALL
 ROCKWALL COUNTY, TEXAS**

**RETAINING WALL
 PLAN
 NORTH**

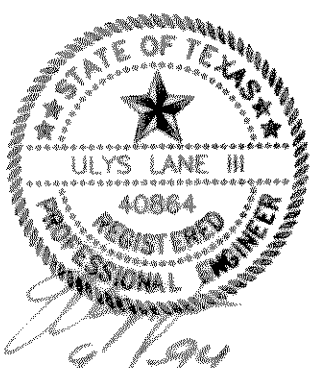

9.1.94
 COPYRIGHT ©
 WIER & ASSOCIATES, INC.
 LAST SHEET EDIT
 DATE 08-30-94
 FILE RETWALL5
 WA# 93049

RECORD PLANS

12-18-95

SHEET NO. 37