

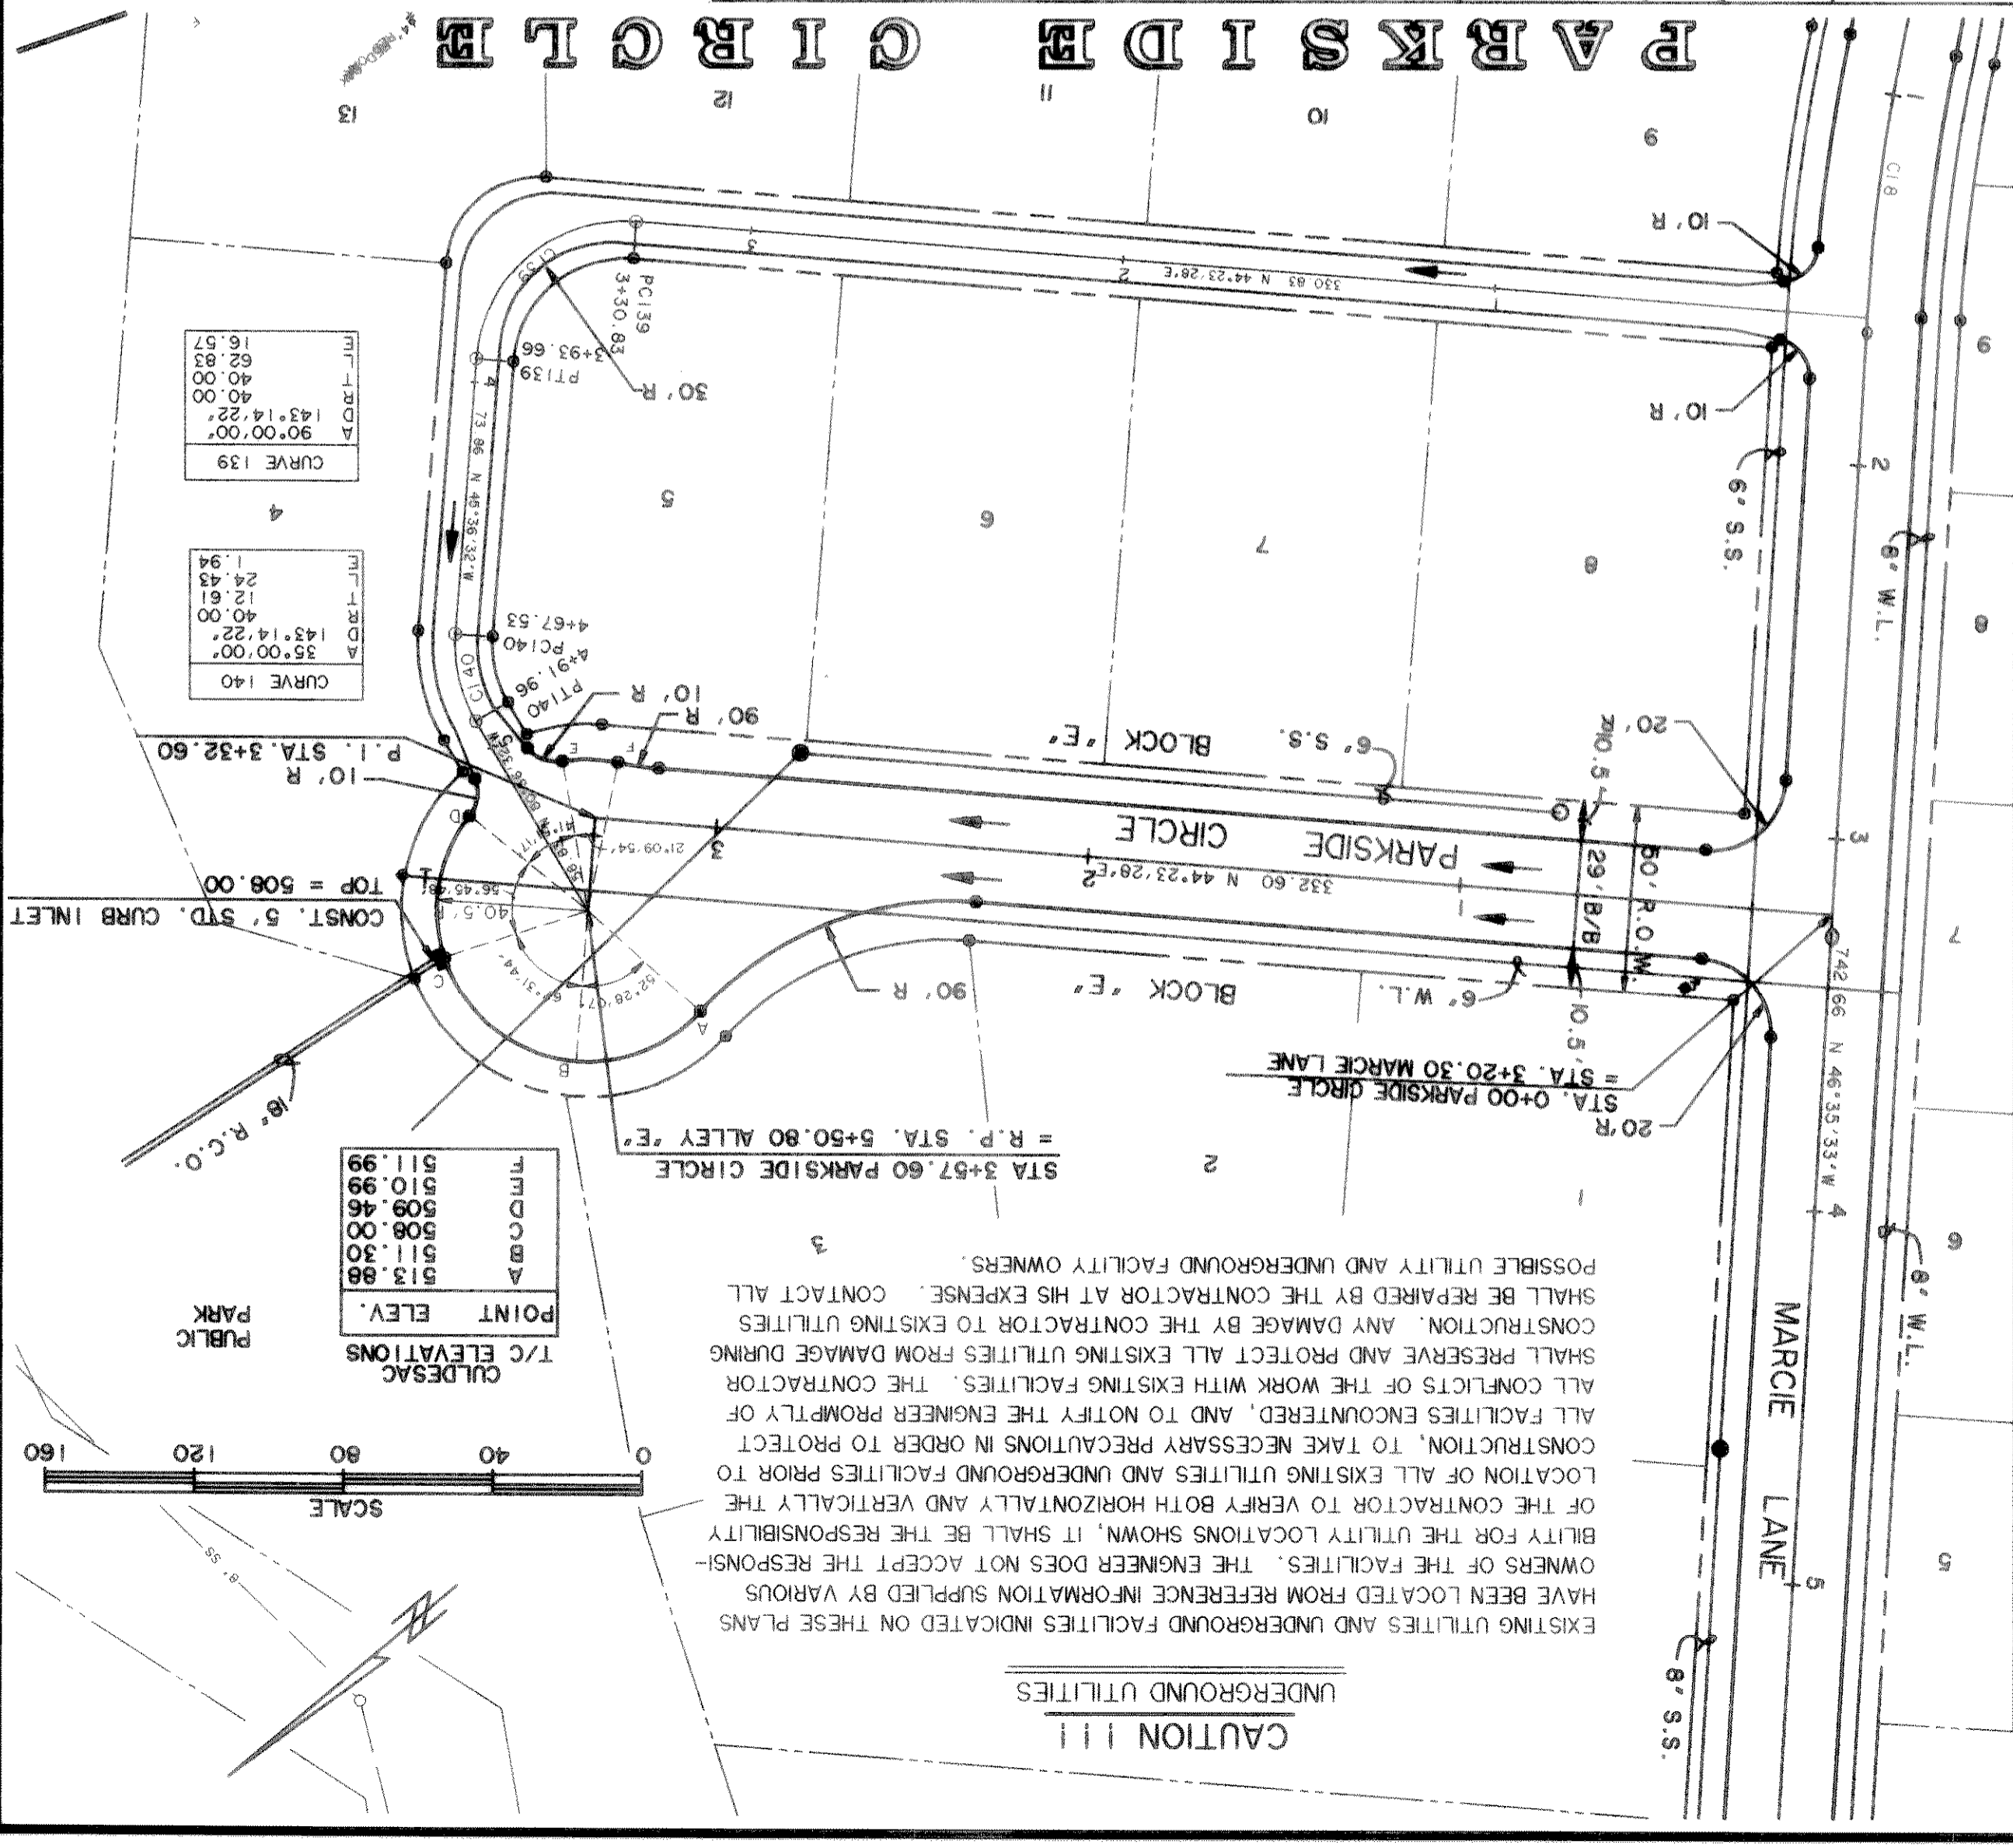


LEGEND
 DENOTES PERFORATED PIPE
 DENOTES SOLID PIPE

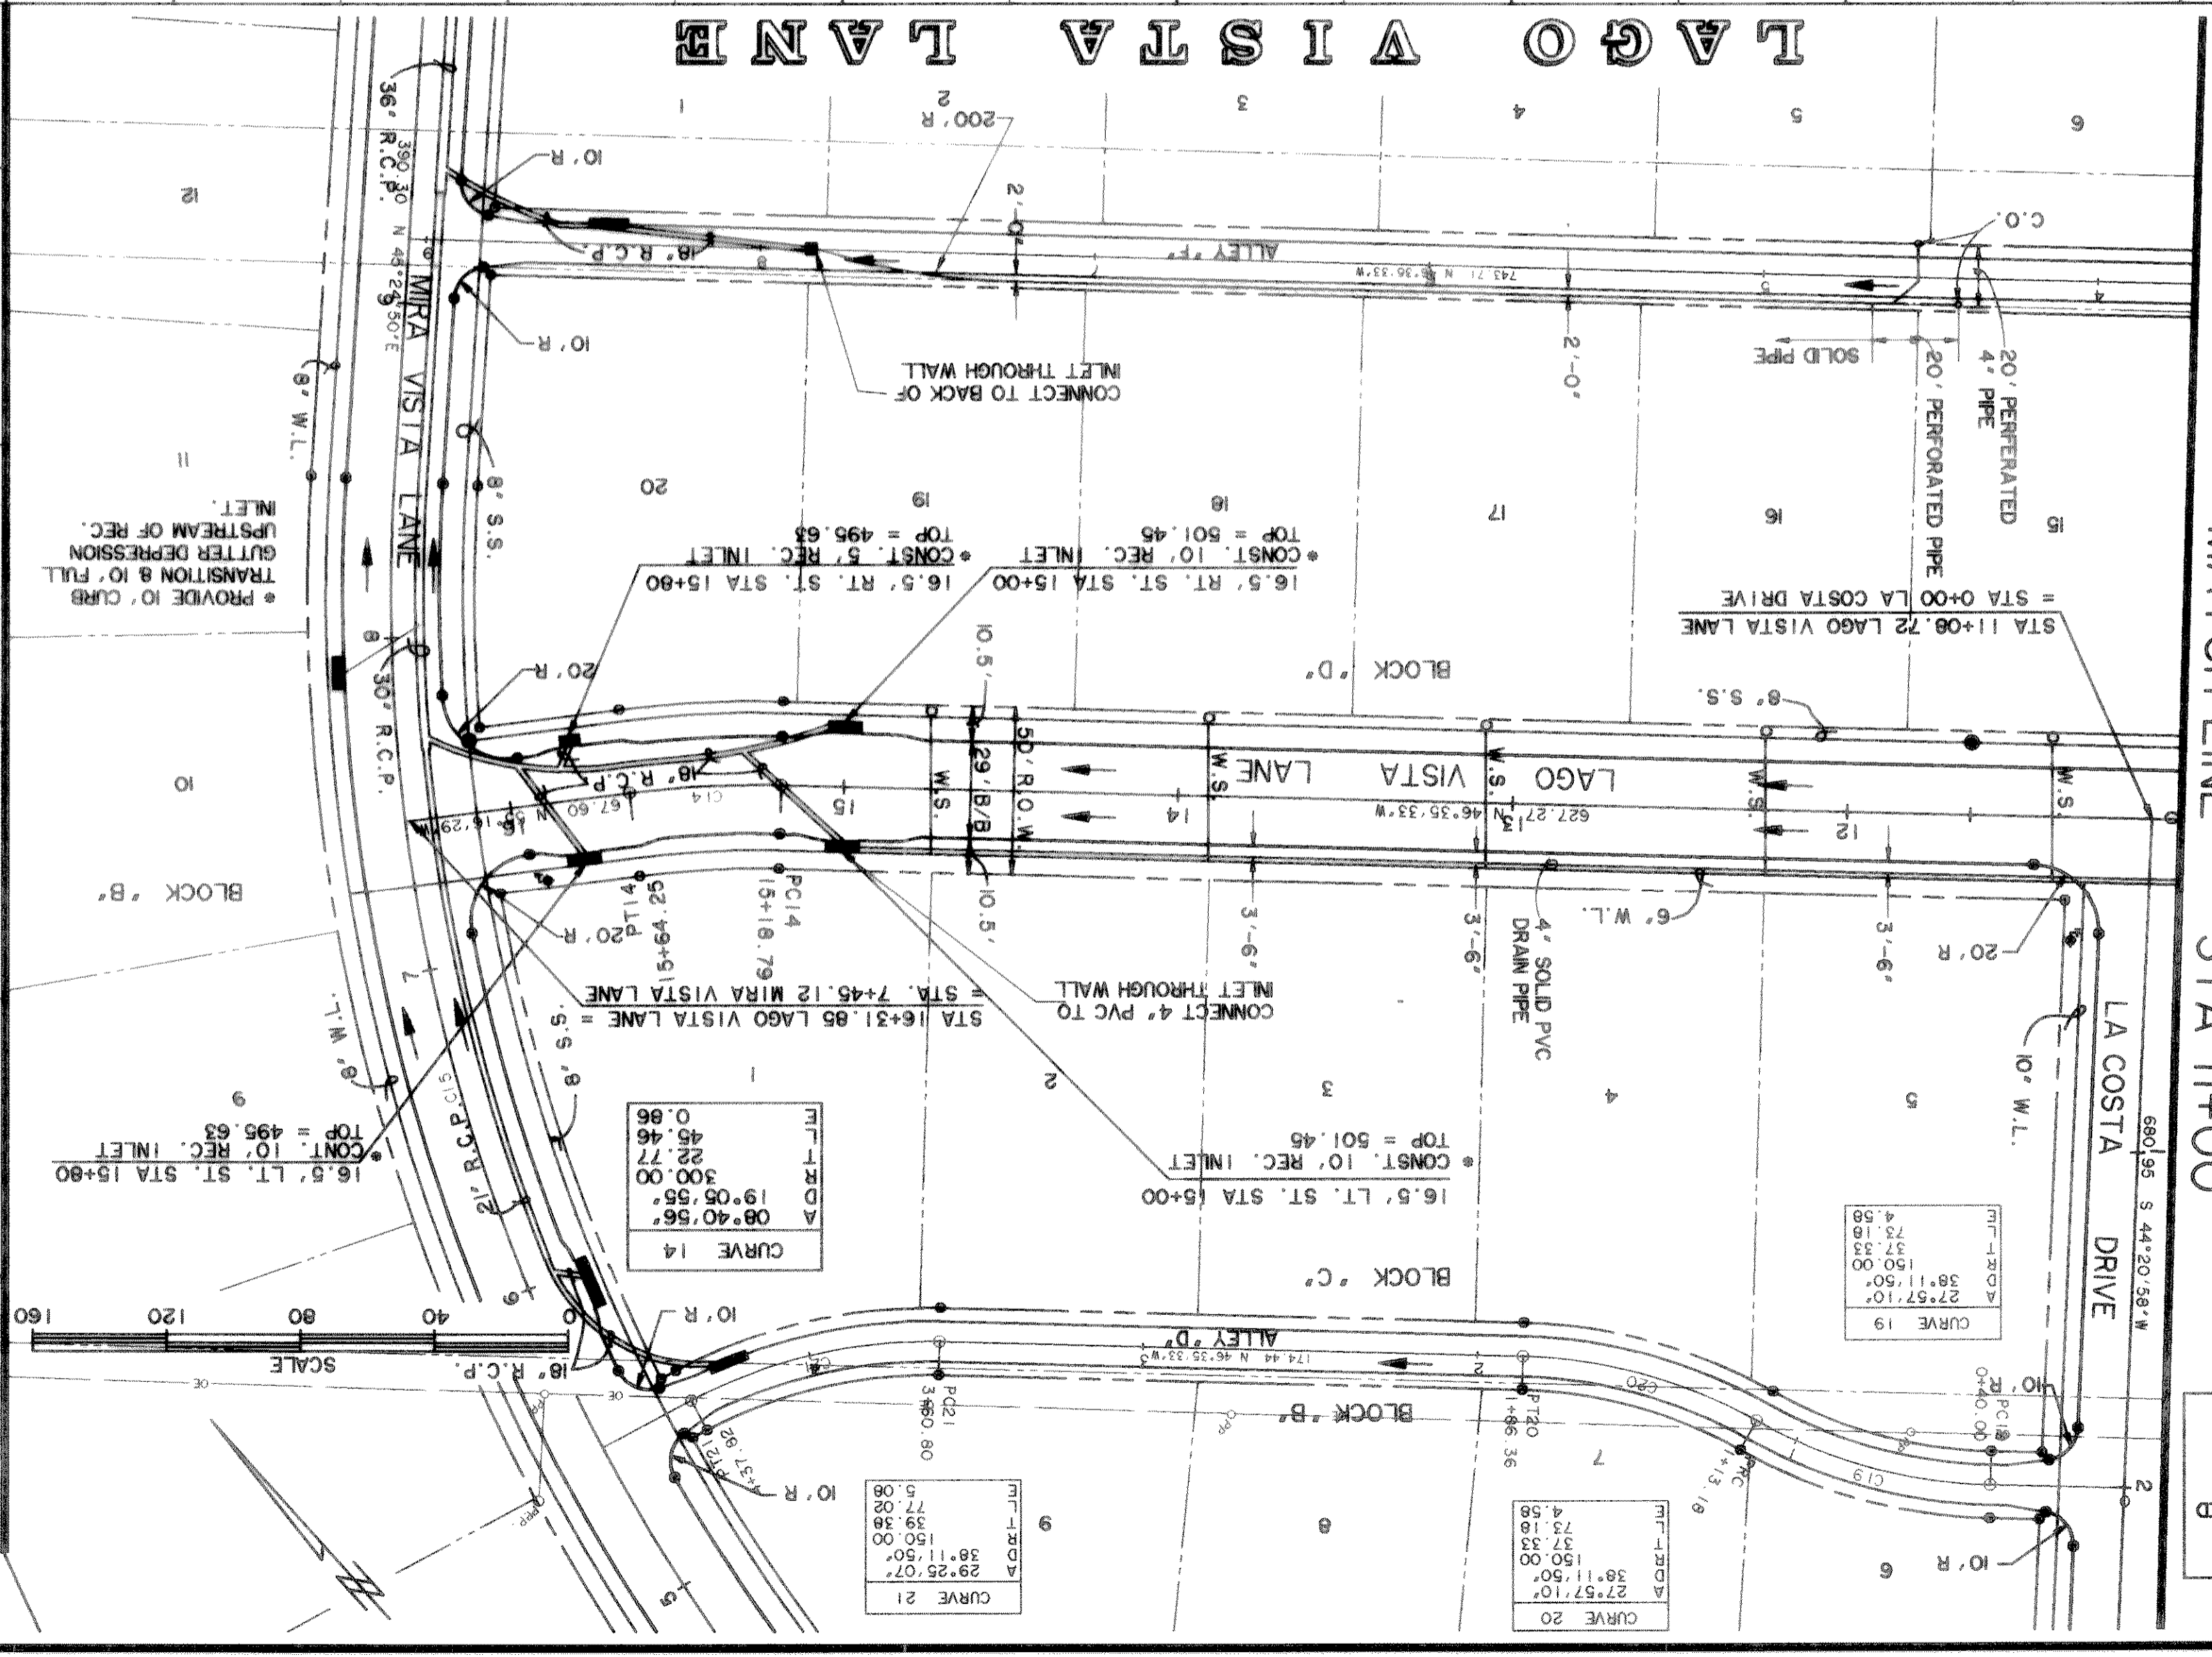

- * BENCH MARKS *
- 1. BOX CUT IN CONC. BASE OF CIVIL DEFENSE SIREN 30.8' RT. ST. STA. 3+22 SUMMER LEE DRIVE. ELEV. 520.33
- 2. RAILROAD SPIKE SET IN 25' PECAN TREE 76.4' LT. ST. STA. 1+37 SUMMER LEE DRIVE. ELEV. 471.34

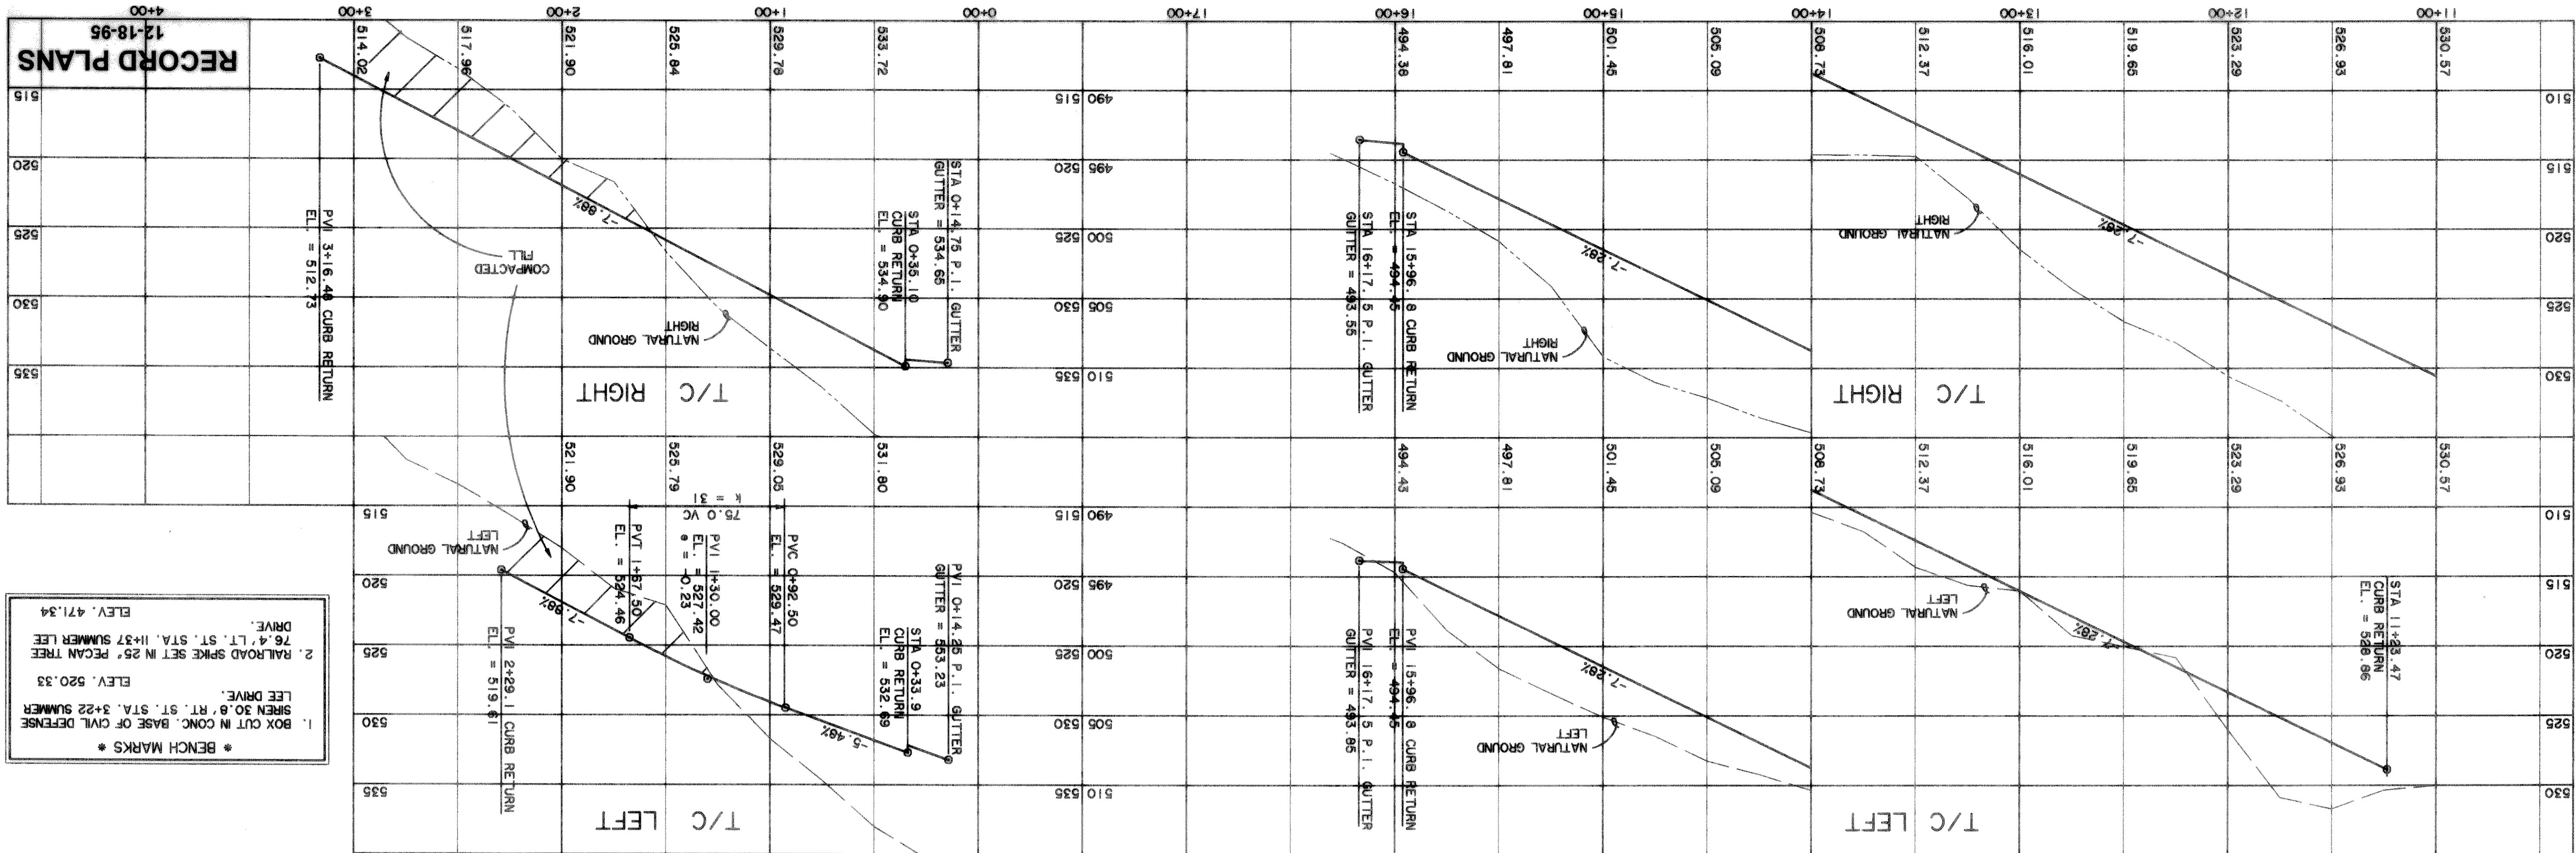

WIA WIER & ASSOCIATES, INC.
 ENGINEERS SURVEYORS LAND PLANNERS
 4300 BELTWAY PLACE SUITE 130 ARLINGTON TEXAS 76018 MEMO (817) 467-7700
 3808 SOUTH FRENCH FORT WORTH TEXAS 76110 (817) 925-0212

PLAN AND PROFILES
 LAGO VISTA LANE
 STA. 11+00 TO END
 PARKSIDE CIRCLE
 STA. 0+00 TO END

CITY OF ROCKWALL
 ROCKWALL COUNTY, TEXAS

WIA WIER & ASSOCIATES, INC.
 PREPARED BY:
 ENGINEERS SURVEYORS LAND PLANNERS
 4300 BELTWAY PLACE SUITE 130 ARLINGTON TEXAS 76018 MEMO (817) 467-7700
 3808 SOUTH FRENCH FORT WORTH TEXAS 76110 (817) 925-0212