
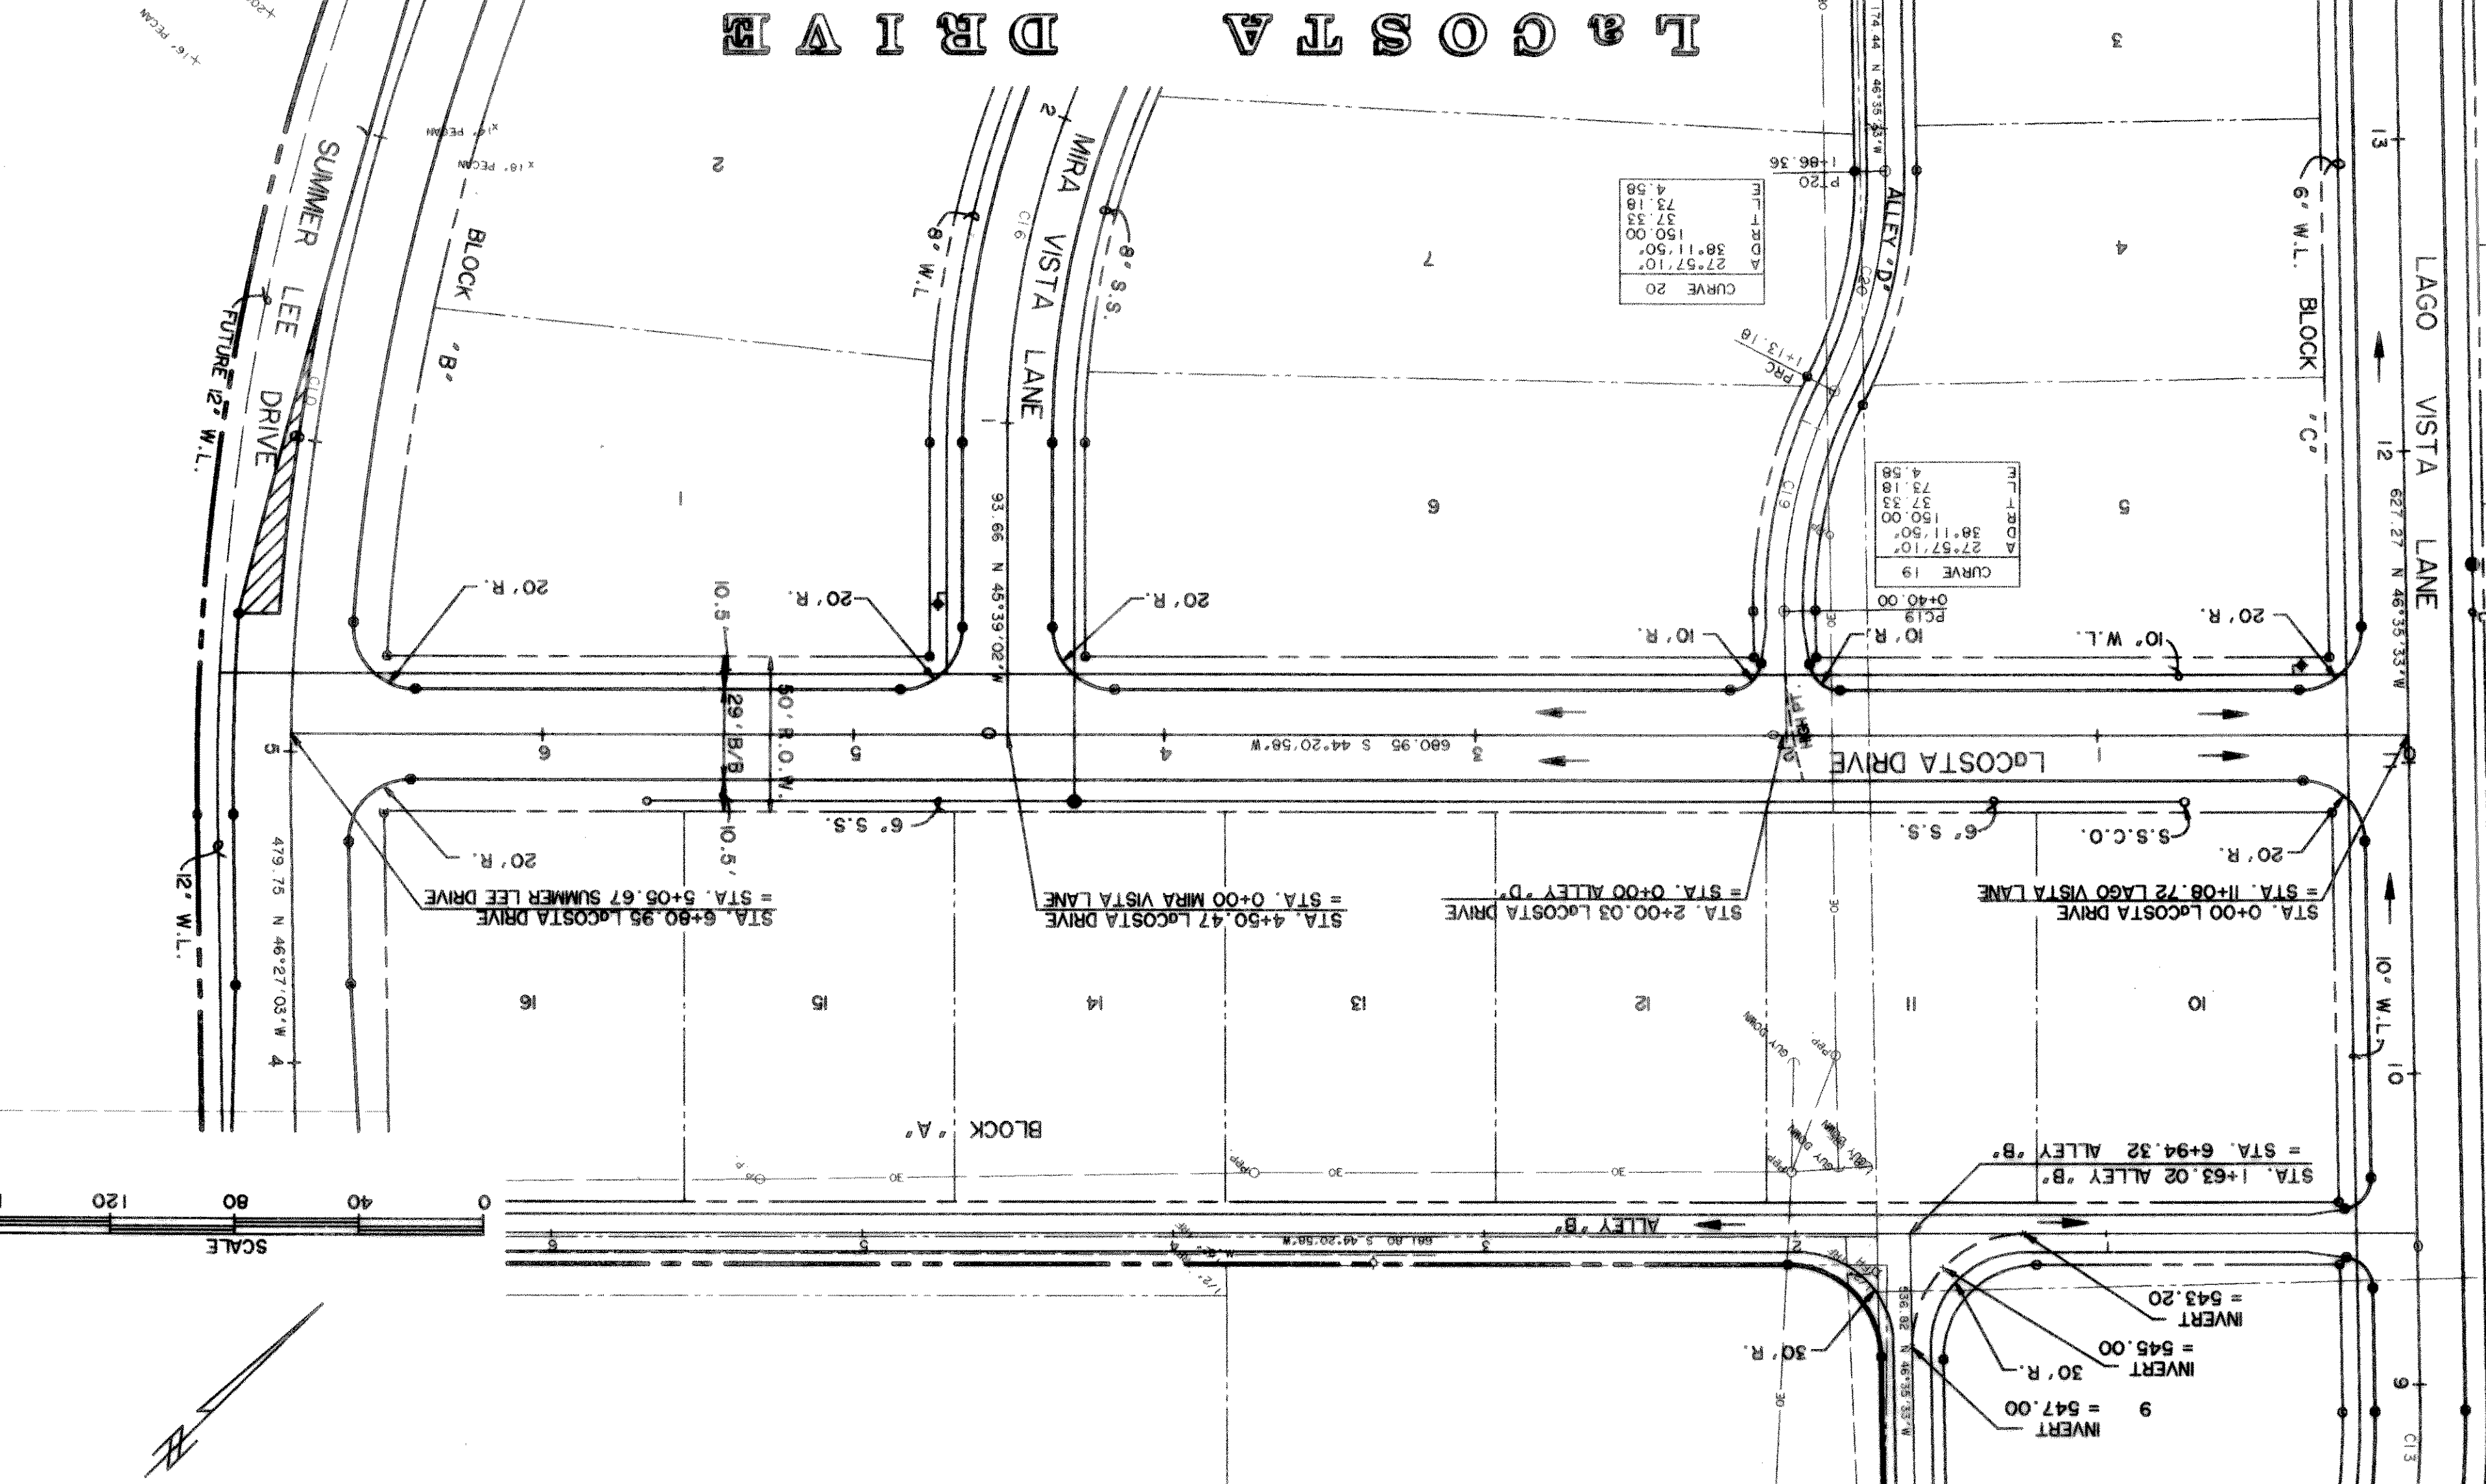


EXISTING UTILITIES AND UNDERGROUND FACILITIES INDICATED ON THESE PLANS HAVE BEEN LOCATED FROM REFERENCE INFORMATION SUPPLIED BY VARIOUS OWNERS OF THE FACILITIES. THE ENGINEER DOES NOT ACCEPT THE RESPONSIBILITY FOR THE UTILITY LOCATIONS SHOWN, IT SHALL BE THE RESPONSIBILITY OF THE CONTRACTOR TO VERIFY BOTH HORIZONTALLY AND VERTICALLY THE LOCATION OF ALL EXISTING UTILITIES AND UNDERGROUND FACILITIES PRIOR TO CONSTRUCTION. TO TAKE NECESSARY PRECAUTIONS IN ORDER TO PROTECT ALL FACILITIES ENCOUNTERED, AND TO NOTIFY THE ENGINEER PROMPTLY OF ALL CONFLICTS OF THE WORK WITH EXISTING FACILITIES. THE CONTRACTOR SHALL PRESERVE AND PROTECT ALL EXISTING UTILITIES FROM DAMAGE DURING CONSTRUCTION. ANY DAMAGE BY THE CONTRACTOR TO EXISTING UTILITIES SHALL BE REPAIRED BY THE CONTRACTOR AT HIS EXPENSE. CONTACT ALL POSSIBLE UTILITY AND UNDERGROUND FACILITY OWNERS.

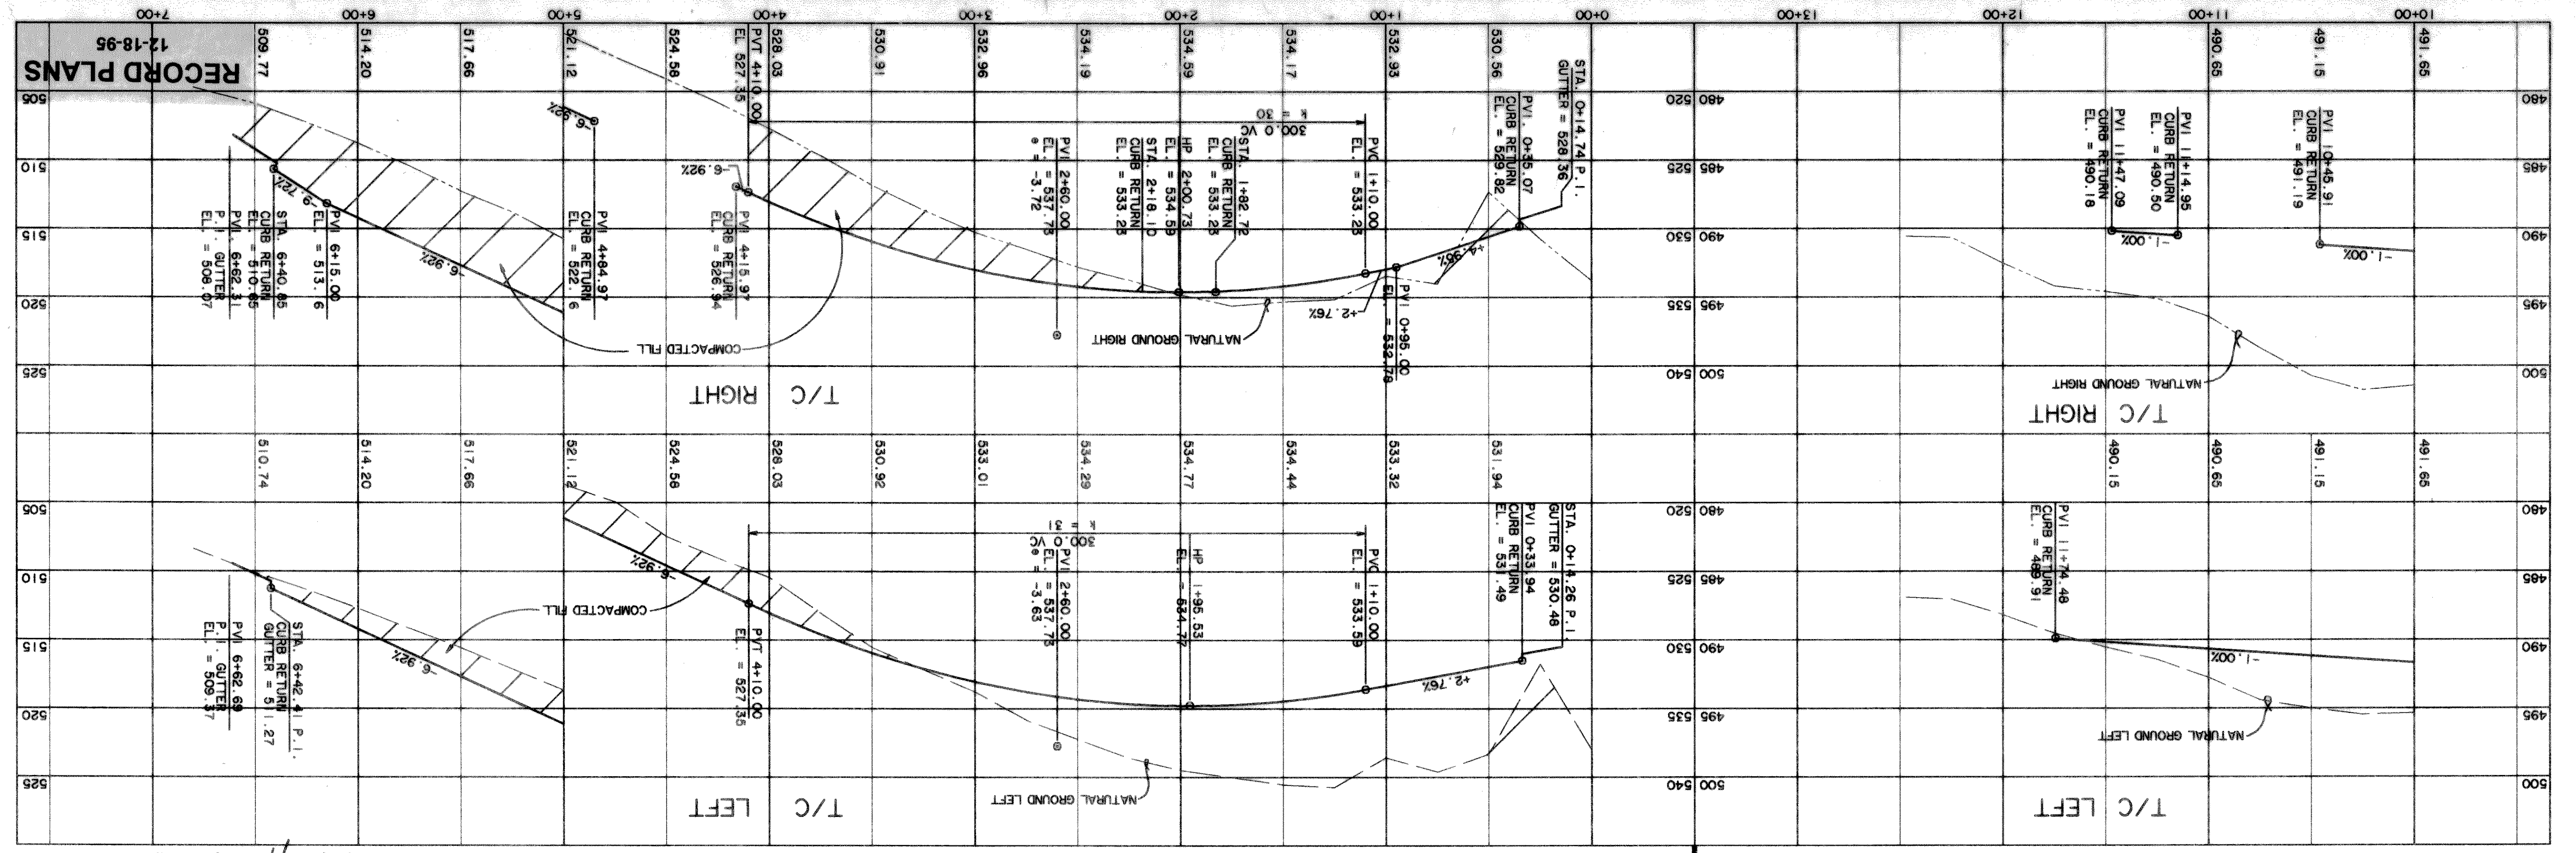

SHEET NO. 13

DATE: 08-31-95

LAST SHEET

W&A ASSOCIATES, INC.

REGISTERED PROFESSIONAL ENGINEER

NO. 40864

STATE OF TEXAS

PLAN AND PROFILES

MIRA VISTA LANE

STA. 10+00 TO STA. END

LACOSTA DRIVE

STA. 0+00 TO STA. END

CITY OF ROCKWALL

ROCKWALL COUNTY, TEXAS

PREPARED BY:

W&A WIER & ASSOCIATES, INC.

ENGINEERS SURVEYORS LAND PLANNERS

4300 BELTWAY PLACE SUITE 130 ARLINGTON, TEXAS 76010 (817)667-7700

3900 SOUTH FREEMAN FORT WORTH, TEXAS 76110 (817)928-0212