


- * BENCH MARKS *
1. BOX CUT IN CONC. BASE OF CIVIL DEFENSE SHELTER 30.8 RT. STA. 3+22 SUMMER LEE DRIVE. ELEV. 520.33
 2. RAILROAD SPIKE SET IN 25' PECAN TREE 76.4 LT. ST. STA. 1+37 SUMMER LEE DRIVE. ELEV. 471.34

POINT	ELEV.
GIMCOB A	517.68
G	516.83
B	515.81
C	514.50
D	514.61
E	516.14

EXISTING UTILITIES AND UNDERGROUND FACILITIES INDICATED ON THESE PLANS HAVE BEEN LOCATED FROM REFERENCE INFORMATION SUPPLIED BY VARIOUS OWNERS OF THE FACILITIES. THE ENGINEER DOES NOT ACCEPT THE RESPONSIBILITY FOR THE UTILITY LOCATIONS SHOWN, IT SHALL BE THE RESPONSIBILITY OF THE CONTRACTOR TO VERIFY BOTH HORIZONTALLY AND VERTICALLY THE LOCATION OF ALL EXISTING UTILITIES AND UNDERGROUND FACILITIES PRIOR TO CONSTRUCTION. TO TAKE NECESSARY PRECAUTIONS IN ORDER TO PROTECT ALL FACILITIES ENCOUNTERED, AND TO NOTIFY THE ENGINEER PROMPTLY OF ALL CONFLICTS OF THE WORK WITH EXISTING FACILITIES. THE CONTRACTOR SHALL PRESERVE AND PROTECT ALL EXISTING UTILITIES FROM DAMAGE DURING CONSTRUCTION. ANY DAMAGE BY THE CONTRACTOR TO EXISTING UTILITIES SHALL BE REPAIRED BY THE CONTRACTOR AT HIS EXPENSE. CONTACT ALL POSSIBLE UTILITY AND UNDERGROUND FACILITY OWNERS.

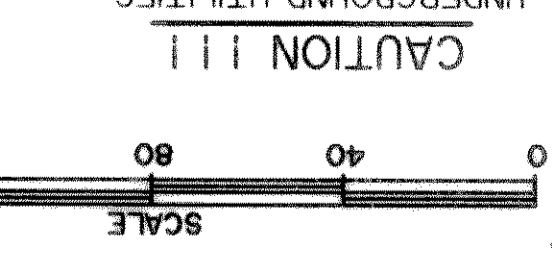

14 SHEET NO.
WA# 93049
D.L. WIER & ASSOCIATES, INC.
1100 BELLEVUE BLVD., SUITE 130
MCKINNEY, TEXAS 75069
COPYRIGHT © 1995

SHADY GROVE CIRCLE
PLAN AND PROFILES
STA. 0+00 TO STA. END

CITY OF ROCKWALL
ROCKWALL COUNTY, TEXAS

PREPARED BY:
WIER & ASSOCIATES, INC.
ENGINEERS SURVEYORS LAND PLANNERS
4300 BELLEVUE PLACE, SUITE 130, MCKINNEY, TEXAS 75069
3908 SOUTH FREEMAN FORT WORTH, TEXAS 76110 (817)928-0212