



MAINTAIN 2% MAXIMUM
 CROSS SLOPE ON 15' EASEMENT
 FOR ACCESS

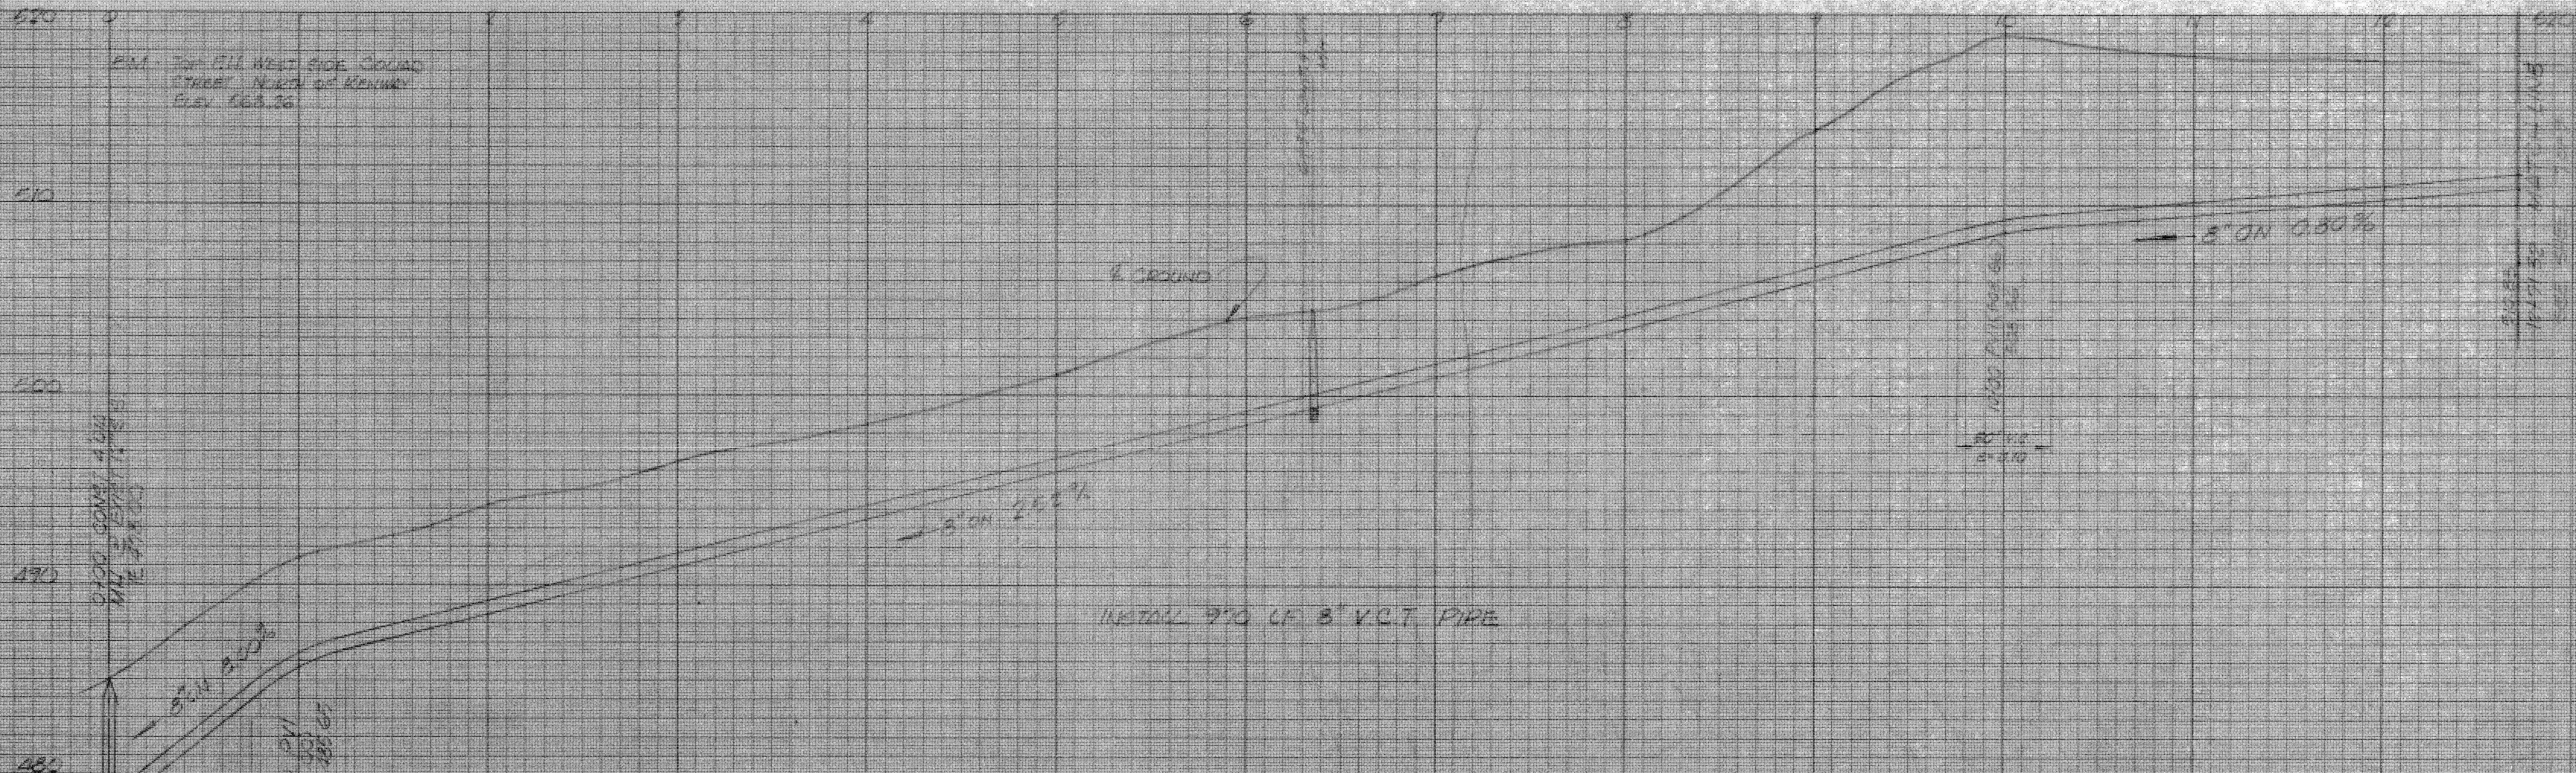

SEE PLAN SHEET TYPICAL
 DO NOT TYPICAL
 ALL IN 2004

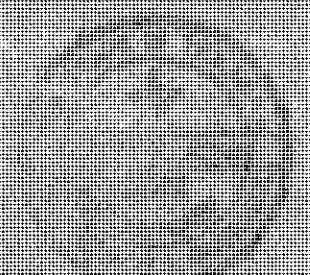

ACREY ASSOCIATES, INC.
 CONSULTING ENGINEERS
 P.O. BOX 28902 DALLAS, TEXAS (214) 328-4613
 DESIGN: JEL DRAWN: DATE: 2 OCT 1996 SCALE: 1"=40'

SANITARY SEWER
 OUTFALL FOR ROCKWALL, TEXAS
 ROCKWALL, TEXAS

SHEET NO.
 7
 11
 7007