
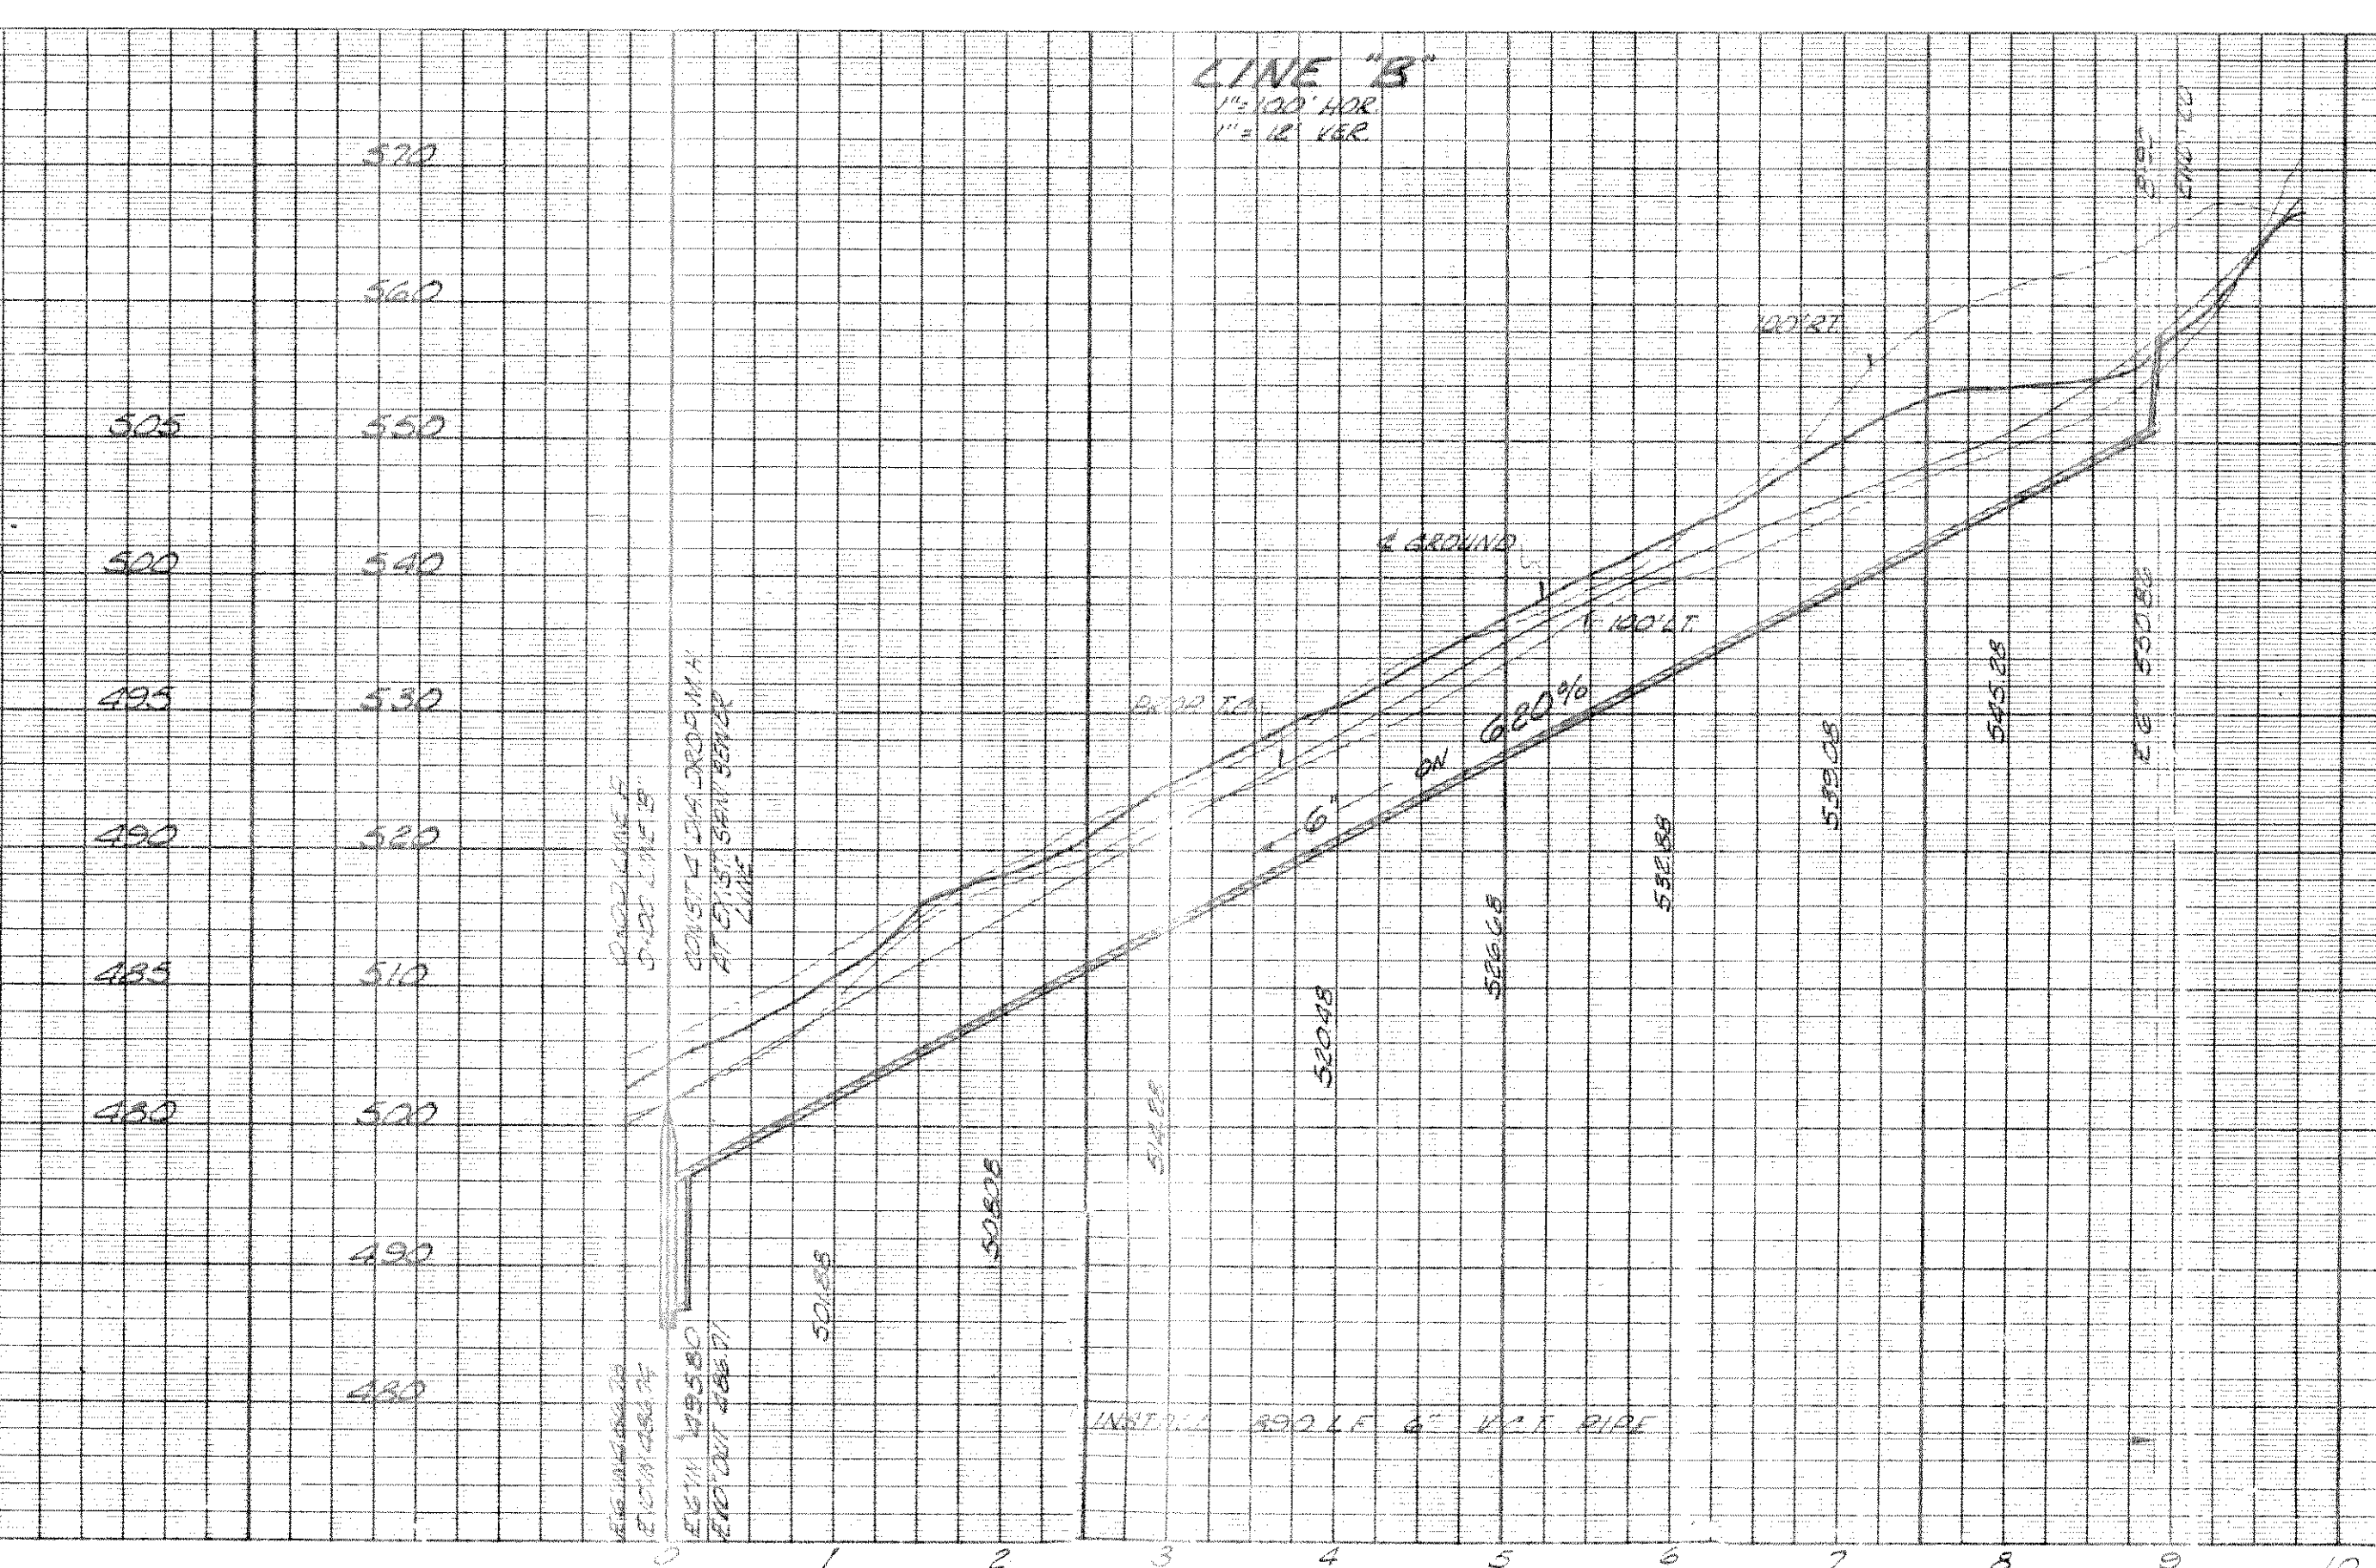


**CURVE DATA FOR SANITARY SEWERS**

**LINE A**  
 Δ: 28°45 S  
 CV: 21.38500'  
 1. T: 102.31'  
 L: 200.00'

**LINE B**  
 Δ: 3°48 20"  
 CV: 21.38500'  
 2. T: 12.51'  
 L: 25.01'  
 Δ: 36°00"  
 CV: 21.26000'  
 3. T: 82.48'  
 L: 63.36'

VALVE WAS INSTALLED HERE  
 BY DATE 2010  
 CONST. CO

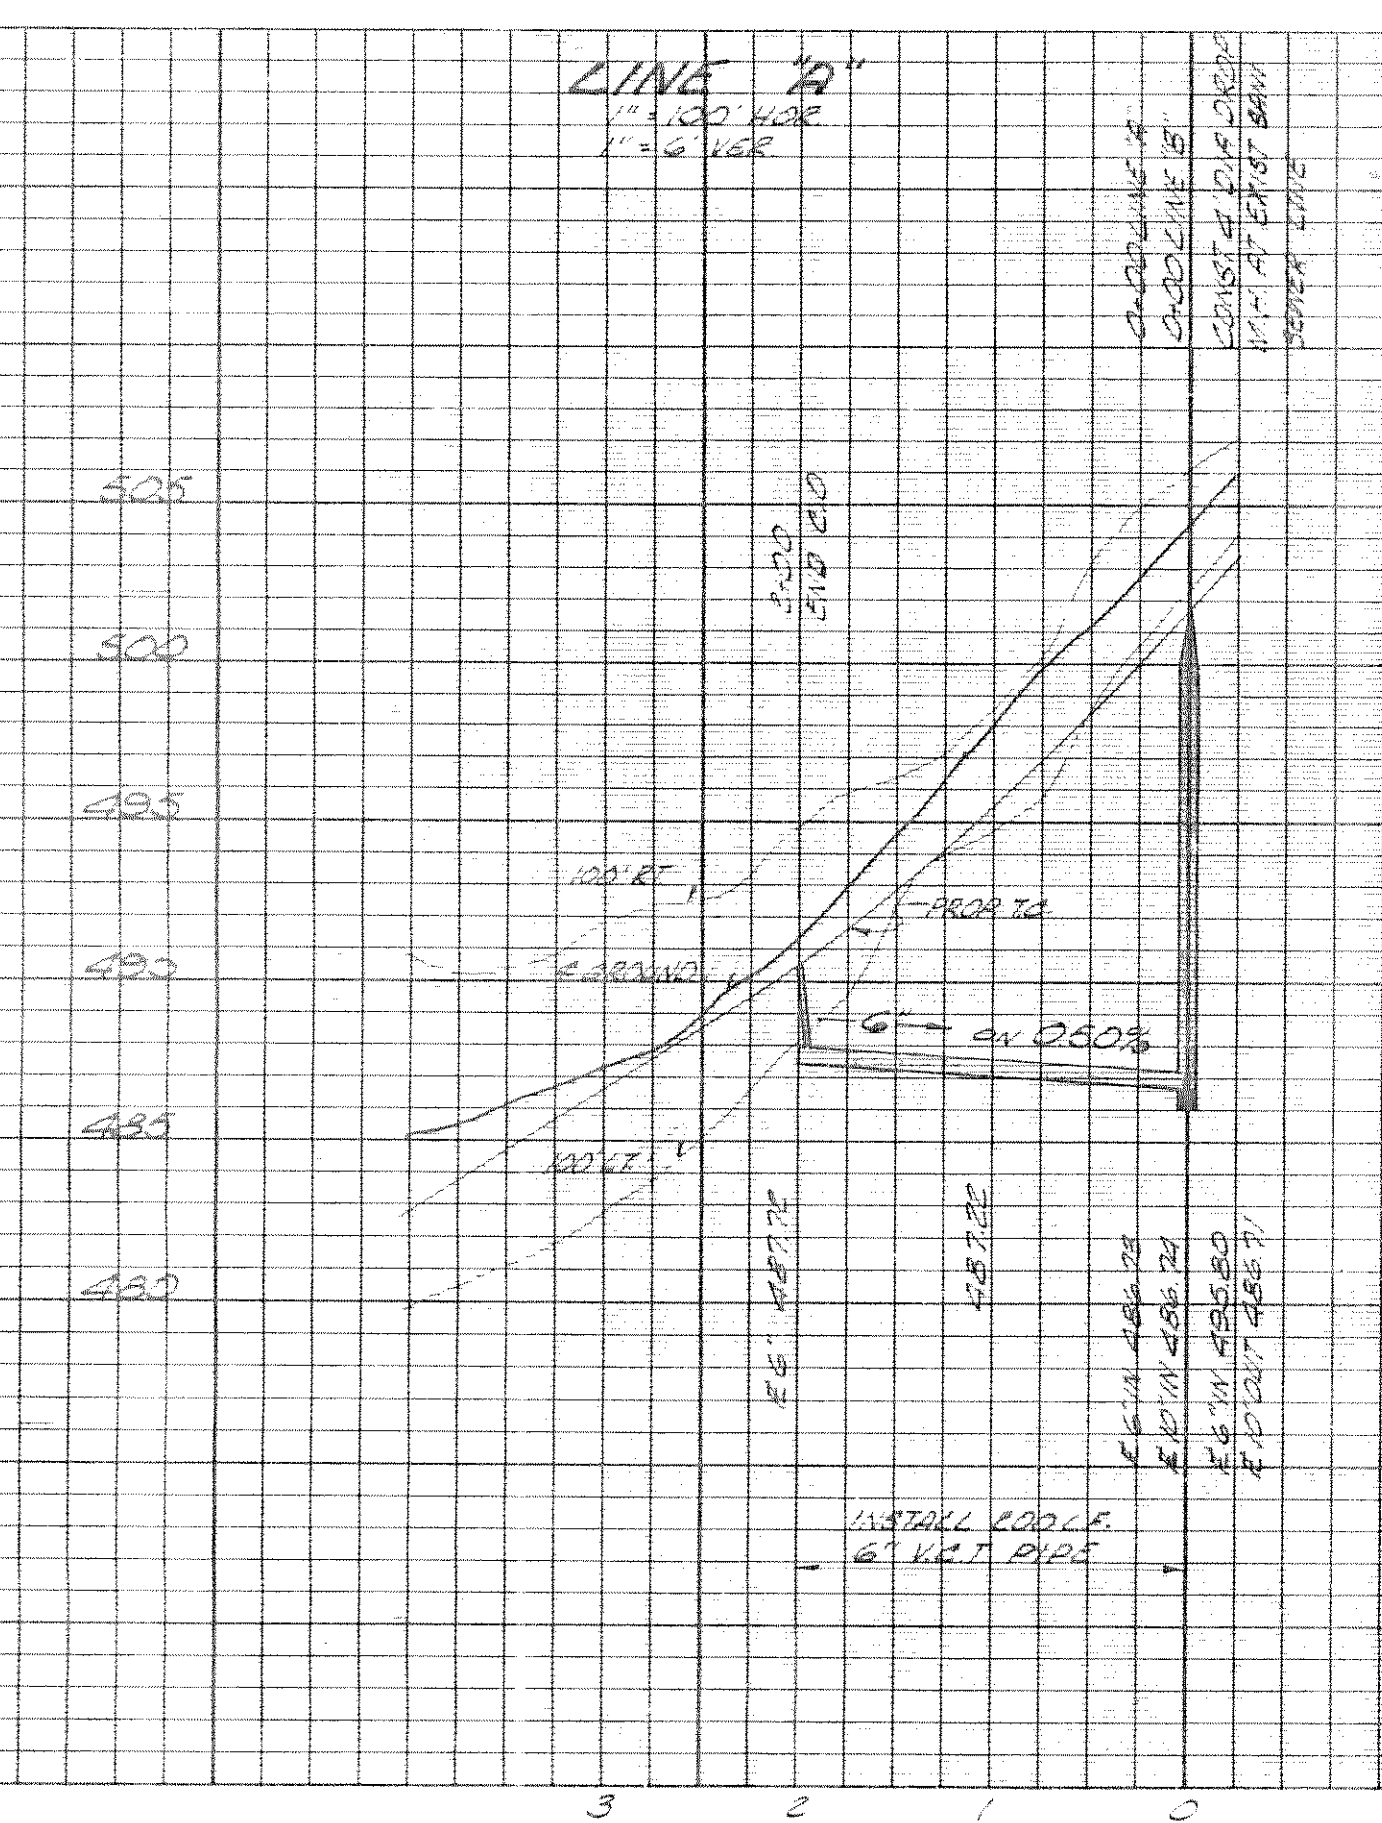

|  |       |         |              |       |      |     |
|--|-------|---------|--------------|-------|------|-----|
| <b>WATER / SANITARY SEWERS</b>         |       |         |              |       |      |     |
| LAKE MEADOWS ESTATES                   |       |         |              |       |      |     |
| ROCKWALL, TEXAS                        |       |         |              |       |      |     |
| KIRBY B ALBERTSON - OWNER              |       |         |              |       |      |     |
| BILLY L STEPHENSON & ASSOC - ENGINEERS |       |         |              |       |      |     |
| DESIGN                                 | DRAWN | DATE    | SCALE        | NOTES | FILE | NO. |
| BLM                                    | BLM   | 4/21/10 | 1/8" = 1'-0" | RI    | 3G   |     |