

CIVIL CONSTRUCTION PLANS

FOR

LAKEPOINTE CHURCH - ROCKWALL CAMPUS

RING ROAD PROJECT

LOT 3, BLOCK A

LAKE POINTE BAPTIST CHURCH ADDITION

701 E. INTERSTATE 30

PLANS SUBMITTAL/REVIEW LOG

FIRST CITY SUBMITTAL - NOT FOR CONSTRUCTION	05/17/2024
SECOND CITY SUBMITTAL - NOT FOR CONSTRUCTION	07/23/2024
THIRD CITY SUBMITTAL - NOT FOR CONSTRUCTION	08/20/2024
ISSUE FOR CONSTRUCTION	09/19/2024


"RECORD DRAWINGS"
To the best of our knowledge Kimley-Horn and Associates, inc., hereby states that this plan is As-Built. This information provided is based on surveying at the site and information provided by the contractor.

12/18/2025 MATT LUCAS, P.E.
DATE: BY:

OWNER
 **LAKEPOINTE**
CHURCH
LAKEPOINTE BAPTIST CHURCH
701 I-30
ROCKWALL, TX 75087
CONTACT: JOHN WARDELL
EMAIL: JOHN.WARDELL@LAKEPOINTE.CHURCH

ENGINEER
Kimley»Horn

203 W NASH ST. SUITE 100 TERRELL, TX 75160
PHONE: 972-770-1300
CONTACT: MATTHEW A. LUCAS, P.E.
TEXAS REGISTERED ENGINEERING FIRM NO. F-928

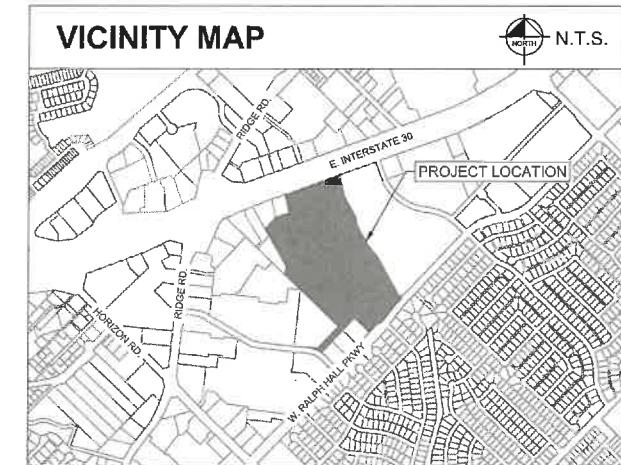


RELEASED FOR CONSTRUCTION
ALL RESPONSIBILITY FOR ADEQUACY OF DESIGN
REMAINS WITH THE DESIGN ENGINEER. THE CITY
OF ROCKWALL, IN REVIEWING AND RELEASING
PLANS FOR CONSTRUCTION, ASSUMES NO
RESPONSIBILITY FOR ADEQUACY OR ACCURACY OF
DESIGN.


CITY

9/23/24
DATE

CIVIL SHEET INDEX	
Sheet Number	Sheet Title
C-001	COVER SHEET
C-002	GENERAL NOTES
C-003	CITY GENERAL NOTES (1 OF 2)
C-003	CITY GENERAL NOTES (2 OF 2)
C-101	EXISTING CONDITIONS AND DEMOLITION PLAN
C-201	DIMENSION CONTROL, PAVING, AND STRIPING PLAN
C-202	PAVING DETAILS (1 OF 2)
C-203	PAVING DETAILS (2 OF 2)
C-301	GRADING PLAN
C-401	EXISTING DRAINAGE AREA MAP
C-402	PROPOSED DRAINAGE AREA MAP (1 OF 2)
C-403	PROPOSED DRAINAGE AREA MAP (2 OF 2)
C-501	STORM PLAN
C-502	STORM PROFILES (1 OF 2)
C-503	STORM PROFILES (2 OF 2)
C-504	STORM CALCULATIONS
C-505	STORM DETAILS (1 OF 2)
C-506	STORM DETAILS (2 OF 2)
C-601	EROSION CONTROL PLAN
C-602	EROSION CONTROL DETAILS
LC 1.01	LANDSCAPE PLAN
LC 1.02	LANDSCAPE PLAN
LC 1.03	LANDSCAPE PLAN
LC 3.01	LANDSCAPE DETAILS
LC 3.02	LANDSCAPE DETAILS
LC 3.03	LANDSCAPE DETAILS
LT 1.00	OVERALL TREESCAPE PLAN
LT 1.01	TREESCAPE PLAN
LT 1.02	TREESCAPE PLAN
LT 1.03	TREESCAPE PLAN
LT 1.04	TREESCAPE PLAN
LT 1.05	TREESCAPE PLAN
LT 1.06	TREESCAPE PLAN
LT 1.07	TREESCAPE PLAN
LT 3.01	TREESCAPE DETAILS

Kimley»Horn

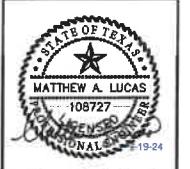

ROCKWALL CAMPUS
RING ROAD PROJECT
PREFARED FOR
LAKEPOINTE CHURCH
ROCKWALL, TX

COVER SHEET

ISSUE FOR CONSTRUCTION	09/19/2024	WNL
REVISIONS		
No.		
DATE		
BY		

SHEET NUMBER
C-001

KHA GENERAL CONSTRUCTION NOTES:

- ALL CONSTRUCTION SHALL BE IN ACCORDANCE WITH THE STANDARD SPECIFICATIONS FOR PUBLIC WORKS CONSTRUCTION FOR ROYSE CITY STANDARDS (LATEST EDITION), AND ANY SPECIAL PROVISIONS ADOPTED BY ROYSE CITY, THE SUBDIVISION RULES AND REGULATIONS OF ROYSE CITY (LATEST EDITION), THE PROJECT SPECIFICATION BOOK, AND THESE CONSTRUCTION PLANS. ROYSE CITY SPECIFICATIONS SHALL GOVERN WHERE OTHER SPECIFICATIONS DO NOT EXIST. IN CASE OF CONFLICTING SPECIFICATIONS OR DETAILS, THE OWNER AND ENGINEER SHALL BE CONTACTED PRIOR TO CONSTRUCTION.
- THE CONTRACTOR SHALL BE RESPONSIBLE TO FURNISH ALL MATERIALS AND LABOR TO CONSTRUCT THE FACILITY AS SHOWN AND DESCRIBED IN THE CONSTRUCTION DOCUMENTS IN ACCORDANCE WITH THE APPROPRIATE APPROVING AUTHORITIES, SPECIFICATIONS AND REQUIREMENTS. THE CONTRACTOR SHALL VISIT THE SITE PRIOR TO BIDDING TO DETERMINE EXISTING CONDITIONS.
- ALL EXISTING UTILITIES SHOWN ARE LOCATED ACCORDING TO THE INFORMATION AVAILABLE TO THE ENGINEER AT THE TIME THE DRAWINGS WERE PREPARED AND HAVE NOT BEEN INDEPENDENTLY VERIFIED BY THE CITY. GUARANTEE IS NOT MADE THAT ALL EXISTING UNDERGROUND UTILITIES ARE SHOWN OR THAT THE LOCATION OF THOSE SHOWN ARE ACCURATE. THE LOCATIONS SHOWN ARE FOR BIDDING PURPOSES ONLY. FINDING THE ACTUAL LOCATION OF ANY EXISTING UTILITIES IS THE CONTRACTOR'S RESPONSIBILITY AND SHALL BE DONE BEFORE COMMENCES ANY WORK IN THE VICINITY. FURTHERMORE, THE CONTRACTOR SHALL BE FULLY RESPONSIBLE FOR ANY AND ALL DAMAGES DUE TO THE CONTRACTOR'S FAILURE TO DETERMINE THE EXACT LOCATION OF ANY EXISTING UTILITIES. THE CONTRACTOR SHALL NOT BE HELD LIABLE FOR ANY DAMAGES SUSTAINED OR COST INCURRED BECAUSE OF THE OPERATIONS IN THE VICINITY OF EXISTING UTILITIES OR STRUCTURES, NOR FOR TEMPORARY BRACING AND SHORING OF SAME, IF IT IS NECESSARY TO SHORE, BRACE, SWING OR RELOCATE A UTILITY. THE UTILITY COMPANY OR DEPARTMENT AFFECTED SHALL BE CONTACTED BY THE CONTRACTOR AND THEIR PERMISSION OBTAINED REGARDING THE METHOD TO USE FOR SUCH WORK.
- IT IS THE CONTRACTOR'S RESPONSIBILITY TO CONTACT THE VARIOUS UTILITY COMPANIES WHICH MAY HAVE BURIED OR AERIAL UTILITIES WITHIN OR NEAR THE CONSTRUCTION AREA BEFORE COMMENCING WORK. THE CONTRACTOR SHALL PROVIDE 72 HOURS MINIMUM NOTICE TO ALL UTILITY COMPANIES PRIOR TO BEGINNING CONSTRUCTION.
- THE CONTRACTOR SHALL BE RESPONSIBLE TO OBTAIN ALL REQUIRED CONSTRUCTION PERMITS AND BONDS PRIOR TO CONSTRUCTION.
- ANY DISCREPANCIES ON THE DRAWINGS SHALL BE IMMEDIATELY BROUGHT TO THE ATTENTION OF THE CITY, ARCHITECT AND ENGINEER BEFORE COMMENCING WORK. NO FIELD CHANGES OR DEVIATIONS FROM DESIGN ARE TO BE MADE WITHOUT PRIOR APPROVAL OF THE CITY AND NOTIFICATION TO THE ARCHITECT AND THE ENGINEER. NO CONSIDERATION WILL BE GIVEN TO CHANGE ORDERS FOR WHICH THE CITY, ENGINEER, AND OWNER WERE NOT CONTACTED PRIOR TO CONSTRUCTION OF THE AFFECTED ITEM.
- ALL NECESSARY INSPECTIONS AND/OR CERTIFICATIONS REQUIRED BY CODES, JURISDICTIONAL AGENCIES AND/OR UTILITY SERVICE COMPANIES SHALL BE PERFORMED PRIOR TO BUILDING POSSESSION AND THE FINAL CONNECTION OF SERVICES.
- CONTRACTOR SHALL VERIFY BENCHMARKS AND DATUMS PRIOR TO COMMENCING CONSTRUCTION OR STAKING OF IMPROVEMENTS.
- CONTRACTOR SHALL THOROUGHLY CHECK COORDINATION OF CIVIL, LANDSCAPE, MEP, ARCHITECTURAL, AND OTHER PLANS PRIOR TO COMMENCING CONSTRUCTION. OWNER/ENGINEER SHALL BE NOTIFIED OF ANY DISCREPANCY PRIOR TO COMMENCING WITH CONSTRUCTION.
- THE CONTRACTOR IS RESPONSIBLE FOR COORDINATING ADJUSTMENTS, RELOCATIONS AND INSTALLATIONS OF FRANCHISE UTILITIES AS NECESSARY FOR ON-SITE AND OFF-SITE CONSTRUCTION.
- CONTRACTOR IS RESPONSIBLE FOR ALL CONSTRUCTION FIELD STAKING, TESTING, AND CERTIFICATION UNLESS SPECIFIED OTHERWISE BY THE OWNER.
- UNLESS NOTED OTHERWISE, CONTRACTOR SHALL REPLACE ANY FENCING, CURBING, ETC. THAT IS DESTROYED DUE TO THE CONSTRUCTION ACTIVITIES.
- TRENCH SAFETY DESIGN WILL BE THE RESPONSIBILITY OF THE UTILITY CONTRACTOR. CONTRACTOR SHALL SUBMIT A TRENCH SAFETY PLAN (SEALED BY A PROFESSIONAL ENGINEER LICENSED IN THE STATE OF TEXAS) TO THE ROYSE CITY PUBLIC WORKS DEPARTMENT FOR REVIEW PRIOR TO THE START OF ANY UTILITY CONSTRUCTION.
- ALL CONTRACTORS MUST CONFINE THEIR ACTIVITIES TO THE WORK AREA. NO ENCROACHMENTS OUTSIDE OF THE WORK AREA WILL BE ALLOWED. ANY DAMAGE RESULTING THEREFROM SHALL BE CONTRACTOR'S SOLE RESPONSIBILITY TO REPAIR.
- LIGHT POLES AND SIGNS SHALL NOT BE PLACED IN ADA ACCESSIBLE ROUTES OR ACCESSIBLE ACROSS ROUTES.
- ALL AREAS IN EXISTING RIGHTS-OF-WAY DISTURBED BY SITE CONSTRUCTION NOT INCLUDED WITH THIS SCOPE OF WORK SHALL BE REGRADED AND LANDSCAPED OR PAVED (TO WHATEVER CONDITION EXISTED BEFORE DISTURBANCE). ALL DISTURBED AREAS SHALL BE REPAVED TO THE SAME OR BETTER CONDITION THAN BEFORE AREA WAS DISTURBED.
- THE CONTRACTOR SHALL HAVE AVAILABLE AT THE JOB SITE AT ALL TIMES ONE COPY OF THE CONTRACT DOCUMENTS INCLUDING PLANS, SPECIFICATIONS, AND SPECIAL CONDITIONS, COPIES OF ANY REQUIRED CONSTRUCTION PERMITS, AND EROSION CONTROL PLANS AND INSPECTION REPORTS (SWPP).
- THE CONTRACTOR SHALL REVIEW AND VERIFY ALL DIMENSIONS, ELEVATIONS, AND EXISTING CONTOURS SHOWN ON THE PLANS AND ALL FIELD CONDITIONS THAT MAY AFFECT CONSTRUCTION. SHOULD DISCREPANCIES OCCUR, THE CONTRACTOR SHALL NOTIFY THE ENGINEER TO OBTAIN THE ENGINEER'S CLARIFICATION BEFORE COMMENCING WITH THE CONSTRUCTION.
- CONTRACTOR SHALL USE ALL NECESSARY SAFETY PRECAUTIONS TO AVOID CONTACT WITH OVERHEAD AND UNDERGROUND POWER LINES.
- THE CONTRACTOR SHALL MAINTAIN ADEQUATE SITE DRAINAGE DURING ALL PHASES OF CONSTRUCTION. THE CONTRACTOR SHALL USE SILT FENCES (OR OTHER METHODS APPROVED BY THE ENGINEER AND CITY) AS REQUIRED TO PREVENT SILT AND CONSTRUCTION DEBRIS FROM FLOWING ONTO ADJACENT PROPERTIES. CONTRACTOR SHALL COMPLY WITH ALL APPLICABLE FEDERAL, STATE, AND LOCAL EROSION, CONSERVATION, AND SILTATION ORDINANCES. CONTRACTOR SHALL REMOVE ALL TEMPORARY EROSION CONTROL DEVICES UPON COMPLETION OF THE CONSTRUCTION OF A STAND OF GRASS OR OTHER GROWTH TO PREVENT EROSION. CONTRACTOR IS RESPONSIBLE FOR FURNISHING AND N.O.T. WITH REPORTING. CONTRACTOR MUST SUBMIT COPIES OF N.O.I. AND N.O.T. TO ROYSE CITY.
- CONTRACTOR TO DISPOSE OF ALL EXCESS EXCAVATION MATERIALS AS DIRECTED BY THE OWNER.
- ALL EXCAVATION IS UNCLASSIFIED AND SHALL INCLUDE ALL MATERIALS ENCOUNTERED. UNUSABLE EXCAVATED MATERIAL AND ALL WASTE RESULTING FROM SITE CLEARING AND GRUBBING SHALL BE TAKEN OFF SITE BY THE GRADING CONTRACTOR AT HIS EXPENSE.
- THE CONTRACTOR SHALL CLEAR AND GRUB THE SITE AND PLACE, COMPACT, AND MOISTURE CONDITION FILL PER THE PROJECT GEOTECHNICAL ENGINEER'S SPECIFICATIONS. THE FILL MATERIAL TO BE USED SHALL BE APPROVED BY THE GEOTECHNICAL ENGINEER PRIOR TO PLACEMENT.
- ALL SIGNS, PAVEMENT MARKINGS, AND OTHER TRAFFIC CONTROL DEVICES SHALL CONFORM TO THE TEXAS MANUAL ON UNIFORM TRAFFIC CONTROL DEVICES*.
- ALL REINFORCING STEEL SHALL CONFORM TO THE GEOTECHNICAL REPORT AND ASTM A-815, GRADE 60, AND SHALL BE SUPPORTED BY BAR CHAIRS.
- WATER LINES CROSSING STORM SEWER LINES AND SANITARY SEWER LINES SHALL BE IN CONFORMANCE WITH ALL TEXAS COMMISSION ON ENVIRONMENTAL QUALITY (TCEQ) SPECIFICATIONS.
- THE SITE UTILITY CONTRACTOR SHALL PROVIDE ALL MATERIALS AND APPURTENANCES NECESSARY FOR COMPLETE INSTALLATION OF THE UTILITIES. ALL PUBLIC PIPE STRUCTURES AND FITTINGS SHALL BE INSPECTED BY THE CITY INSPECTOR PRIOR TO BEING COVERED. THE CONTRACTOR'S BID PRICE SHALL BE DURING THE INSPECTION AND PRESSURE TESTING OF ALL MAINS. THE CONTRACTOR'S BID PRICE SHALL INCLUDE ALL INSPECTION FEES AS AN ALTERNATE. THE OWNER RESERVES THE RIGHT TO PAY THE INSPECTION FEES DIRECTLY TO THE CITY.
- ALL FIRE HYDRANTS, FITTINGS, VALVES, AND PIPE ENDS SHALL BE BLOCKED WITH CONCRETE PER CITY STANDARDS.
- TOP RIM ELEVATIONS OF ALL SANITARY SEWER MANHOLES SHALL BE COORDINATED WITH TOP OF PAVEMENT OR FINISHED GRADE.
- CONTRACTOR SHALL CONSTRUCT PROPOSED PAVEMENT TO MATCH EXISTING PAVEMENT WITH A SMOOTH, FLUSH, CONNECTION.
- THE CONTRACTOR SHALL PROTECT ALL EXISTING STRUCTURES, UTILITIES, AND OTHER FACILITIES TO REMAIN AND SHALL REPAIR ANY DAMAGES DUE TO HIS CONSTRUCTION ACTIVITIES AT NO COST TO THE OWNER.
- CONTRACTOR TO ADJUST ALL GATE VALVE COVERS TO MATCH PROPOSED PAVING GRADES.
- THE OPERATING NUT OF ALL GATE VALVES SHALL BE 2 FEET BELOW FINISH GRADE (MINIMUM).
- THESE PLANS, PREPARED BY KIMLEY-HORN AND ASSOCIATES, INC. DO NOT EXTEND TO OR INCLUDE DESIGNS OR SPECIFICATIONS FOR THE CONTRACTOR OR ITS EMPLOYEES, AGENTS OR REPRESENTATIVES. THE PERFORMANCE OF THE WORK, THE ENGINEER'S SEALS, HEREIN, DO NOT EXTEND TO ANY SUCH SAFETY SYSTEM THAT MAY NOW OR HEREAFTER BE INCORPORATED IN THESE PLANS. THE CONTRACTOR SHALL BE RESPONSIBLE FOR IMPLEMENTATION OF ALL REQUIRED SAFETY PROCEDURES AND PROGRAMS.
- REFER TO SWPP REPORT AND EROSION CONTROL PLANS FOR APPLICABLE NOTES.
- REFER TO ARCHITECTURAL AND STRUCTURAL PLANS TO VERIFY ALL BUILDING DIMENSIONS.

CONTRACTOR'S RESPONSIBILITY TO SHOW BY STANDARD TESTING PROCEDURES THAT THE WORK CONSTRUCTED DOES MEET THE REQUIREMENTS OF THE CITY'S SPECIFICATIONS AND THESE PLANS.

- CONTRACTOR SHALL CALL 1-800-PIGGIES AT LEAST 72 HOURS PRIOR TO COMMENCING CONSTRUCTION FOR FIELD LOCATIONS OF UTILITIES IN THE VICINITY OF THE SITE.
- PROPOSED CONTOURS ARE APPROXIMATE. PROPOSED SPOT ELEVATIONS AND DESIGNATED GRADIENT ARE TO BE USED IN CASE OF DISCREPANCY.
- NO TREE SHALL BE REMOVED OR DAMAGED WITHOUT PRIOR AUTHORIZATION OF THE OWNER OR OWNER'S REPRESENTATIVE. EXISTING TREES SHALL BE PRESERVED WHEREVER POSSIBLE.
- CONTRACTOR SHALL VERIFY HORIZONTAL AND VERTICAL CONTROL PRIOR TO COMMENCING CONSTRUCTION AND SHALL NOTIFY ENGINEER OF ANY DISCREPANCIES BEFORE CONSTRUCTION COMMENCES.
- CONTRACTOR SHALL TEST AND OBSERVE PAVEMENT AREAS FOR EVIDENCE OF PONDING. ALL AREAS SHALL ADEQUATELY DRAIN TOWARDS THE INTENDED STRUCTURE TO CONVEY STORM RUNOFF. CONTRACTOR SHALL IMMEDIATELY NOTIFY OWNER AND ENGINEER IF ANY DISCREPANCIES ARE DISCOVERED.

PERMANENT GROUND COVER ON DISTURBED AREAS PRIOR TO FINAL APPROVAL OF THE PROJECT.

- INSPECTIONS SHALL BE MADE WEEKLY BY THE CONTRACTOR AND AFTER RAIN STORM EVENTS TO INSURE THAT THE DEVICES ARE FUNCTIONING PROPERLY. WHEN SEDIMENT OR MUD HAS CLOGGED THE VOID SPACES BETWEEN STONES OR MUD IS BEING TRACKED ONTO A PUBLIC ROADWAY, THE AGGREGATE PAD MUST BE WASHED DOWN OR CLEANED UP. THE CONTRACTOR SHALL NOT BE ALLOWED TO DRAIN DIRECTLY OFF SITE WITHOUT FIRST FLOWING THROUGH ANOTHER BMP TO CONTROL OFF SITE SEDIMENTATION. PERIODIC RE-GRADING OR THE ADDITION OF NEW STONE MAY BE REQUIRED TO MAINTAIN THE EFFICIENCY OF THE INSTALLATION. CONSTRUCTION ENTRANCES AND EXITS TO BE REPAVED OR REPLACED. HEAVY MUD BUILD UP SHOULD BE COVERED WITH ADDITIONAL ROCK.
- CONTRACTOR SHALL BE RESPONSIBLE FOR ALL INSPECTIONS, DOCUMENTATION, AND SUBMITTAL OF N.O.I., N.O.T. AND ANY ADDITIONAL INFORMATION REQUIRED BY THE E.P.A. AND T.C.E.Q. CONTRACTOR SHALL COMPLY WITH ALL E.P.A. AND T.C.E.Q. STORM WATER POLLUTION PREVENTION REQUIREMENTS. CONTRACTOR MUST SUBMIT COPIES OF N.O.I. AND N.O.T. TO ROYSE CITY.
- CONTRACTOR IS SOLELY RESPONSIBLE FOR SELECTION, IMPLEMENTATION, MAINTENANCE, AND EFFECTIVENESS OF ALL BEST MANAGEMENT PRACTICES (BMP'S) AND FOR UPDATING THE PLAN DURING CONSTRUCTION AS FIELD CONDITIONS CHANGE. EROSION CONTROLS SHOWN ON THIS SITE MAP ARE SUGGESTED CONTROLS ONLY. CONTRACTOR IS RESPONSIBLE FOR UPDATING THE EROSION CONTROL PLAN AND STORM WATER POLLUTION PREVENTION PLAN (SWPP) AS NECESSARY.
- CONTRACTOR SHALL RECORD INSTALLATION, MAINTENANCE OR MODIFICATION, AND REMOVAL DATES FOR EACH BMP EMPLOYED WHETHER CALLED OUT IN THE SWPP OR NOT.
- EROSION CONTROL MEASURES MAY ONLY BE PLACED IN FRONT OF INLETS OR IN CHANNELS, DRAINEGEWAYS OR BORROW DITCHES AT RISK OF CONTRACTOR AND IN COMPLIANCE WITH SECTIONS 401 AND 404 OF THE CLEAN WATER ACT. CONTRACTOR SHALL REMAIN LIABLE FOR ANY DAMAGE CAUSED BY THE MEASURES, INCLUDING FLOODING DAMAGE, WHICH MAY OCCUR DUE TO BLOCKED DRAINAGE. AT THE CONCLUSION OF ANY PROJECT, ALL CHANNELS, DRAINEGEWAYS AND BORROW DITCHES IN THE WORK ZONE SHALL BE DREDGED OF ANY SEDIMENT GENERATED BY THE PROJECT OR DEPOSITED AS A RESULT OF EROSION CONTROL MEASURES.
- CONTRACTOR IS RESPONSIBLE FOR MODIFYING THE SWPP AND EROSION CONTROL PLAN TO INCLUDE BMP'S FOR ANY OFF-SITE MATERIAL WASTE, BORROW, OR EQUIPMENT STORAGE AREAS.
- CONTRACTOR SHALL INSPECT DISTURBED AREAS, MATERIAL STORAGE AREAS EXPOSED TO PRECIPITATION, STRUCTURAL CONTROL MEASURES, AND VEHICLE ENTRY AND EXIT AREAS AT LEAST ONCE EVERY 14 CALENDAR DAYS AND WITHIN 24 HOURS OF A STORM EVENT OF 0.5 INCHES OR GREATER OR ONCE EVERY 7 DAYS ON THE SAME DAY OF THE WEEK EACH WEEK, REGARDLESS IF THERE HAS BEEN A RAINFALL EVENT. THE SWPP MUST REFLECT THE SCHEDULE IN USE.

STORM WATER DISCHARGE AUTHORIZATION

THE CONTRACTOR IS RESPONSIBLE TO ENSURE:

- PRIMARY OPERATORS MUST SUBMIT A N.O.T. TO TCEQ AT LEAST SEVEN DAYS PRIOR TO COMMENCING CONSTRUCTION. THE SUBMISSION IS AN ELECTRONIC SUBMITTAL, PRIOR TO COMMENCING CONSTRUCTION. ALL PRIMARY OPERATORS SHALL PROVIDE A COPY OF THE SIGNED N.O.T. TO THE OPERATOR OF ANY MS4 RECEIVING DISCHARGE FROM THE SITE.
- ALL CONTRACTORS AND SUBCONTRACTORS PROVIDING SERVICES RELATED TO THE SWPP SHALL SIGN A CONTRACTOR CERTIFICATION STATEMENT ACKNOWLEDGING THEIR RESPONSIBILITIES AS SPECIFIED IN THE SWPP.
- A COPY OF THE SWPP, INCLUDING CONTRACTOR CERTIFICATION AND ANY REVISIONS, SHALL BE SUBMITTED TO ROYSE CITY BY THE CONTRACTOR AND FILED WITH THE CONSTRUCTION PLANS, AND SHALL BE RETAINED ON-SITE DURING CONSTRUCTION.
- A NOTICE OF TERMINATION (NOT-SH) BE SUBMITTED TO TCEQ BY ANY PRIMARY OPERATOR WITHIN 30 DAYS AFTER THE LAST DISTURBING ACTIVITY. THE SITE MAY BE COMPETED AND THE PERMIT IS IN AN ACTIVE STATE IF 70% OR MORE HAS BEEN ESTABLISHED ON ALL UNPAVED AREAS AND AREAS NOT COVERED BY STRUCTURES. A TRANSFER OF OPERATIONAL CONTROL HAS OCCURRED OR THE OPERATOR HAS OBTAINED AN ALTERNATIVE AUTHORIZATION UNDER A DIFFERENT PERMIT, A COPY OF THE NOT SHALL BE PROVIDED TO THE OPERATOR OF ANY MS4 RECEIVING DISCHARGE FROM THE SITE.

UTILITY NOTES

- CONTACT ALL FRANCHISE UTILITIES LOCATION OF UNDERGROUND LINE
- CONTRACTOR SHALL EXERCISE CARE IN CONTRACTOR'S EQUIPMENT AND A SHORING MEASURES TO PREVENT DAMAGE TO THE LINE.
- THE CONTRACTOR SHALL PROTECT PROJECT. ALL MANHOLES, CLEAN RE-ADJUSTED TO PROPER LINE AND
- CONTRACTOR SHALL ARRANGE FOR ADJUSTMENT NEEDED.
- THE CONTRACTOR SHALL GIVE THI FOR SEWER SERVICE DISRUPTIONS
- THE CONTRACTOR IS RESPONSIBLE FOR REPAIR ALL WATER SERVICES, SEWER MAINS.
- REFERENCE LANDSCAPE AND/OR PAVING PLANS FOR LOCATION AND TYPE OF HANDICAP RAMPS TO BE PROVIDED AND FOR FLATWORK.
- ALL MATERIALS AND WORKMANSHIP SHALL CONFORM TO THE ROYSE CITY STANDARD SPECIFICATIONS.
- CONTRACTOR RESPONSIBLE FOR PREPARATION, SUBMITTAL, AND APPROVAL BY ROYSE CITY OF TRAFFIC CONTROL PLAN PRIOR TO START OF CONSTRUCTION.
- SIDEWALKS ADJACENT TO CURB SHALL BE CONNECTED TO BACK OF CURB USING LONGITUDINAL BUTT JOINT.
- UNLESS THE PLANS SPECIFICALLY DICTATE TO THE CONTRARY, ON-SITE AND OTHER DIRECTIONAL SIGNS SHALL BE LOCATED OUT OF THE PERTURBED AND UNPAVED ROADS AND SHALL BE LOCATED BETWEEN THREE TO FIVE FEET BEHIND THE NEAREST BACK OF CURB, SIGN HEIGHT, LOCATION, AND STRUCTURE SHALL BE SUCH THAT THE SIGNS POSE NO THREAT TO PUBLIC SAFETY.
- UNLESS THE PLANS SPECIFICALLY DICTATE TO THE CONTRARY, ON-SITE AND OTHER DIRECTIONAL SIGNS SHALL BE ORIENTED SO THEY ARE READILY VISIBLE TO THE ONCOMING TRAFFIC FOR WHICH THEY ARE INTENDED. FIELD ADJUSTMENTS OF LOCATION AND ORIENTATION OF THE SIGNS ARE TO BE MADE TO ACCOMPLISH THIS.
- CONTRACTOR RESPONSIBLE FOR INSTALLING NECESSARY CONDUIT FOR LIGHTING, IRRIGATION, ETC. PRIOR TO PLACEMENT OF PAVEMENT. ALL CONSTRUCTION DOCUMENTS (CIVIL, MEP, LANDSCAPE, AND ARCHITECT) SHALL BE CONSULTED.
- BEFORE PLACING PAVEMENT, CONTRACTOR SHALL VERIFY THAT SUITABLE HANDICAPPED ROUTES (PER A.D.A. STANDARDS) EXIST TO AND FROM THE NEAREST DOOR AND ALONG SIDEWALKS AND A POSSIBLE ROUTE IN NO CASE SHALL HANDICAP RAMPS EXCEED 1 VERTICAL TO 12 HORIZONTAL. IN NO CASE SHALL SIDEWALK SLOPES EXCEED 5.0 PERCENT. CONTRACTOR SHALL CONTACT ENGINEER PRIOR TO PAVING IF ANY EXCESSIVE SLOPES ARE ENCOUNTERED. NO CONTRACTOR CHANGE ORDERS WILL BE ACCEPTED FOR A.D.A. AND T.A.S. COMPLIANCE ISSUES.
- ALL CONSTRUCTION STAGING AREAS TO BE LOCATED ON-SITE (WITHIN PROJECT LIMITS).
- ALL JOINTS SHALL EXTEND THROUGH THE CURB.
- THE MINIMUM LENGTH OF OFFSET JOINTS AT RADIUS POINTS SHALL BE 2 FEET.

EROSION CONTROL

- EROSION CONTROL DEVICES AS SHOWN ON THE EROSION CONTROL PLAN FOR THE PROJECT SHALL BE INSTALLED PRIOR TO THE START OF LAND DISTURBING ACTIVITIES ON THE PROJECT.
- THE CONTRACTOR SHALL CONSTRUCT SILT SCREENS OR OTHER APPROVED DEVICES PRIOR TO CONSTRUCTION TO PREVENT ADVERSE OFF SITE IMPACT OF STORM WATER QUALITY. AS REQUIRED BY THE CITY OF PLANO, CONTRACTOR IS RESPONSIBLE FOR PROPER MAINTENANCE OF THE REQUIRED EROSION CONTROL DEVICES THROUGHOUT THE ENTIRE CONSTRUCTION PROCESS. THE EROSION CONTROL DEVICES SHOULD REMAIN IN PLACE, WHERE PRACTICAL, UPON COMPLETION OF CONSTRUCTION.
- ALL EROSION CONTROL DEVICES ARE TO BE INSTALLED IN ACCORDANCE WITH THE APPROVED PLANS AND SPECIFICATIONS FOR THE PROJECT. CHANGES ARE TO BE APPROVED BEFORE CONSTRUCTION BY THE DESIGN ENGINEER AND THE ROYSE CITY ENGINEERING DIVISION.
- IF THE EROSION CONTROL PLAN AS APPROVED DOES NOT CONTROL EROSION AND OFF-SITE SEDIMENTATION FROM THE PROJECT THE EROSION CONTROL PLAN WILL BE REQUIRED TO BE REVISED AND/OR ADDITIONAL EROSION CONTROL DEVICES WILL BE REQUIRED ON SITE.
- OFF-SITE (IF APPLICABLE) SOIL, BORROW, AND SPOIL AREAS ARE CONSIDERED AS PART OF THE PROJECT SITE AND MUST ALSO COMPLY WITH THE EROSION CONTROL REQUIREMENTS FOR THIS PROJECT. THIS INCLUDES THE INSTALLATION OF BMP'S TO CONTROL OFFSITE SEDIMENTATION AND THE ESTABLISHMENT OF

PERMANENT GROUND COVER ON DISTURBED AREAS PRIOR TO FINAL APPROVAL OF THE PROJECT.

VAL	BY
05/19/2024	
	DATE
	REVISIONS
	NO.

**"RECORD DRAWINGS"**

To the best of our knowledge Kimley-Horn and Associates, inc., hereby states that this plan is As-Built. This information provided is based on surveying at the site and information provided by the contractor.

12/18/2025

MATT LUCAS, P.E.
DATE: BY:

THESE PLAN AND GENERAL NOTES REFER TO:
GEOTECHNICAL ENGINEERING REPORT
ALPHA TESTING, INC.
NO. G240023
FEBRUARY 26, 2024
INCLUDING ALL REVISIONS AND ADDENDA TO THIS REPORT THAT MAY HAVE BEEN RELEASED AFTER THE NOTED DATE.

GENERAL NOTES
ROCKWALL CAMPUS
RING ROAD PROJECT
PREPARED FOR
LAKEPOINTE CHURCH
ROCKWALL, TX

SHEET NUMBER
C-002

DEMOLITION, REMOVAL, DISPOSAL AND EXCAVATION NO.

1. All pavements to be removed and replaced shall be saw cut to full depth along neat squared lines shown in the plans.
2. Proposed concrete pavement shall be constructed with longitudinal butt construction joints at all connections to existing concrete pavement.
3. All public concrete pavement to be removed and replaced shall be full panel replacement, 1-inch thicker and on top of 6-inch thick compacted flexbase.
4. No excess excavated material shall be deposited in low areas or along natural drainage ways without written permission from the affected property owner and the City of Rockwall. No excess excavation shall be deposited in the City Limits without a permit from the City of Rockwall. If the CONTRACTOR places excess materials in these areas without written permission, the CONTRACTOR will be responsible for all damages resulting from such fill and shall remove the material at their own cost.

PAVING AND GRADING

1. All detention systems are to be installed and verified for design compliance along with the associated storm sewer and outflow structures, prior to the start of any paving operations (including building foundations). Erosion protection shall be placed at the pond outflow structures, silt fence along the perimeter of the pond along with any of the associated erosion BMPs noted on the erosion control plan, and the sides and bottom of the detention system shall have either sod or anchored seeded curlex installed prior to any concrete placement.
2. All paving roadway, driveways, fire lanes, drive-isles, parking, dumpster pads, etc. sections shall have a minimum thickness, strength, reinforcement, joint type, joint spacing and subgrade treatment shall at a minimum conform to the City standards of Design and Construction and table below.

Street/Pavement Type	Minimum Thickness (inches)	Strength 28-Day (psi)	Minimum Cement (sacks / CY)		Steel Reinforcement	
			Machine placed	Hand Placed	Bar #	Spacing (O.C.E.W.)
Arterial	10"	3,600	6.0	6.5	#4 bars	18"
Collector	8"	3,600	6.0	6.5	#4 bars	18"
Residential	6"	3,600	6.0	6.5	#3 bars	24"
Alley	7"-5"-7"	3,600	6.0	6.5	#3 bars	24"
Fire Lane	6"	3,600	6.0	6.5	#3 bars	24"
Driveways	6"	3,600	6.0	6.5	#3 bars	24"
Barrier Free Ramps	6"	3,600	N/A	6.5	#3 bars	24"
sidewalks	4"	3,000	N/A	5.5	#3 bars	24"
Parking Lot/Drive Aisles	5"	3,000	5.0	5.5	#3 bars	24"
Dumpster Pads	7"	3,600	6.0	6.5	#3 bars	24"

3. Reinforcing steel shall be tied (100%). Reinforcing steel shall be set on plastic chairs. Bar laps shall be minimum 30 diameters. Sawed transverse dummy joints shall be spaced every 15 feet or 1.25 times longitudinal butt joint spacing whichever is less. Sawing shall occur within 5 to 12 hours after the pour, including sealing. Otherwise, the section shall be removed and longitudinal butt joint constructed.
4. No sand shall be allowed under any paving.
5. All concrete mix design shall be submitted to the City for review and approval prior to placement.
6. Fly ash may be used in concrete pavement locations provided that the maximum cement reduction does not exceed 20% by weight per C.Y. of concrete. The fly ash replacement shall be 1.25 lbs. per 1.0 lb. cement reduction.
7. All curb and gutter shall be integral (monolithic) with the pavement.
8. All fill shall be compacted by sheep's foot roller to a minimum 95% standard proctor. Maximum loose lift for compaction shall be 8 inches. All lifts shall be tested for density by an independent laboratory. All laboratory compaction reports shall be submitted to the City Engineering Construction Inspector once results are received. All reports will be required prior to final acceptance.
9. All concrete compression tests and soil compaction/density tests are required to be submitted to the City's Engineering Inspector immediately upon results.
10. All proposed sidewalks shall include barrier free ramps at intersecting streets, alleys, etc. Barrier free ramps (truncated dome plate in Colonial or brick red color) shall meet current City and ADA requirements and be approved by the Texas Department of Licensing and Regulation (TDLR).
11. All public sidewalks shall be dowled into pavement where it abuts curbs and driveways. Expansion joint material shall be used at these locations.
12. All connection of proposed concrete pavement to existing concrete pavement shall include a longitudinal butt joint as the load transfer device. All longitudinal butt joints shall be clean, straight and smooth (not jagged in appearance)
13. Cracks formed in concrete pavement shall be repaired or removed by the CONTRACTOR at the City's discretion. CONTRACTOR shall replace existing concrete curbs, sidewalk, paving, a gutters as indicated on the plans and as necessary to connect to the existing infrastructure, including any damage caused by the CONTRACTOR.
14. All residential lots will require individual grading plans submitted during the building permit process that correspond with the engineered grading and drainage area plans.
15. Approval of this plan is not an authorization to grade adjacent properties when the plans or field conditions warrant off-site grading. Written permission must be obtained and signed from the affected property owner(s) and temporary construction easements may be required. The written permission shall be provided to the City as verification of approval by the adjacent property owner(s). Violation of this requirement will result in suspension of all work at the job site until issue has been rectified.
16. All cut or fill slopes of non-paved areas shall be a maximum of 4:1 and minimum of 1%.
17. CONTRACTOR agrees to repair any damage to property and the public right-of-way in accordance with the City Standards of Design and Construction.
18. CONTRACTOR shall protect all monuments, iron pins/rods, and property corners during construction.
19. CONTRACTOR shall ensure positive drainage so that runoff will drain by gravity flow to new or existing drainage inlets or sheet flow per these approved plans.

DRAINAGE / STORM SEWER NOTES

1. The CONTRACTOR shall maintain drainage at all times during construction. Ponding of water in streets, drives, trenches, etc. will not be allowed. Existing drainage ways shall not be blocked or removed unless explicitly stated in the plans or written approval is given by the City.
2. All structural concrete shall be 4200 psi compressive strength at 28 days minimum 7.0 sack mix, air entrained, unless noted otherwise. Fly ash shall not be allowed in any structural concrete.
3. Proposed storm sewer embedment shall be NCTCOG Class 'B' as amended by the City of Rockwall's Engineering Department Standards of Design and Construction Manual.
4. All public storm pipe shall be a minimum of 18-inch reinforced concrete pipe (RCP), Class III, unless otherwise noted.
5. All storm pipe entering structures shall be grouted to assure connection at the structure is watertight.
6. All storm structures shall have a smooth uniform poured mortar invert from invert to invert out.
7. All storm sewer manholes in paved areas shall be flush with the paving grade, and shall have traffic bearing ring and covers.
8. All storm sewer pipes and laterals shall be inspected by photographic means (television and DVD) prior to final acceptance and after franchise utilities are installed. The CONTRACTOR shall furnish a DVD to the Engineering Construction Inspector for review. Pipes shall be cleaned prior to TV inspection of the pipes. Any sags, open joints, cracked pipes, etc. shall be repaired or removed by the CONTRACTOR at the CONTRACTOR's expense. A television survey will be performed as part of the final testing in the twentieth (20th) month of the maintenance period.

RETAINING WALLS

1. All retaining walls, regardless of height, will be reviewed and approved by the City Engineering Department
2. All retaining walls (including foundation stem walls), regardless of height, will be constructed of rock/stone/brick or rock/stone/brick faced. No smooth concrete walls are allowed. Wall materials shall be the same for all walls on the project.
3. All portions, including footings, tie-backs, and drainage backfill, of the wall shall be on-site and not encroach into any public easements or right-of-way. The entire wall shall be in one lot and shall not be installed along a lot line.
4. All walls 3 feet and taller will be designed and signed/sealed by a registered professional engineer in the State of Texas. The wall design engineer is required to inspect the wall construction and supply a signed/sealed letter of wall construction compliance to the City of Rockwall along with wall as-builts prior to City Engineering acceptance.
5. No walls are allowed in detention easements. A variance to allow retaining walls in a detention easement will require approval by the Planning and Zoning Commission with appeals being heard by the City Council

FINAL ACCEPTANCE AND RECORD DRWINGS/AS-BUILTS

1. Final Acceptance shall occur when all the items on the Checklist for Final Acceptance have been completed and signed-off by the City. An example of the checklist for final acceptance has been included in the Appendix of the Standards of Design and Construction. Items on the checklist for final acceptance will vary per project and additional items not shown on the check list may be required.
2. After improvements have been constructed, the developer shall be responsible for providing to the City "As Built" or "Record Drawings". The Design Engineer shall furnish all digital files of the project formatted in Auto Cad 14, or 2000 format or newer and Adobe Acrobat (.pdf) format with a CD-ROM disk or flash drive. The disk or drive shall include a full set of plans along with any landscaping, wall plans, and details sheets.
3. Submit 1-set of printed drawings of the "Record Drawings" containing copies of all sheets to the Engineering Construction Inspector for the project. The printed sheets will be reviewed by the inspector PRIOR to producing the "Record Drawing" digital files on disk or flash drive. This will allow any revisions to be addressed prior to producing the digital files.
4. Record Drawing Disk drawings shall have the Design Engineers seal, signature and must be stamped and dated as "Record Drawings" or "As Built Drawings" on all sheets.
5. The City of Rockwall will not accept any Record Drawing disk drawings which include a disclaimer. A disclaimer shall not directly or indirectly state or indicate that the design engineer or the design engineer's surveyor/surveyors did not verify grades after construction, or that the Record Drawings were based solely on information provided by the construction contractor/contractors. Any Record Drawings which include like or similar disclaimer verbiage will not be accepted by the City of Rockwall.
6. Example of Acceptable Disclaimer: "To the best of our knowledge ABC Engineering, Inc., hereby states that this plan is As-Built. This information provided is based on surveying at the site and information provided by the contractor."

"RECORD DRAWINGS"

To the best of our knowledge Kimley-Horn and Associates, inc., hereby states that this plan is As-Built. This information provided is based on surveying at the site and information provided by the contractor.

12/18/2025

MATT LUCAS PE

DATE:

D.V.

RELEASED FOR CONSTRUCTION
RESPONSIBILITY FOR ADEQUACY OF DESIGN
NS WITH THE DESIGN ENGINEER. THE CITY
OCKWALL, IN REVIEWING AND RELEASING
FOR CONSTRUCTION, ASSUMES NO
NSIBILITY FOR ADEQUACY OR ACCURACY OF
N

CITY

DATE



GENERAL CONSTRUCTION NOTES
Sheet 2 of 2
October 2020

**CITY OF ROCKWALL
ENGINEERING DEPARTMENT**


385 S. Goliad
Rockwall, Texas 75087


CITY GENERAL NOTES (2 OF 2)

ROCKWALL CAMPUS RING ROAD PROJECT

PREPARED FOR





		ISSUE FOR CONSTRUCTION		108192024	M
		DATE	REVISIONS	DATE	E
13455 NOEL RD, TWO GALLERIA OFFICE TOWER SUITE 100 DALLAS, TX 75240 PHONE: 972-235-3620 WWW.KIMLEY-HORN.COM TX-F-0228 © 2024 KIMLEY-HORN AND ASSOCIATES, INC.					
MATTHEW A. LUCAS 108727 FRANKE					
NAME	GRADE	NAME	GRADE	NAME	GRADE
KHA PROJECT 084685015	AS SHOWN	MFJ	WV	WV	MA
DATE 09/19/2024	RAWN BY				
CALE	DESIGNED BY				

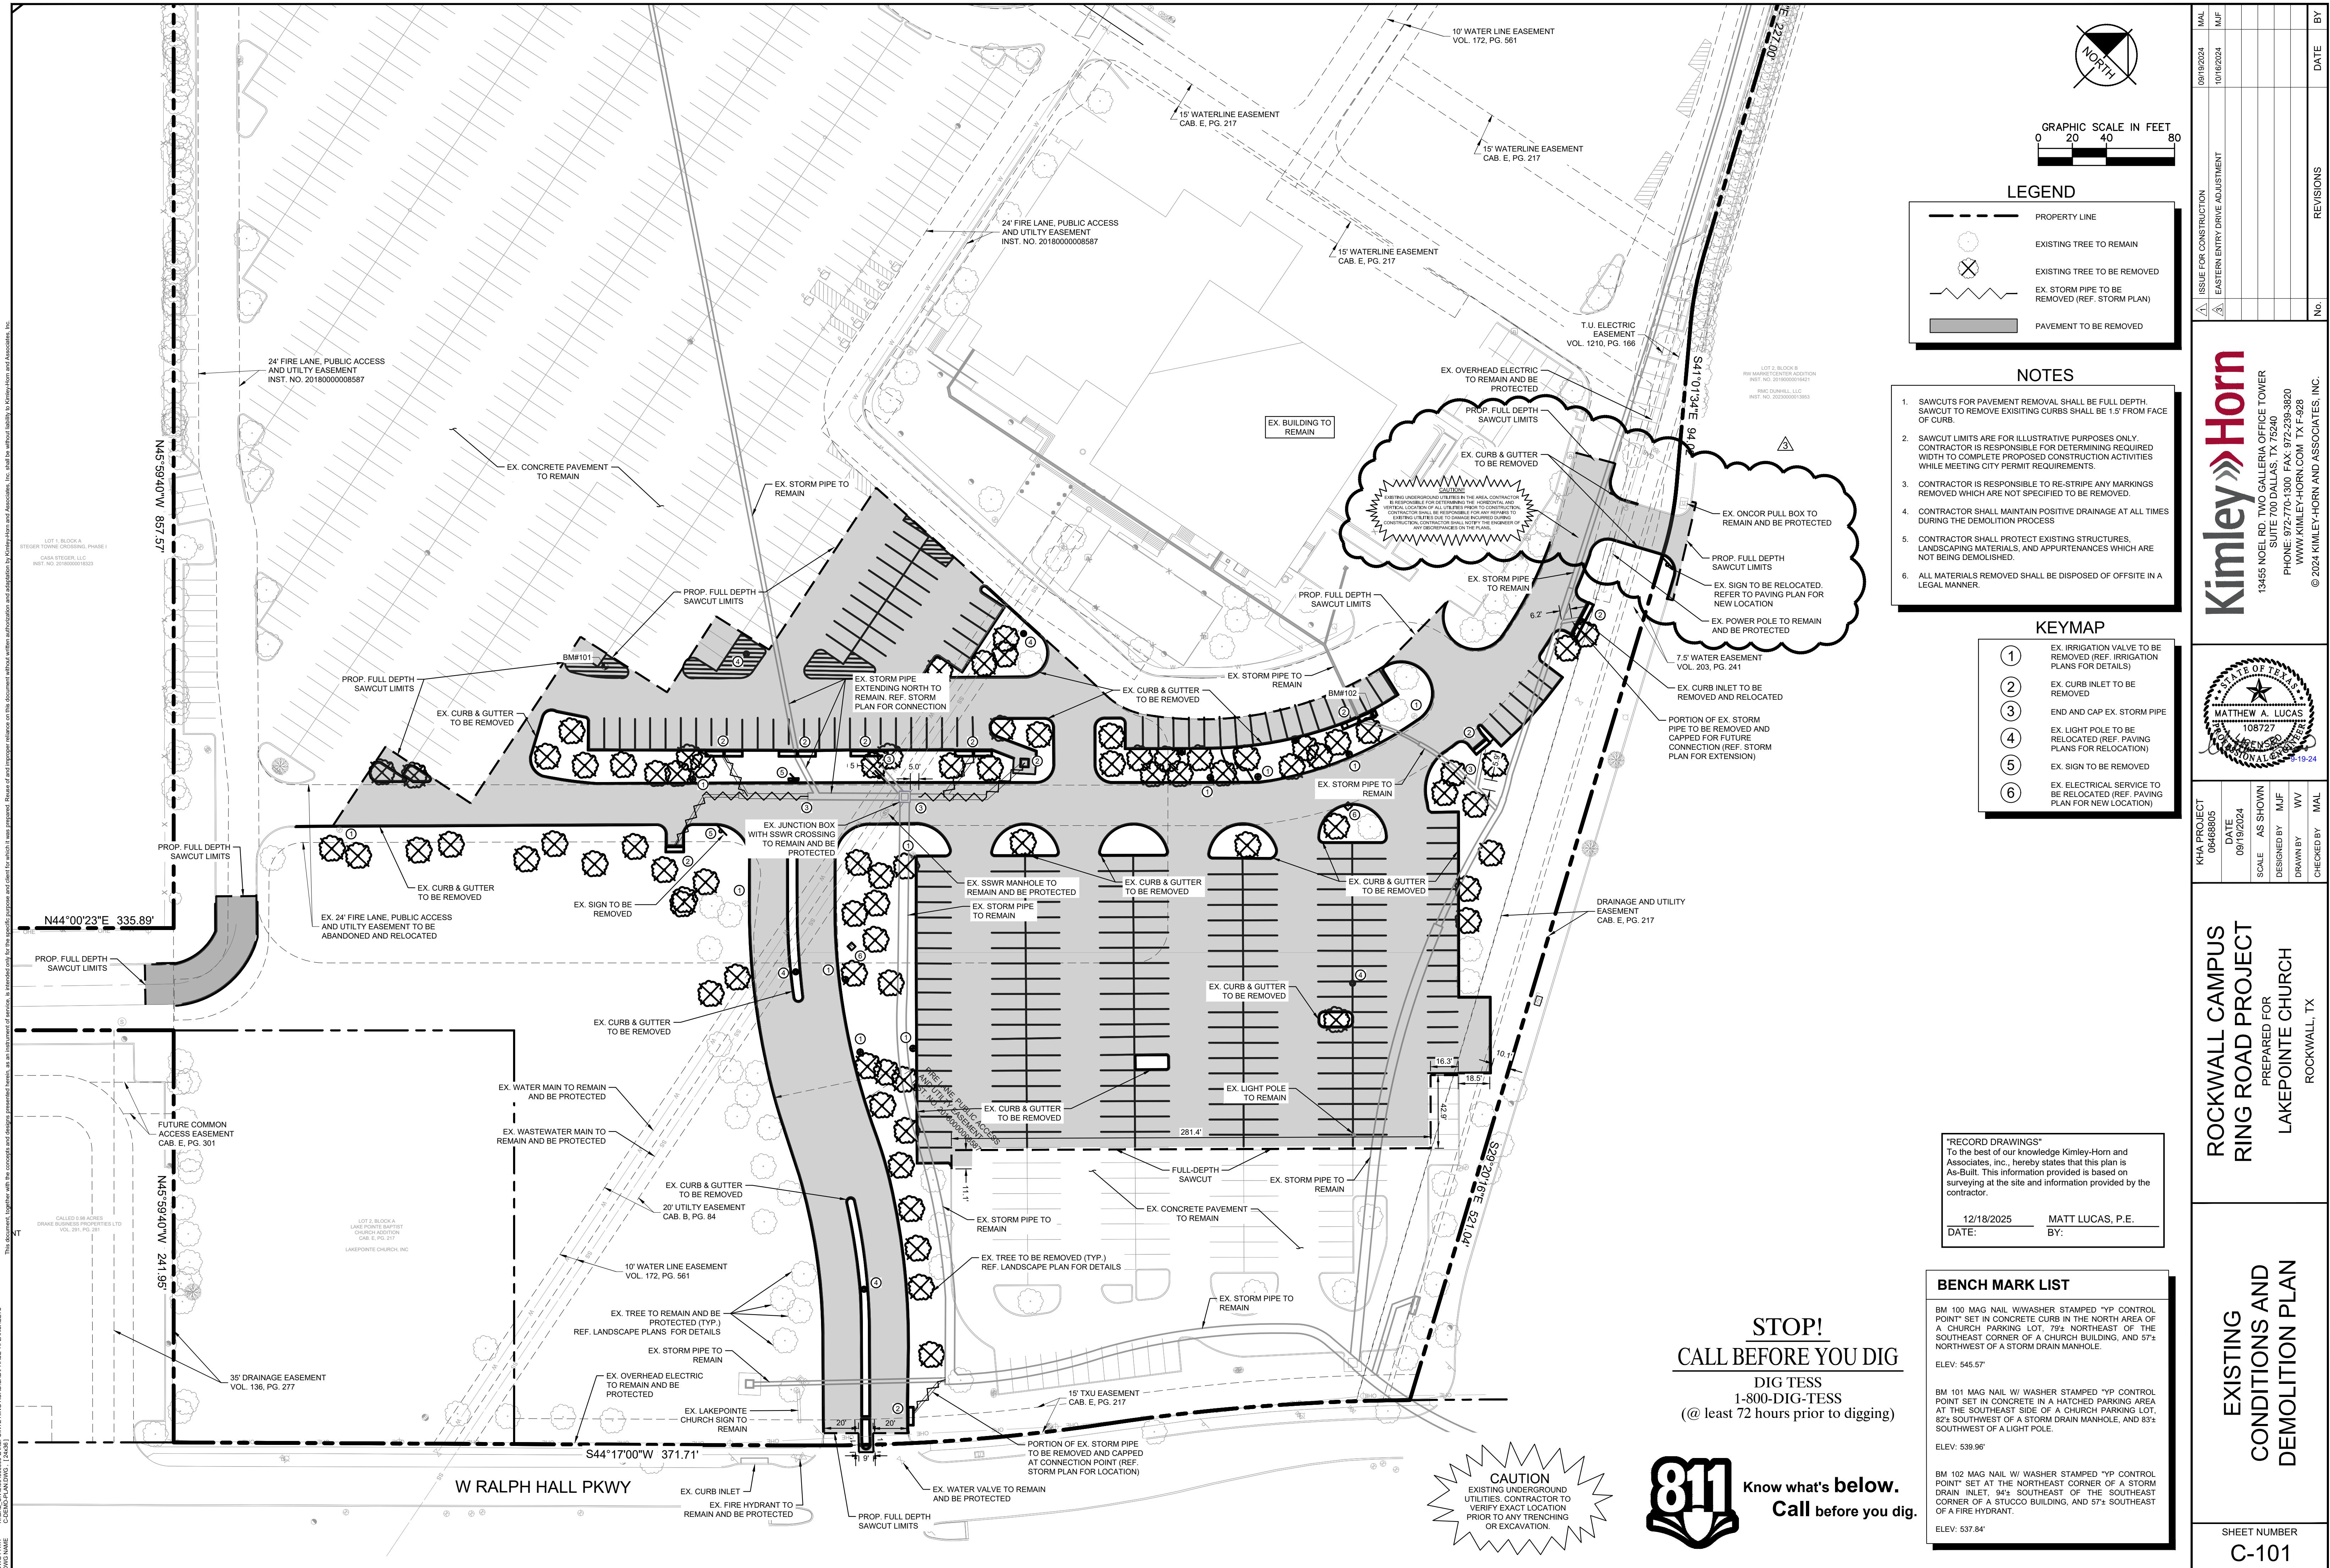

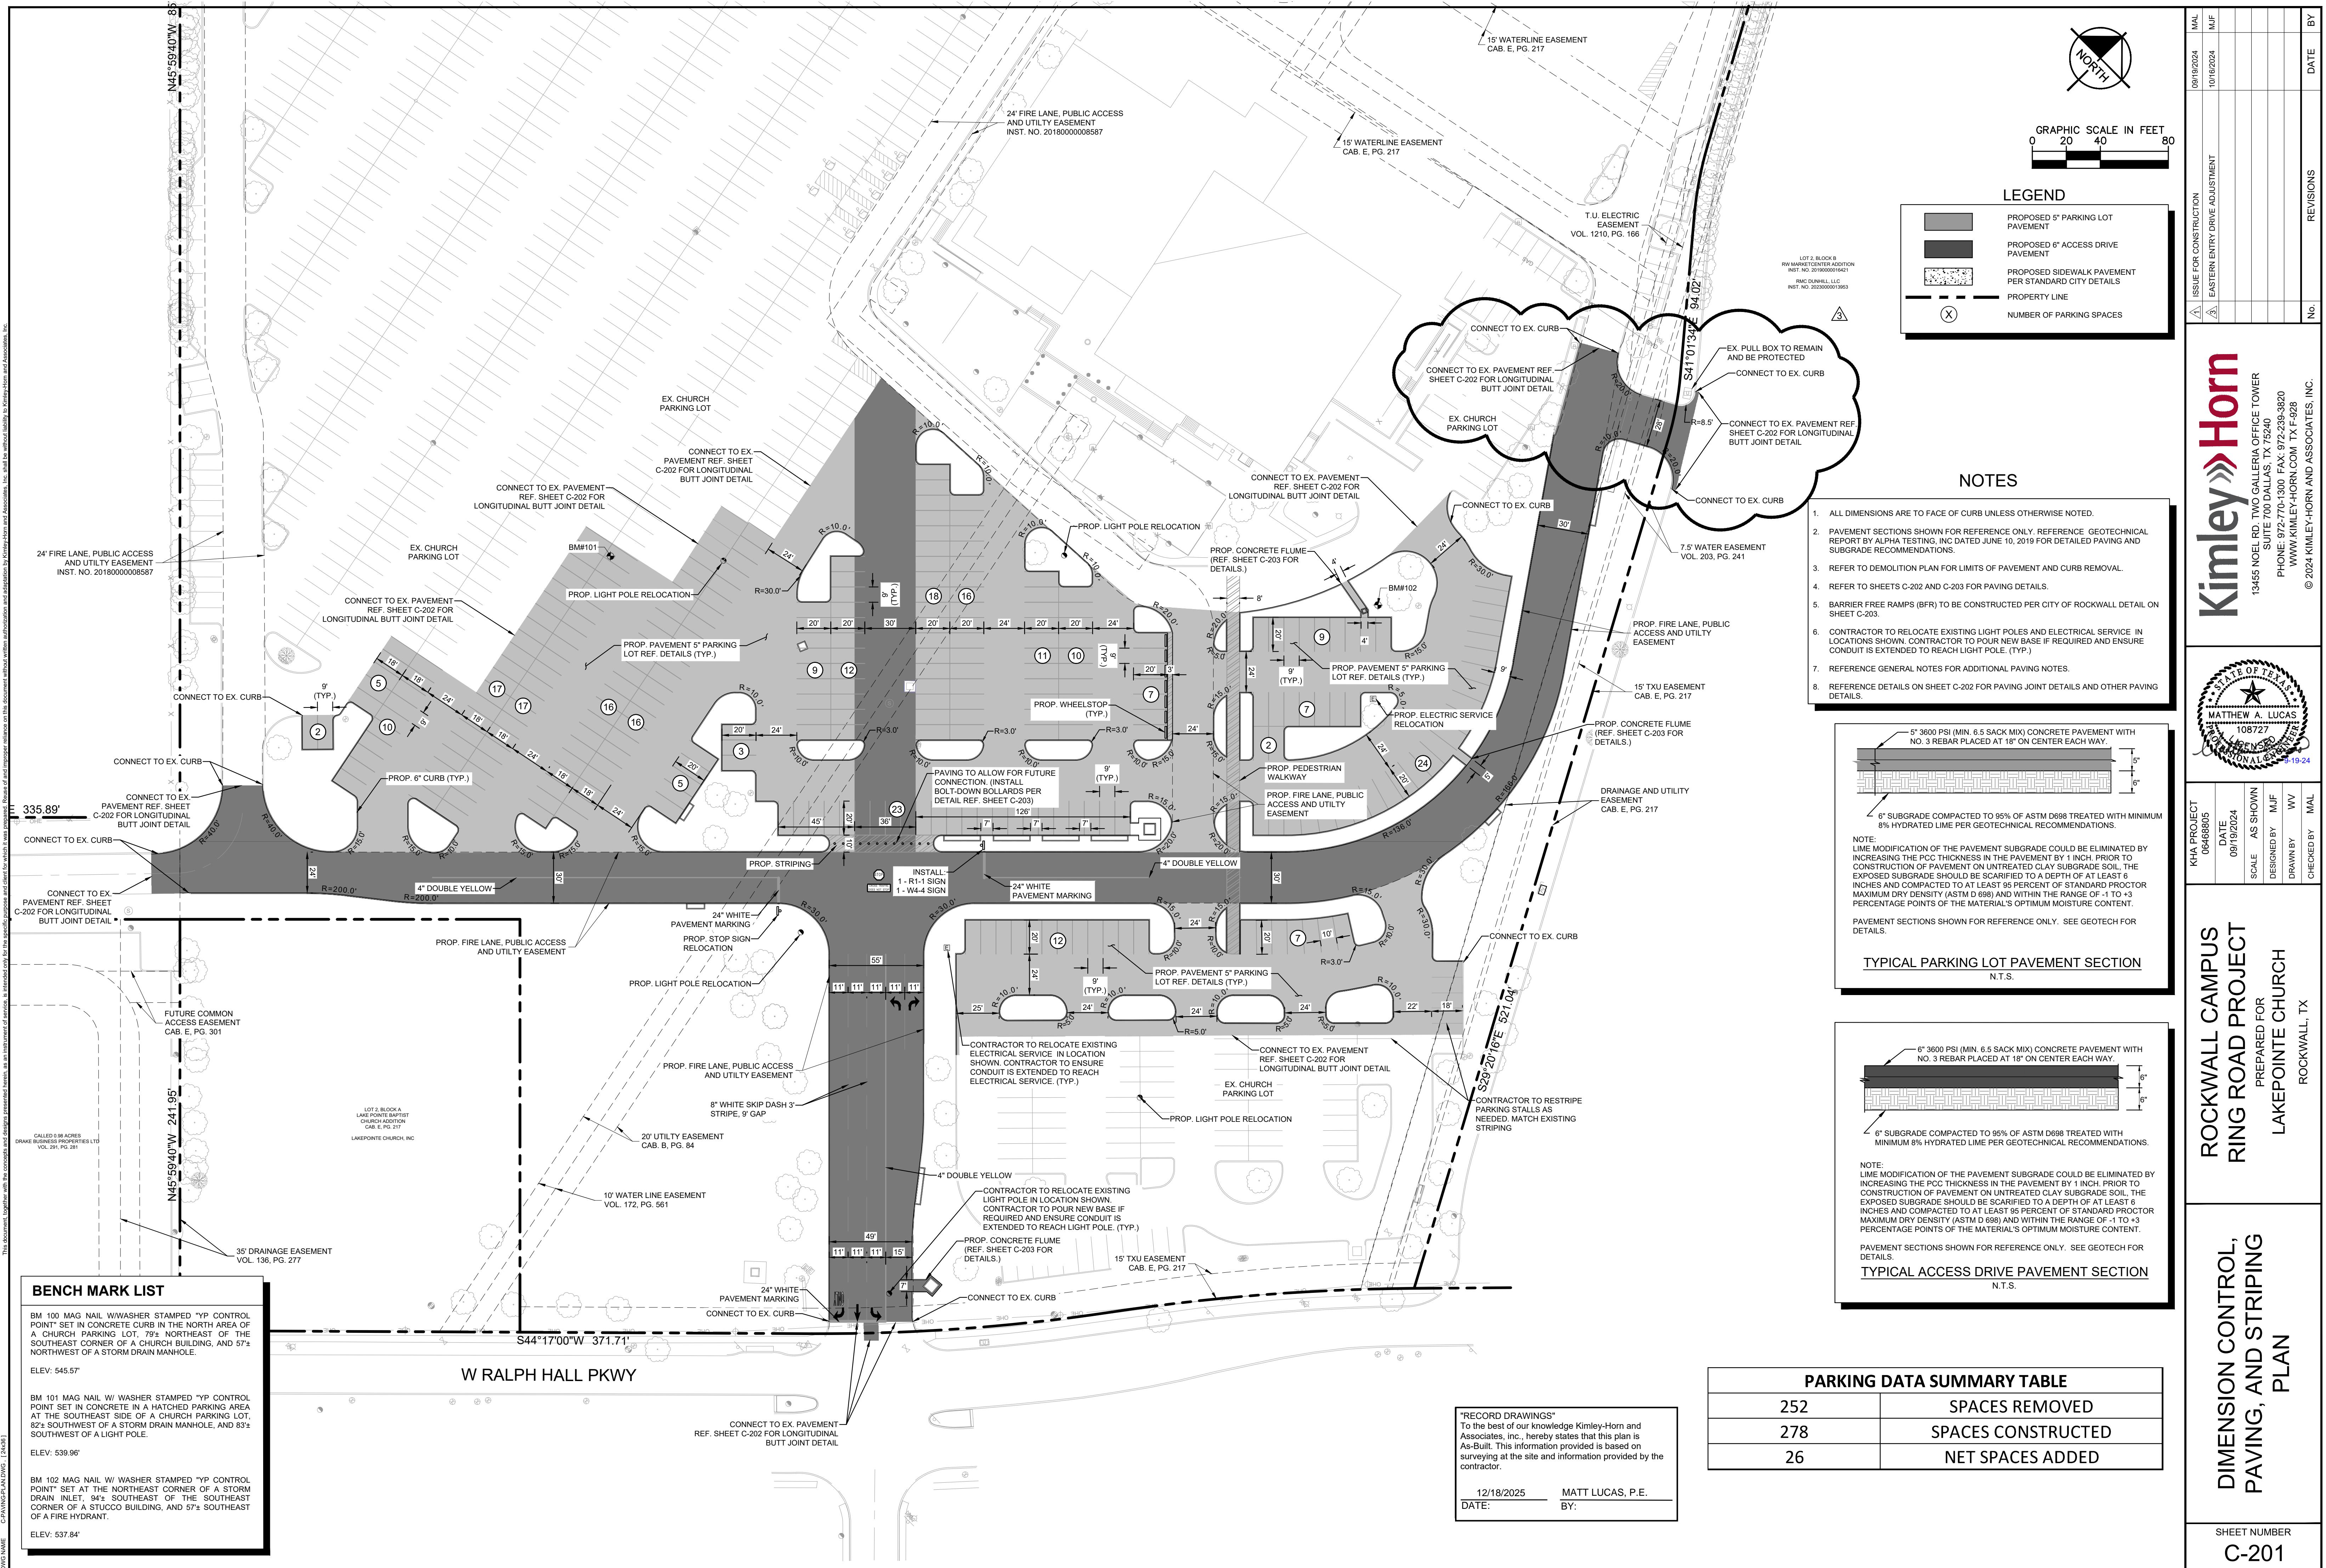

"RECORD DRAWINGS"
To the best of our knowledge Kimley-Horn and Associates, inc., hereby states that this plan is As-Built. This information provided is based on surveying at the site and information provided by the contractor.

12/18/2025 MATT LUCAS, P.E.
DATE: BY:

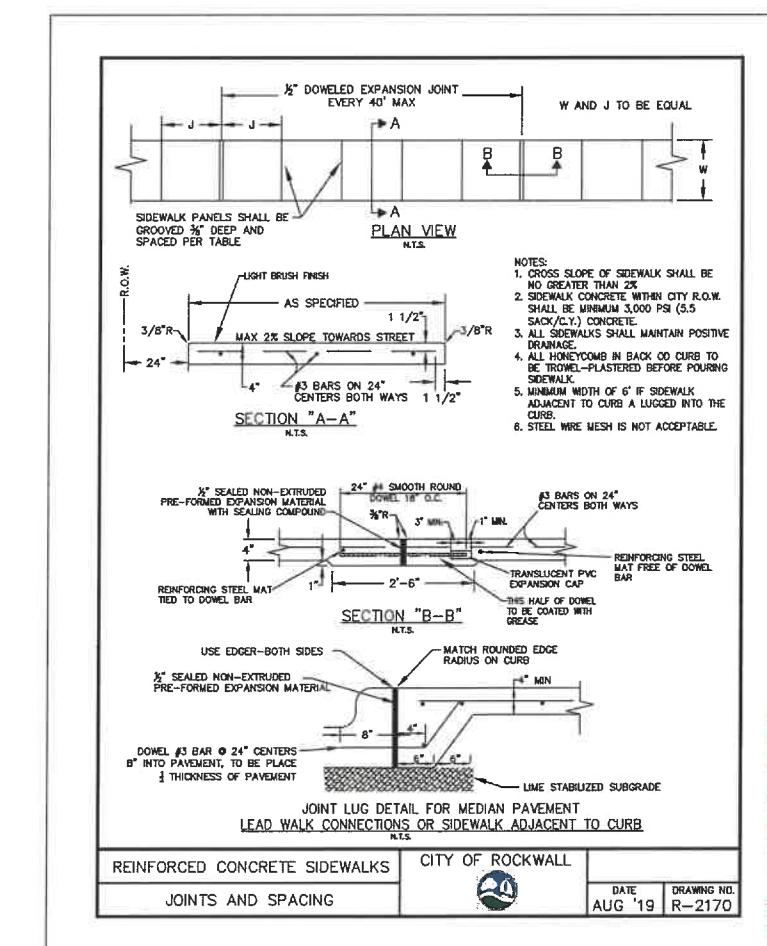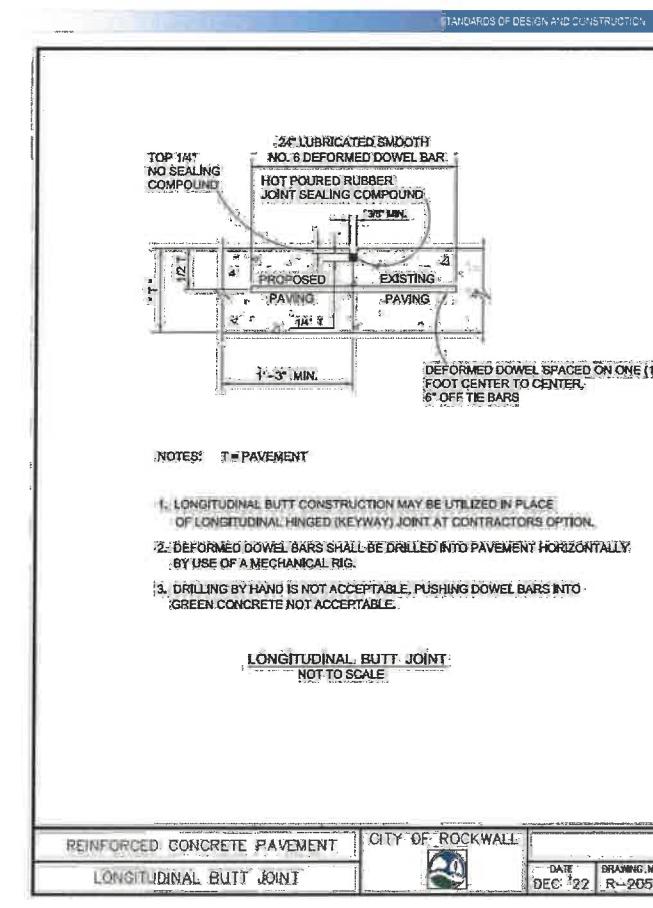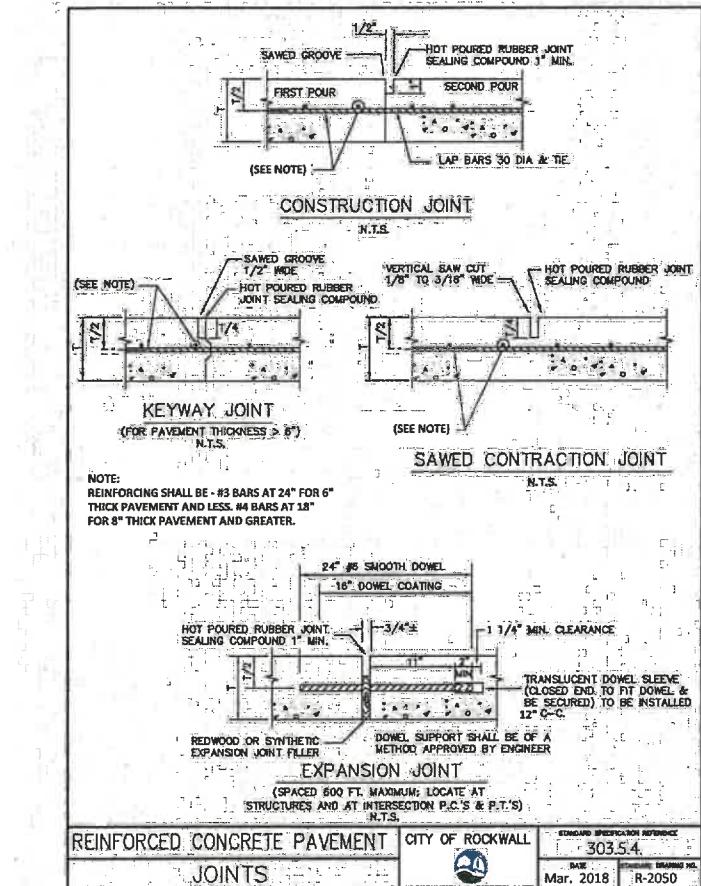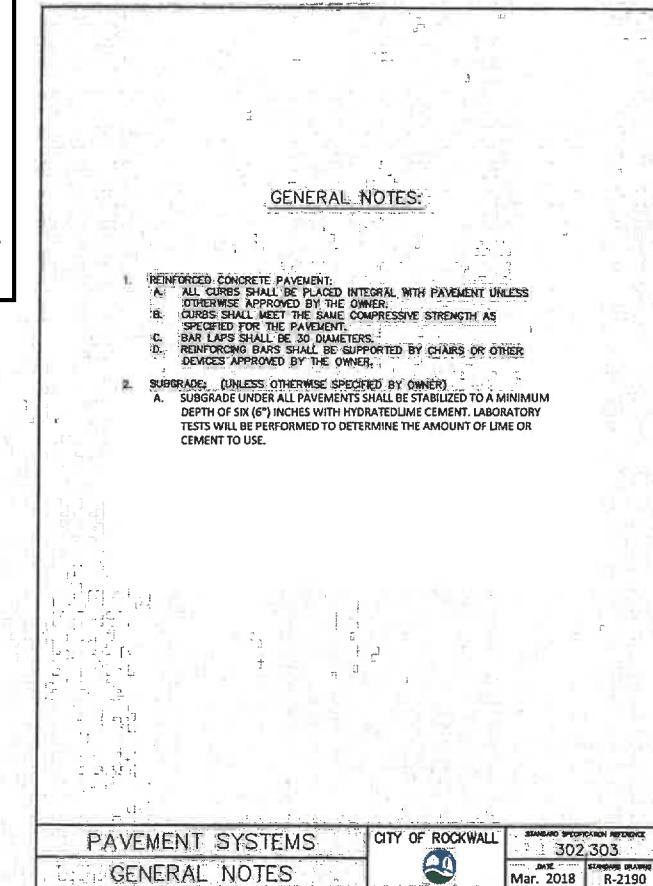

RELEASED FOR CONSTRUCTION
ALL RESPONSIBILITY FOR ADEQUACY OF DESIGN REMAINS WITH THE DESIGN ENGINEER. THE CITY OF ROCKWALL, IN REVIEWING AND RELEASING PLANS FOR CONSTRUCTION, ASSUMES NO RESPONSIBILITY FOR ADEQUACY OR ACCURACY OF DESIGN.

CITY DATE

REVISIONS	DATE	BY
	10/19/2024	MAIL


Kimley-Horn
13455 NOEL RD. TWO GALLERIA OFFICE TOWER
SUITE 700 DALLAS, TX 75240
PHONE: 972-770-300 FAX: 972-235-3820
WWW.KIMLEY-HORN.COM TX F-828
© 2024 KIMLEY-HORN AND ASSOCIATES, INC.

ROCKWALL CAMPUS RING ROAD PROJECT
PREPARED FOR LAKEPOINTE CHURCH
ROCKWALL, TX


PAVING DETAILS (1 OF 2)

KHA PROJECT 00468805	DATE 09/19/2024	AS SHOWN
SCALE 1:50	DESIGNED BY M.J.F.	DRAWN BY W.V.
CHECKED BY M.A.L.		

SHEET NUMBER C-202

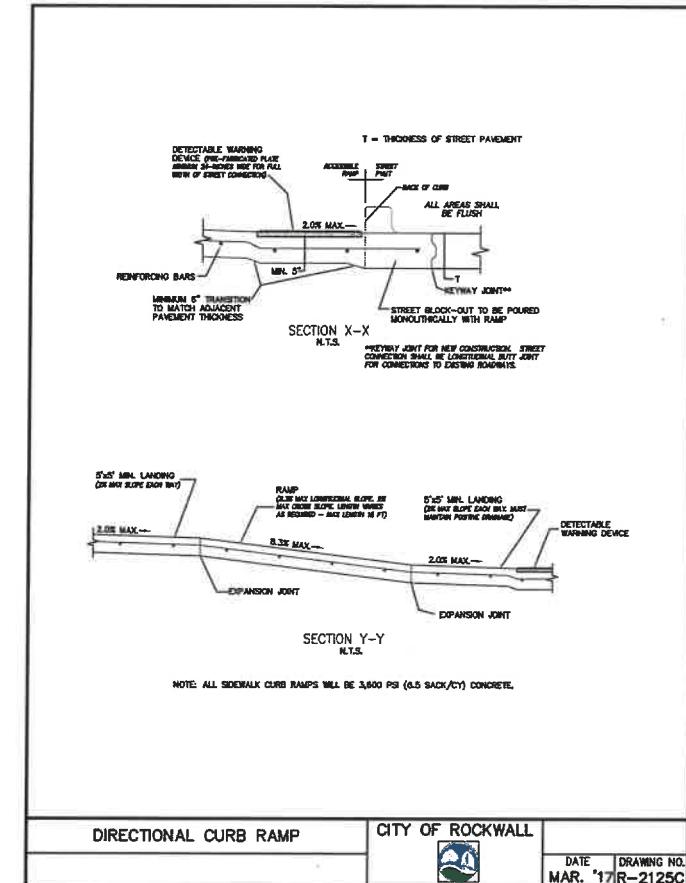


DIRECTIONAL CURB RAMP	CITY OF ROCKWALL	DATE: MAR. '17 DRAWING NO. R-2125C
-----------------------	------------------	------------------------------------

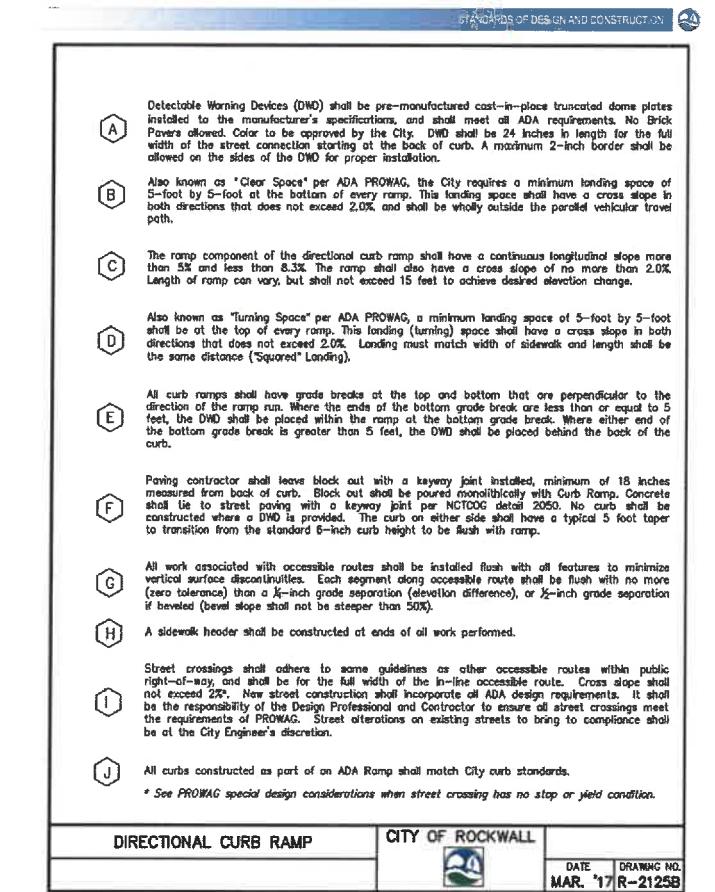


DIRECTIONAL CURB RAMP	CITY OF ROCKWALL	DATE: MAR. '17 DRAWING NO. R-2125B
-----------------------	------------------	------------------------------------

CITY OF ROCKWALL PAGE 1 OF 10

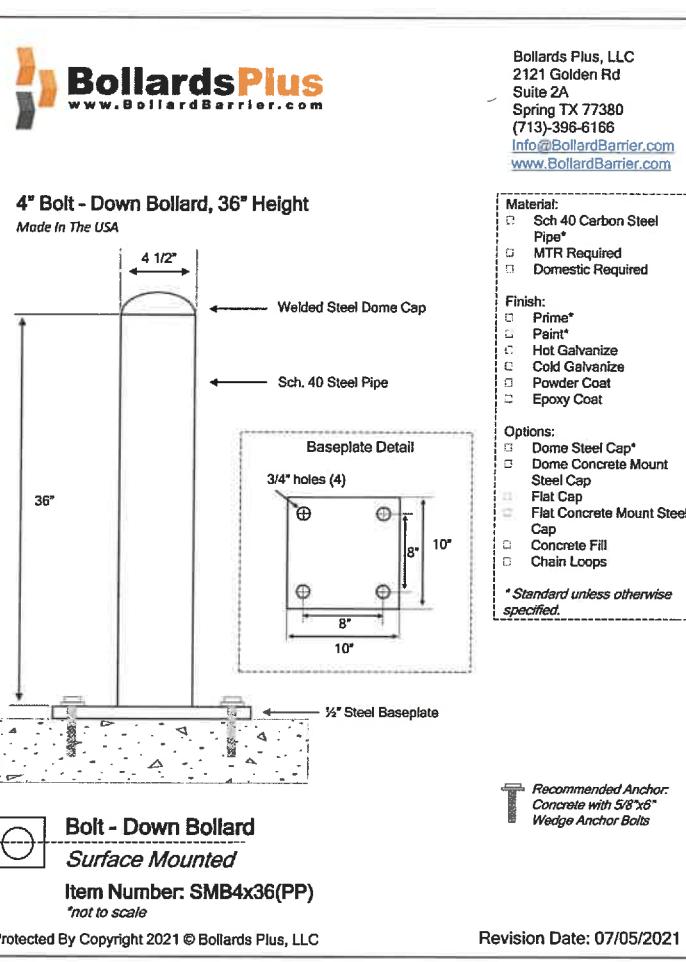

Protected By Copyright 2021 © Bollards Plus, LLC
*not to scale
Revision Date: 07/05/2021

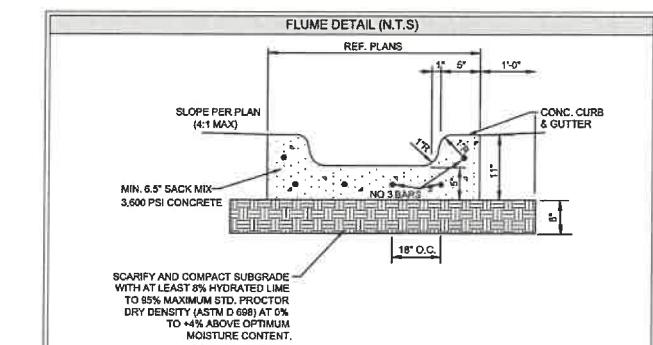

"RECORD DRAWINGS"
To the best of our knowledge Kimley-Horn and Associates, inc., hereby states that this plan is As-Built. This information provided is based on surveying at the site and information provided by the contractor.

12/18/2025 MATT LUCAS, P.E.
DATE: BY:


RELEASED FOR CONSTRUCTION
ALL RESPONSIBILITY FOR ADEQUACY OF DESIGN REMAINS WITH THE DESIGN ENGINEER. THE CITY OF ROCKWALL, IN REVIEWING AND RELEASING PLANS FOR CONSTRUCTION, ASSUMES NO RESPONSIBILITY FOR ADEQUACY OR ACCURACY OF DESIGN.

CITY _____ DATE _____

LAST SAVED BY: [Signature]	DATE: 09/19/2024	FILED BY: [Signature]	DATE: 09/19/2024
PROJECT NAME: ROCKWALL CAMPUS RING ROAD PROJECT	REVISION: 1	DESIGNED BY: [Signature]	DRAWN BY: [Signature]
ITEM: PAVING DETAILS (2 OF 2)	SCALE: AS SHOWN	APPROVED FOR: LAKEPOINTE CHURCH	CHECKED BY: [Signature]
SHEET NUMBER: C-203		CITY OF ROCKWALL, TX	

Kimley-Horn
13455 NOEL RD, TWO GALLERIA OFFICE TOWER
SUITE 700 DALLAS, TX 75240
PHONE: 972-776-3200 FAX: 972-239-3220
WWW.KIMLEY-HORN.COM TX-F-228
© 2024 KIMLEY-HORN AND ASSOCIATES, INC.



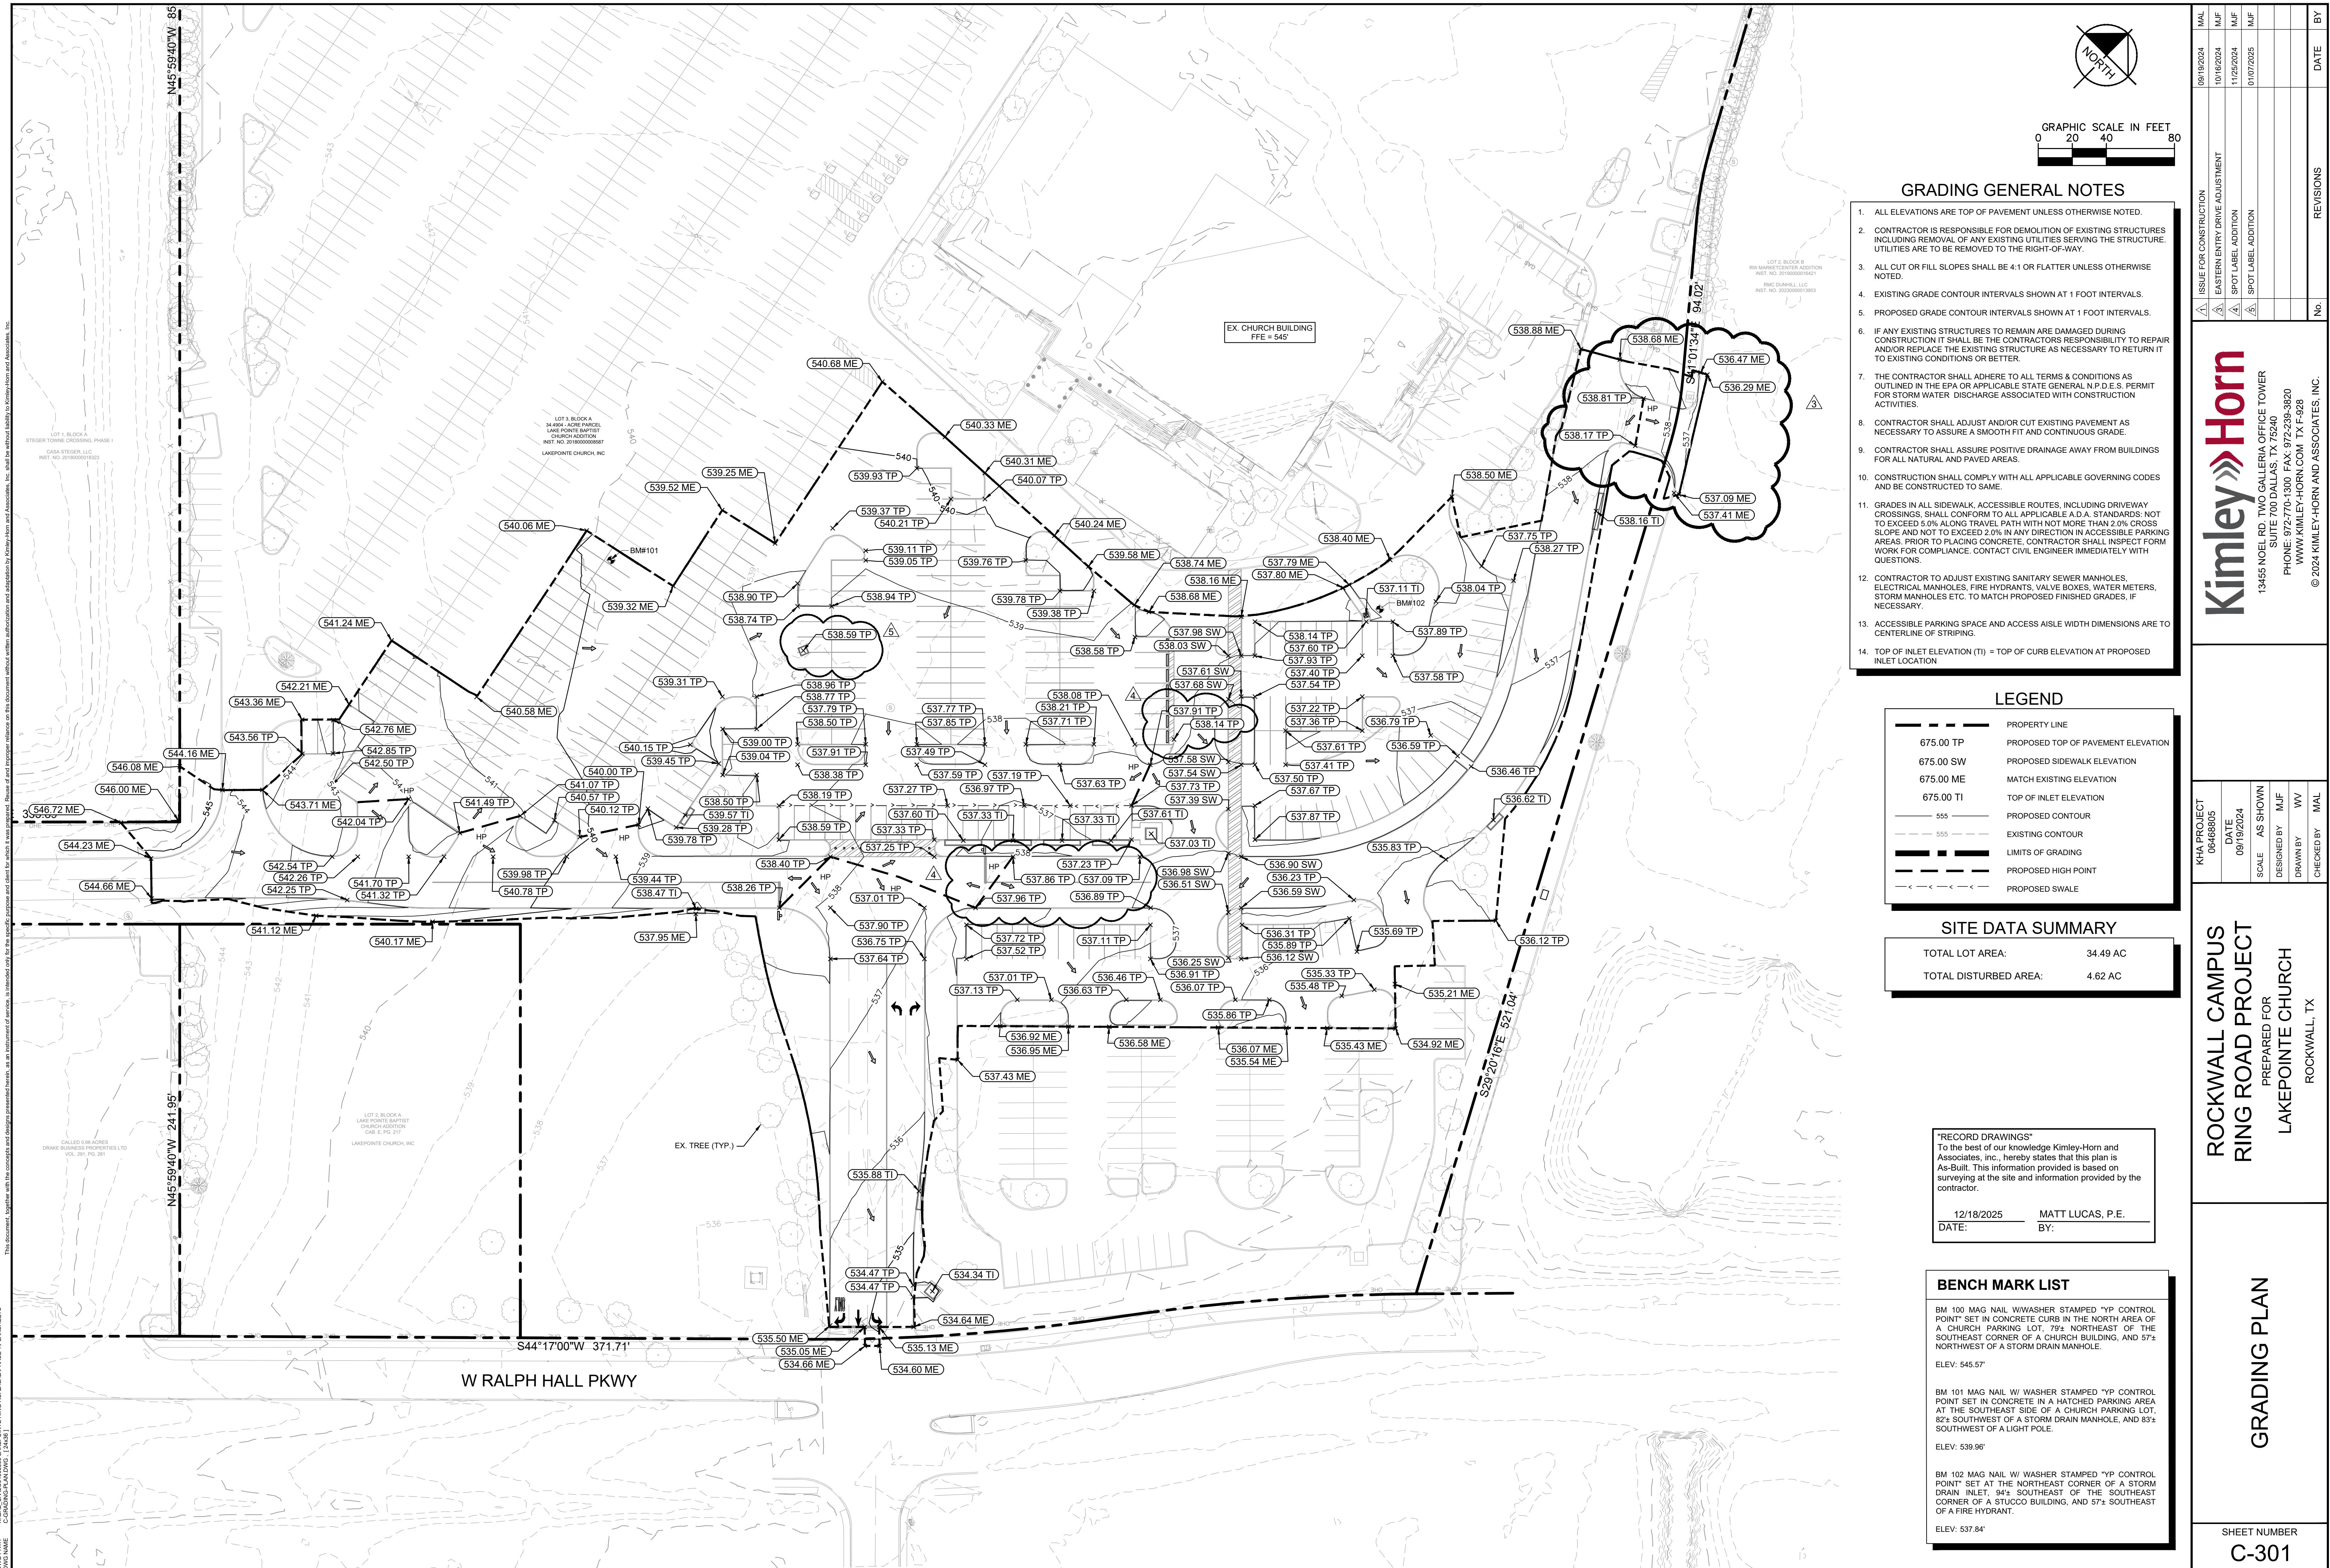

"RECORD DRAWINGS"

To the best of our knowledge Kimley-Horn and Associates, inc., hereby states that this plan is As-Built. This information provided is based on surveying at the site and information provided by the contractor.

12/18/2025

MATT LUCAS, P.E.

DATE:

BY:



GRAPHIC SCALE IN FEET
0 51.5 103.1 206.1

LEGEND

	AREA DESIGNATOR AREA IN ACRES Q100 FLOW IN CFS
	PROPERTY LINE
	PROPOSED DRAINAGE DIVIDE
	PROPOSED FLOW DIRECTION
Q = C 1 A (CFS)	
Q = DESIGN DISCHARGE (CFS)	
C = RATIONAL METHOD RUNOFF COEFFICIENT	
I = RAINFALL INTENSITY (INCH/HOUR)	
A = DRAINAGE AREA (ACRES)	

DRAINAGE GENERAL NOTES

1. CONTRACTOR TO FIELD VERIFY HORIZONTAL AND VERTICAL LOCATION OF EXISTING UTILITIES PRIOR TO CONSTRUCTION.
2. SEE STORM DRAIN PLAN & PROFILE SHEETS FOR DETAILED INFORMATION ON STORM DRAIN LINES.
3. ALL STORM DRAIN LINES SHALL BE RCP, CLASS III UNLESS OTHERWISE NOTED.
4. EXISTING DRAINAGE AREAS SHOWN PER AS-BUILT DRAWINGS FOR THE EXISTING LAKEPOINT ROCKWALL SUBJECT SITE. REFER TO DRAWINGS FOR EACH DRAINAGE AREA AS OUTLINED BELOW:
- 4.1. EX-A-1 TO EX-A-6: SHOWN PER LAKEPOINT CHURCH NEW CHAPEL/EDUCATION BUILDING AS-BUILT DRAWINGS BY HALFF ASSOCIATES DATED 6/1/2018.
- 4.2. EX-OS-A-1: OFF-PROPERTY AREA DELINEATED SEPARATELY FROM DRAINAGE AREA A-1 AS SHOWN IN EXISTING DRAWINGS BY HALFF ASSOCIATES DATED 6/1/2018. DESIGN DISCHARGE RATE (Q DESIGN) FOR EX-OS-A-1 CALCULATED USING EX-OS-A-1 AREA (A) AND DRAINAGE CRITERIA OUTLINED IN THE AFOREMENTIONED AS-BUILT DRAWINGS (C=0.8, I=1.2 INCHES = 0.93 IN/HOUR).
- 4.3. EX-B-1 TO EX-B-3, EX-B-4A & EX-B-4B: SHOWN PER LAKEPOINT CHURCH PARKING AND DRAINAGE IMPROVEMENTS AS-BUILT DRAWINGS BY HALFF ASSOCIATES DATED 7/20/2018.
- 4.4. EX-C-1: SHOWN PER LAKEPOINT CHURCH YOUTH DRAINS AS-BUILT DRAWINGS AND UTILITY LANS BY BENTLEY ENGINEERING DATED 1/8/2002. DESIGN DISCHARGE RATE (Q DESIGN) FOR EX-C-1 CALCULATED USING EX-C-1 AREA (A) AND DRAINAGE CRITERIA OUTLINED IN THE AFOREMENTIONED AS-BUILT DRAWINGS (C=0.8, I=1.2 INCHES = 0.93 IN/HOUR).
- 4.5. EX-D-1: SHOWN AS EX-15 CFS PER SHOWN PER LAKEPOINT CHURCH PARKING AND DRAINAGE IMPROVEMENTS AS-BUILT DRAWINGS BY HALFF ASSOCIATES DATED 6/23/2005.
- 4.6. EX-D-3B, EX-D-3D, & EX-OS-D-4: SHOWN PER TOPOGRAPHIC SURVEY BY KIMLEY-HORN DATED 12/1/2024. AS-BUILT DRAWINGS DID NOT SHOW THESE DRAINS AS BUILT. DESIGN BUT TOPOGRAPHIC SURVEY INDICATES RUNOFF SURFACE DRAINS TO THE SUBJECT SITE IN EXISTING CONDITIONS.
5. DESIGN POINTS OUTLINED BELOW:
- 5.1. Q DESIGN = DISCHARGE RATE PER AS-BUILT DRAWINGS
- 5.2. Q EX = DISCHARGE RATE PER CITY OF ROCKWALL DRAINAGE CRITERIA
- 5.3. Q CAP = EXISTING INLET CAPACITY

Kimley Horn

1345 NOL RD. SUITE 700 DALLAS, TX 75240-3820
PHONE: 972-770-1300 FAX: 972-255-9228
© 2024 KIMLEY-HORN AND ASSOCIATES, INC.



BENCH MARK LIST

BM 100 MAG NAIL W/WASHER STAMPED "YP" CONTROL POINT SET IN CONCRETE CURB IN THE NORTH AREA OF A CHURCH PARKING LOT, 79' NORTHEAST OF THE SOUTHEAST CORNER OF A CHURCH BUILDING, AND 57' NORTHWEST OF A STORM DRAIN MANHOLE.
ELEV: 545.57

BM 101 MAG NAIL W/WASHER STAMPED "YP" CONTROL POINT SET IN CONCRETE IN A HATCHED PARKING AREA AT THE SOUTHEAST SIDE OF A CHURCH PARKING LOT, 82' SOUTHWEST OF A STORM DRAIN MANHOLE, AND 83' SOUTHWEST OF A LIGHT POLE.
ELEV: 539.56

BM 102 MAG NAIL W/WASHER STAMPED "YP" CONTROL POINT SET AT THE NORTHEAST CORNER OF A STORM DRAIN INLET, 94' SOUTHEAST OF THE SOUTHEAST CORNER OF A STUCCO BUILDING, AND 57' SOUTHEAST OF A FIRE HYDRANT.
ELEV: 537.84

ROCKWALL CAMPUS
RING ROAD PROJECT
PREPARED FOR
LAKEPOINT CHURCH
ROCKWALL, TX

EXISTING DRAINAGE
AREA MAP

RELEASED FOR CONSTRUCTION
ALL RESPONSIBILITY FOR ADEQUACY OF DESIGN
REMAINS WITH THE DESIGN ENGINEER. THE CITY
OF ROCKWALL, IN REVIEWING AND RELEASING
PLANS FOR CONSTRUCTION, ASSUMES NO
RESPONSIBILITY FOR ADEQUACY OR ACCURACY OF
DESIGN.

CITY

DATE


SHEET NUMBER
C-401

DRAINAGE AREA TABLE							
DRAINAGE AREA NO.	AREA (sq ft)	ANTECEDENT FACTOR	RUNOFF COEFFICIENT "C"	TIME OF CONCENTRATION (minutes)	RAINFALL INTENSITY "I" 100 (in/hr)	TOTAL FLOW Q100 (cfs)	COLLECTION POINT
EX-A-1	8.46	1.00	0.90	10	9.80	74.50	EX. (4) 20' CI AND 4' X 4' TYPE-Y INLET
EX-A-2	3.54	1.00	0.90	10	9.80	31.21	SURFACE DRAIN TO EX. FLUME TO A-1
EX-A-3	0.33	1.00	0.90	10	9.80	2.91	SURFACE DRAIN TO EX. FLUME TO A-1
EX-A-4	0.08	1.00	0.90	10	9.80	0.67	ROOF DRAINS DAYLIGHT - SURFACE DRAIN TO A-1
EX-A-5	0.47	1.00	0.90	10	9.80	4.12	EX. 4' X 4' TYPE-Y INLET
EX-A-6	2.87	1.00	0.90	10	9.80	25.35	EX. 5' X 5' TYPE-Y INLET
EX-B-1	5.71	1.00	0.90	10	9.80	50.35	EX. 27' HEADWALL
EX-B-2	2.80	1.00	0.90	10	9.80	24.70	SURFACE DRAIN TO EX-B-3
EX-B-3	2.09	1.00	0.90	10	9.80	18.43	EX. 20' CI
EX-B-4A	0.64	1.00	0.90	10	9.80	5.64	EX. 10' CI
EX-B-4B	0.41	1.00	0.90	10	9.80	3.62	EX. 15' CI
EX-C-1	0.44	1.00	0.90	10	9.80	3.87	EX. ROOF AND LANDSCAPE DRAINS
EX-C-2	0.68	1.00	0.90	10	9.80	6.03	EX. ROOF AND LANDSCAPE DRAINS
EX-D-1	3.05	1.00	0.90	10	9.80	26.91	EX. 6' X 6' TYPE-Y INLET
EX-D-2	0.60	1.00	0.90	10	9.80	5.29	EX. 10' CI
EX-D-3A	2.91	1.00	0.90	10	9.80	25.66	EX. 4' X 4' TYPE-Y INLET
EX-D-3B	0.48	1.00	0.90	10	9.80	4.22	SURFACE DRAIN TO D-3A
EX-D-4	0.80	1.00	0.90	10	9.80	7.07	EX. 10' CI
EX-OS-A-1	4.92	1.00	0.90	10	9.80	43.37	SURFACE DRAIN TO A-1
EX-OS-D-3	0.07	1.00	0.90	10	9.80	0.59	SURFACE DRAIN TO D-3A
EX-OS-D-4	0.22	1.00	0.90	10	9.80	1.96	SHEET FLOW TO EX-D-4

ISSUE FOR CONSTRUCTION	VAL
09/19/2024	DATE

REVISIONS

No.

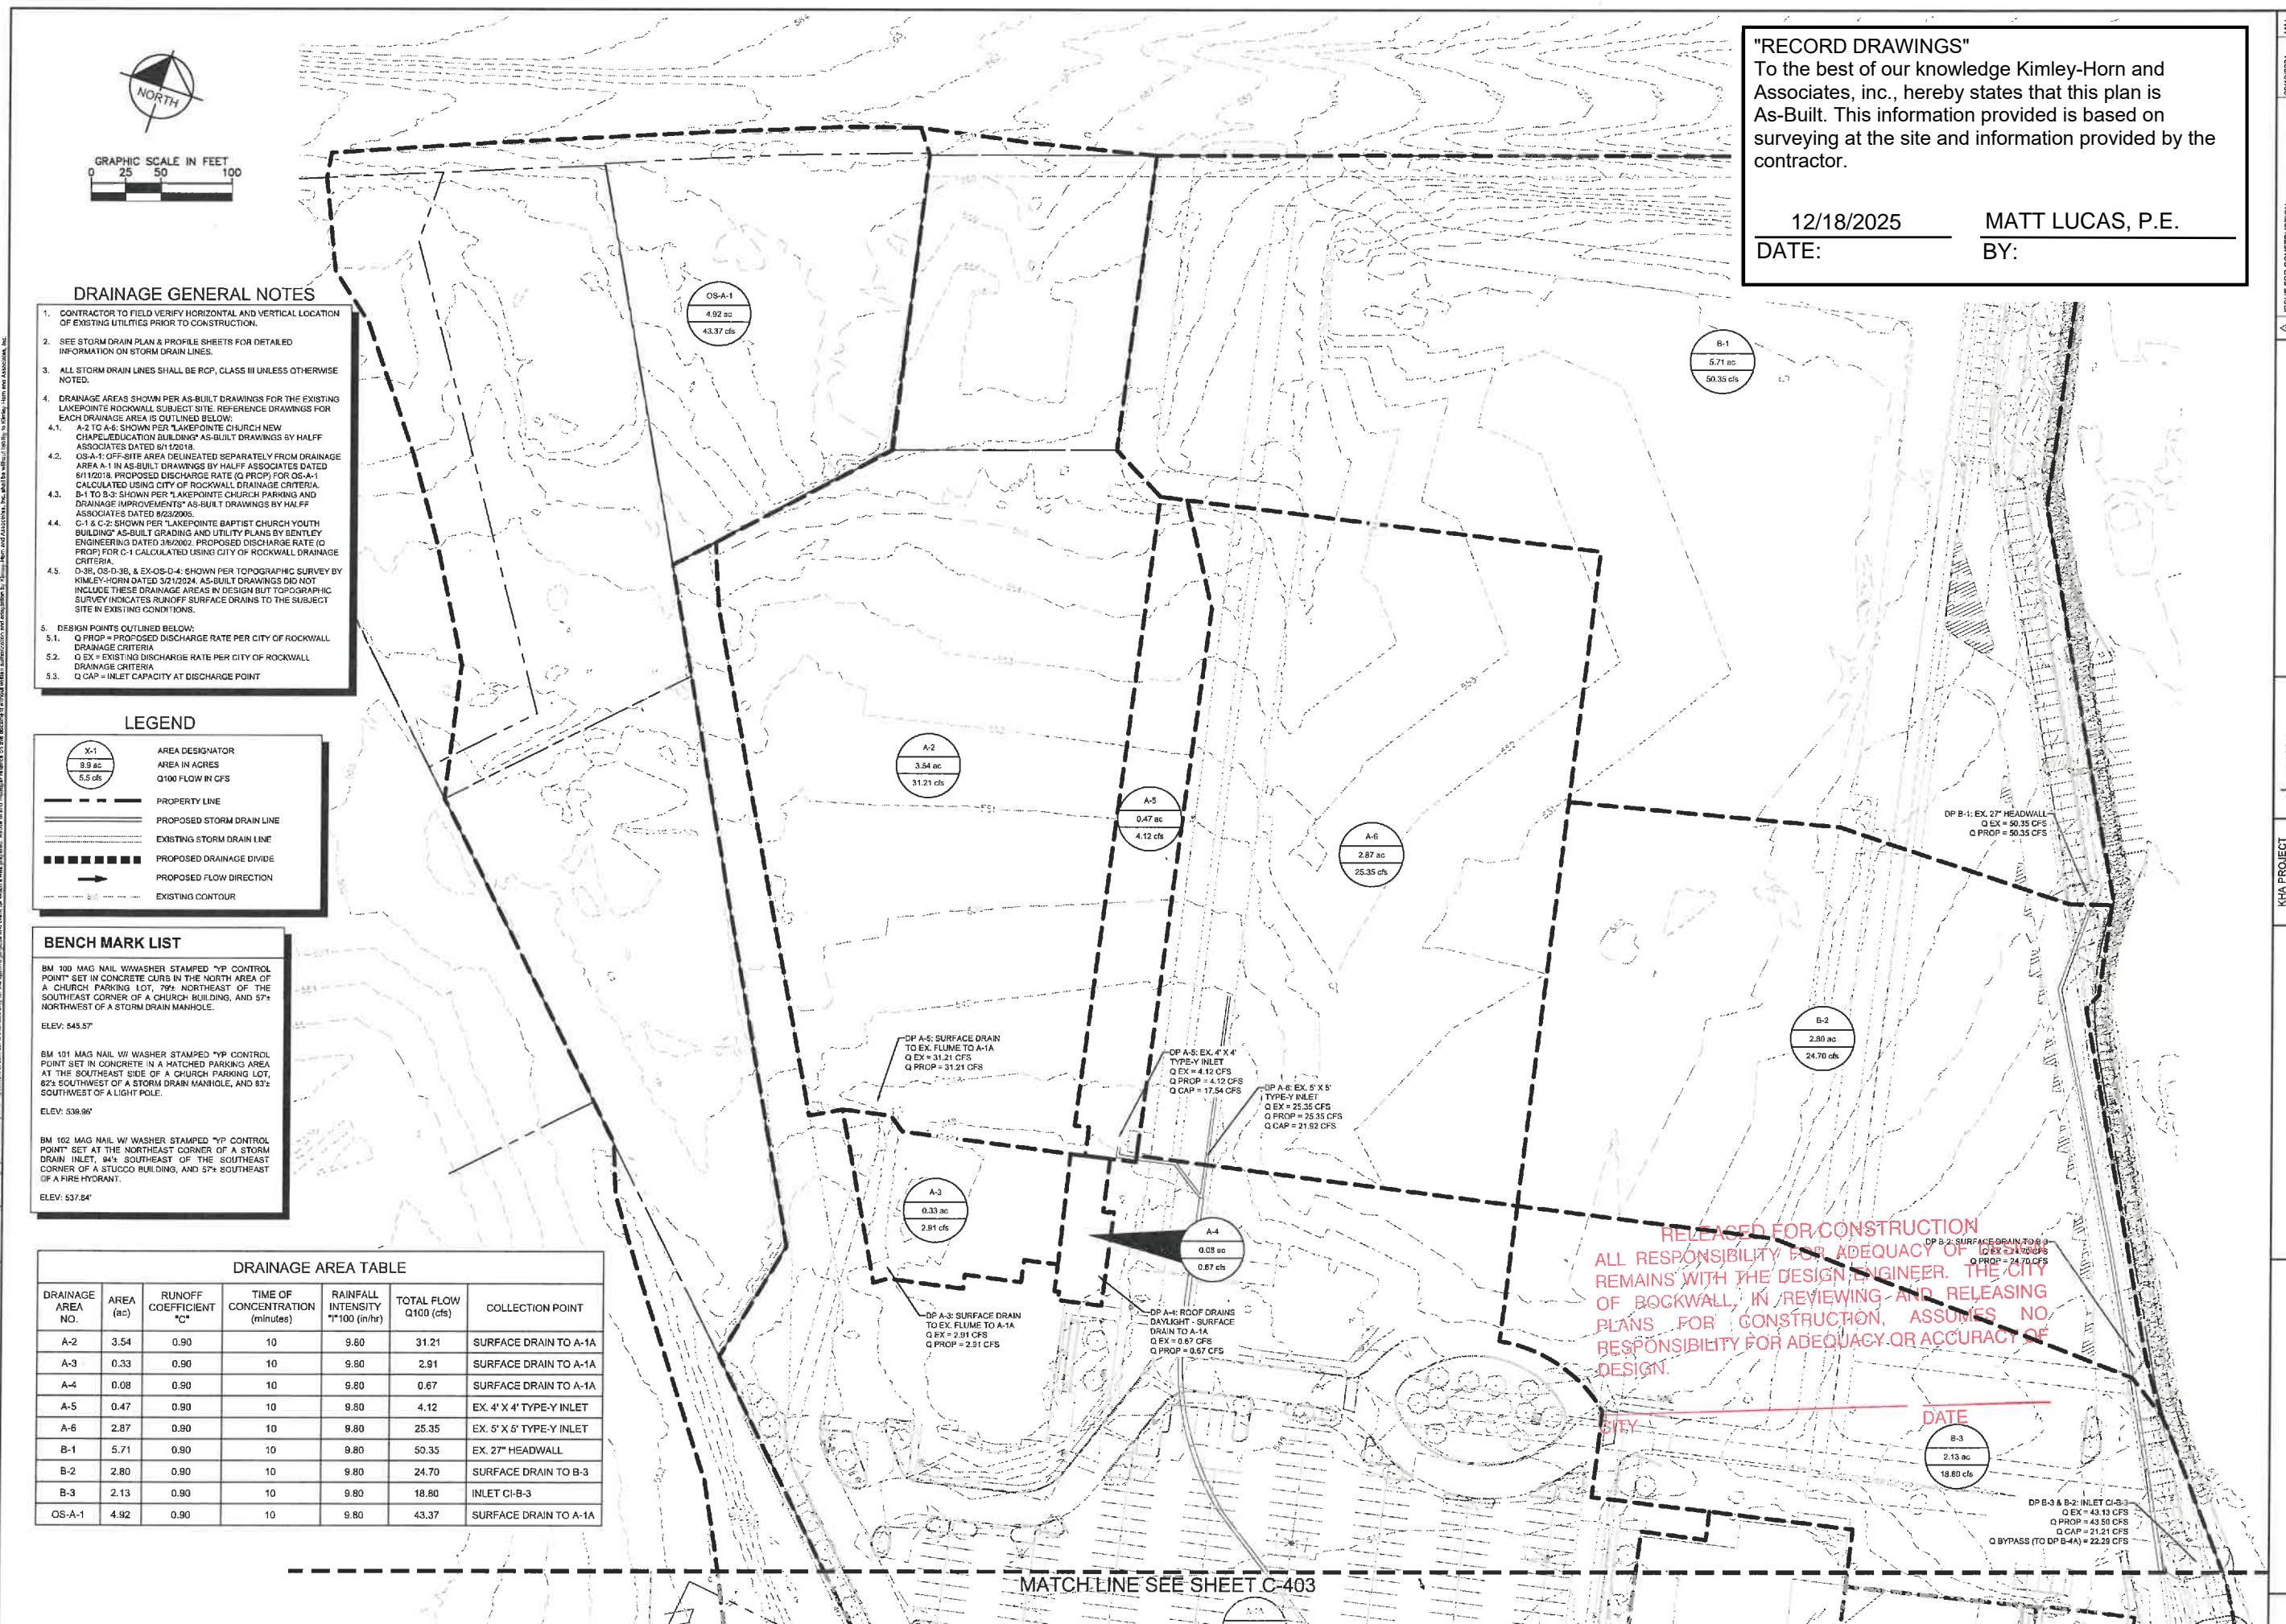

RECORD DRAWINGS"

To the best of our knowledge Kimley-Horn and Associates, inc., hereby states that this plan is As-Built. This information provided is based on surveying at the site and information provided by the contractor.

DATE: 12/18/2025

MATT LUCAS, P.E.
BY:

09/19/2025	WAL
ISSUE FOR CONS TRUC LUN	REVISIONS
01	DATE
02	BY
03	
04	

Kimley-Horn
13455 NOEL RD., TWO GALLERIA OFFICE TOWER
SUITE 700 DALLAS, TX 75240

A circular notary seal for the State of Texas. The outer ring contains the words "STATE OF TEXAS" at the top and "NOTARY PUBLIC" at the bottom. The inner circle features a five-pointed star in the center, with the name "MATTHEW A. LUCAS" above it and the number "105727" below it. The word "TEXAS" is curved along the bottom edge of the inner circle. The entire seal is stamped with a date, "09/19/2024", at the bottom.

**ROCKWALL CAMPUS
RING ROAD PROJECT**


PROPOSED DRAINAGE
AREA MAP (1 OF 2)



SHEET NUMBER
C-402

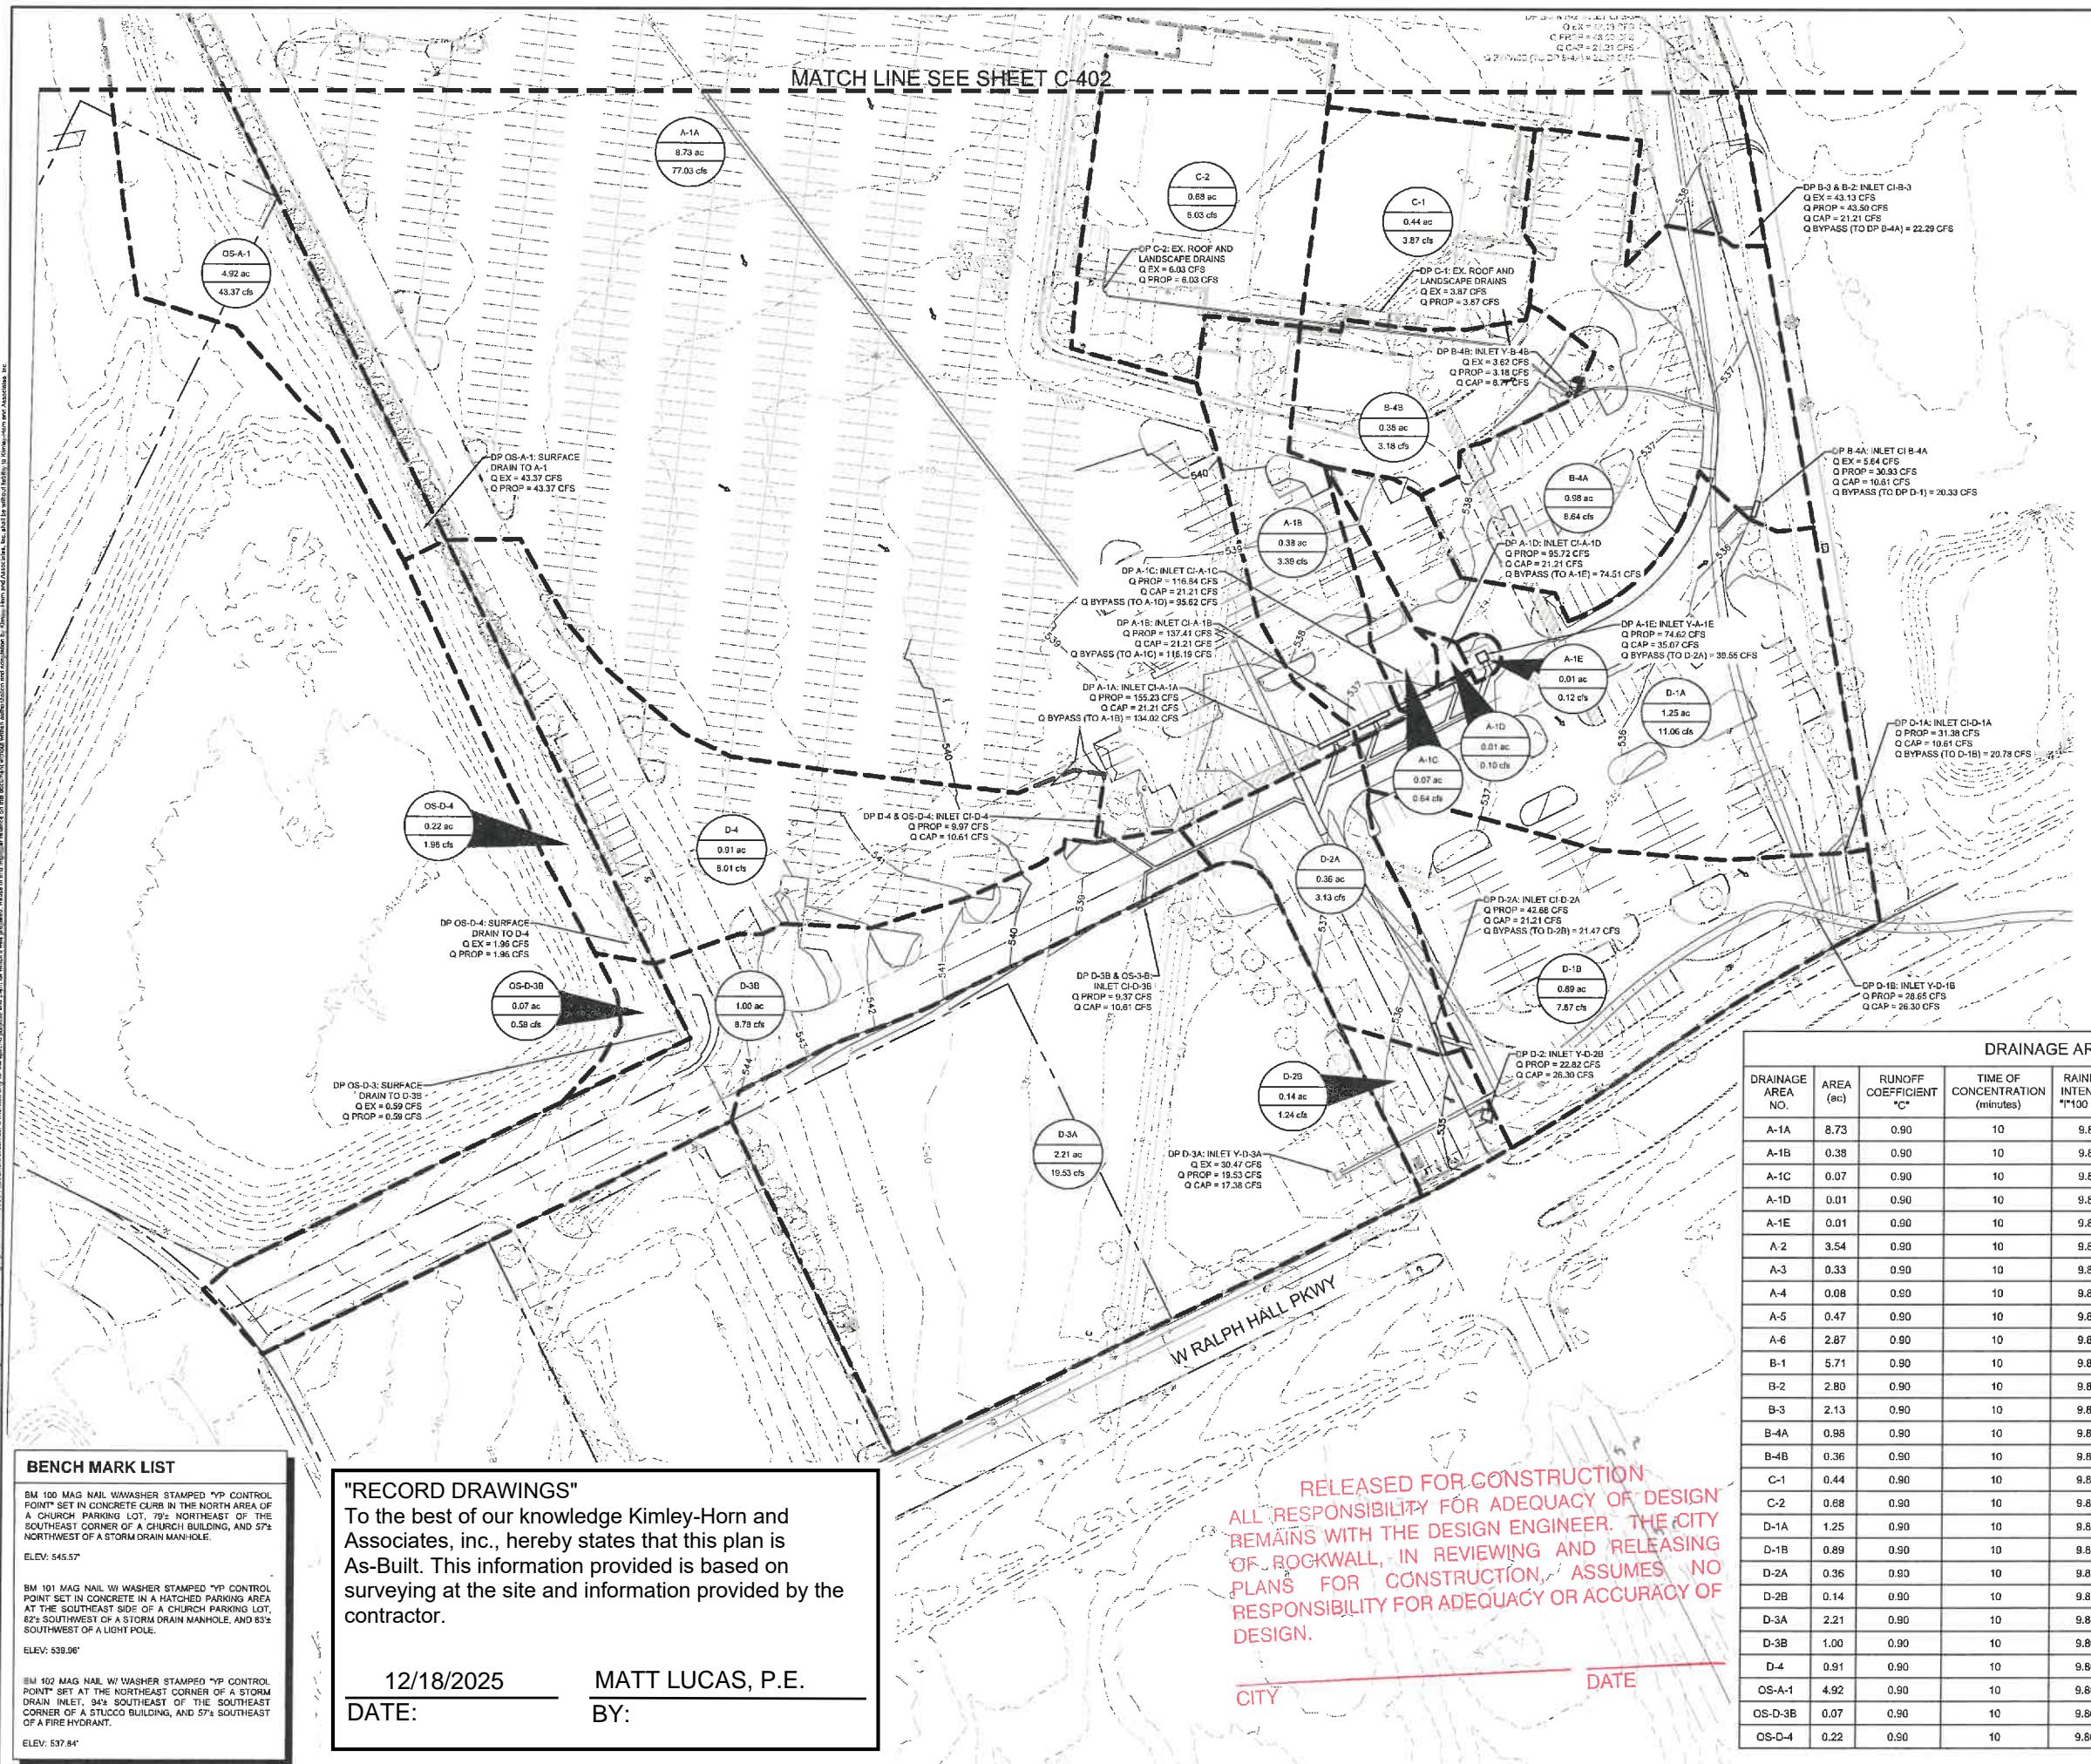

DRAINAGE GENERAL NOTES

1. CONTRACTOR TO FIELD VERIFY HORIZONTAL AND VERTICAL LOCATION OF EXISTING UTILITIES PRIOR TO CONSTRUCTION.
2. SEE STORM DRAIN PLAN & PROFILE SHEETS FOR DETAILED INFORMATION ON STORM DRAIN LINES.
3. ALL STORM DRAIN LINES SHALL BE RCP, CLASS III UNLESS OTHERWISE NOTED.
4. DRAINAGE AREAS SHOWN PER AS-BUILT DRAWINGS FOR THE EXISTING LAKEPOINTE ROCKWALL SUBJECT SITE. REFERENCE DRAWINGS FOR EACH DRAINAGE AREA IS OUTLINED BELOW:
 - 4.1. A-2 TO A-6 SHOWN PER "LAKEPOINTE CHURCH NEW CHAPEL/EDUCATION BUILDING" AS-BUILT DRAWINGS BY HALFF ASSOCIATES DATED 8/11/2018.
 - 4.2. OS-A-1 OFF SITE AREA IS OUTLINED SEPARATELY FROM DRAINAGE AREA A-1 IN AS-BUILT DRAWINGS BY HALFF ASSOCIATES DATED 8/11/2018. PROPOSED DISCHARGE RATE (Q PROP) FOR GS-A-1 CALCULATED USING CITY OF ROCKWALL DRAINAGE CRITERIA.
 - 4.3. B-1, B-2, B-3, B-589, B-589, B-590, B-591, B-592, B-593, B-594, B-595, B-596, B-597, B-598, B-599, B-599, B-600, B-601, B-602, B-603, B-604, B-605, B-606, B-607, B-608, B-609, B-609, B-610, B-611, B-612, B-613, B-614, B-615, B-616, B-617, B-618, B-619, B-619, B-620, B-621, B-622, B-623, B-624, B-625, B-626, B-627, B-628, B-629, B-629, B-630, B-631, B-632, B-633, B-634, B-635, B-636, B-637, B-638, B-639, B-639, B-640, B-641, B-642, B-643, B-644, B-645, B-646, B-647, B-648, B-649, B-649, B-650, B-651, B-652, B-653, B-654, B-655, B-656, B-657, B-658, B-659, B-659, B-660, B-661, B-662, B-663, B-664, B-665, B-666, B-667, B-668, B-669, B-669, B-670, B-671, B-672, B-673, B-674, B-675, B-676, B-677, B-678, B-679, B-679, B-680, B-681, B-682, B-683, B-684, B-685, B-686, B-687, B-688, B-689, B-689, B-690, B-691, B-692, B-693, B-694, B-695, B-696, B-697, B-698, B-699, B-699, B-700, B-701, B-702, B-703, B-704, B-705, B-706, B-707, B-708, B-709, B-709, B-710, B-711, B-712, B-713, B-714, B-715, B-716, B-717, B-718, B-719, B-719, B-720, B-721, B-722, B-723, B-724, B-725, B-726, B-727, B-728, B-729, B-729, B-730, B-731, B-732, B-733, B-734, B-735, B-736, B-737, B-738, B-739, B-739, B-740, B-741, B-742, B-743, B-744, B-745, B-746, B-747, B-748, B-749, B-749, B-750, B-751, B-752, B-753, B-754, B-755, B-756, B-757, B-758, B-759, B-759, B-760, B-761, B-762, B-763, B-764, B-765, B-766, B-767, B-768, B-769, B-769, B-770, B-771, B-772, B-773, B-774, B-775, B-776, B-777, B-778, B-778, B-779, B-779, B-780, B-781, B-782, B-783, B-784, B-785, B-786, B-787, B-788, B-789, B-789, B-790, B-791, B-792, B-793, B-794, B-795, B-796, B-797, B-798, B-799, B-799, B-800, B-801, B-802, B-803, B-804, B-805, B-806, B-807, B-808, B-809, B-809, B-810, B-811, B-812, B-813, B-814, B-815, B-816, B-817, B-818, B-819, B-819, B-820, B-821, B-822, B-823, B-824, B-825, B-826, B-827, B-828, B-829, B-829, B-830, B-831, B-832, B-833, B-834, B-835, B-836, B-837, B-838, B-839, B-839, B-840, B-841, B-842, B-843, B-844, B-845, B-846, B-847, B-848, B-849, B-849, B-850, B-851, B-852, B-853, B-854, B-855, B-856, B-857, B-858, B-859, B-859, B-860, B-861, B-862, B-863, B-864, B-865, B-866, B-867, B-868, B-869, B-869, B-870, B-871, B-872, B-873, B-874, B-875, B-876, B-877, B-878, B-878, B-879, B-879, B-880, B-881, B-882, B-883, B-884, B-885, B-886, B-887, B-888, B-889, B-889, B-890, B-891, B-892, B-893, B-894, B-895, B-896, B-897, B-898, B-898, B-899, B-899, B-900, B-901, B-902, B-903, B-904, B-905, B-906, B-907, B-908, B-909, B-909, B-910, B-911, B-912, B-913, B-914, B-915, B-916, B-917, B-918, B-919, B-919, B-920, B-921, B-922, B-923, B-924, B-925, B-926, B-927, B-928, B-929, B-929, B-930, B-931, B-932, B-933, B-934, B-935, B-936, B-937, B-938, B-939, B-939, B-940, B-941, B-942, B-943, B-944, B-945, B-946, B-947, B-948, B-949, B-949, B-950, B-951, B-952, B-953, B-954, B-955, B-956, B-957, B-958, B-959, B-959, B-960, B-961, B-962, B-963, B-964, B-965, B-966, B-967, B-968, B-969, B-969, B-970, B-971, B-972, B-973, B-974, B-975, B-976, B-977, B-978, B-978, B-979, B-979, B-980, B-981, B-982, B-983, B-984, B-985, B-986, B-987, B-988, B-988, B-989, B-989, B-990, B-991, B-992, B-993, B-994, B-995, B-996, B-997, B-997, B-998, B-998, B-999, B-999, B-1000, B-1001, B-1002, B-1003, B-1004, B-1005, B-1006, B-1007, B-1008, B-1009, B-1009, B-1010, B-1011, B-1012, B-1013, B-1014, B-1015, B-1016, B-1017, B-1018, B-1019, B-1019, B-1020, B-1021, B-1022, B-1023, B-1024, B-1025, B-1026, B-1027, B-1028, B-1029, B-1029, B-1030, B-1031, B-1032, B-1033, B-1034, B-1035, B-1036, B-1037, B-1038, B-1039, B-1039, B-1040, B-1041, B-1042, B-1043, B-1044, B-1045, B-1046, B-1047, B-1048, B-1048, B-1049, B-1049, B-1050, B-1051, B-1052, B-1053, B-1054, B-1055, B-1056, B-1057, B-1058, B-1059, B-1059, B-1060, B-1061, B-1062, B-1063, B-1064, B-1065, B-1066, B-1067, B-1068, B-1068, B-1069, B-1069, B-1070, B-1071, B-1072, B-1073, B-1074, B-1075, B-1076, B-1077, B-1077, B-1078, B-1078, B-1079, B-1079, B-1080, B-1081, B-1082, B-1083, B-1084, B-1085, B-1086, B-1087, B-1088, B-1089, B-1089, B-1090, B-1091, B-1092, B-1093, B-1094, B-1095, B-1096, B-1097, B-1097, B-1098, B-1098, B-1099, B-1099, B-1100, B-1101, B-1102, B-1103, B-1104, B-1105, B-1106, B-1107, B-1108, B-1109, B-1109, B-1110, B-1111, B-1112, B-1113, B-1114, B-1115, B-1116, B-1117, B-1118, B-11

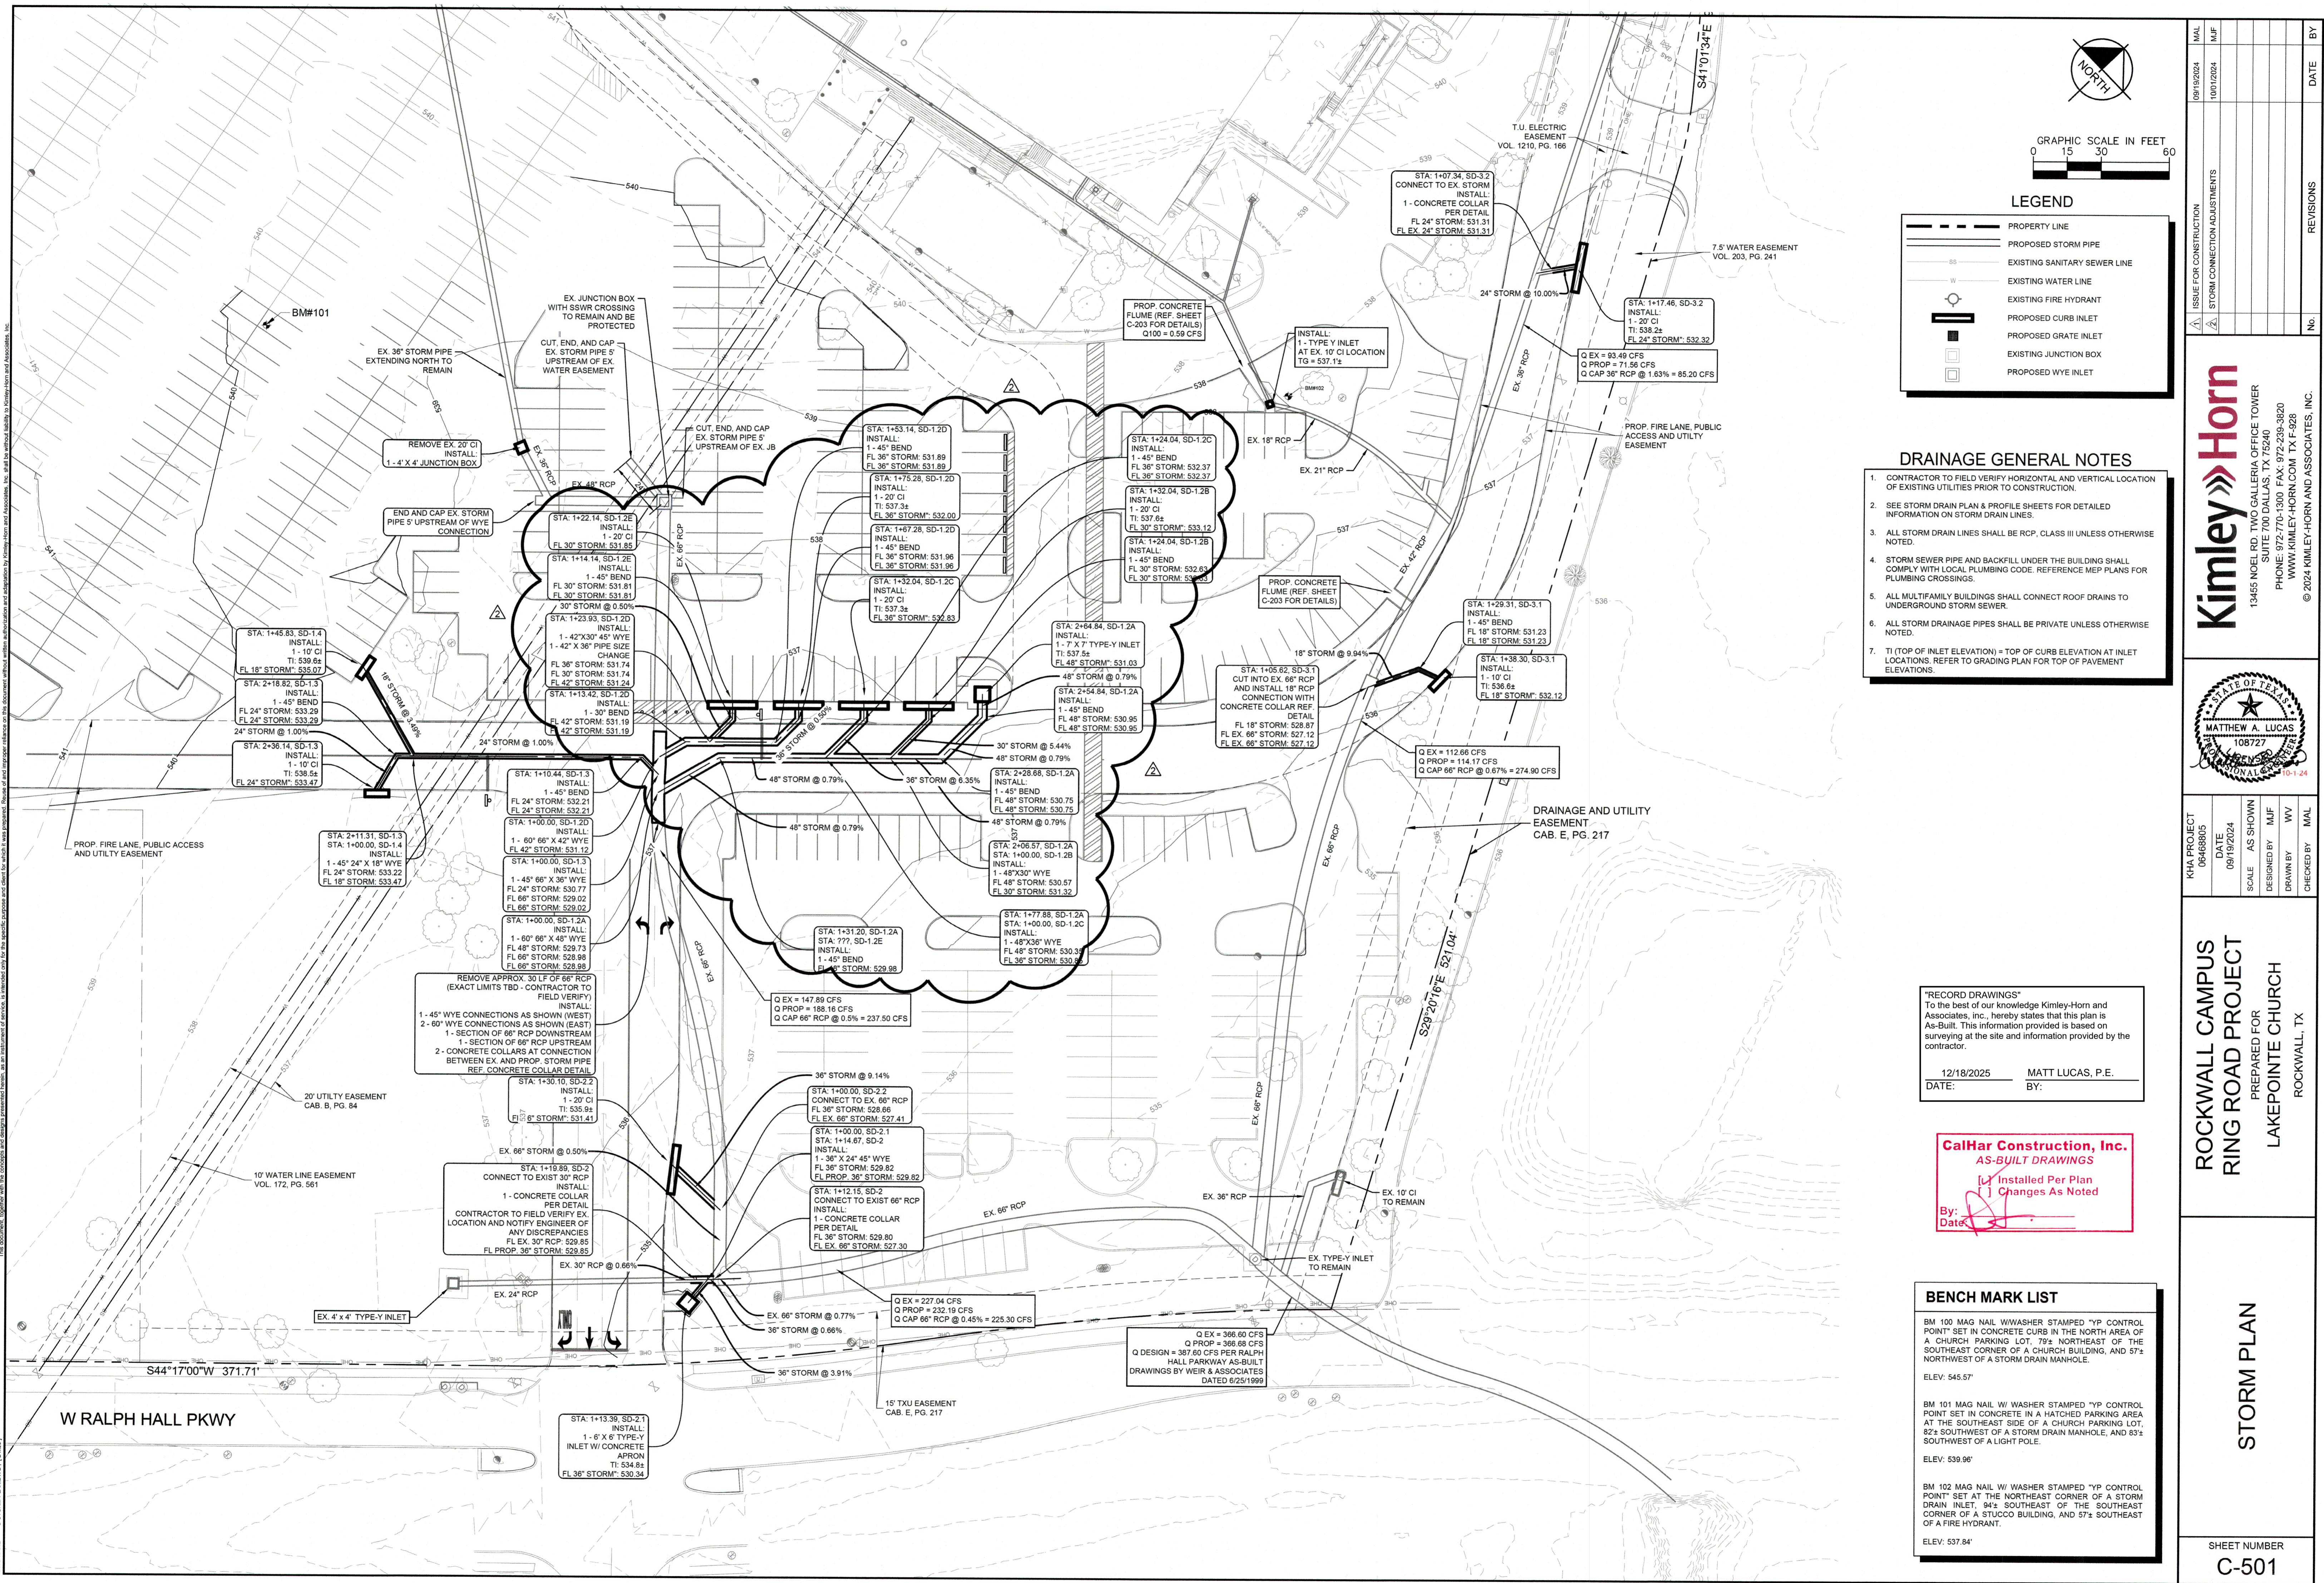

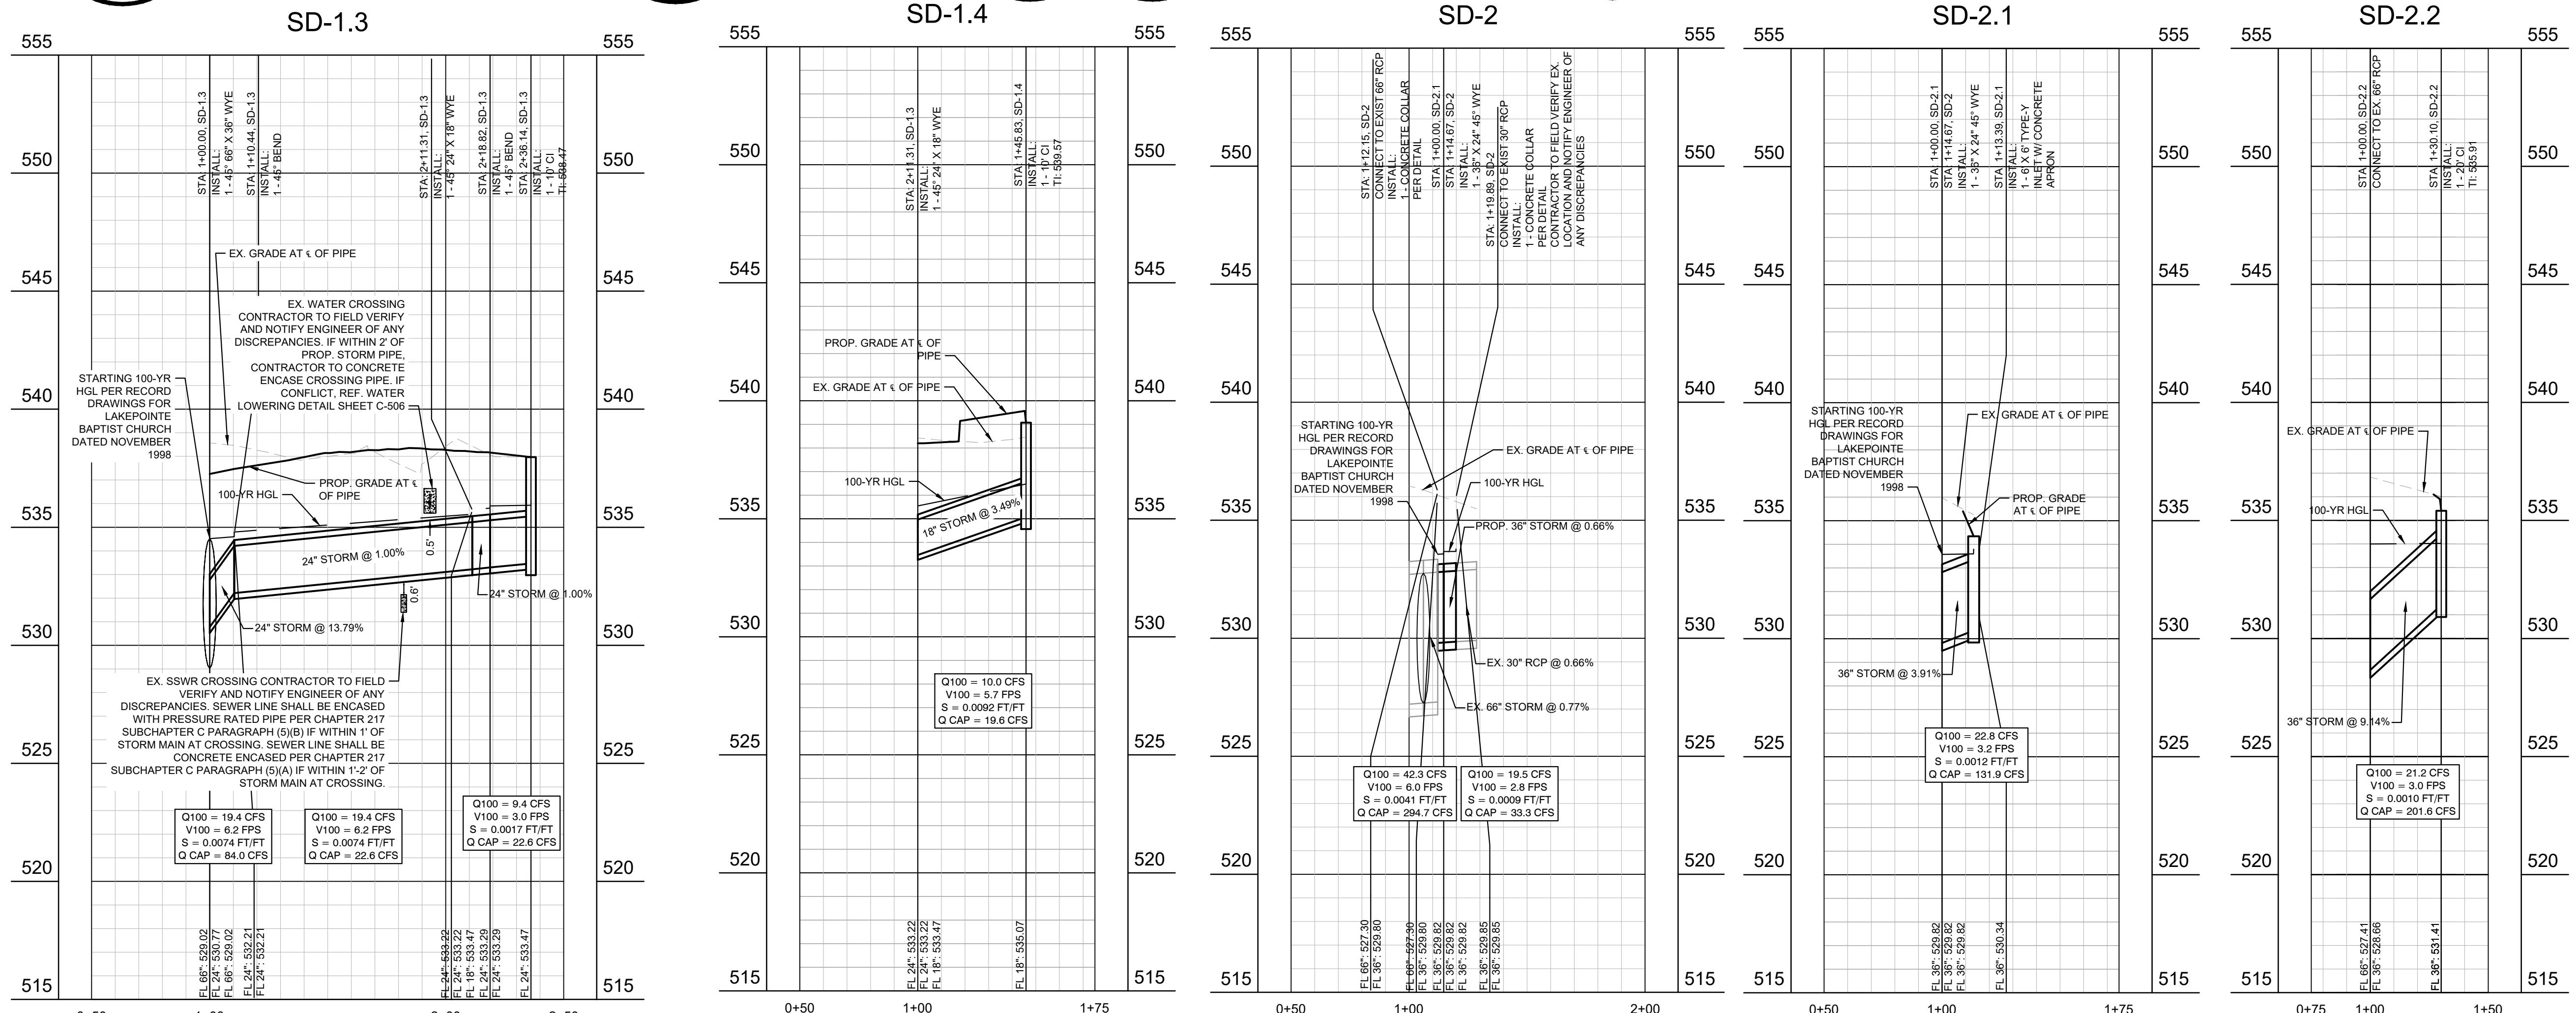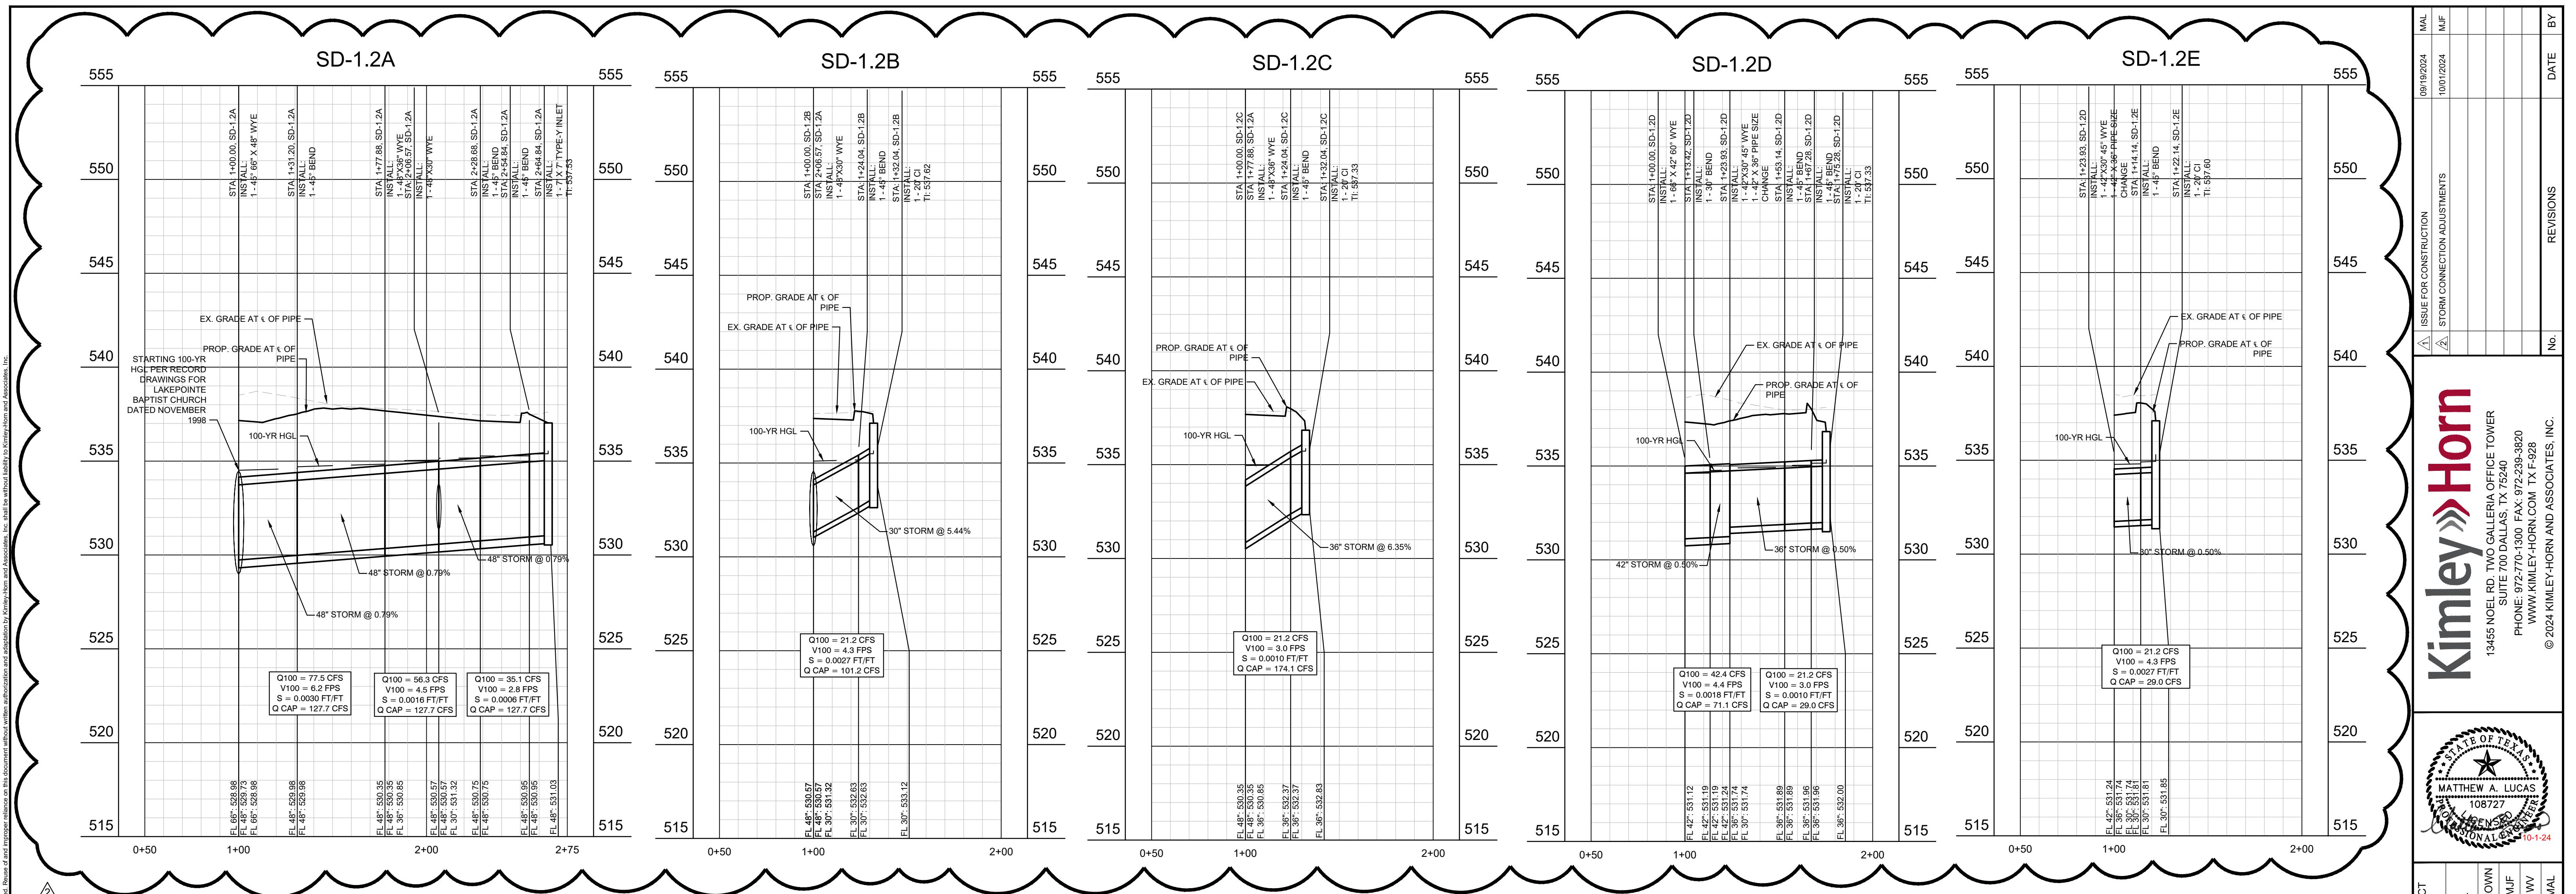

"RECORD DRAWINGS"
To the best of our knowledge Kimley-Horn and
Associates, inc., hereby states that this plan is
As-Built. This information provided is based on
surveying at the site and information provided by the
contractor.

2011


IMAGES XREFS x24X36 : oStorm
LAST SAVED 10/12/2024 10:56 AM
PLOTTED BY FEATHER, MIKE 10/12/2024 12:05 PM
DWG PATH K:\DAL_CIVIL\06460805-LAKEPOINTE RING ROAD\CAD\PHASE 1\PLANSHEETS
DWG NAME C-STORM-PROFILES.DWG , [STORM PROFILES (1 OF 2)]

Kimley-Horn	
13455 NOEL RD. TWO GALLERIA OFFICE TOWER SUITE 700 DALLAS, TX 75240 PHONE: 972-770-1300 FAX: 972-239-3820 WWW.KIMLEY-HORN.COM TX F-928	
© 2024 KIMLEY-HORN AND ASSOCIATES, INC.	
 <p>MATTHEW A. LUCAS 108727 PENNSA LICENSING PROFESSIONAL ENGINEER 10-1-24</p>	
KHA PROJECT 06468805	AS SHOWN
DATE 09/19/2024	
SCALE	
DESIGNED BY MJF	
DRAWN BY WV	
CHECKED BY MAL	
ISSUE FOR CONSTRUCTION 0	REVISIONS
STORM CONNECTION ADJUSTMENTS 1	
1	
2	

STORM PROFILES
(1 OF 2)

ROCKWALL CAMPUS
RING ROAD PROJECT
PREPARED FOR
LAKEPOINTE CHURCH
ROCKWALL, TX

THE DOCUMENTS OF THE CHURCH OF CHRIST IN THE STATE OF MICHIGAN 11

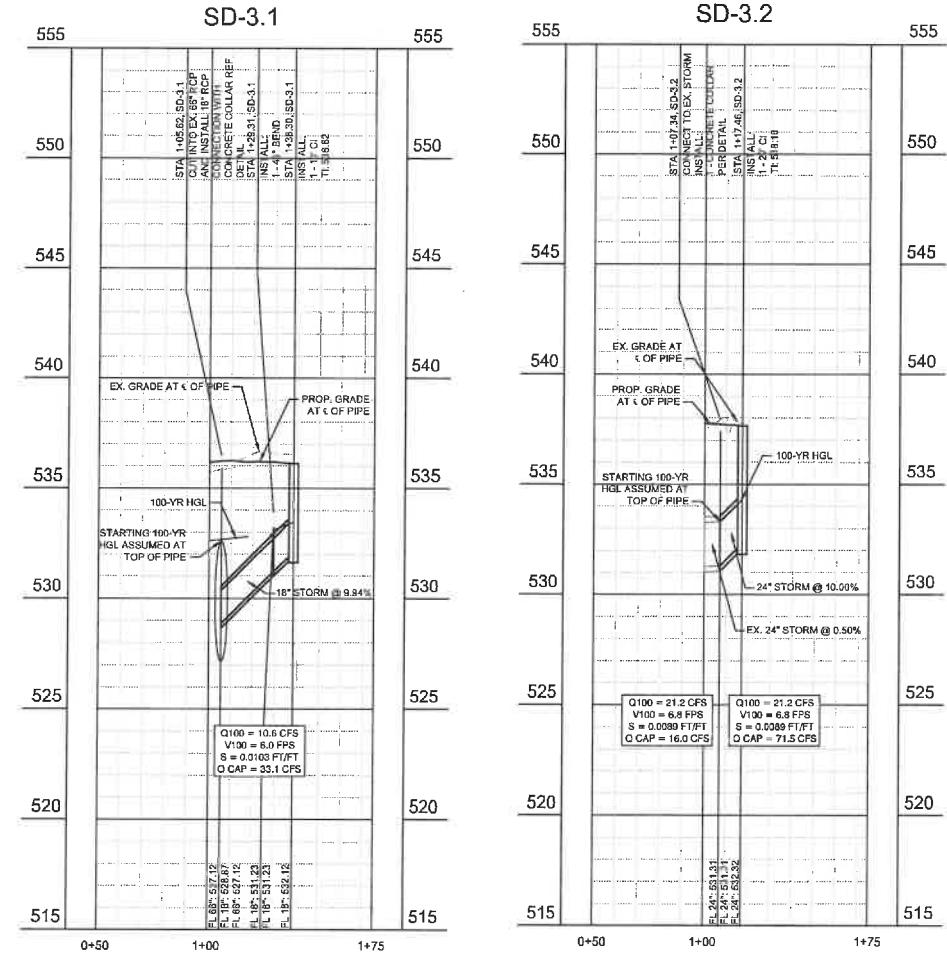

"RECORD DRAWINGS"

RECORD DRAWINGS
To the best of our knowledge Kimley-Horn and
Associates, inc., hereby states that this plan is
As-Built. This information provided is based on
surveying at the site and information provided by the
contractor.

12/18/2025
DATE: _____

RELEASED FOR CONSTRUCTION
RESPONSIBILITY FOR ADEQUACY OF DESIGN
AINS WITH THE DESIGN ENGINEER. THE CITY
ROCKWALL, IN REVIEWING AND RELEASING
ANS FOR CONSTRUCTION, ASSUMES NO
SPONSIBILITY FOR ADEQUACY OR ACCURACY OF
IGN.




STORM PROFILES (2 QF 3)

ROCKWALL CAMPUS RING ROAD PROJECT

PREPARED FOR

Kimley-Horn
13455 NOEL RD., TWO GALLERIA OFFICE TOWER
HOUSTON, TX 77077-3111

Kimley»Horn	
 MATTHEW A. LUCAS 108727 19-24	
13455 NELG RD, TWO GALLERIA OFFICE TOWER SUITE 700 DALLAS, TX 75240 PHONE: 972-770-1300 FAX: 972-339-3228 WWW.KIMLEY-HORN.COM TX-F-328	
© 2024 KIMLEY-HORN AND ASSOCIATES, INC.	
DATE	09/18/2024
DESIGNED BY	M.A.F.
DRAWN BY	W.W.
CHECKED BY	N.A.L.
AS SHOWN	
ISSUE FOR CONSTRUCTION	09/19/2024
REVISIONS	DATE
△	B

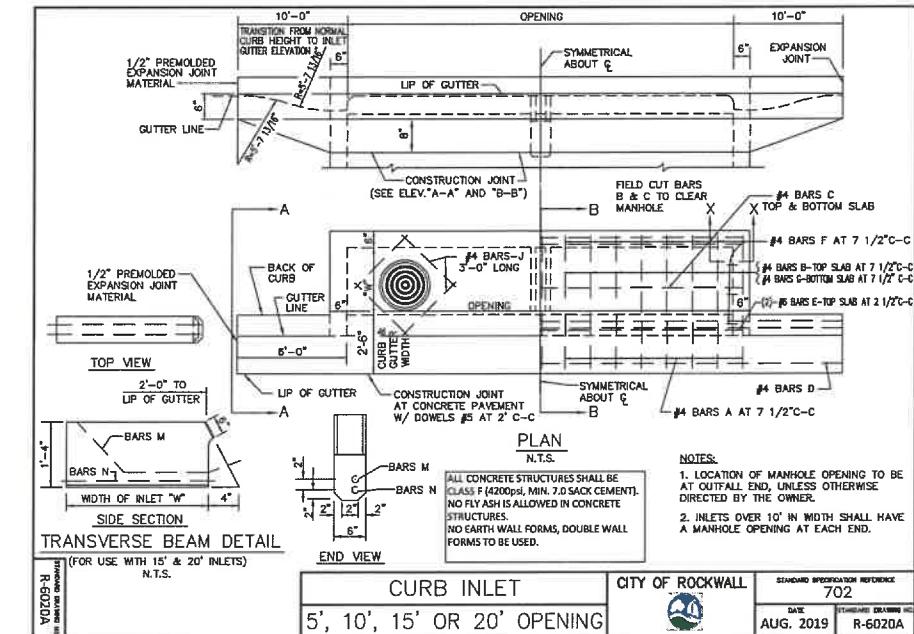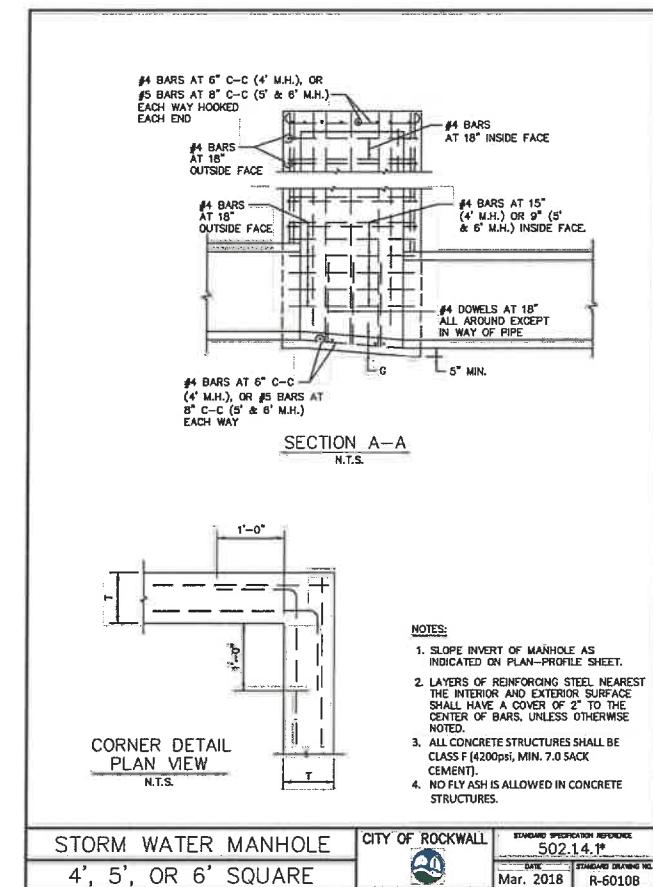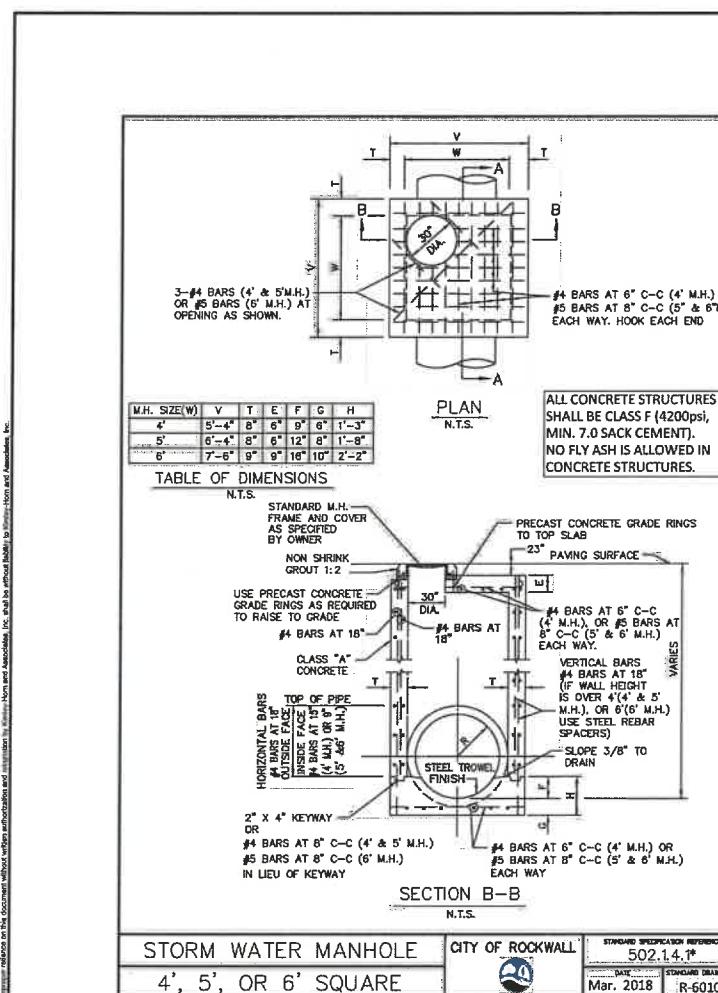



Kimley-Horn

13455 NOEL RD. SUITE 700 DALLAS, TX 75240
PHONE: 972-770-300 FAX: 972-238-3820
WWW.KIMLEY-HORN.COM TX F-228
© 2024 KIMLEY-HORN AND ASSOCIATES, INC.



"RECORD DRAWINGS"
To the best of our knowledge Kimley-Horn and Associates, inc., hereby states that this plan is As-Built. This information provided is based on surveying at the site and information provided by the contractor.

12/18/2025 MATT LUCAS, P.E.
DATE: BY:

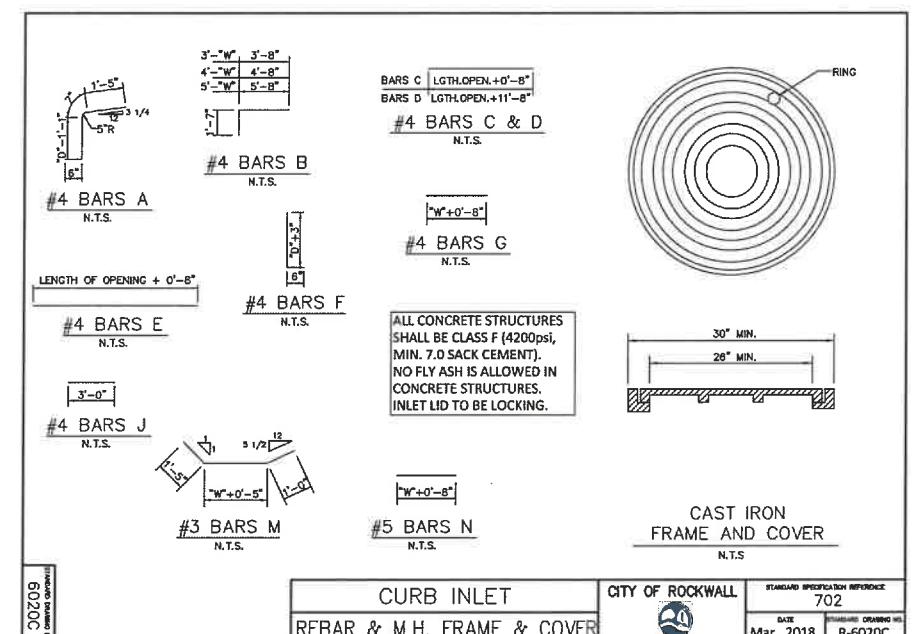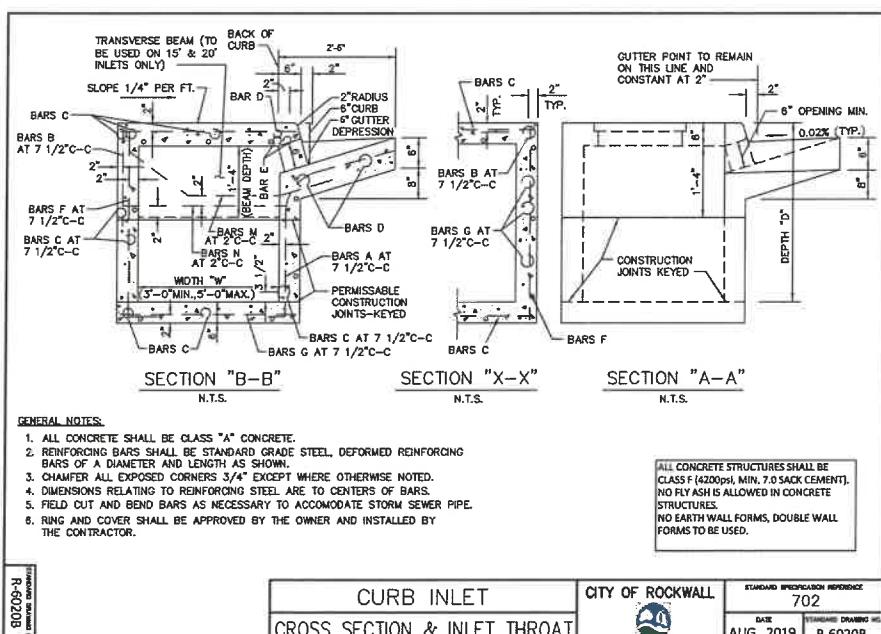

RELEASED FOR CONSTRUCTION
ALL RESPONSIBILITY FOR ADEQUACY OF DESIGN REMAINS WITH THE DESIGN ENGINEER. THE CITY OF ROCKWALL, IN REVIEWING AND RELEASING PLANS FOR CONSTRUCTION, ASSUMES NO RESPONSIBILITY FOR ADEQUACY OR ACCURACY OF DESIGN.

CITY DATE

ISSUE FOR CONSTRUCTION	08/19/2024	MAIL
REVISIONS		DATE
C-505		
KHA PROJECT 06468865	DATE 08/18/2024	AS SHOWN
DESIGNED BY M.J.F.	DRAWN BY W.V.	CHECKED BY M.A.L.
PREPARED FOR LAKEPOINTE CHURCH		
ROCKWALL CAMPUS RING ROAD PROJECT		
STORM DETAILS (1 OF 2)		

EROSION CONTROL SCHEDULE AND PHASING

THE PROJECT SHALL GENERALLY CONFORM TO THE FOLLOWING:

PHASE A - GRADING
1. CONSTRUCT TEMPORARY CONSTRUCTION ENTRANCE, SILT FENCE, DIKE, AND TREE PROTECTION FENCE ACCORDING TO THE APPROXIMATE LOCATION AND SHOWN ON GRADING AND EROSION CONTROL PLAN. NOTES AND ATTACH SHEET.
2. BEGIN CLEARING AND GRADING OF SITE.
3. SEED AND REVEGETATE SLOPES WHERE SHOWN.

PHASE B - UTILITIES
1. KEEP ALL STORM WATER POLLUTION PREVENTION MEASURES IN PLACE.
2. INSTALL STORM DRAINS, SANITARY SEWER, AND WATER AS SPECIFIED ON PLAN SHEETS.

PHASE C - PAVING
1. KEEP ALL STORM WATER POLLUTION PREVENTION MEASURES IN PLACE. REMOVE AS NEEDED TO PAVE.
2. PAVE STREETS AND SIDEWALKS AS SPECIFIED ON PLAN SHEETS.
3. RE-INSTALL ANY STORM WATER POLLUTION PREVENTION MEASURES REMOVED FOR PAVING OPERATIONS.

PHASE D - LANDSCAPING AND SOIL STABILIZATION.
1. REMOVE SITE LOT AND PARKWAYS.
2. LANDSCAPE CONTRACTOR SHALL REVEGETATE ALL AREAS RESERVED FOR LANDSCAPE VEGETATIVE COVERS.
3. REMOVE EROSION CONTROL DEVICES WHEN MINIMUM 70% GROUND COVER IS ESTABLISHED. VEGETATION MUST BE ESTABLISHED BEFORE STRUCTURAL CONTROLS REMOVED.

NOTE: THE SEQUENCE OF CONSTRUCTION SHOWN ABOVE IS A GENERAL OVERVIEW AND IS INTENDED TO CONVEY THE GENERAL CONCEPTS OF THE EROSION CONTROL DESIGN AND SHOULD NOT BE RELIED UPON FOR CONSTRUCTION PURPOSES. THE CONTRACTOR IS SOLELY RESPONSIBLE FOR DETAILED PHASING AND CONSTRUCTION SEQUENCING NECESSARY TO CONSTRUCT THE PROPOSED IMPROVEMENTS INCLUDED IN THESE PLANS. THE CONTRACTOR SHALL NOTIFY ENGINEER IN WRITING IMMEDIATELY, PRIOR TO AND/OR DURING CONSTRUCTION IF ANY ADDITIONAL INFORMATION ON THE CONSTRUCTION SEQUENCE IS NECESSARY. CONTRACTOR IS SOLELY RESPONSIBLE FOR COMPLYING WITH THE REQUIREMENTS OF THE AUTHORITY HAVING JURISDICTION AND ALL OTHER APPLICABLE LAWS.

SITE DATA SUMMARY

TOTAL LOT AREA: 34.49 AC
TOTAL DISTURBED AREA: 4.69 AC

"RECORD DRAWINGS"

To the best of our knowledge Kimley-Horn and Associates, inc., hereby states that this plan is As-Built. This information provided is based on surveying at the site and information provided by the contractor.

12/18/2025

MATT LUCAS, P.E.
DATE: BY:

0 20 40 80
GRAPHIC SCALE IN FEET

LEGEND

632	PROPOSED CONTOUR
632	EXISTING CONTOUR
SF	SILT FENCE
LD	LIMITS OF DISTURBANCE
IP	INLET PROTECTION
TP	TREE PROTECTION

ISSUE FOR CONSTRUCTION

REVISIONS

No.

Kimley Horn

13465 NOLI RD, TWO GALLERIA OFFICE TOWER
SUITE 700 DALLAS, TX 75240
PHONE: 972-270-1300 FAX: 972-239-0820
WWW.KIMLEY-HORN.COM TX F-08
© 2024 KIMLEY-HORN AND ASSOCIATES, INC.



MATTHEW A. LUCAS
10827
WAL

19-24

EROSION CONTROL GENERAL NOTES

1. EROSION CONTROL DEVICES SHOWN ON THIS PLAN SHALL BE INSTALLED PRIOR TO THE START OF LAND DISTURBING ACTIVITIES ON THE PROJECT.
2. ALL EROSION CONTROL DEVICES ARE TO BE INSTALLED IN ACCORDANCE WITH THE APPROVED PLANS AND SPECIFICATIONS FOR THIS PROJECT. CHANGES ARE TO BE APPROVED BEFORE CONSTRUCTION BY THE DESIGN ENGINEER AND THE CITY ENGINEERING DIVISION.
3. IF THE EROSION CONTROL PLAN AS APPROVED CANNOT CONTROL EROSION AND OFF-SITE SEDIMENTATION FROM THE PROJECT, THE EROSION CONTROL PLAN WILL BE REQUIRED TO BE REVISED AND/OR ADDITIONAL EROSION CONTROL DEVICES WILL BE REQUIRED ON SITE.
4. INSPECTIONS SHALL BE MADE WEEKLY AND AFTER RAIN STORM EVENTS TO INSURE THAT THE EROSION CONTROL DEVICES ARE FUNCTIONING PROPERLY. AGGREGATE PAD SHALL BE WASHED DOWN OR REPLACED IF SEDIMENT OR MUD IS CLOGGED IN THE VOID SPACES. IF THE STONE OR MUD IS CLOGGED IN THE VOID SPACES BETWEEN THE STONES OR MUD IS TO BE TRACED ONTO THE PUBLIC ROADWAY. RUNOFF FROM THE WASHDOWN OPERATION HALL NOT BE ALLOWED TO DRAIN DIRECTLY OFF SITE WITHOUT FIRST FLOWING THROUGH ANOTHER BMP TO CONTROL OFF SITE SEDIMENTATION. PERIODIC RE-GRADING OR THE ADDITION OF NEW STONE MAY BE REQUIRED TO MAINTAIN THE EFFICIENCY OF THE INSTALLATION.
5. CONTRACTOR SHALL BE RESPONSIBLE FOR SUBMITTAL OF N.O.I., N.O.T. AND ANY ADDITIONAL INFORMATION REQUIRED BY THE TCEQ CONTRACTOR SHALL COMPLY WITH ALL TCEQ STORMWATER POLLUTION PREVENTION REQUIREMENTS.

BMP MAINTENANCE SCHEDULE

TEMPORARY STONE CONSTRUCTION ENTRANCE/EXIT:
INSPECTIONS SHALL BE MADE WEEKLY AND AFTER RAIN STORM EVENTS TO ENSURE THAT THE FACILITY IS FUNCTIONING PROPERLY. AGGREGATE PAD SHALL BE WASHED DOWN OR REPLACED IF SEDIMENT OR MUD IS CLOGGED IN THE VOID SPACES BETWEEN THE STONES OR MUD IS TO BE TRACED ONTO THE PUBLIC ROADWAY. RUNOFF FROM WASHDOWN OPERATION SHALL BE FILTERED THROUGH ANOTHER BMP.

SILT FENCE:
INSPECTIONS SHALL BE MADE WEEKLY AND AFTER RAIN STORM EVENTS. SEDIMENT SHALL BE REMOVED FROM THE FENCE WHEN THE DEPTH OF SEDIMENT HAS BUILT UP TO ONE-HALF THE HEIGHT OF THE FENCE ABOVE GRADE. FENCE SHALL BE INSPECTED FOR GAPS AT BASE. INSPECT SUPPORTING POSTS AND FILTER FABRIC. REPLACE IF REQUIRED.

CURB INLET/GRATE INLET/WEVE INLET:
INSPECTIONS SHALL BE MADE WEEKLY AND AFTER ALL RAIN EVENTS TO ENSURE THAT THE DEVICE IS FUNCTIONING PROPERLY. REMOVE SEDIMENT FROM THE STORAGE AREA SURROUNDING THE INLET/GRATE WHEN THE DEPTH OF SEDIMENT HAS BUILT UP TO ONE-HALF OF THE PROTECTION HEIGHT. DEVICE SHALL BE INSPECTED FOR GAPS AT BASE, AND SHALL BE REPLACED AS NEEDED.

RELEASED FOR CONSTRUCTION
ALL RESPONSIBILITY FOR ADEQUACY OF DESIGN
REMAINS WITH THE DESIGN ENGINEER. THE CITY
OF ROCKWALL, IN REVIEWING AND RELEASING
PLANS FOR CONSTRUCTION, ASSUMES NO
RESPONSIBILITY FOR ADEQUACY OR ACCURACY
OF DESIGN.

VEGETATIVE STABILIZATION REQUIREMENTS

TEMPORARY SEEDING

ALL DISTURBED AREAS WHICH WILL BE LEFT DORMANT FOR GREATER THAN 14 DAYS SHALL BE SEEDED WITH FAST-GERMINATING TEMPORARY VEGETATION. THE SEEDING RATE AND PLANTING DATES WILL DEPEND ON THE TIME OF YEAR IT IS APPLIED (SEE DESCRIPTIONS IN TABLE 2). REFER TO LANDSCAPE PLAN FOR PERMANENT STABILIZATION REQUIREMENTS. ALL TEMPORARY SEEDING MATERIALS SHALL BE APPROVED BY THE OWNER'S REPRESENTATIVE PRIOR TO APPLICATION.

VEGETATION TABLE

TEMPORARY SEEDING SPECIES	PLANTING RATE	PLANTING DATES
CRIMSON CLOVER	1/2ACRE	8/15-10/30
MILLET, FOXTAIL	30ACRE	5/1-8/30
RYEGRASS, RYEGRASS	8/10-10/30	
SPRANGLETOP, GREEN	2.5ACRE	2/1-5/1
TALL FESCUE	70-109/1000 SF	9/1-10/1

*USE ONLY USDA CERTIFIED SEED.

TEMPORARY EROSION CONTROL

1. INSTALL EROSION STRUCTURES SUCH AS Dikes, Diversion, ETC. PRIOR TO SEEDING.
2. FURROW SLOPES STEEPER THAN 3:1 ON THE CONTOUR LINE BEFORE SEEDING.
3. ENSURE SEED BED IS PULVERIZED, LOOSE, AND UNIFORM.

APPLICATION

1. WHEN EROSION CONTROL IS USED, DO NOT MIX SEED AND FERTILIZER MORE THAN 30 MINUTES PRIOR TO APPLICATION.
2. APPLY SEED EVENLY USING PROPER EQUIPMENT AND WATER TO AID VEGETATION GROWTH.
3. EROSION CONTROL NETTING SHALL BE INSTALLED OVER FULL SLOPES WHICH HAVE BEEN BROUGHT TO FINAL GRADE AND HAVE BEEN SEED TO PROTECT AGAINST EROSION. MULCH (STRAW OR FIBER) SHALL BE USED ON RELATIVELY FLAT SLOPES.

OWNER/DEVELOPER

LAKEPOINTE BAPTIST CHURCH
CONTACT: JOHN WARDELL
PHONE: 214-707-2732
EMAIL: JOHN.WARDELL@LAKEPOINTE.CHURCH


ENGINEER

CONTACT: MATTHEW A. LUCAS, P.E.
PHONE: 972-770-1300
EMAIL: MATT.LUCAS@KIMLEY-HORN.COM


EROSION CONTROL PLAN

ROCKWALL CAMPUS
RING ROAD PROJECT
PREPARED FOR
LAKEPOINTE CHURCH
ROCKWALL, TX

SHEET NUMBER
C-601

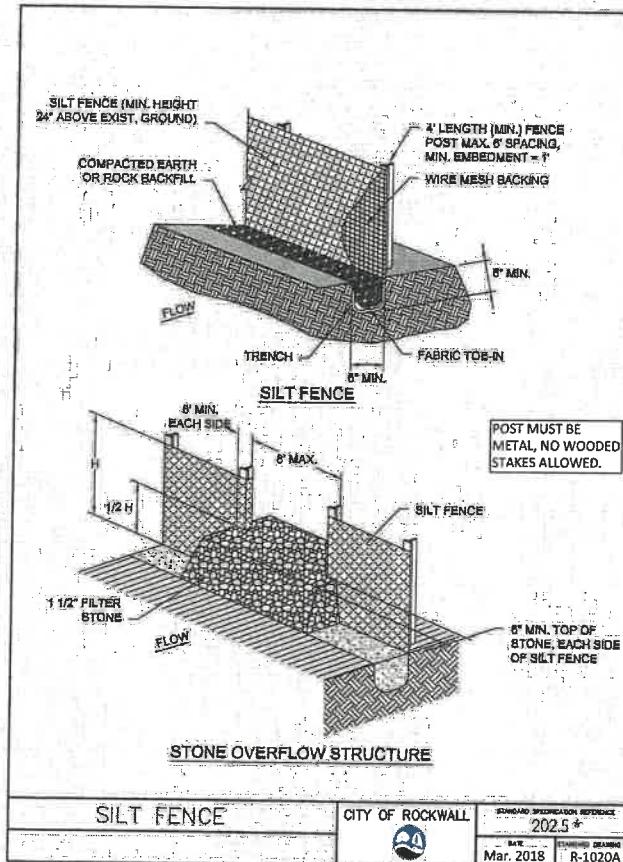

*Section II Standard Drawings as of October 2004. Reference number only has been updated for Edition Specifications. *Public Works Construction Standards North Central Texas, Fifth Edition*.

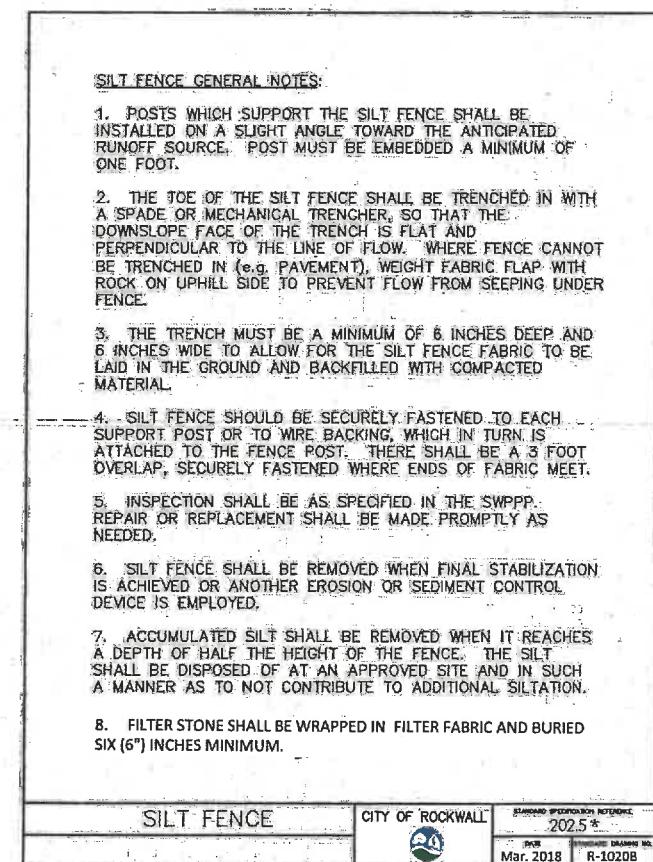

*Section II Standard Drawings as of October 2004. Reference number only has been updated for Fifth Edition Specifications. *Public Works Construction Standards North Central Texas, Fifth Edition.*

		ISSUE FOR CONSTRUCTION		MAIL	09/19/2024	DATE	BY
		△					
13455 NOEL RD. TWO GALLERIA OFFICE TOWER SUITE 700 DALLAS, TX 75240 PHONE: 972-270-1300 FAX: 972-238-3820 WWW.KIMLEY-HORN.COM TX F-828				No.	REVISIONS		
© 2024 KIMLEY-HORN AND ASSOCIATES, INC.							
							
MATTHEW A. LUCAS 108727							
NAME KIMLEY-HORN 06468806	DATE 09/19/2024	AS SHOWN	MAJ	W/W	MAL		
SCALE	DESIGNED BY						
DRAWN BY	CHECKED BY						



PRINTED NAME	KIRKMAN, JEFFREY		
PHONE NUMBER	06468806		
DATE	09/19/2024		
SCALE	AS SHOWN		
DESIGNED BY	MF		
DRAWN BY	WV		
CHECKED BY	MAL		

ROCKWALL CAMPUS RING ROAD PROJECT

PREPARED FOR
LAKEPOINTE CHURCH
ROCKWALL, TX

"RECORD DRAWINGS"
To the best of our knowledge Kimley-Horn and
Associates, inc., hereby states that this plan is
As-Built. This information provided is based on
surveying at the site and information provided by the
contractor.

12/18/2025
DATE: _____

RELEASED FOR CONSTRUCTION
RESPONSIBILITY FOR ADEQUACY OF DESIGN
AINS WITH THE DESIGN ENGINEER. THE CITY
ROCKWALL, IN REVIEWING AND RELEASING
S FOR CONSTRUCTION, ASSUMES NO
NSIBILITY FOR ADEQUACY OR ACCURACY OF
GN.

ITY _____ DATE _____