- Contractor is responsible for, and must obtain prior to construction, all necessary construction permits required by
- 3. The Contractor shall abide by all applicable federal, state, and local laws governing excavation. The Contractor shall provide detailed plans and specifications for trench safety systems that comply with applicable laws governing excavation. These plans shall be sealed by an Engineer experienced in the design of trench safety systems and licensed by the State of Texas. Submit plan to the Owner prior to commencing work. The Contractor shall be solely responsible for all aspects of work related to excavation.
- 4. Existing utility locations shown are taken from available records provided by the utility Owner and field locations of surface appurtenances. Locations shown are generally schematic in nature and may not accurately reflect the size and location of each particular utility. Some utility lines may not be shown. Contractor shall assume responsibility for actual field location and protection of existing facilities whether shown or not. Contractor shall also assume responsibility for repairs to existing facilities, whether shown or not, damaged by contractor's activities. Differences in horizontal or vertical location of existing utilities shall not be a basis for additional expense.
- 5. Contractor shall locate and adjust existing utility manhole lids, cleanouts, water valves and other surface appurtenances as required for new construction. Contractor shall coordinate utility adjustments with other disciplines and the appropriate utility agencies and provide for all fees for permits, connections, inspections, etc.
- 6. The Contractor shall protect existing property monumentation and primary control. Any such points which the Contractor believes will be destroyed shall have offset points established by the Contractor prior to construction. Any monumentation destroyed by the Contractor shall be reestablished at his expense.
- 7. Any damages that may occur to real property or existing improvements shall be restored by the Contractor to at lease the same condition that the real property or existing improvements were in prior to the damages. This restoration shall be subject to the Owner's approval; moreover, this restoration shall not be a basis for additional compensation to the Contractor. Restoration shall include, but not be limited to, regrassing, revegetation, replacing fences, replacing trees, etc.
- 8. It shall be the responsibility of the Contractor to:
 - A. Prevent any damage to private property and property owner's poles, fences, shrubs, etc.
 - B. Provide access to all drives during construction.C. Protect all underground utilities to remain in service.
 - D. Notify all utility companies and verify location of all utilities prior to start of construction.
- 9. Contractor shall maintain positive drainage at all time during construction. Ponding of water in streets, drives, truck courts, trenches, etc. will not be allowed.
- 10. Contractor shall maintain existing sanitary sewer and water service at all times during construction.
- 11. Contractor is responsible for coordination with utility companies and adjustment of existing sanitary sewer cleanouts, water meters and any other appurtenances to new grade as required.
- 12. Pavement removal and repair shall conform to the City of Rockwall requirements. All sawcuts shall be full depth cuts. Contractor shall make efforts to protect concrete and/or asphalt edges. Any large spalled or broken edges shall be removed by sawcutting pavement prior to replacement.
- 13. Fire service shall be sized and designed by a State of Texas licensed fire protection engineer/contractor registered in the State of Texas
- 14. All underground fire lines shall be installed by a state licensed fire protection contractor.
- 15. All utility crossings shall comply with TCEQ Chapter 217 and 290 regulations and city requirements.

EROSION CONTROL NOTES

1. Refer to the Erosion Control Sheets, sheets C3.01 and C3.02, for Erosion Control notes.

DEMOLITION NOTES:

- 1. For additional extents for demolition, refer to grading, storm drainage, paving, and dimension control, water and
- Information provided on this plan does not delineate any underground foundation or objects that currently may be covered
- 3. The contract shall be responsible for proper removal and disposal of materials as required by the Owner or Owner's representative.

GRADING NOTES:


- 1. No grading or earthwork shall commence until filing of a Notice of Intent to the Texas Commission of Environmental Quality (TCEQ) if applicable and Implementation of the Storm water Pollution Prevention Plan by the Contractor. A site erosion control plan and stormwater pollution prevention plan shall be prepared and provided to the City of Rockwallby others prior to start of construction.
- 2. The existing ground surface shall be stripped of vegetation, roots, old construction debris, and other organic materials. Material unsuitable for fill shall be removed from the site and properly disposed of.
- 3. The subgrade should be firm and able to support the construction equipment without displacement. Soft or yielding subgrade should be corrected and made stable before construction proceeds. The subgrade shall be proof rolled using a heavy pneumatic tire roller, loaded dump truck or similar piece of heavy equipment.
- 4. All areas to receive fill shall be stripped of vegetation and the top six (6) inches scarified prior to receiving any fill. Fill material shall be placed in loose lifts not exceeding 8-inches in uncompacted thickness. The fill material shall be uniform with respect to material type and moisture content. Clods and chunks of material shall be broken down and the fill material mixed by disking, blading, or plowing, as necessary, so that a material of uniform moisture and density is obtained for each lift. Water required to bring the fill material to the proper moisture content should be sprinkled evenly through each layer.
- 5. The on-site soils are suitable for use in site grading. Imported fill material shall be clean soil with a Liquid Limit less than 40 and no rock greater than 4 inches in maximum dimension. The fill material shall be free of vegetation and debris
- 6. The fill material shall be compacted between 95 and 98 percent of the maximum dry density as determined by the Standard Proctor test, ASTM D 698. In conjunction with the compacting operation, the fill material shall be brought to the proper moisture content. The moisture content of the compacted soils should be maintained between -2 and +2 percent of the optimum value (determined from ASTM D 698). All fill to be compacted using a sheep's foot roller.
- The Contractor shall administer sprinklers for dust control, earthwork or base construction as required or as directed by the Engineer in accordance with the TXDOT Standard Specification for Construction, Item 204-Sprinklering.
- 8. Contractor's work shall include pavement removal and disposal required for new walk, drive, curb, gutter and other grading features. Contractor shall be responsible for all coordination, inspection and testing required by the Owner and/or the City of Rockwall.
- 9. All sidewalks shall maintain 2% cross slope maximum. Longitudinal slopes along sidewalks and accessible routes shall not exceed 5% in the direction of travel. Slopes within designated handicap parking or loading areas shall not exceed 2% in any direction.
- 10. 4:1 Horizontal: Vertical is the maximum allowable slope within the earthen areas.
- 11. Site grading and pavement subgrade shall be prepared in accordance with the Geotechnical Report No. G161157 prepared by ALPHA TESTING dated 06/10/2016.
- Proposed spot elevations represent gutter elevation unless noted otherwise.

PAVING NOTES:

- Pavement removal and repair shall conform to City of Rockwall requirements. All sawcuts shall be full depth cuts.
 Contractor shall make efforts to protect concrete. Any large spalled or broken edges shall
 be removed by sawcutting pavement prior to replacement.
- Contractor's work shall include pavement removal and disposal required for new walk, drive, curb, gutter and
 other paving features. Contractor shall be responsible for all coordination, inspection and testing required by the
 Owner and/or the City of Rockwall.
- 3. Concrete paving joints shall be constructed as recommended in the geotechnical report noted below. Expansion joints shall be placed at changes in direction of paving, at driveways and/or as shown on the drawings. Seal all joints as shown on the drawings.
- 4. Paving sections shall be sawcut in 15' x15' squares.
- 5. Site grading and pavement subgrade shall be prepared in accordance with the Geotechnical Report No. G161157 prepared by ALPHA TESTING dated 06/10/2016.
- 6. Unless otherwise indicated on plans, all dimensions are to face of curb or face of building and are perpendicular to property line. These dimensions are provided to tie the Architect's Site Plan to the property lines.
- 7. All sidewalks and handicap parking areas shall meet current ADA standards for minimum and maximum slopes.

3803 PARKWOOD BLVD, SUITE 800 FRISCO, TEXAS 75034-8640 TEL (214) 618-4574 TBPE FIRM #F-312

Description
RECORD DRAWINGS

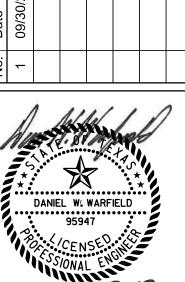

authorized by Daniel W. Warfield, P.E. 95947

on (05/15/19). Alteration of a sealed

document without proper notification to the

responsible engineer is an offense under the

Texas Engineering Practice Act. The record


copy of this drawing is on file at the offices of Halff Associates, Inc., 3803 Parkwood Blvd.,

Frisco, Texas 75034. TBPE FIRM #F-312.

RECORD DRAWING

TO THE BEST OF OUR KNOWLEDGE
HALFF ASSOCIATES, INC. HEREBY STATES
THAT THIS PLAN IS A RECORD DRAWING.
THESE RECORD DRAWINGS HAVE BEEN
PREPARED BASED ON FIELD OBSERVATIONS,
ON 09/10/2019. AND FIELD SURVEY

WORK CONDUCTED AT THE SITE. THE ORIGINAL SEALED CONSTRUCTION DRAWINGS ARE ON FILE AT THE OFFICES OF:
HALFF ASSOCIATES, INC., TBPE FIRM #312

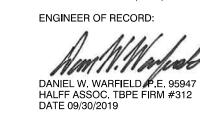

BENCHMARKS				
#	NORTHING	EASTING	ELEVATION	DESCRIPTION
105	7015991.2980	2592962.1928	550.06	SXTP
106	7015431.9569	2593196.4381	543.24	SXTP
320	7015521.4980	2592947.0430	546.21	SXTP
321	7015870.0270	2593095.7245	548.29	SXTP
322	7015977.2058	2593078.3578	549 . 54	SXTP

Project No.: 35866
Issued: 9/30/2019

Drawn By: CAD
Checked By: DWW
Scale: AS NOTED
Sheet Title
GENERAL
NOTES

C0.02
Sheet Number