

RECORD DRAWING


This is to certify that changes and corrections have been made to conform to the contractor's record of this project.

[Signature]
Date: 1/14/99

Graham Associates, Inc.
CONSULTING ENGINEERS & PLANNERS

SCALE: 1" = 40' HORIZ.
1" = 4' VERT.

2.28

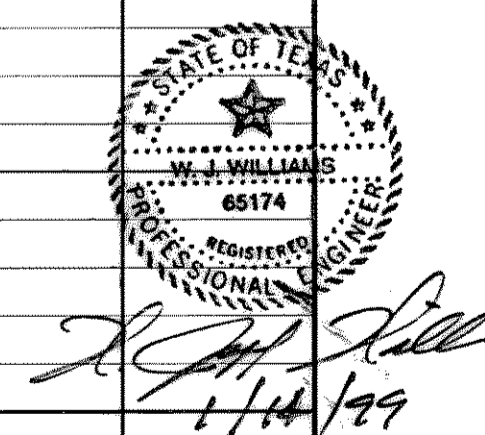

STORM SEWER PROFILE

LINE "A"

LAKE POINTE BAPTIST CHURCH

CITY OF ROCKWALL
ROCKWALL COUNTY, TEXAS

Graham Associates, Inc.
CONSULTING ENGINEERS & PLANNERS

616 SIX FLAGS DRIVE, SUITE 400
ARLINGTON, TEXAS 76011 (817) 640-8535

Date: NOV., 1998
File: 9762-1011
Drawn By: G.A.I. Sheet 20 of 27