

LEGEND

- SAWCUT FULL DEPTH & REMOVE EX. CONCRETE PAVEMENT & CURB & GUTTER TO BE REMOVED & DISPOSE OF PROPERLY OFF SITE.

- NOTE: 1. SEE DIMENSION CONTROL SHEET FOR ADDITIONAL DIMENSIONS
 2. REFER TO BUILDING CONSTRUCTION PLANS SHEET 2.40 FOR LIGHT POLE RELOCATIONS.


RECORD DRAWING

IMPROVEMENTS INDICATED ON THIS PLAN WHERE MADE IN ACCORDANCE WITH THE PROJECT PLANS & SPECIFICATIONS. THE DESIGN ENGINEER IS NOT AWARE OF ANY CHANGES TO THESE PLANS OTHER THAN THOSE PROVIDED ON A CONTRACTORS SET OF MARKUPS.
 DATE: JUNE 03, 2003

BENTLEY ENGINEERING, INC.
 CIVIL ENGINEERING • PLANNING • CONSTRUCTION MANAGEMENT
 705 GATEWOOD DRIVE
 CARLAND, TEXAS 75443
 PHE: (972) 246-4821
 FAX: (972) 246-0922

RECORD DRAWING

DEMOLITION PLAN
 LAKE POINTE BAPTIST CHURCH YOUTH BUILDING
 CITY OF ROCKWALL, TEXAS

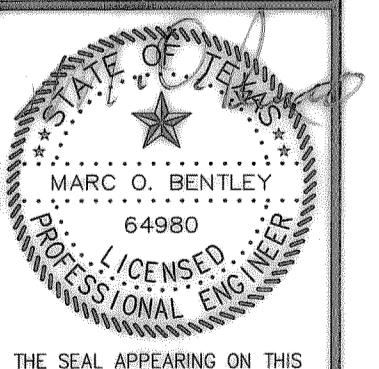

Scale:	1"=30'
File Name:	LP SITE
Date:	JULY 2001
Project No.:	21134
Designed:	B.E.I.
Drawn:	B.E.I.
Checked:	M.O.B.

SHEET
C1

No.	Date	Revision	By
	3/6/02	Permit Set	