


# ENGINEERING CONSTRUCTION PLANS FOR LAKE POINTE CHURCH

## NEW CHAPEL/EDUCATIONAL BUILDING PART OF LOT 1 BLOCK A CITY OF ROCKWALL, ROCKWALL COUNTY, TEXAS

AVO 31697 - LAKE POINTE CHURCH  
LOT 1, BLOCK A LAKE POINTE BAPTIST CHURCH ADDITION

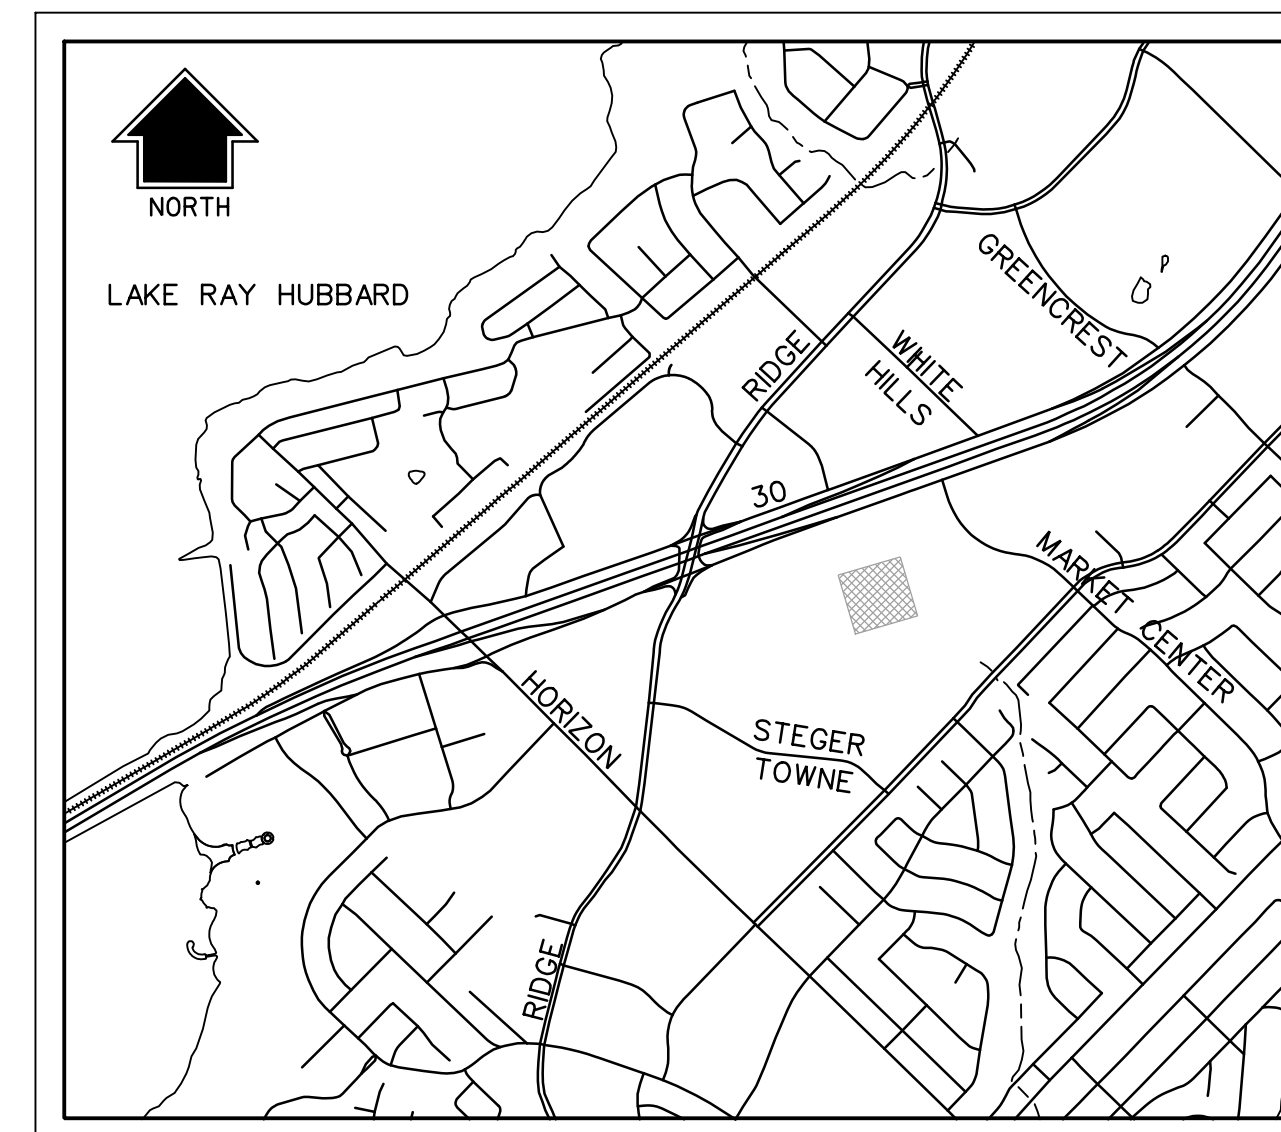

LOCATION MAP  
N.T.S.  
MAPSCO NO. 30C-G

### SHEET INDEX

	COVER SHEET
	REPLAT
C0.01	GENERAL NOTES
C1.01	SITE LOCATION PLAN
C1.02	SITE PLAN
C2.01	DEMOLITION PLAN
C3.01	EROSION CONTROL PLAN
C3.02	EROSION CONTROL NOTES & DETAILS
C4.01	PAVING PLAN
C4.02	PAVING DETAILS
C5.01	GRADING PLAN
C5.02	GRADING INSET DETAIL
△ C6.01	DRAINAGE AREA MAP
C6.02-C6.03	STORM DRAIN PLAN
C6.04	STORM DRAIN PROFILE
C6.05	STORM DRAIN CALCULATIONS
C7.01	PRIVATE WASTE WATER PLAN
C8.01	PUBLIC WATER PLAN
C9.01	UTILITY PLAN

#### OWNER / DEVELOPER

LAKE POINTE CHURCH- ROCKWALL CAMPUS  
701 INTERSTATE 30  
ROCKWALL, TX 75087  
CONTACT: JOHN WARDELL  
(PH) 469-698-2244

#### CIVIL ENGINEER

HALFF ASSOCIATES, INC.  
3803 PARKWOOD BLVD., SUITE 800  
FRISCO, TX 75034  
TBPE FIRM #F-312  
CONTACT: DAN WARFIELD, P.E.  
(PH) 214-618-4570

#### ARCHITECT

SHANKS ARCHITECTS  
5151 BELTLINE ROAD, SUITE 840  
DALLAS, TX 75254  
CONTACT: TIM BROYLES, RA  
(PH) 972-788-9300




3803 PARKWOOD BLVD., SUITE 800  
FRISCO, TEXAS 75034-8640  
TEL (214) 618-4570  
FAX (214) 618-4574  
TBPE FIRM #F-312

#### RECORD DRAWING

TO THE BEST OF OUR KNOWLEDGE HALFF ASSOCIATES, INC. HEREBY STATES THAT THIS PLAN IS A RECORD DRAWING. THESE RECORD DRAWINGS HAVE BEEN PREPARED BASED ON INFORMATION PROVIDED BY THE GENERAL CONTRACTOR, MEDCO CONSTRUCTION L.L.C. DURING MAY 2018, FIELD OBSERVATIONS, ON 05/09/2018, AND FIELD SURVEY WORK CONDUCTED AT THE SITE. THIS INFORMATION INCLUDES MODIFICATIONS BY ADDENDA AND CHANGE ORDERS. THE ORIGINAL SEALED CONSTRUCTION DRAWINGS ARE ON FILE AT THE OFFICES OF:  
HALFF ASSOCIATES, INC., TBPE FIRM #312

ENGINEER OF RECORD:

*Daniel W. Warfield*  
DANIEL W. WARFIELD, P.E. 95947  
HALFF ASSOC. TBPE FIRM #312  
DATE 06/11/2018

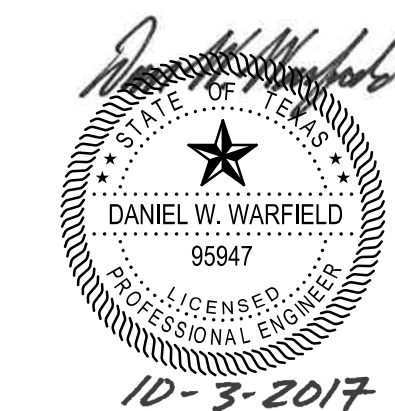

The seal appearing on this document was authorized by Daniel W. Warfield, P.E. 95947 on 10-03-2017. Alteration of a sealed document without proper notification to the responsible engineer is an offense under the Texas Engineering Practice Act. The record copy of this drawing is on file at the offices of Halff Associates, Inc., 3803 Parkwood Blvd., Frisco, Texas 75034, TBPE FIRM #F-312.

Revision		
No.	Date	Description
1	04/25/2017	REVISED TO ADDRESS CITY COMMENTS
2	10/03/2017	GRADING, ADDED F.H. RAISED FL AND STORM DRAINAGE
3	06/11/2018	RECORD DRAWINGS
-	-	-
-	-	-
-	-	-
-	-	-

APRIL 2017 PROBABLE START OF CONSTRUCTION