


REVISED BACKGROUND PROPOSED  
SITE PLAN LAYOUT ONLY

**RECORD DRAWING**  
TO THE BEST OF OUR KNOWLEDGE  
HALFF ASSOCIATES, INC. HEREBY STATES  
THAT THIS PLAN IS A RECORD DRAWING.  
THESE RECORD DRAWINGS HAVE BEEN  
PREPARED BASED ON INFORMATION  
PROVIDED BY THE GENERAL CONTRACTOR,  
MEDCO CONSTRUCTION L.L.C.  
DURING MAY 2018, FIELD OBSERVATIONS,  
ON 05/09/2018, AND FIELD SURVEY  
WORK CONDUCTED AT THE SITE. THIS  
INFORMATION INCLUDES MODIFICATIONS  
BY ADDENDA AND CHANGE ORDERS. THE  
ORIGINAL SEALED CONSTRUCTION  
DRAWINGS ARE ON FILE AT THE OFFICES OF:  
HALFF ASSOCIATES, INC., TBPE FIRM #312  
ENGINEER OF RECORD:  
*Daniel W. Warfield*  
DANIEL W. WARFIELD, P.E. 95947  
HALFF ASSOC. TBPE FIRM #312  
DATE 06/11/2018

**LAKE POINTE CHURCH**  
**NEW CHAPEL / EDUCATION BUILDING**  
701 Interstate 30 Rockwall, TX 75087

**HALFF**  
3803 PARKWOOD BLVD, SUITE 800  
FRISCO, TEXAS 75034-2640  
TEL: (214) 618-4174  
FAX: (214) 618-4174  
TBPE FIRM #F-312

Revision No.	Date	Description
2	10/03/2017	OWNER, ARCHITECT, ENGINEER, AND STORE DRAWING RECORD DRAWINGS
3	06/11/2018	RECORD DRAWINGS

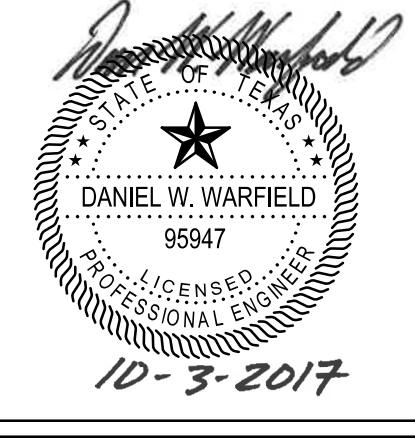

The seal appearing on this document was authorized by Daniel W. Warfield, P.E. 95947 on 10-03-2017. Alteration of a sealed document without proper notification to the responsible engineer is an offense under the Texas Engineering Practice Act. The record copy of this drawing is on file at the offices of Halff Associates, Inc., 3803 Parkwood Blvd., Frisco, Texas 75034, TBPE FIRM #F-312.

Project No.:	31697
Issued:	08/01/2017
Drawn By:	TRS
Checked By:	DWW
Scale:	AS NOTED
Sheet Title	SITE LOCATION PLAN
Sheet Number	C1.01