


**LAKE POINTE CHURCH
NEW CHAPEL / EDUCATION BUILDING**
701 Interstate 30 Rockwall, TX 75087



Revision No.	Date	Description
2	10/03/2017	ISSUING, ADDRESS CHANGE AND STORM DRAINAGE
3	06/11/2018	RECORD DRAWINGS

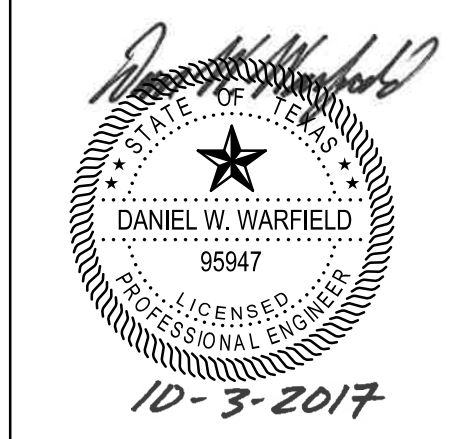

The seal appearing on this document was authorized by Daniel W. Warfield, P.E. 95947 on 10-3-2017. Absence of a sealed document without proper notification to the responsible engineer is an offense under the Texas Engineering Practice Act. The record copy of this drawing is on file at the offices of Halff Associates, Inc., 3803 Parkwood Blvd., Frisco, Texas 75034. TBPE FIRM #312.

Project No.: 31697
Issued: 08/01/2017
Drawn By: TRS
Checked By: DWW
Scale: AS NOTED

Sheet Title
STORM DRAIN PROFILE
C6.04
Sheet Number

BENCHMARK #	NORTHING	EASTING	ELEVATION	DESCRIPTION
105	7015991.2980	2592962.1928	550.06	SXTP
106	7015431.9569	2593196.4381	543.24	SXTP
320	7015521.4980	2592947.0430	546.21	SXTP
321	7015870.0270	2593095.7245	548.29	SXTP
322	7015977.2058	2593078.3578	549.54	SXTP

SEE SHEET C0.01 FOR GENERAL NOTES