


STORM SEWERS
 LIKE RAY HUBBARD ESTATES
 ROCKWALL, TEXAS
 1:4" V. 1" H. DATE 1978

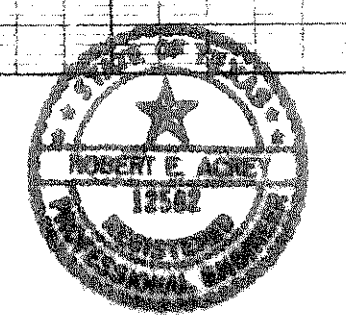

ACREE ASSOCIATES
 CONSULTING ENGINEERS
 LONG STAR LIFE BUILDING
 500 NORTH HAWTHORNE ROAD
 DALLAS, TEXAS 75202

MADE IN U.S.A.
 CLEARPRINT PAPER CO.
 CLEARPRINT PROFILE PLAM PLATE A

MADE IN U.S.A.
 CLEARPRINT PAPER CO.
 CLEARPRINT PROFILE PLAM PLATE A

MADE IN U.S.A.
 CLEARPRINT PAPER CO.
 CLEARPRINT PROFILE PLAM PLATE A