

1. Pipe materials to be Mueller, Class 150, or equal.
2. Trench backfill to be jetted by contractor.
3. Contractor to furnish As Built Plans showing ties from Water & Sewer Services to the Nearest Lot corner.
4. Lots to have 1" Copper water services & 4" sewer laterals, locate sewer laterals by painting red on curb at center of lot. Water services 5' uphill.
5. Lots to have an 18" diameter X 14" galvanized water meter box and a 1" angle type-K copper meter coupling.

CURVE DATA			
Cv. No.	INT.	EXT.	EXT.
1	Δ	16°59'25"	69°25'40"
	R	641.20	118.0'
	T	95.77	81.83'
	L	190.14'	143.09'
2	Δ	10°54'47"	76°26'04"
	R	802.26	100.0'
	T	76.62	77.34'
	L	152.78	131.66'
3	Δ	0°29'27"	2°28'47"
	R	51°25'53"	73°50'
	T	345.23	100.0'
	L	178.18	87.61'
4	Δ	0°08'29"	153.24'
	R	0.08296	2,280.75'
	T	10°24'57"	8°21'46"
	L	278.09'	454.34'
5	Δ	100.14'	51.75'
	R	171.70	65.39'
	T	0.108786	2,026.59'
	L		
6	Δ		
	R		
	T		
	L		
7	Δ		
	R		
	T		
	L		
8	Δ		
	R		
	T		
	L		

"AS-BUILT"


## WATER & SANITARY SEWER LAKE RAY HUBBARD ESTATES

AN ADDITION TO THE CITY OF  
ROCKWALL, TEXAS  
OUT OF THE D. ATKINS SURV. ABST. NO. 1  
ROCKWALL COUNTY, TEXAS

HAYWOOD EAGON & TONY CHUCKE - OWNERS  
P.O. BOX 18133 - DALLAS, TEXAS - 475-2933, 691-2521

ACREY ASSOCIATES, INC. - CONSULTING ENGINEERS  
2331 GUS THOMASSON RD. DALLAS, TEXAS  
P.O. BOX 28902 528-4613

June 21, 72

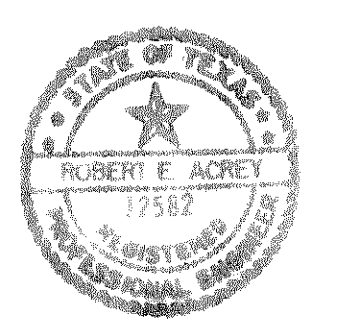

1/2

PROPOSED WATER CONNECTION  
IN FM 740  
CITY OF ROCKWALL TEXAS