


LAKE
RAY
HUBBARD

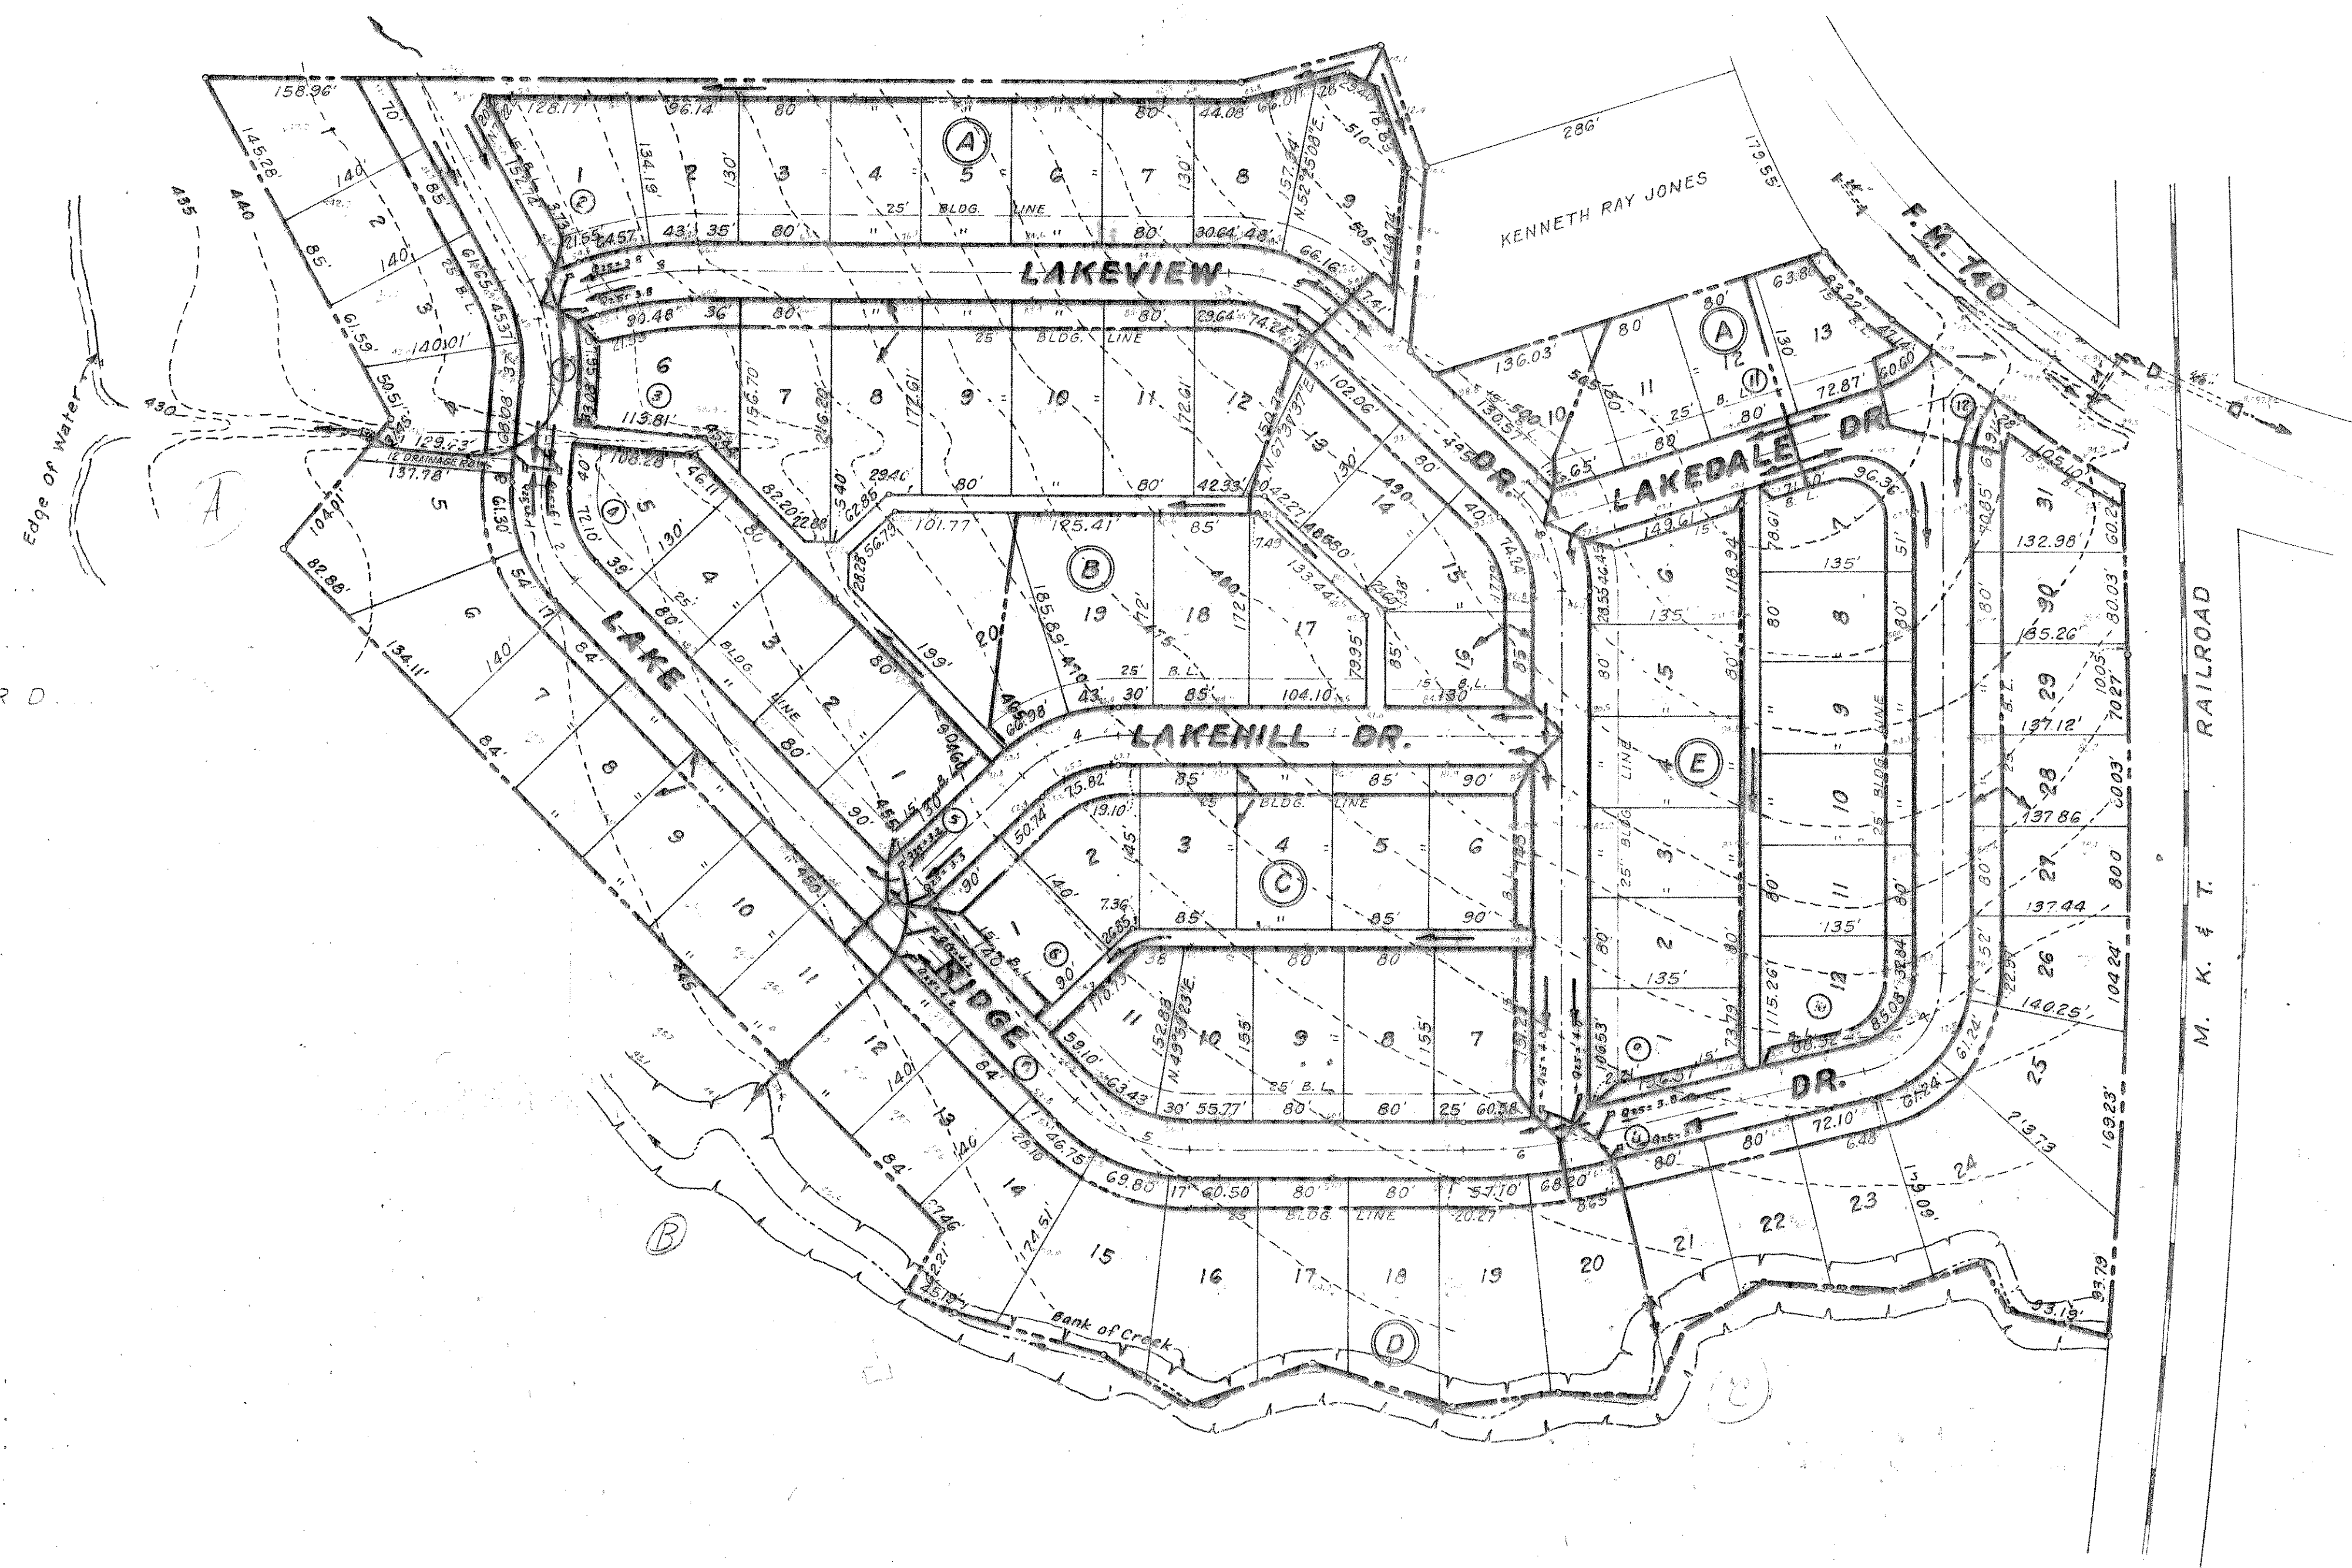

No	Area	C	I ₂₅	C _{I₂₅}	O ₂₅
1	1.0	0.4	5.3	2.1	2.1
2	3.6	"	"	"	7.6
3	2.7	"	"	"	5.7
4	2.1	"	"	"	4.4
5	3.1	"	"	"	6.5
6	1.5	"	"	"	3.2
7	2.5	"	"	"	5.3
8	2.2	"	"	"	4.6
9	3.0	"	"	"	6.3
10	1.4	"	"	"	2.9
11	0.8	"	"	"	1.7
12	0.3	"	"	"	0.6

DRAINAGE MAP					
LAKE RIDGE PARK ADDITION					
ROCKWALL, TEXAS					
C. L. MOON, INC. ~ ENGINEERS					
11554 E. NORTHWEST HWY. ~ DALLAS, TEXAS					
DESIGN & DRAWN	DATE	SCALE	NOTES	FILE	NO
C. L. MOON, INC. ENGINEERS	1972	1"=100'	J.C.		2

2B