


# ROCKWALL LAKE ESTATES

## AREA 3

JUNE 13, 2008



1 inch = 392.582536 feet

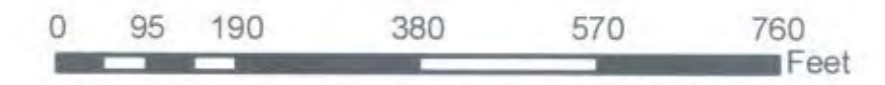

CITY OF ROCKWALL GEOGRAPHIC INFORMATION SYSTEMS



The data represented on this map was obtained with the best methods available. Data is supplied from various sources and accuracy may be out of the City of Rockwall's control. The verification of accuracy and / or content lies entirely with the end user. The City of Rockwall does not guarantee the accuracy of contained information. All information is provided "As Is" with no warranty being made, either expressed or implied.

### Legend

- 6" SEWER LINES (EXIST) W/ MANHOLES

2" steel line feeds - even number trout  
odd number trout  
even number Lakeside  
even number Bream  
odd number Bream



Trailer side  
Meters are in front  
even numbered EVA  
EVANS  
RENEE  
odd numbered RENEE.

poly line added  
between  
1st lines

Service

John Scott

COUNTY LINE RD