


LINE "B1"

LINE "B2"

LINE "B3"

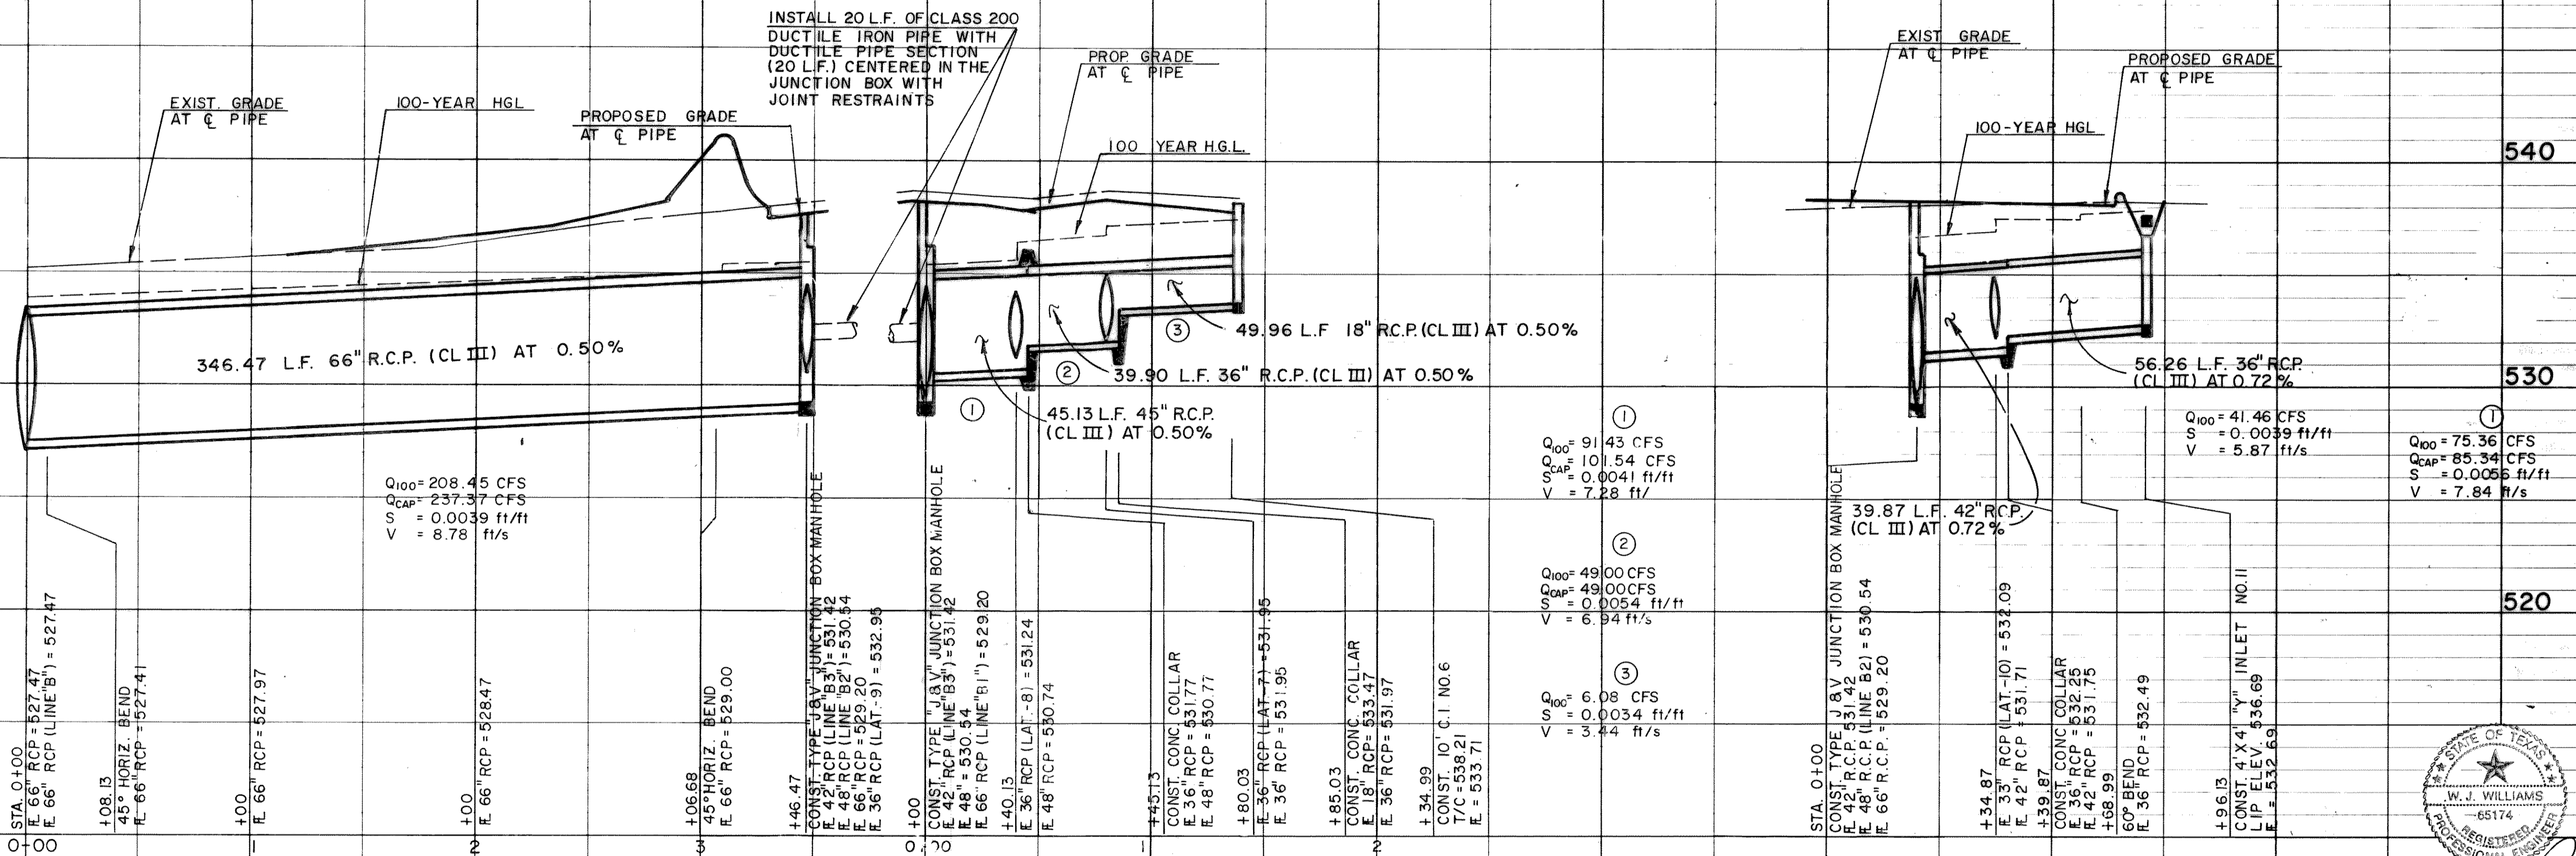


RECORD DRAWING

This is to certify that changes and corrections have been made in accordance with the contractor's record of this project.

[Signature] 4/12/00

Graham Associates, Inc.
CONSULTING ENGINEERS & PLANNERS

2.26

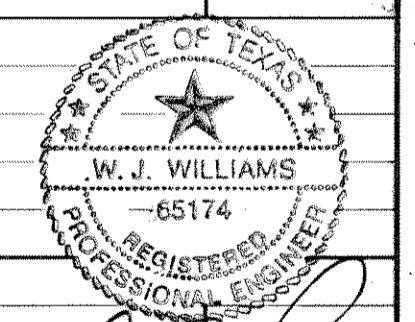

1/14/99

STORM SEWER PROFILE

LINES "B1", "B2" & "B3"

LAKE POINTE BAPTIST CHURCH

CITY OF ROCKWALL

ROCKWALL COUNTY, TEXAS

Graham Associates, Inc.
CONSULTING ENGINEERS & PLANNERS

616 SIX FLAGS DRIVE, SUITE 400
ARLINGTON, TEXAS 76011 (817) 640-8535

Drawn By: G. A. I. Sheet 18 of 27

Date: NOV. 1998
File: 9762-1011