

LOCATION MAP  
NO SCALE


# SITE CONSTRUCTION PLANS

FOR

# LAKE POINTE BAPTIST CHURCH YOUTH BUILDING

# LAKE POINTE CHURCH ADDITION BLOCK A, LOT 1

# IN THE CITY OF ROCKWALL, TEXAS

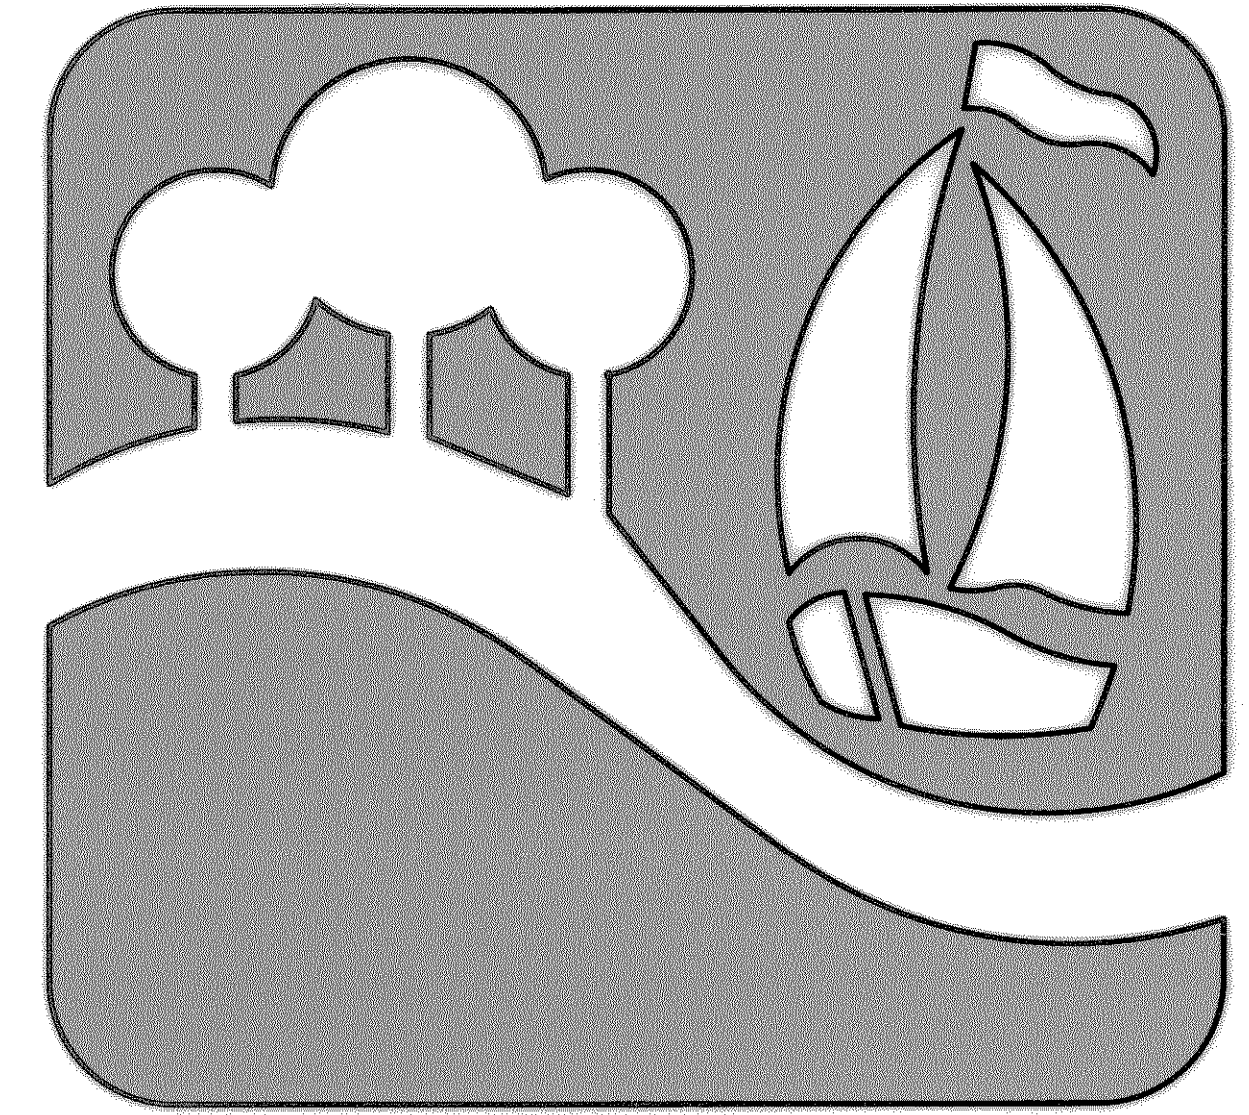

"THE NEW HORIZON"

## SHEET INDEX


Sheet No.	Description
1	Cover Sheet
2	Replat
SP1	Site Plan
C1	Demolition Plan
C2	Dimension Control
C3	Grading Plan
C4	Water/Sewer Plan
C5	Erosion Control
C6	Typical Details & Notes

## BENTLEY ENGINEERING, INC

CIVIL ENGINEERING • PLANNING • CONSTRUCTION MANAGEMENT

702 GATEWOOD DRIVE  
GARLAND, TEXAS 75043  
PH: (972) 240-4821  
FAX: (972) 240-0922

MARCH 2002

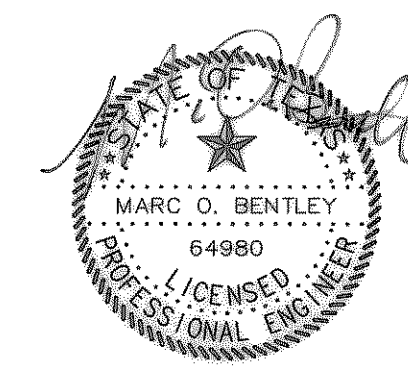

THE SEAL APPEARING ON THIS DOCUMENT WAS AUTHORIZED BY MARC O. BENTLEY, P.E. NO. 64980 ON 03/06/02

RECORD DRAWING

IMPROVEMENTS INDICATED ON THIS PLAN WHERE MADE IN ACCORDANCE WITH THE PROJECT PLANS & SPECIFICATIONS. THE DESIGN ENGINEER IS NOT AWARE OF ANY CHANGES TO THESE PLANS OTHER THAN THOSE PROVIDED ON A CONTRACTORS SET OF MARKUPS.  
DATE: JUNE 03, 2003