


RECORD DRAWINGS
 TO THE BEST OF OUR KNOWLEDGE BINKLEY & BARFIELD - C&P, INC.,
 HEREBY STATES THAT THIS PLAN IS AS-BUILT. THIS INFORMATION
 PROVIDED IS BASED ON SURVEYING AT THE SITE AND INFORMATION
 PROVIDED BY THE CONTRACTOR.
 DATE: 7-1-2014 SIGNATURE: *[Signature]*
 BINKLEY & BARFIELD - C&P, INC.

B.M. 5/8" IRON ROD WITH YELLOW CAP FOUND
 ON SOUTH CORNER OF THE INTERSECTION
 OF INDUSTRIAL BLVD. AND AIRPORT ROAD
 ELEVATION = 581.84
 *ALL RESPONSIBILITY FOR ADEQUACY OF DESIGN
 REMAINS WITH THE DESIGN ENGINEER. THE CITY
 OF ROCKWALL, IN REVIEWING AND RELEASING PLANS
 FOR CONSTRUCTION, ASSUMES NO RESPONSIBILITY
 FOR ADEQUACY OR ACCURACY OF DESIGN*

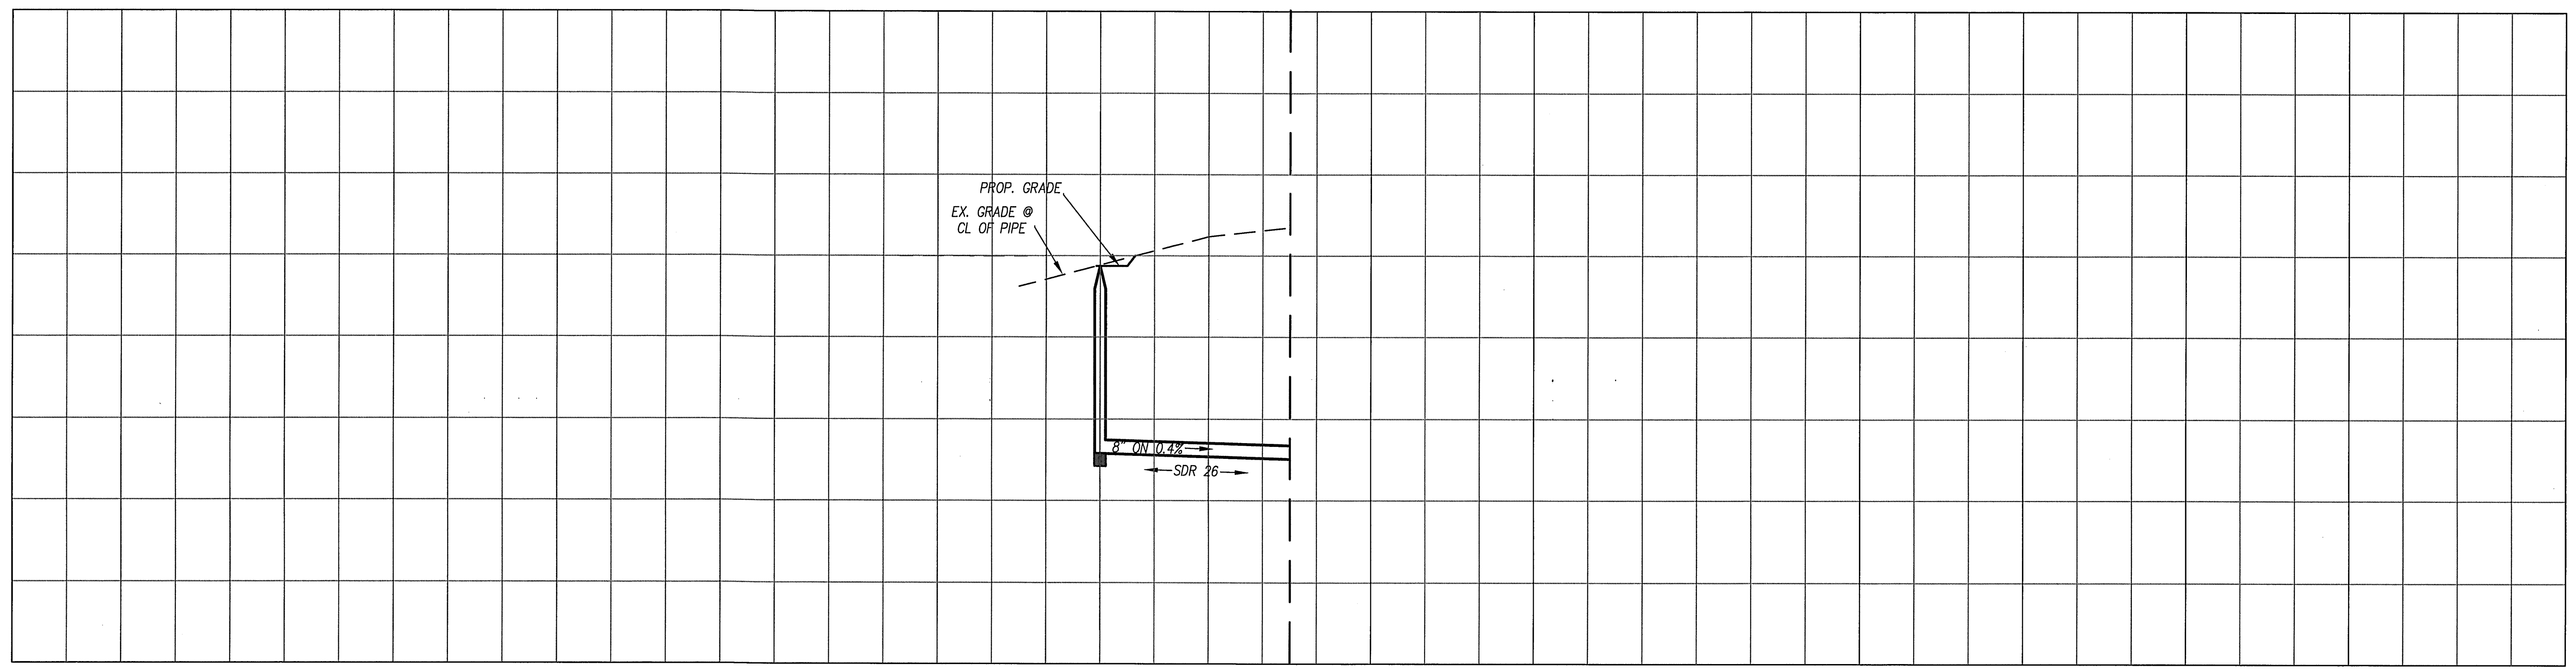

S:\153000 Lakes Reg MHMR Center\USA - BC12049 FORCE MAIN PP.dwg-PM SHEET 3 Plotted Jul 01, 2014 at 12:43pm by kerderson | Last Saved by: kerderson

Designed By:	RAA	Job No.:	BC12049
Drawn By:	BS	Date:	
Checked By:	TPJ	Scale:	1"=30' H (22"X34")
Approved By:			

The seal appearing on this document was authorized by Thomas P. Jones, P.E. 58887. Alteration of a sealed document without proper notification to the responsible engineer is an offense under the Texas Engineering Practice Act. Apr. 22, 2013

Binkley & Barfield | C&P
 consulting engineers
 1801 Gateway Blvd, Suite 101 Richardson Texas 75080 www.bbcp.com
 Firm Registration #F-3185

LAKES REGIONAL MHMR CENTER
 MR. DON SMITH
 P.O. BOX 747
 TERRELL, TX 75160
 972-388-2000, EXT. 1196
 DONS@LRMHMRC.ORG

OFFSITE SANITARY SEWER PLAN/PROFILE
 BLOCK A, LOT 4, COLUMBIA PARK ADDITION
 ROCKWALL, TEXAS
 LAKES REGIONAL
 MENTAL HEALTH MENTAL RETARDATION CENTER
 ROCKWALL, TEXAS

Sheet No:
SS3
 of NS