

Install:
2-8" 45° Bends

Install:
1-8" x 6" Tee
1-6" Valve
1-Fire Hydt.



Conn. to Ex. 16" Water & Install:
1-16" x 8" Tapping Sleeve & 8" Valve

Remove Exist. 8" Plug &
Conn. to Exist. 8" Valve

37 L.F. By Other
Than Open Cut

174 Ln. "A"
Const. 4.0' Dia. M.H.

0+00 Ln. "A" Const. 4.0' Dia.
M.H. Over Ex. 21" San. Sew.

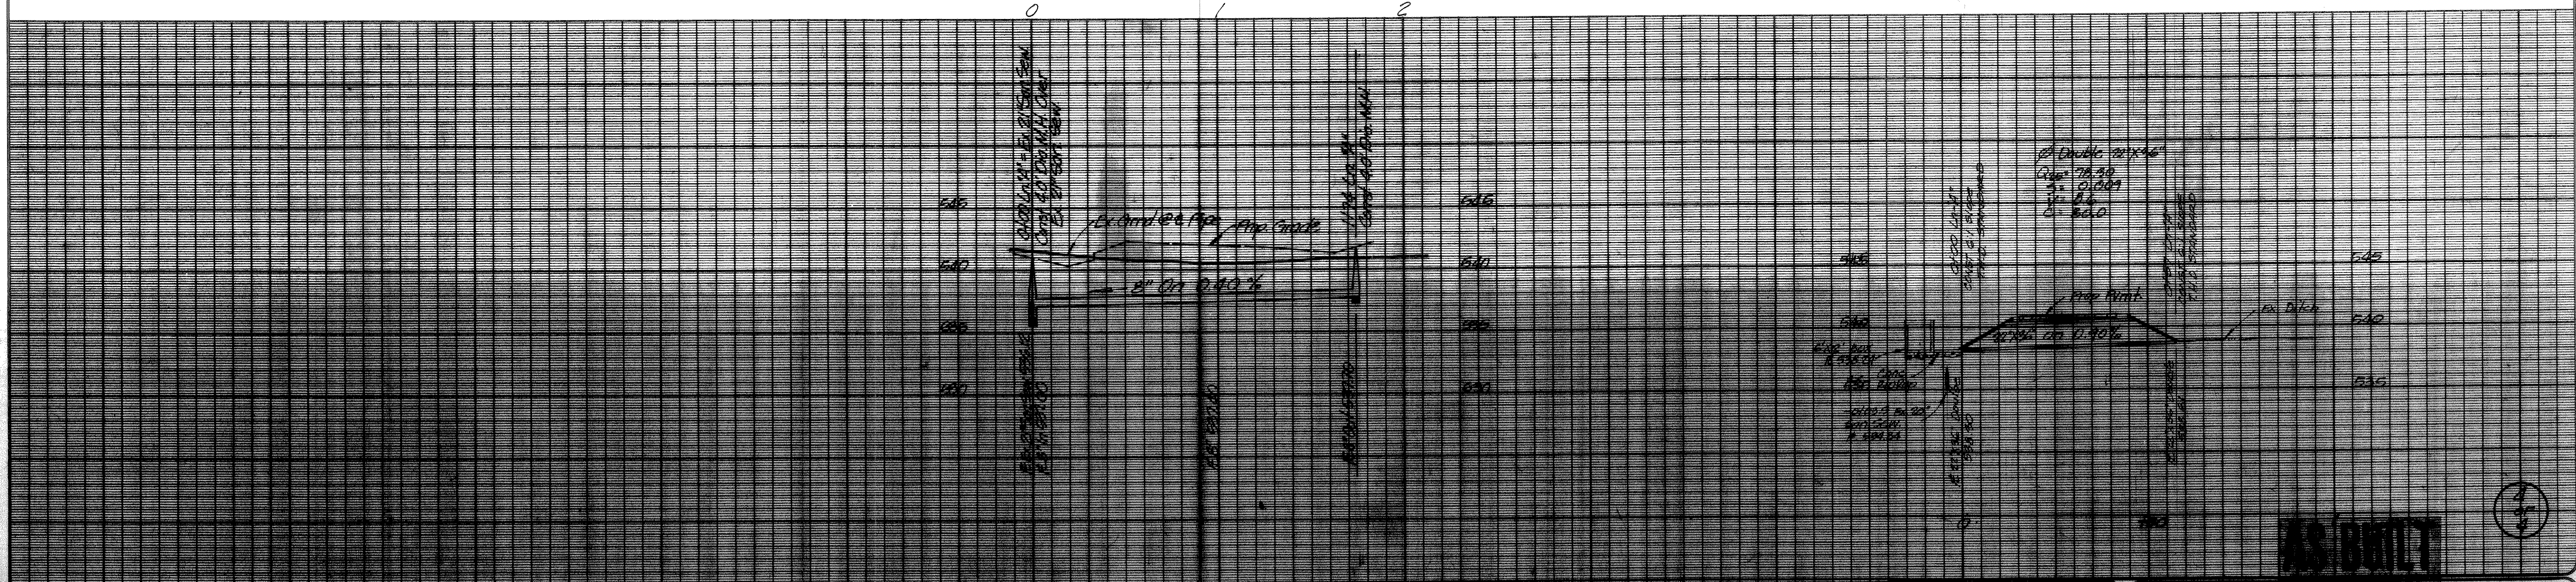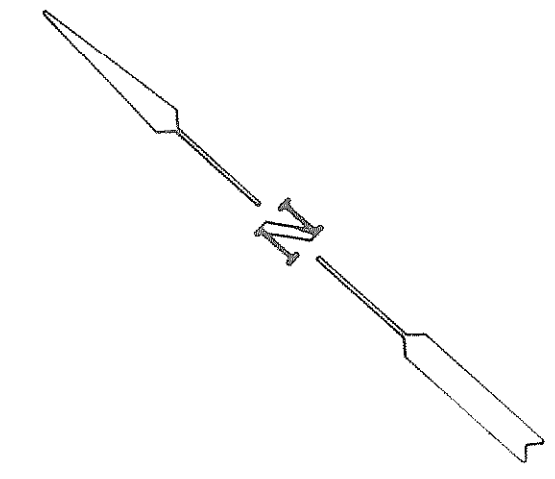

HAROLD L. EVANS
CONSULTING ENGINEER
2331 GUS THOMASSON RD. SUITE 102
DALLAS, TEXAS 75228
PHONE (214) 328-8133
SCALE DATE JOB NO.
1/4" = 1'-0" 9-12-84 84225

WATER & SANITARY SEWER
LAKESHORE BUSINESS PARK
CITY OF ROCKWALL
ROCKWALL COUNTY, TEXAS