


**CONSTRUCTION PLANS
FOR
LAKESHORE COMMONS
4.7 AC±
LOTS 1 - 4, BLOCK A
LAKESHORE COMMONS ADDN
IN
ROCKWALL, TEXAS**

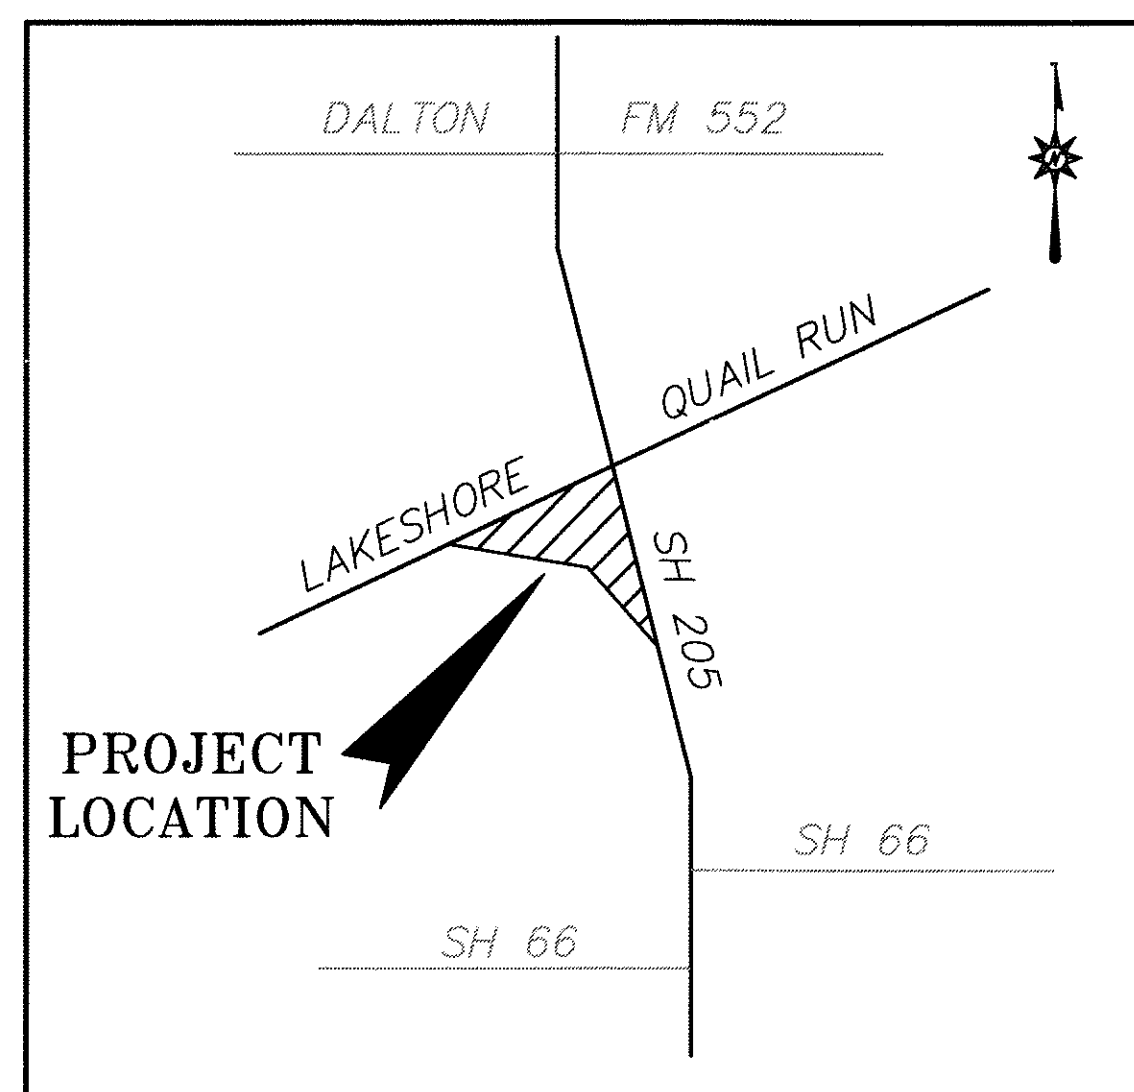

VICINITY MAP

**FOR
MOORE WORTH INVESTMENTS, LLC
8445 FREEPORT PARKWAY, SUITE 175
IRVING, TX 75063
214-415-9993**

FEBRUARY 2017

SHEET INDEX	
SHT #	SHEET TITLE
C-1	COVER SHEET
	FINAL PLAT - BY OTHERS
C-2	SITE & PAVING PLAN
C-3	GRADING PLAN
C-4	DRAINAGE PLAN
C-5	UDS DRAINAGE AREA MAP
C-6	DETENTION CALCULATIONS - POND A
C-7	DETENTION CALCULATIONS - POND B
C-8	DETENTION CALCULATIONS - UDS
C-9	UNDERGROUND DETENTION SYSTEM DETAILS
C-10	STORM SEWER PROFILES
C-11	STORM SEWER PROFILES
C-12	STORM SEWER & INLET CALCULATIONS
C-13	UTILITY PLAN
C-14	EROSION CONTROL PLAN
C-15	DETAILS & SANITARY SEWER PROFILE

PLAN SUBMITTALS		
No	DATE	COMMENTS
1	09-16-16	CITY OF ROCKWALL - 1st SUBMITTAL
2	02-06-17	CITY OF ROCKWALL - 2nd SUBMITTAL
3	03-06-17	CITY OF ROCKWALL - 3rd SUBMITTAL
4	03-15-17	CITY OF ROCKWALL - PARTIAL; SHTS C-4, C-5 & C-12
F	03-22-17	FINALS
REVISIONS		
1	03-23-17	REV UTILITY PLAN
2	05-17-17	REV SITE, PAVING, GRADING, DRAINAGE AND UTILITY PLAN
	05-30-17	FINALS
3	10-12-17	REV UTIL PLAN - WATER CONNECTION
4	10-16-17	REV POND B
5	05-10-18	REV DRAINAGE & LOT 3&4 UDS - 1ST SUB
5	06-26-18	REV SS, DRAINAGE, LOT 3&4 UDS, POND B, 205 SWALE & STRUCTURE #6 (LINE E) - 2ND SUB
5	07-17-18	REV OFF-SITE DRAINAGE AREAS - 3RD SUB
5	07-25-18	FINALS

RECORD DRAWING


THIS RECORD DRAWING HAS BEEN PREPARED
BASED ON INFORMATION PROVIDED BY OTHERS.
THE ENGINEER HAS NOT VERIFIED THE ACCURACY
OF THIS INFORMATION AND SHALL NOT BE
RESPONSIBLE FOR ANY DISCREPANCIES WHICH MAY
BE INCORPORATED HEREIN AS A RESULT.

Note: Copyright © Hickman Consulting Engineers, Inc. All rights reserved.
No part of this drawing may be reproduced by photocopying, recording or
by any other means, or stored, processed or transmitted in or by any
computer or other systems without the prior written permission of Hickman
Consulting Engineers, Inc. Copies of this plan without an original signature
and seal are not valid.

HCE
Hickman Consulting Engineers, Inc.
3094 County Road 1024
Farmersville, Texas 75442
Ph (972)784-2499
markredick@gmail.com
Engineers
Planners

COVER SHEET
LAKESHORE COMMONS
ROCKWALL, ROCKWALL COUNTY, TEXAS
MOORE WORTH INVESTMENTS, LLC
8445 FREEPORT PARKWAY, SUITE 175
IRVING, TX 75063
214-415-9993

SCALE: N/A
DATE: AUG2016
DRAWN BY: FP
CHK'D BY: MHH
JOB NO: 1501-357
FILE: 165-180187-LC-PWD
SUBMITTAL: 03/22/17(C)

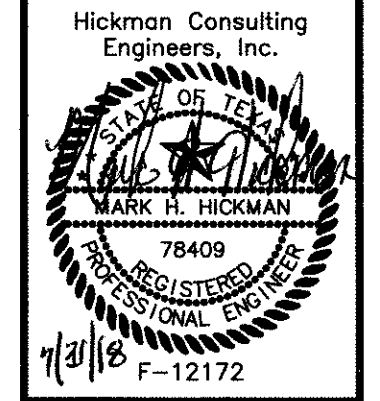


REVISION	DATE	BY	DESCRIPTION

SHEET
C-1



BEFORE YOU DIG CALL:
1-800-245-4545



TEXAS ONE CALL SYSTEM

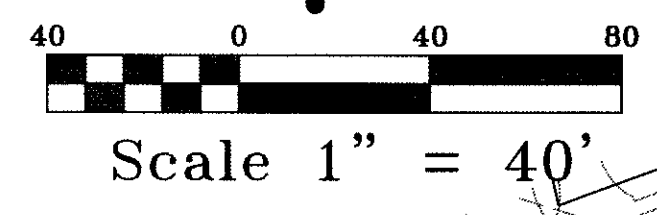

Scale 1" = 40'

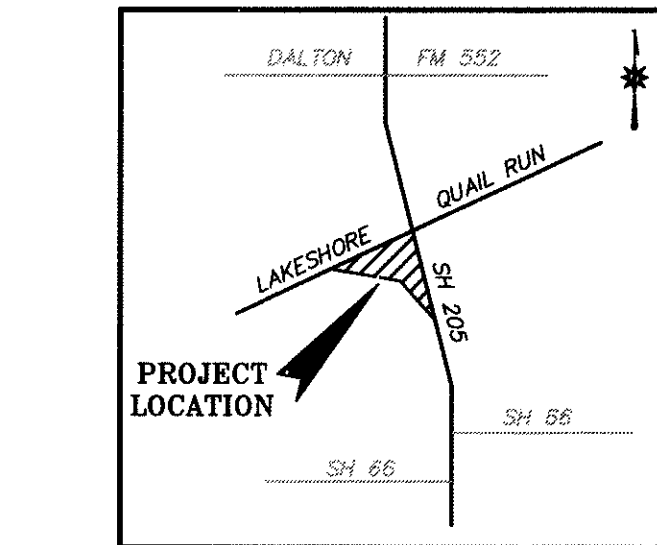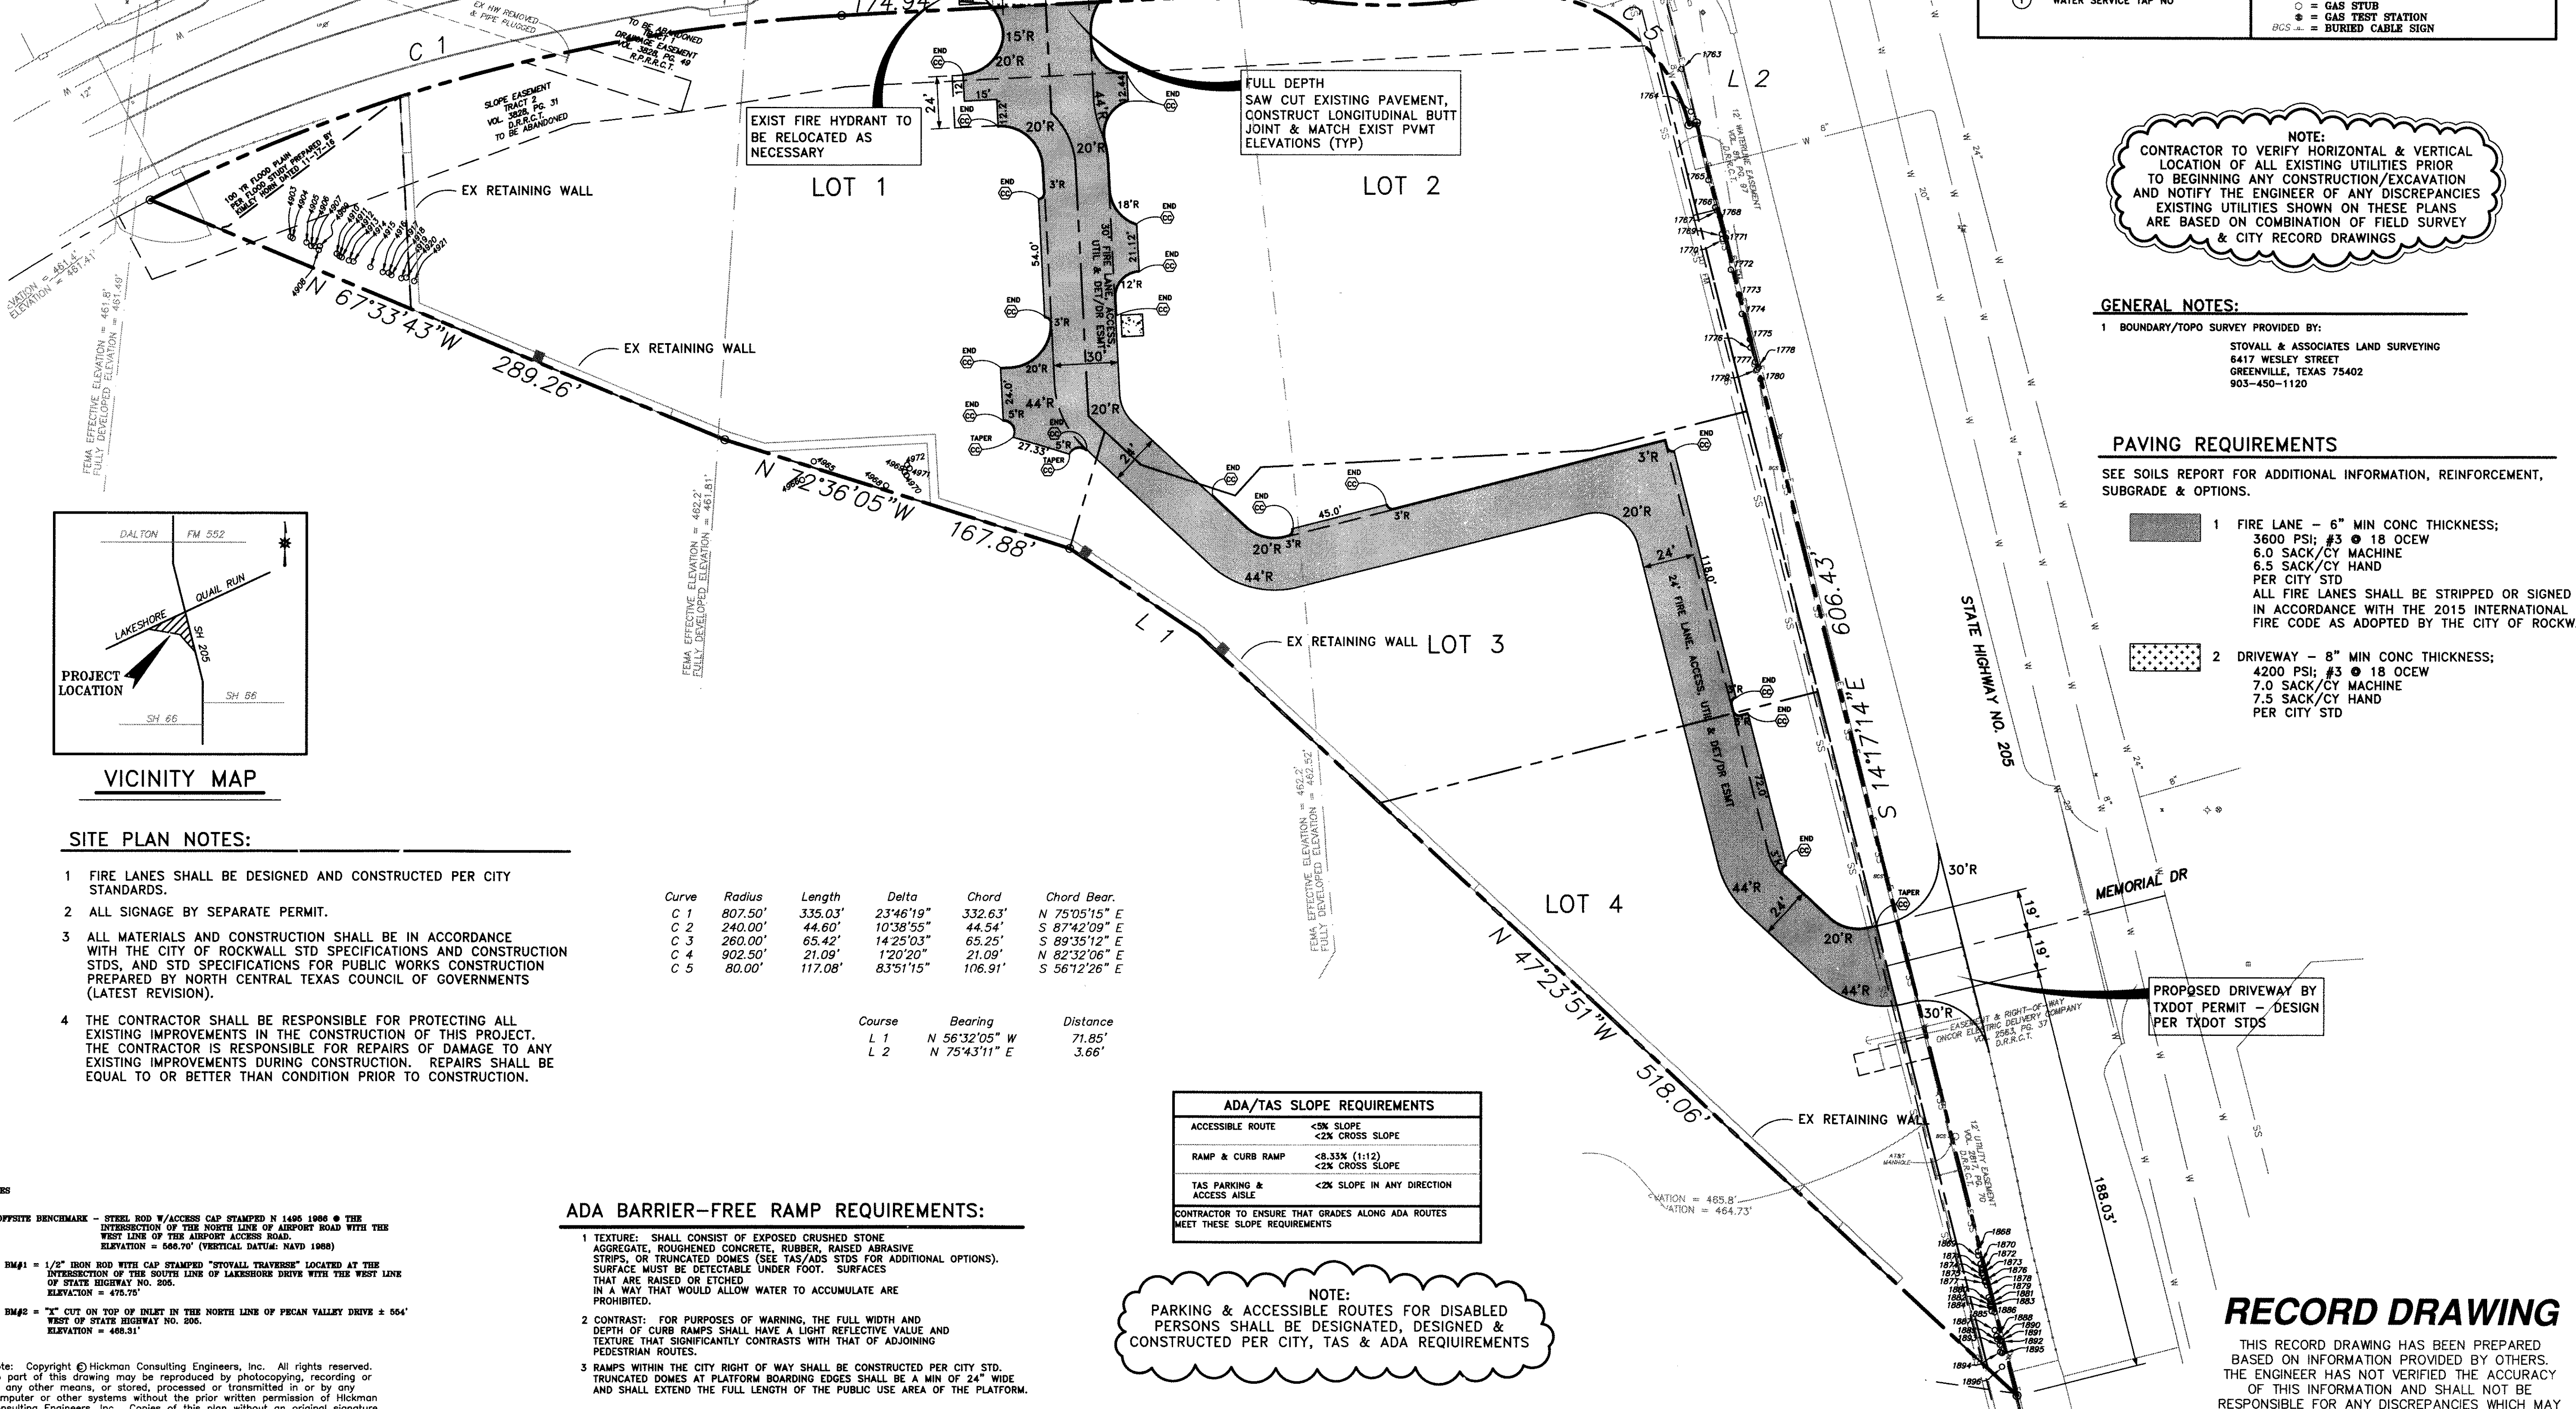

VICINITY MAP

SITE PLAN NOTES:

- FIRE LANES SHALL BE DESIGNED AND CONSTRUCTED PER CITY STANDARDS.
- ALL SIGNAGE BY SEPARATE PERMIT.
- ALL MATERIALS AND CONSTRUCTION SHALL BE IN ACCORDANCE WITH THE CITY OF ROCKWALL STD SPECIFICATIONS AND CONSTRUCTION STDS, AND STD SPECIFICATIONS FOR PUBLIC WORKS CONSTRUCTION PREPARED BY NORTH CENTRAL TEXAS COUNCIL OF GOVERNMENTS (LATEST REVISION).
- THE CONTRACTOR SHALL BE RESPONSIBLE FOR PROTECTING ALL EXISTING IMPROVEMENTS IN THE CONSTRUCTION OF THIS PROJECT. THE CONTRACTOR IS RESPONSIBLE FOR REPAIRS OF DAMAGE TO ANY EXISTING IMPROVEMENTS DURING CONSTRUCTION. REPAIRS SHALL BE EQUAL TO OR BETTER THAN CONDITION PRIOR TO CONSTRUCTION.

Curve	Radius	Length	Delta	Chord	Chord Bear.
C 1	807.50'	335.03'	23°46'19"	332.63'	N 75°05'15" E
C 2	240.00'	44.60'	10°38'55"	44.54'	S 87°42'09" E
C 3	260.00'	65.42'	14°25'03"	65.25'	S 89°35'12" E
C 4	902.50'	21.09'	1°20'20"	21.09'	N 82°32'06" E
C 5	80.00'	117.08'	83°51'15"	106.91'	S 56°12'26" E

Course	Bearing	Distance
L 1	N 56°32'05" W	71.85'
L 2	N 75°43'11" E	3.66'

ADA BARRIER-FREE RAMP REQUIREMENTS:

- TEXTURE: SHALL CONSIST OF EXPOSED CRUSHED STONE AGGREGATE, ROUGHENED CONCRETE, RUBBER, RAISED ABRASIVE STRIPS, OR TRUNCATED DOMES (SEE T&S/ADS STDS FOR ADDITIONAL OPTIONS). SURFACE MUST BE DETECTABLE UNDER FOOT. SURFACES THAT ARE RAISED OR ETCHED IN A WAY THAT WOULD ALLOW WATER TO ACCUMULATE ARE PROHIBITED.
- CONTRAST: FOR PURPOSES OF WARNING, THE FULL WIDTH AND DEPTH OF CURB RAMPS SHALL HAVE A LIGHT REFLECTIVE VALUE AND TEXTURE THAT SIGNIFICANTLY CONTRASTS WITH THAT OF ADJOINING PEDESTRIAN ROUTES.
- RAMPS WITHIN THE CITY RIGHT OF WAY SHALL BE CONSTRUCTED PER CITY STD. TRUNCATED DOMES AT PLATFORM BOARDING EDGES SHALL BE A MIN OF 24" WIDE AND SHALL EXTEND THE FULL LENGTH OF THE PUBLIC USE AREA OF THE PLATFORM.

ADA/T&S SLOPE REQUIREMENTS	
ACCESSIBLE ROUTE	<3% SLOPE <2% CROSS SLOPE
RAMP & CURB RAMP	<8.33% (1:12) <2% CROSS SLOPE
T&S PARKING & ACCESS AISLE	<2% SLOPE IN ANY DIRECTION

NOTE:
PARKING & ACCESSIBLE ROUTES FOR DISABLED PERSONS SHALL BE DESIGNATED, DESIGNED & CONSTRUCTED PER CITY, T&S & ADA REQUIREMENTS

PROPOSED	EXISTING
500 - PROPOSED CONTOURS	AP = POWER POLE
515.00 - SPOT ELEVATION AT FINISHED GRADE	AN = ANCHOR
514.00 - INDICATES TOP OF STRUCTURE	WM = WATER METER
513.50 - INDICATES FLOW LINE ELEVATION	WV = WATER VALVE
W - PROPOSED WATER LINE	ICV = IRRIGATION CONTROL VALVE
SS - PROPOSED SANITARY SEWER LINE	TP = TELEPHONE PEDESTAL
PS - PROPOSED STORM DRAIN LINE	GM = GAS METER
PC - PROPOSED CONDUIT	MB = MAILBOX
PG - PROPOSED GAS	LP = LIGHT POLE
CS - CONCRETE CURB PER CITY STD	FH = FIRE HYDRANT
WT - WATER SERVICE TAP NO	BL = BUILDING LINE
	UE = UTILITY EASEMENT
	DUE = DRAINAGE & UTILITY EASEMENT
	FDC = FIBER OPTIC CABLE MARKER
	GAS = GAS SIGN
	SSSB = SUB SURFACE SERVICE BOX
	TS = TRAFFIC SIGNAL
	U.E. = UTILITY EASEMENT
	GS = GAS SIGN
	GSST = GAS TEST STATION
	BGS = BURIED CABLE SIGN

NOTE:
CONTRACTOR TO VERIFY HORIZONTAL & VERTICAL LOCATION OF ALL EXISTING UTILITIES PRIOR TO BEGINNING ANY CONSTRUCTION/EXCAVATION AND NOTIFY THE ENGINEER OF ANY DISCREPANCIES EXISTING UTILITIES SHOWN ON THESE PLANS ARE BASED ON COMBINATION OF FIELD SURVEY & CITY RECORD DRAWINGS

GENERAL NOTES:

1 BOUNDARY/TOPSO SURVEY PROVIDED BY:
STOWALL & ASSOCIATES LAND SURVEYING
8417 WESLEY STREET
GREENVILLE, TEXAS 75402
903-450-1120

PAVING REQUIREMENTS

SEE SOILS REPORT FOR ADDITIONAL INFORMATION, REINFORCEMENT, SUBGRADE & OPTIONS.

- FIRE LANE - 6" MIN CONC THICKNESS;
3600 PSI; #3 @ 18 OCEW
6.0 SACK/CY MACHINE
6.5 SACK/CY HAND
PER CITY STD
ALL FIRE LANES SHALL BE STRIPPED OR SIGNED IN ACCORDANCE WITH THE 2015 INTERNATIONAL FIRE CODE AS ADOPTED BY THE CITY OF ROCKWALL
- DRIVEWAY - 8" MIN CONC THICKNESS;
4200 PSI; #3 @ 18 OCEW
7.0 SACK/CY MACHINE
7.5 SACK/CY HAND
PER CITY STD

RECORD DRAWING

THIS RECORD DRAWING HAS BEEN PREPARED BASED ON INFORMATION PROVIDED BY OTHERS. THE ENGINEER HAS NOT VERIFIED THE ACCURACY OF THIS INFORMATION AND SHALL NOT BE RESPONSIBLE FOR ANY DISCREPANCIES WHICH MAY BE INCORPORATED HEREIN AS A RESULT.

Hickman Consulting Engineers, Inc.
9084 County Road 1024
Farmersville, Texas 75442
Ph (972) 784-2499
mark@hce.com
markredhick@gmail.com
Planners
Engineers

SITE PLAN
LAKESHORE COMMONS
LOTS 1 - 4; LAKESHORE COMMONS
ROCKWALL, ROCKWALL COUNTY, TEXAS
MOORE WORTH INVESTMENTS, LLC
8445 FREEMONT PARKWAY, SUITE 175
IRVING, TX 75063
214-415-9993


SCALE: 1"=40'
DATE: AUG2016
DRAWN BY: EP
CHK'D BY: MHH
JOB NO: 1501-357
FILE: 15-1501357-10-11-WO
DATE SUBMITTED: 03/22/17(F)

Hickman Consulting Engineers, Inc.
78409
78409
F-12172

REVISION	DATE	DESCRIPTION
2	08-17-17	REV TO SHOW ADDITIONAL PAVING/CURB ALONG FIRE LANE

NOTES:
1) OFFSITE BENCHMARK - STEEL ROD W/ACCESS CAP STAMPED N 1486 1886 @ THE INTERSECTION OF THE NORTH LINE OF AIRPORT ROAD WITH THE WEST LINE OF THE AIRPORT ACCESS ROAD. ELEVATION = 686.70' (VERTICAL DATUM: NAVD 1988)
BM#1 = 1/2" IRON ROD WITH CAP STAMPED "STOWALL TRAVERSE" LOCATED AT THE INTERSECTION OF THE SOUTH LINE OF LAKESHORE DRIVE WITH THE WEST LINE OF STATE HIGHWAY NO. 206. ELEVATION = 476.70'
BM#2 = 1" CUT IN TOP OF INLET IN THE NORTH LINE OF PECAN VALLEY DRIVE @ 504' WEST OF STATE HIGHWAY NO. 206. ELEVATION = 468.31'
Note: Copyright © Hickman Consulting Engineers, Inc. All rights reserved. No part of this drawing may be reproduced by photocopying, recording or by any other means, or stored, processed or transmitted in or by any computer or other systems without the prior written permission of Hickman Consulting Engineers, Inc. Copies of this plan without an original signature and seal are not valid.

BEFORE YOU DIG CALL:
1-800-245-4545

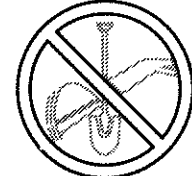

TEXAS ONE CALL SYSTEM



Scale 1" = 40'

LEGEND	
PROPOSED	EXISTING
500 - PROPOSED CONTOURS	AP = ANCHOR
515.00 - SPOT ELEVATION AT FINISHED GRADE	WM = WATER METER
514.00 - INDICATES TOP OF STRUCTURE	WV = WATER VALVE
513.50 - INDICATES FLOW LINE ELEVATION	IC = IRRIGATION CONTROL VALVE
W - PROPOSED WATER LINE	TP = TELEPHONE PEDESTAL
SS - PROPOSED SANITARY SEWER LINE	GM = GAS METER
SD - PROPOSED STORM DRAIN LINE	LP = LIGHT POLE
PC - PROPOSED CONDUIT	BL = BUILDING LINE
CG - PROPOSED GAS	UE = UTILITY EASEMENT
CS - CONCRETE CURB PER CITY STD	DUE = DRAINAGE & UTILITY EASEMENT
1 - WATER SERVICE TAP NO	FGC = FIBER OPTIC CABLE MARKER
	GAS = GAS SIGN
	SSSB = SUB SURFACE SERVICE BOX
	TS = TRAFFIC SIGN
	TR = TRAFFIC SIGNAL
	U.E. = UTILITY EASEMENT
	GS = GAS STUB
	ST = GAS TEST STATION
	B.C.S. = BURIED CABLE SIGN

GENERAL NOTES:

- BOUNDARY/TOPO SURVEY PROVIDED BY:
STOVALL & ASSOCIATES LAND SURVEYING
6417 WESLEY STREET
GREENVILLE, TEXAS 75402
903-450-1120

NOTE:
CONTRACTOR TO VERIFY HORIZONTAL & VERTICAL LOCATION OF ALL EXISTING UTILITIES PRIOR TO BEGINNING ANY CONSTRUCTION/EXCAVATION AND NOTIFY THE ENGINEER OF ANY DISCREPANCIES. EXISTING UTILITIES SHOWN ON THESE PLANS ARE BASED ON COMBINATION OF FIELD SURVEY & CITY RECORD DRAWINGS.

NOTES:

- ALL FILL TO BE COMPACTED TO 95% STANDARD DENSITY USING A SHEEP'S FOOT ROLLER.
- NO PAVING IS ALLOWED UNTIL ALL DETENTION SYSTEMS ARE INSTALLED AND FUNCTIONING PER APPROVED PLANS. IF DETENTION IS ABOVE GROUND THE SIDES AND BOTTOM ARE TO BE ANCHORED WITH SEEDED CURLEX PRIOR TO PAVING.


ADA BARRIER-FREE RAMP REQUIREMENTS:

- TEXTURE: SHALL CONSIST OF EXPOSED CRUSHED STONE AGGREGATE, ROUGHENED CONCRETE, RUBBER, RAISED ABRASIVE STRIPS, OR TRUNCATED DOMES (SEE T&S/ADS STDS FOR ADDITIONAL OPTIONS). SURFACE MUST BE DETECTABLE UNDER FOOT. SURFACES THAT ARE RAISED OR ETCHED IN A WAY THAT WOULD ALLOW WATER TO ACCUMULATE ARE PROHIBITED.
- CONTRAST: FOR PURPOSES OF WARNING, THE FULL WIDTH AND DEPTH OF CURB RAMPS SHALL HAVE A LIGHT REFLECTIVE VALUE AND TEXTURE THAT SIGNIFICANTLY CONTRASTS WITH THAT OF ADJOINING PEDESTRIAN ROUTES.
- RAMPS WITHIN THE CITY RIGHT OF WAY SHALL BE CONSTRUCTED PER CITY STD. TRUNCATED DOME PLATES (COLONIAL OR BRICK RED) AT PLATFORM BOARDING EDGES SHALL BE A MIN OF 24" WIDE AND SHALL EXTEND THE FULL LENGTH OF THE PUBLIC USE AREA OF THE PLATFORM.

ADA/TAS SLOPE REQUIREMENTS	
ACCESSIBLE ROUTE	<5% SLOPE <2% CROSS SLOPE
RAMP & CURB RAMP	<8.33% (1:12) <2% CROSS SLOPE
TAS PARKING & ACCESSIBLE	<2% SLOPE IN ANY DIRECTION

CONTRACTOR TO ENSURE THAT GRADES ALONG ADA ROUTES MEET THESE SLOPE REQUIREMENTS

NOTE:
PARKING & ACCESSIBLE ROUTES FOR DISABLED PERSONS SHALL BE DESIGNATED, DESIGNED & CONSTRUCTED PER CITY, T&S & ADA REQUIREMENTS

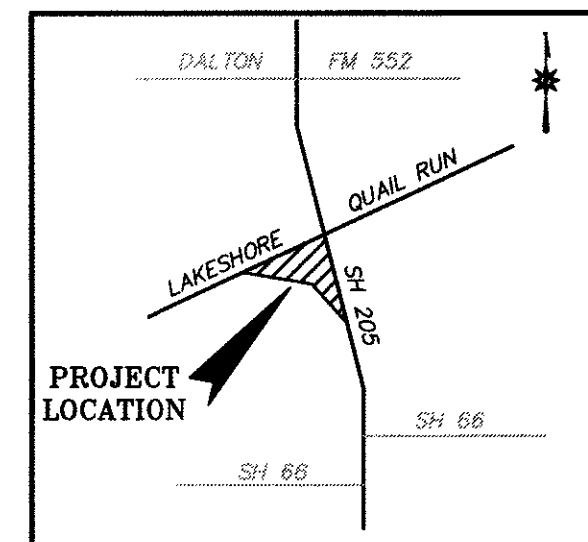


VICINITY MAP

- NOTES:**
- OFFSITE BENCHMARK - STEEL ROD W/ACCESS CAP STAMPED IN 1495 1986 @ THE INTERSECTION OF THE NORTH LINE OF AIRPORT ROAD WITH THE WEST LINE OF THE AIRPORT ACCESS ROAD. ELEVATION = 566.70' (VERTICAL DATUM: NAVD 1988)
 - BM#1 = 1/2" IRON ROD WITH CAP STAMPED "STOVALL TRAVERS" LOCATED AT THE INTERSECTION OF THE SOUTH LINE OF LAKESHORE DRIVE WITH THE WEST LINE OF STATE HIGHWAY NO. 205. ELEVATION = 470.75'
 - BM#2 = "X" CUT ON TOP OF INLET IN THE NORTH LINE OF PECAN VALLEY DRIVE @ 504' WEST OF STATE HIGHWAY NO. 205. ELEVATION = 468.31'

Note: Copyright © Hickman Consulting Engineers, Inc. All rights reserved. No part of this drawing may be reproduced by photocopying, recording or by any other means, or stored, processed or transmitted in or by any computer or other systems without the prior written permission of Hickman Consulting Engineers, Inc. Copies of this plan without an original signature and seal are not valid.

Hickman Consulting Engineers, Inc.
3084 County Road 1024
Farmersburg, Texas 75442
(972) 776-0949
mark@hickman-engineers.com
marktrudick@gmail.com
Planners
Engineers

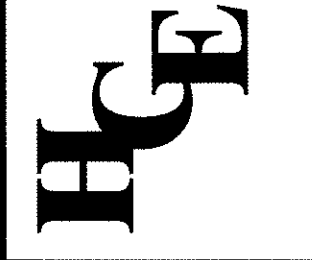

GRADING PLAN
LAKESHORE COMMONS
LOTS 1 - 4; LAKESHORE COMMONS
ROCKWALL, ROCKWALL COUNTY, TEXAS
MOORE WORTH INVESTMENTS, LLC
8445 FREEMONT PARKWAY, SUITE 175
IRVING, TX 75063
214-415-9993

SCALE: 1" = 40'
DATE: MAY 2016
DRAWN BY: FP
CHK'D BY: MHH
JOB NO.: 1501-357
FILE: 15-1501357-LWD
DATE SUBMITTED: 03/22/17 (F)


Hickman Consulting Engineers, Inc.
MARK H. HICKMAN
78409
REGISTERED PROFESSIONAL ENGINEER
No. 11181
F-12172

NO.	DATE	DESCRIPTION


SHEET
C-3

RECORD DRAWING

THIS RECORD DRAWING HAS BEEN PREPARED BASED ON INFORMATION PROVIDED BY OTHERS. THE ENGINEER HAS NOT VERIFIED THE ACCURACY OF THIS INFORMATION AND SHALL NOT BE RESPONSIBLE FOR ANY DISCREPANCIES WHICH MAY BE INCORPORATED HEREIN AS A RESULT.

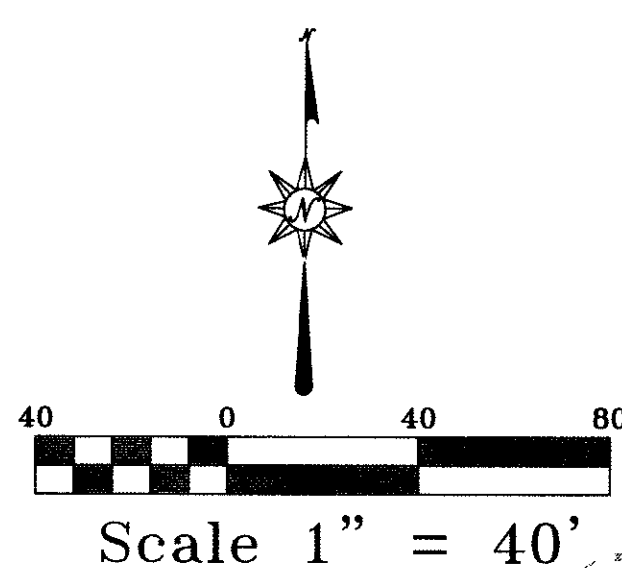

BEFORE YOU DIG CALL:
1-800-245-4545

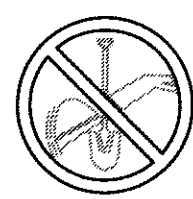

TEXAS ONE CALL SYSTEM

NOTES:

1 BOUNDARY/TOPO SURVEY PROVIDED BY:
STOVALL & ASSOCIATES LAND SURVEYING
6417 WESLEY STREET
GREENVILLE, TEXAS 75402
903-450-1120


PROPOSED		EXISTING	
500	PROPOSED CONTOURS	⊗	POWER POLE
515.00	SPOT ELEVATION AT FINISHED GRADE	⊕	ANCHOR
514.00	INDICATES TOP OF STRUCTURE	⊗	WATER METER
513.50	INDICATES FLOW LINE ELEVATION	⊗	WATER VALVE
⊗	PROPOSED WATER LINE	⊗	IRRIGATION CONTROL VALVE
⊗	PROPOSED SANITARY SEWER LINE	⊗	TELEPHONE PEDESTAL
⊗	PROPOSED STORM DRAIN LINE	⊗	GAS METER
⊗	PROPOSED CONDUIT	⊗	MAILBOX
⊗	PROPOSED GAS	⊗	LIGHT POLE
⊗	CONCRETE CURB PER CITY STD	⊗	FIRE HYDRANT
⊗	WATER SERVICE TAP NO	⊗	BUILDING LINE
		⊗	UTILITY BASEMENT
		⊗	DUE = DRAINAGE & UTILITY BASEMENT
		⊗	FCC = FIBER OPTIC CABLE MARKER
		⊗	GAS = GAS SIGN
		⊗	SSSB = SUB SURFACE SERVICE BOX
		⊗	T = TRAFFIC SIGN
		⊗	U.E. = UTILITY BASEMENT
		⊗	G = GAS STUB
		⊗	G = GAS TEST STATION
		⊗	B.C.S. = BURIED CABLE SIGN

NOTES:

1 BOUNDARY/TOPO SURVEY PROVIDED BY:
STOVALL & ASSOCIATES LAND SURVEYING
6417 WESLEY STREET
GREENVILLE, TEXAS 75402
903-450-1120

KEY:

DRAINAGE AREA NO (X)

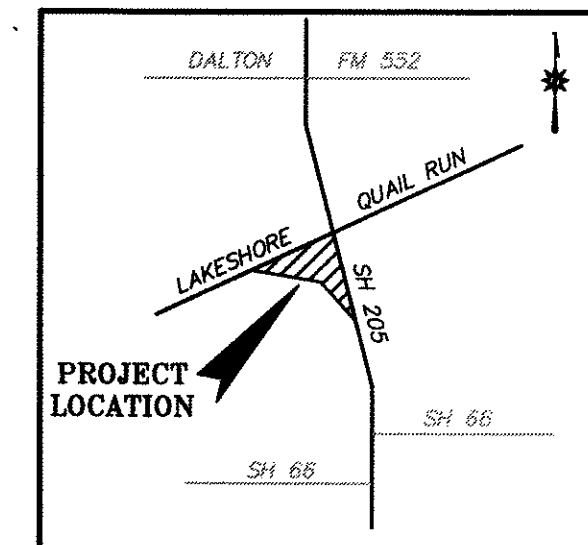

VICINITY MAP

NOTES:
2) OPPOSITE BENCHMARK - STEEL ROD W/ACCESS CAP STAMPED N 1496 1998 @ THE INTERSECTION OF THE NORTH LINE OF AIRPORT ROAD WITH THE WEST LINE OF THE AIRPORT ACCESS ROAD. ELEVATION = 468.70' (VERTICAL DATUM: NAD 1988)
BM#1 = 1/2" IRON ROD WITH CAP STAMPED "STOVALL TRAVELER" LOCATED AT THE INTERSECTION OF THE SOUTH LINE OF LAKESHORE DRIVE WITH THE WEST LINE OF STATE HIGHWAY NO. 205. ELEVATION = 475.70'
BM#2 = 1" CIP ON TOP OF INLET IN THE NORTH LINE OF PECAN VALLEY DRIVE S 66' WEST OF STATE HIGHWAY NO. 205. ELEVATION = 468.31'

NOTE:
CONTRACTOR TO VERIFY HORIZONTAL & VERTICAL LOCATION OF ALL EXISTING UTILITIES PRIOR TO BEGINNING ANY CONSTRUCTION/EXCAVATION AND NOTIFY THE ENGINEER OF ANY DISCREPANCIES. EXISTING UTILITIES SHOWN ON THESE PLANS ARE BASED ON COMBINATION OF FIELD SURVEY & CITY RECORD DRAWINGS.

PROPOSED WEIGHTED "C" FACTOR				
AREA	A acres	C runoff coefficient	% OF OVERALL SITE	TOTAL WEIGHTED C
1-4	5.32*			
IMPERVIOUS	0.84	1.00	16	0.16
PERVIOUS	4.48	0.35	84	0.29
* INCLUDES OFF-SITE AREAS 3A & 6a				

PROPOSED DRAINAGE AREA CHART - POND A, B & UDS						
AREA	C runoff coefficient	A acres	Q ₁₀₀ cfs	CONVEYANCE	REMARKS	OUTFALL
1	0.46	9.80	0.80	3.61	TO STR #1-DROP INLET	TO POND A
2	0.46	9.80	0.57	2.57	TO STR #2-DROP INLET	TO POND A
3	0.46	9.80	1.22	5.50	TO STR #5-DROP INLET	TO POND B
3a	0.90	9.80	0.09	0.79	TO STR #5-DROP INLET	TO POND B
4	0.46	9.80	0.59	2.66	TO STR #4-DROP INLET	TO UDS LOT 3 & 4*
5	0.46	9.80	0.99	4.46	TO STR #6-DROP INLET	TO UDS LOT 3 & 4*
5a	0.90	9.80	0.61	5.38	TO STR #6-DROP INLET	TO UDS LOT 3 & 4*
6	0.46	9.80	0.16	0.72	SHEET FLOW	BYPASS UDS LOT 3 & 4
7	0.46	9.80	0.02	0.09	SHEET FLOW	REMAIN NATURAL/FLOODPLAIN
8	0.46	9.80	0.14	0.63	SHEET FLOW	REMAIN NATURAL/FLOODPLAIN
9	0.46	9.80	0.08	0.36	SHEET FLOW	BYPASS POND A


FUTURE DRAINAGE AREA CHART - STORM SEWER DESIGN						
AREA	C runoff coefficient	A acres	Q ₁₀₀ cfs	CONVEYANCE	REMARKS	OUTFALL
1	0.90	9.80	0.80	7.06	TO FUTURE CURB INLET	TO FUTURE UDS LOT 1
2	0.90	9.80	0.57	5.03	TO FUTURE CURB INLET	TO FUTURE UDS LOT 1
3	0.90	9.80	1.22	10.76	TO FUTURE CURB INLET	TO FUTURE UDS LOT 2
3a	0.90	9.80	0.09	0.79	TO FUTURE CURB INLET	TO FUTURE UDS LOT 2
4	0.90	9.80	0.59	5.21	TO FUTURE CURB INLET	TO FUTURE UDS LOT 2 & EX UDS LOT 3 & 4
5	0.90	9.80	0.99	8.73	TO FUTURE CURB INLET	TO FUTURE UDS LOT 2 & EX UDS LOT 3 & 4
5a	0.90	9.80	0.61	5.38	TO FUTURE CURB INLET	TO FUTURE UDS LOT 2 & EX UDS LOT 3 & 4
6	0.30	9.80	0.16	1.41	SHEET FLOW	BYPASS EX UDS LOT 3 & 4
7	0.90	9.80	0.02	0.18	SHEET FLOW	REMAIN NATURAL/FLOODPLAIN
8	0.90	9.80	0.14	1.23	SHEET FLOW	REMAIN NATURAL/FLOODPLAIN
9	0.90	9.80	0.08	0.70	SHEET FLOW	BYPASS FUTURE UDS LOT 1

Note: Copyright © Hickman Consulting Engineers, Inc. All rights reserved. No part of this drawing may be reproduced by photocopying, recording or by any other means, or stored, processed or transmitted in or by any computer or other systems without the prior written permission of Hickman Consulting Engineers, Inc. Copies of this plan without an original signature and seal are not valid.

RECORD DRAWING


THIS RECORD DRAWING HAS BEEN PREPARED BASED ON INFORMATION PROVIDED BY OTHERS. THE ENGINEER HAS NOT VERIFIED THE ACCURACY OF THIS INFORMATION AND SHALL NOT BE RESPONSIBLE FOR ANY DISCREPANCIES WHICH MAY BE INCORPORATED HEREIN AS A RESULT.

Hickman Consulting Engineers, Inc.
3094 County Road 1024
Farmersville, Texas 75442
Ph (972)764-2499
markredhick@gmail.com
Engineers
Planners

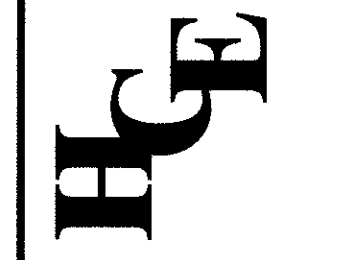

DRAINAGE PLAN
LAKESHORE COMMONS
LOTS 1 - 4; LAKESHORE COMMONS
ROCKWALL, ROCKWALL COUNTY, TEXAS
MOORE WORTH INVESTMENTS, LLC
8445 FREEMONT PARKWAY, SUITE 175
IRVING, TX 75063
214-415-9983


SCALE: 1"=40'
DATE: MAY2016
DRAWN BY: FP
CHK'D BY: MHH
JOB NO: 1501-357
FILE#148-1501357-LOW
DATE SUBMITTED: 03/22/17(F)

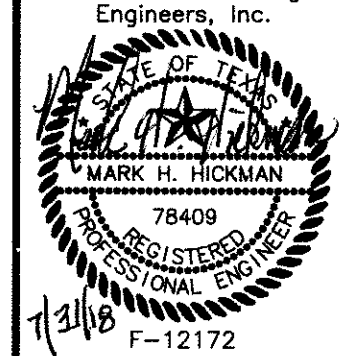


REVISION	DATE	DESCRIPTION

SHEET
C-4

BEFORE YOU DIG CALL:
1-800-245-4545

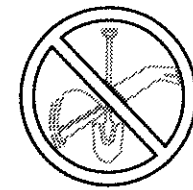


TEXAS ONE CALL SYSTEM

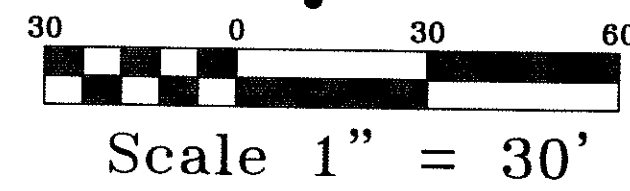

NOTES:

1 BOUNDARY/TOPO SURVEY PROVIDED BY:
STOVALL & ASSOCIATES LAND SURVEYING
6417 WESLEY STREET
GREENVILLE, TEXAS 75402
903-450-1120

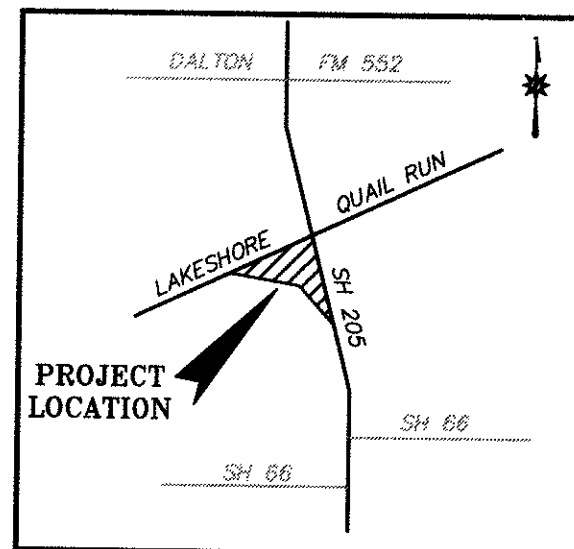

VICINITY MAP

FUTURE DRAINAGE AREA CHART - LOTS 3 & 4						
AREA	C	I ₁₀₀	A	Q ₁₀₀	CONVEYANCE	OUTFALL
	runoff coefficient	rainfall intensity	acres	cfs		
F1	0.90	9.80	1.55	12.70	TO UDS	TO CREEK
F1a	0.90	9.80	0.61	5.38	TO UDS	TO CREEK
F2	0.90	9.80	0.09	0.79	SHEET FLOW TO NORTHWEST	TO CREEK
F3	0.90	9.80	0.16	1.41	SHEET FLOW TO SOUTH	TO CREEK
						TO POND A
						BYPASS UDS

Tc = 10 min
UDS - UNDERGROUND DETENTION SYSTEM


NOTES

2) OPPOSITE BENCHMARK - STEEL ROD W/ACCESS CAP STAMPED N 1495 1986 @ THE INTERSECTION OF THE NORTH LINE OF AIRPORT ROAD WITH THE WEST LINE OF THE AIRPORT ACCESS ROAD.
ELEVATION = 566.70' (VERTICAL DATUM: NAVD 1988)

BM#1 = 1/2" IRON ROD WITH CAP STAMPED "STOVALL TRAVERS" LOCATED AT THE INTERSECTION OF THE SOUTH LINE OF LAKESHORE DRIVE WITH THE WEST LINE OF STATE HIGHWAY NO. 206.
ELEVATION = 476.75'

BM#2 = "X" CITE ON TOP OF INLET IN THE NORTH LINE OF PECAN VALLEY DRIVE ± 564' WEST OF STATE HIGHWAY NO. 206.
ELEVATION = 468.31'

Note: Copyright © Hickman Consulting Engineers, Inc. All rights reserved. No part of this drawing may be reproduced by photocopying, recording or by any other means, or stored, processed or transmitted in or by any computer or other systems without the prior written permission of Hickman Consulting Engineers, Inc. Copies of this plan without an original signature and seal are not valid.

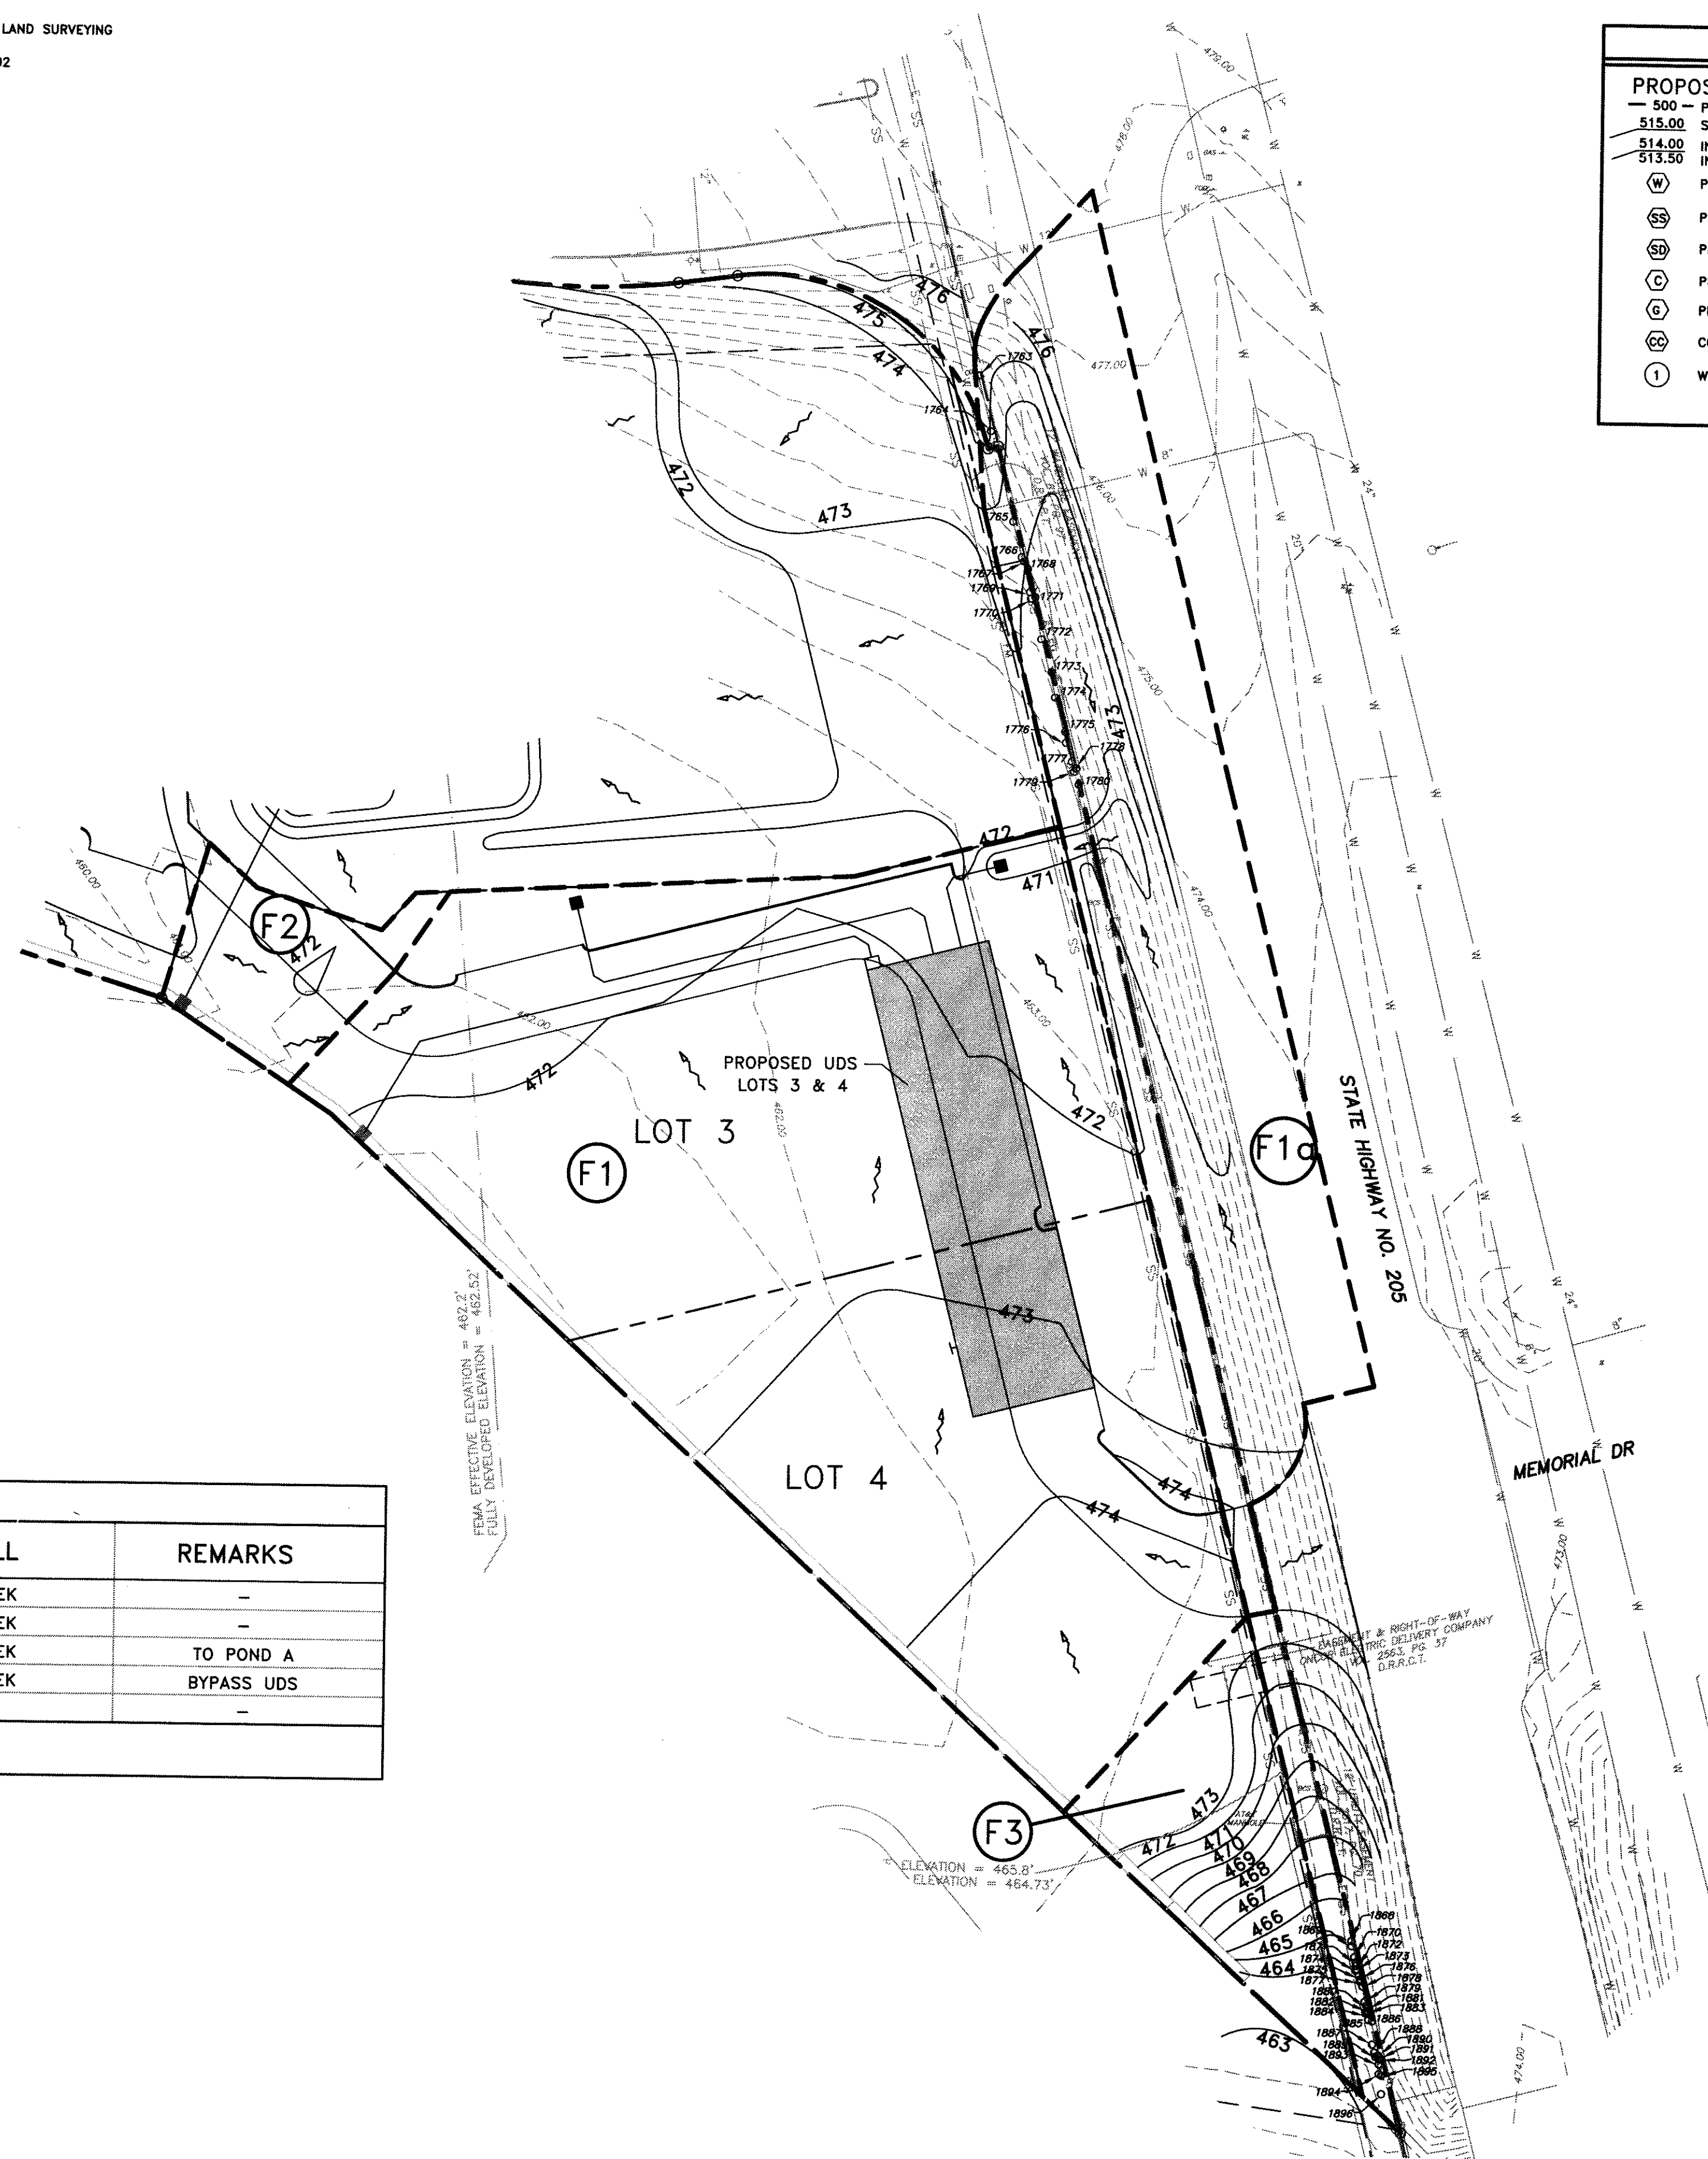

LEGEND	
PROPOSED	EXISTING
500 - PROPOSED CONTOURS	POWER POLE
515.00 - SPOT ELEVATION AT FINISHED GRADE	ANCHOR
514.00 - INDICATES TOP OF STRUCTURE	WATER METER
513.50 - INDICATES FLOW LINE ELEVATION	WATER VALVE
(W) - PROPOSED WATER LINE	IRRIGATION CONTROL VALVE
(SS) - PROPOSED SANITARY SEWER LINE	TELEPHONE PEDESTAL
(SD) - PROPOSED STORM DRAIN LINE	GAS METER
(C) - PROPOSED CONDUIT	MAILBOX
(G) - PROPOSED GAS	LIGHT POLE
(CC) - CONCRETE CURB PER CITY STD	FIRE HYDRANT
(1) - WATER SERVICE TAP NO	BL - BUILDING LINE
	UR - UTILITY EASEMENT
	DUE - DRAINAGE & UTILITY EASEMENT
	FCC - FIBER OPTIC CABLE MARKER
	GAS - GAS SIGN
	SSSB - SUB SURFACE SERVICE BOX
	T - TRAFFIC SIGN
	T - TRAFFIC SIGNAL
	U.E. - UTILITY EASEMENT
	GAS STUB
	GAS TEST STATION
	B.C.S. - BURIED CABLE SIGN

NOTES:

1 BOUNDARY/TOPO SURVEY PROVIDED BY:
STOVALL & ASSOCIATES LAND SURVEYING
6417 WESLEY STREET
GREENVILLE, TEXAS 75402
903-450-1120

NOTE:
CONTRACTOR TO VERIFY HORIZONTAL & VERTICAL LOCATION OF ALL EXISTING UTILITIES PRIOR TO BEGINNING ANY CONSTRUCTION/EXCAVATION AND NOTIFY THE ENGINEER OF ANY DISCREPANCIES EXISTING UTILITIES SHOWN ON THESE PLANS ARE BASED ON COMBINATION OF FIELD SURVEY & CITY RECORD DRAWINGS

KEY:
DRAINAGE AREA NO (X)

FOR UDS DESIGN LOTS 3 & 4 - CALC BASED ON FUTURE DEVELOPMENT

RECORD DRAWING

THIS RECORD DRAWING HAS BEEN PREPARED BASED ON INFORMATION PROVIDED BY OTHERS. THE ENGINEER HAS NOT VERIFIED THE ACCURACY OF THIS INFORMATION AND SHALL NOT BE RESPONSIBLE FOR ANY DISCREPANCIES WHICH MAY BE INCORPORATED HEREIN AS A RESULT.

Hickman Consulting Engineers, Inc.
3094 County Road 1024
Farmersville, Texas 75442
Ph. (972)784-2489
markrednick@gmail.com
Engineers

HCE

UDS DRAINAGE AREA MAP
LAKESHORE COMMONS
LOTS 1 - 4; LAKESHORE COMMONS
ROCKWALL, ROCKWALL COUNTY, TEXAS
MOORE NORTH INVESTMENTS, LLC
8445 FREEPORT PARKWAY, SUITE 175
IRVING, TX 75063
214-415-9993

SCALE: 1"=30'
DATE: MAY/2016
DRAWN BY: FP
CHK'D BY: MHH
JOB NO: 1501-357
FILE# 165-1901357-1000
DATE SUBMITTED: 03/22/17/10

Hickman Consulting Engineers, Inc.
78409
REGISTERED PROFESSIONAL ENGINEER
F-12172

REVISION	DATE	BY	DESCRIPTION

SHEET
C-5

5 YEAR STORM

AREA	ACRE	C	Tc	I _h	Q _h
PRE-DEV (AREAS 1, 2 & 9)	1.46	0.35	20	4.9	2.49
POST-DEV (AREA 2 & 9 BY-PASS)	0.65	0.46	10	6.1	1.82

Allowable Q from Pond = Q_h - Q_{by Pass} = Q_{Storage}
 Allowable Q from Pond = 2.49 - 1.82 = 0.67 cfs


A = 1.45 ACRES			
DURATION	I _h	CA	Q _h
10	6.1	0.67	4.09
20	4.9	0.67	3.28
30	4.1	0.67	2.75
40	3.4	0.67	2.28
50	2.8	0.67	1.88
60	2.6	0.67	1.74
70	2.4	0.67	1.61
80	2.3	0.67	1.54

POND VOLUME CALCULATIONS - 5 YEAR STORM		
10	10 * 4.09 * 60 = 2454	0.50 * 20 * 0.67 * 60 = 402
		2052 ft. ³
20	20 * 3.28 * 60 = 3936	0.50 * 30 * 0.67 * 60 = 603
		3333 ft. ³
30	30 * 2.75 * 60 = 4950	0.50 * 40 * 0.67 * 60 = 804
		4146 ft. ³
40	40 * 2.28 * 60 = 5472	0.50 * 50 * 0.67 * 60 = 1005
		4467 ft. ³
50	50 * 1.88 * 60 = 5640	0.50 * 60 * 0.67 * 60 = 1206
		4434 ft. ³


PEAK STORM = 40 MIN.
 REQUIRED STORAGE = 4467 ft.³

ELEVATION @ 4467 ft.³ = 467.11

5 YEAR WEIR CALCULATIONS

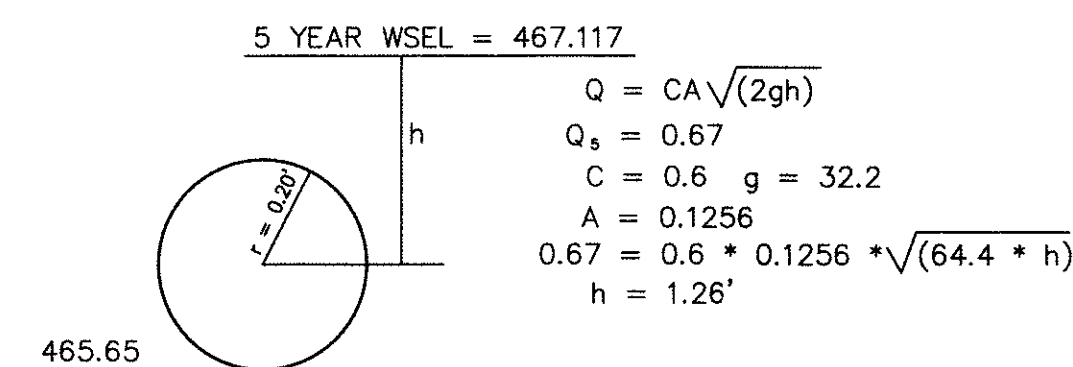

10 YEAR WEIR CALCULATIONS

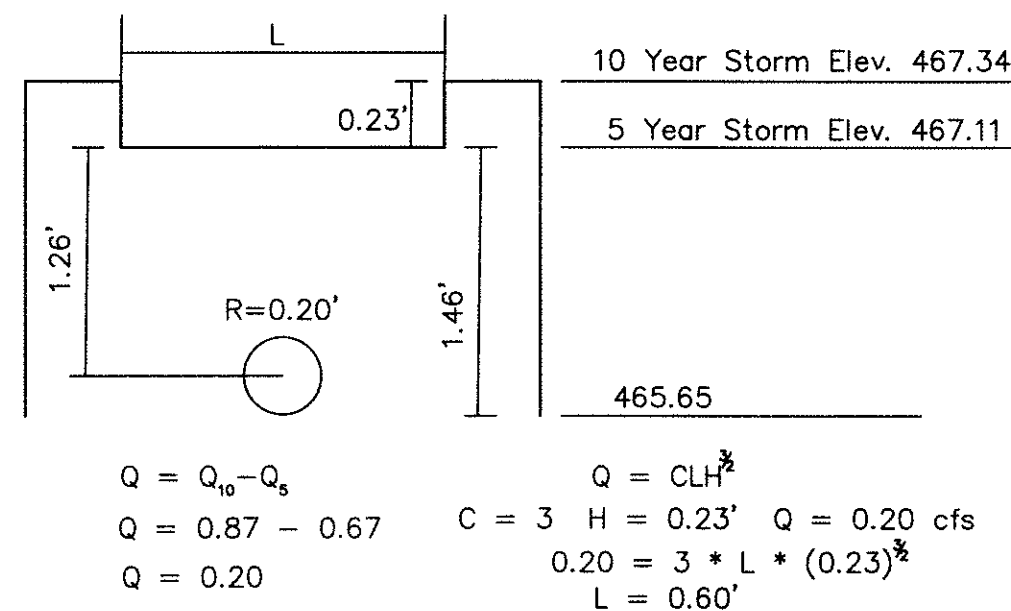

10 YEAR STORM

AREA	ACRE	C	Tc	I _h	Q _h
PRE-DEV (AREAS 1, 2 & 9)	1.45	0.35	20	5.9	2.99
POST-DEV (AREA 2 & 9 BY-PASS)	0.65	0.46	10	7.1	2.12

Allowable Q from Pond = Q_h - Q_{by Pass} = Q_{Storage}
 Allowable Q from Pond = 2.99 - 2.12 = 0.87 cfs


A = 1.45 ACRES			
DURATION	I _h	CA	Q _h
10	7.1	0.67	4.78
20	5.9	0.67	3.95
30	4.8	0.67	3.22
40	4.0	0.67	2.68
50	3.5	0.67	2.35
60	3.0	0.67	2.01
70	2.8	0.67	1.88
80	2.6	0.67	1.74

POND VOLUME CALCULATIONS - 10 YEAR STORM		
10	10 * 4.78 * 60 = 2868	0.50 * 20 * 0.87 * 60 = 522
		2346 ft. ³
20	20 * 3.95 * 60 = 4740	0.50 * 30 * 0.87 * 60 = 783
		3957 ft. ³
30	30 * 3.22 * 60 = 5796	0.50 * 40 * 0.87 * 60 = 1044
		4752 ft. ³
40	40 * 2.68 * 60 = 6432	0.50 * 50 * 0.87 * 60 = 1305
		5127 ft. ³
50	50 * 2.35 * 60 = 7050	0.50 * 60 * 0.87 * 60 = 1566
		5484 ft. ³
60	60 * 2.01 * 60 = 7236	0.50 * 70 * 0.87 * 60 = 1827
		5409 ft. ³

PEAK STORM = 50 MIN.
 REQUIRED STORAGE = 5484 ft.³

ELEVATION @ 5484 ft.³ = 467.34

100 YEAR ORIFICE CALCULATIONS

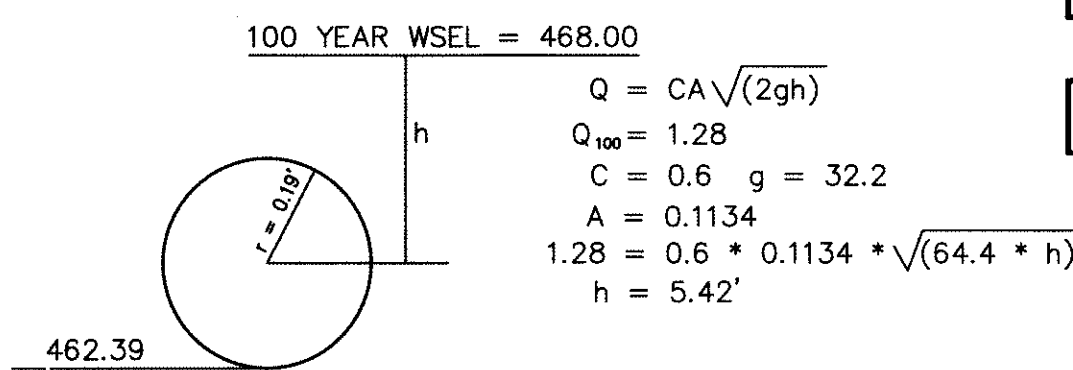

25 YEAR STORM

AREA	ACRE	C	Tc	I _h	Q _h
PRE-DEV (AREAS 1, 2 & 9)	1.45	0.35	20	7.5	3.35
POST-DEV (AREA 2 & 9 BY-PASS)	0.65	0.46	10	8.3	2.48

Allowable Q from Pond = Q_h - Q_{by Pass} = Q_{Storage}
 Allowable Q from Pond = 3.35 - 2.48 = 0.87 cfs


A = 1.45 ACRES			
DURATION	I _h	CA	Q _h
10	8.3	0.67	5.58
20	6.6	0.67	4.42
30	5.5	0.67	3.69
40	4.6	0.67	3.08
50	4.0	0.67	2.68
60	3.5	0.67	2.35
70	3.3	0.67	2.21
80	3.1	0.67	2.08
90	2.9	0.67	1.94
100	2.7	0.67	1.81
110	2.5	0.67	1.68

POND VOLUME CALCULATIONS - 25 YEAR STORM		
10	10 * 5.58 * 60 = 3348	0.50 * 20 * 0.87 * 60 = 522
		2826 ft. ³
20	20 * 4.42 * 60 = 5304	0.50 * 30 * 0.87 * 60 = 783
		4521 ft. ³
30	30 * 3.69 * 60 = 6642	0.50 * 40 * 0.87 * 60 = 1044
		5598 ft. ³
40	40 * 3.08 * 60 = 7392	0.50 * 50 * 0.87 * 60 = 1305
		6087 ft. ³
50	50 * 2.68 * 60 = 8040	0.50 * 60 * 0.87 * 60 = 1566
		6474 ft. ³
60	60 * 2.35 * 60 = 8460	0.50 * 70 * 0.87 * 60 = 1827
		6633 ft. ³
70	70 * 2.21 * 60 = 9282	0.50 * 80 * 0.87 * 60 = 2088
		7194 ft. ³
80	80 * 2.08 * 60 = 9984	0.50 * 90 * 0.87 * 60 = 2349
		7635 ft. ³
90	90 * 1.94 * 60 = 10,476	0.50 * 100 * 0.87 * 60 = 2610
		7866 ft. ³
100	100 * 1.81 * 60 = 10,860	0.50 * 110 * 0.87 * 60 = 2871
		7989 ft. ³
110	110 * 1.68 * 60 = 11,088	0.50 * 120 * 0.87 * 60 = 3132
		7956 ft. ³

PEAK STORM = 100 MIN.
 REQUIRED STORAGE = 7989 ft.³

ELEVATION @ 7989 ft.³ = 467.90

25 YEAR WEIR CALCULATIONS

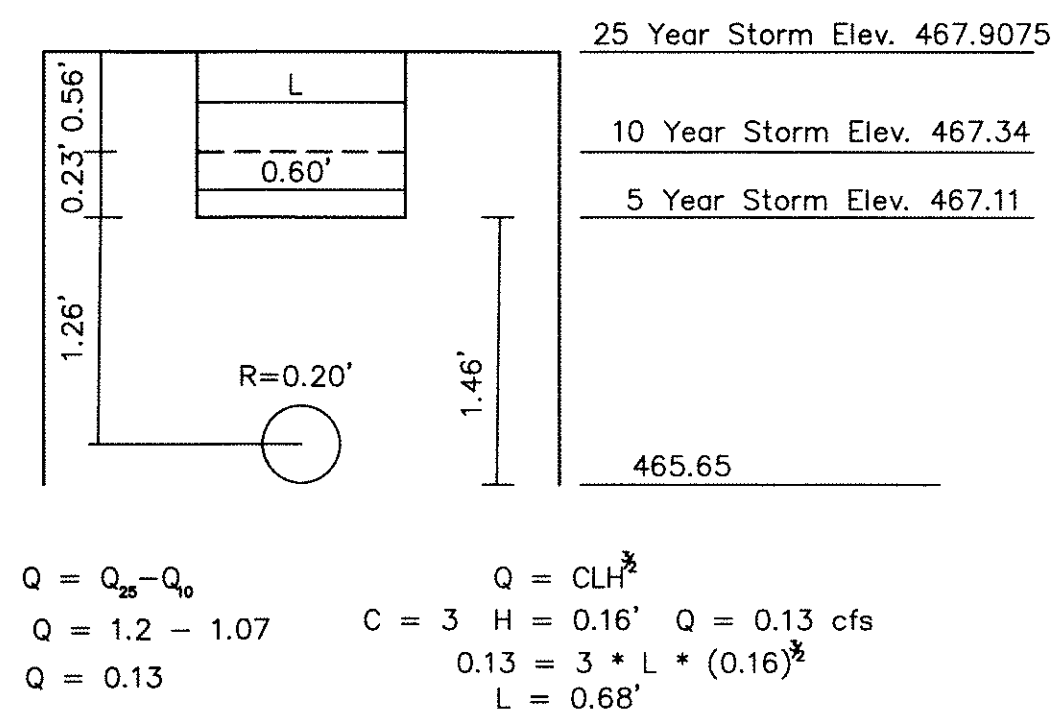

100 YEAR STORM

AREA	ACRE	C	Tc	I _h	Q _h
PRE-DEV (AREAS 1, 2 & 9)	1.45	0.35	20	8.3	4.21
POST-DEV (AREA 2 & 9 BY-PASS)	0.65	0.46	10	9.8	2.93

Allowable Q from Pond = Q_h - Q_{by Pass} = Q_{Storage}
 Allowable Q from Pond = 4.21 - 2.93 = 1.28 cfs

A = 1.45 ACRES			
DURATION	I _h	CA	Q _h
10	9.8	0.67	6.57
20	8.3	0.67	5.57
30	6.9	0.67	4.62
40	5.8	0.67	3.89
50	5.0	0.67	3.35
60	4.5	0.67	3.02
70	4.0	0.67	2.68
80	3.7	0.67	2.48
90	3.4	0.67	2.28
100	3.1	0.67	2.08




POND VOLUME CALCULATIONS - 100 YEAR STORM		
10	10 * 6.57 * 60 = 3942	0.50 * 20 * 1.28 * 60 = 374
		3568 ft. ³
20	20 * 5.57 * 60 = 6672	0.50 * 30 * 1.28 * 60 = 1152
		5520 ft. ³
30	30 * 4.62 * 60 = 8316	0.50 * 40 * 1.28 * 60 = 1536
		6780 ft. ³
40	40 * 3.89 * 60 = 9336	0.50 * 50 * 1.28 * 60 = 1920
		7416 ft. ³
50	50 * 3.35 * 60 = 10,050	0.50 * 60 * 1.28 * 60 = 2304
		7746 ft. ³
60	60 * 3.02 * 60 = 10,872	0.50 * 70 * 1.28 * 60 = 2688
		8184 ft. ³
70	70 * 2.68 * 60 = 11,256	0.50 * 80 * 1.28 * 60 = 3072
		8184 ft. ³
80	80 * 2.48 * 60 = 11,904	0.50 * 90 * 1.28 * 60 = 3456
		8448 ft. ³
90	90 * 2.28 * 60 = 12,312	0.50 * 100 * 1.28 * 60 = 3840
		8472 ft. ³
100	100 * 2.08 * 60 = 12,480	0.50 * 110 * 1.28 * 60 = 4224
		8256 ft. ³

PEAK STORM = 90 MIN.
 REQUIRED STORAGE = 8472 ft.³

ELEVATION @ 8472 ft.³ = 468.00

DETENTION POND STAGE/STORAGE CALCS

ELEV.	AREA (SF)	VOLUME (CF)	CUM. VOL (CF)	NOTES
465.65	0	536	0	BOTTOM
466.0	3064		536	
467.0	3947		3506	
467.11	4055		440	5 YR WSEL
467.34	4282		1399	
467.90	4834		3951	10 YR WSEL
468.0	4932		4440	25 YR WSEL
470.0			8482	100 YR WSEL
				TOP OF POND

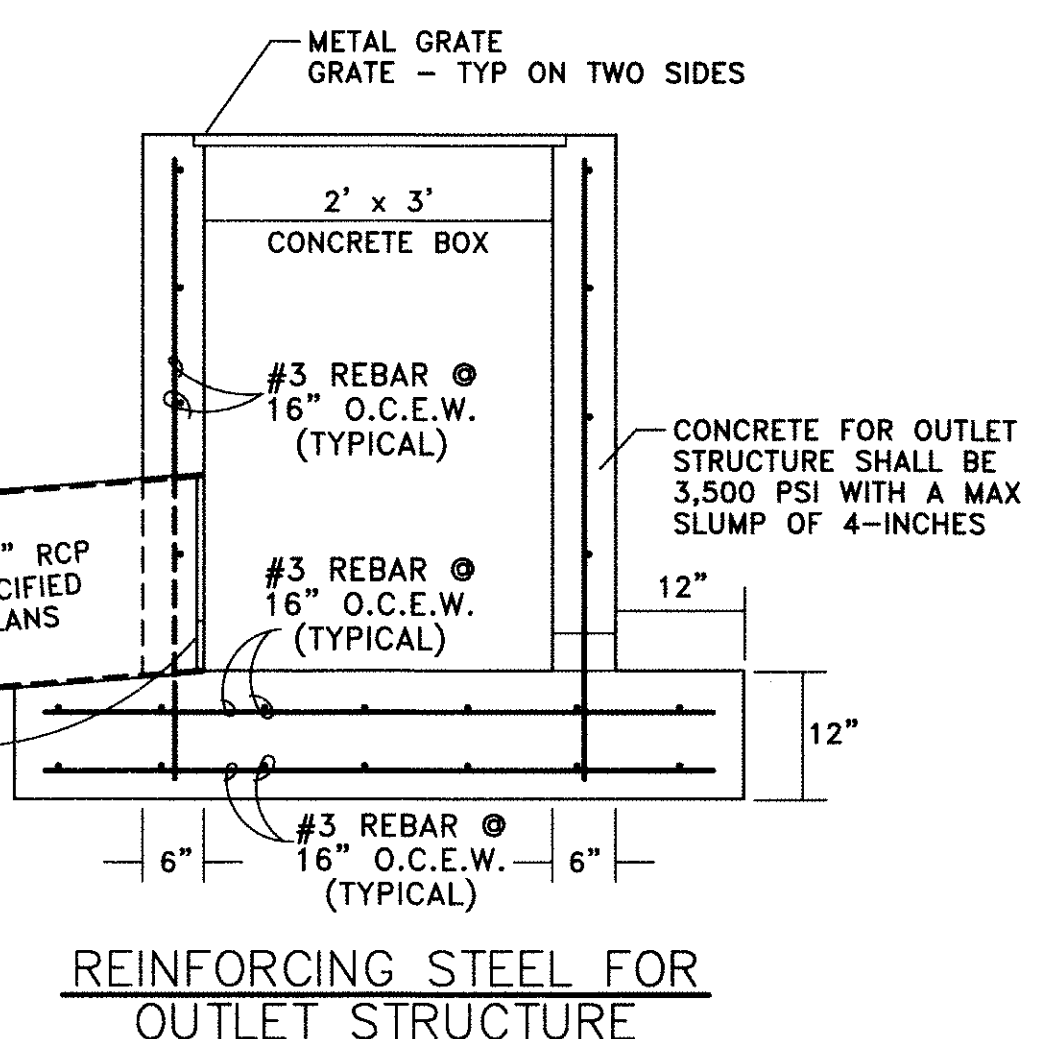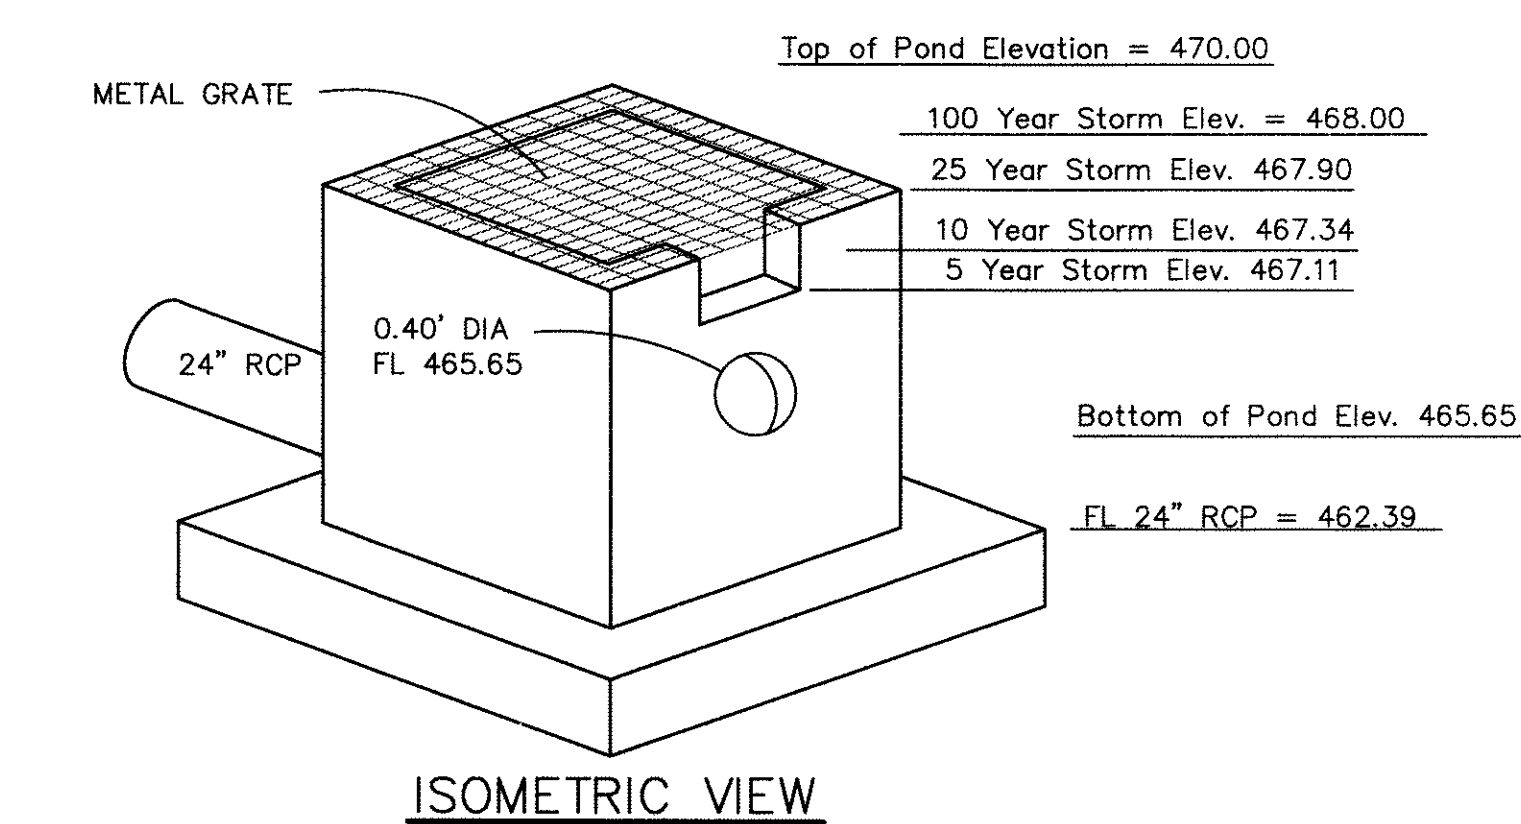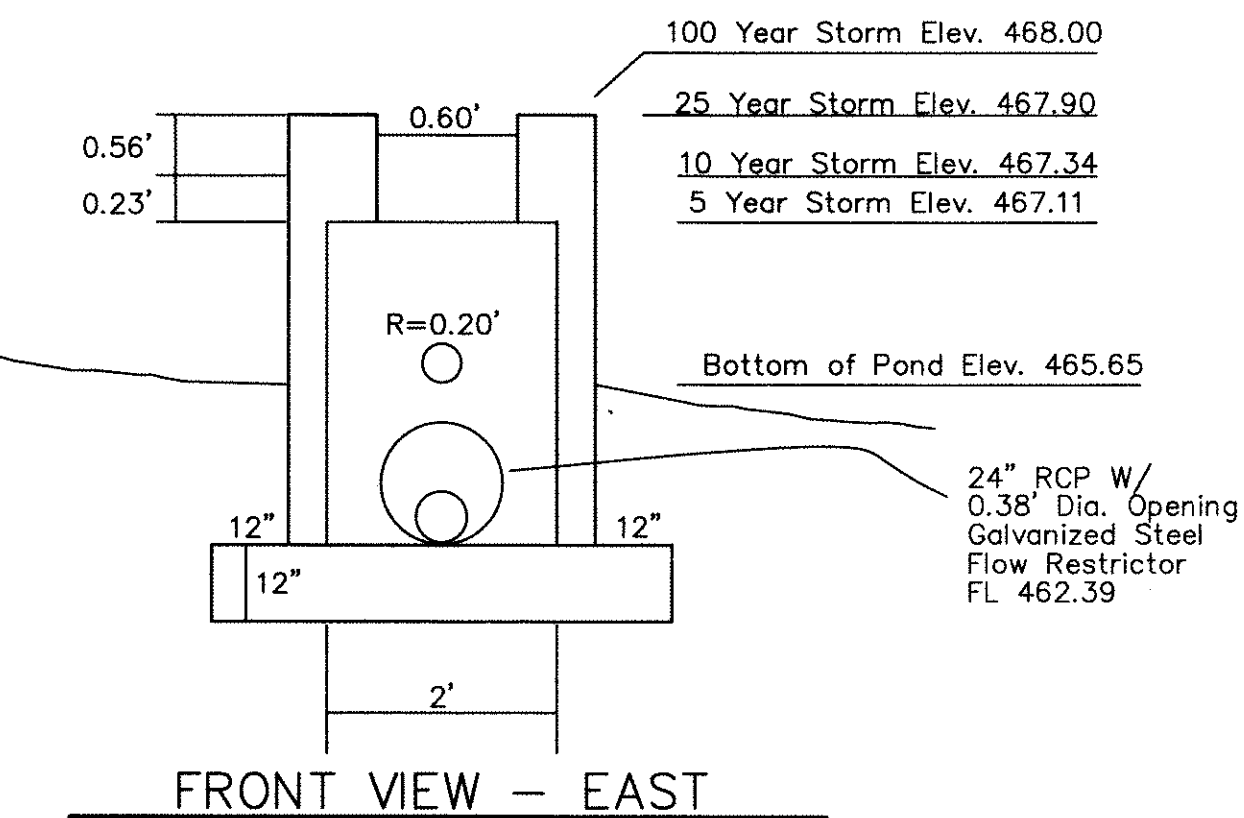

OUTLET STRUCTURE

For Reference Only
 See Details This Sheet For Dimensions

RECORD DRAWING

THIS RECORD DRAWING HAS BEEN PREPARED BASED ON INFORMATION PROVIDED BY OTHERS. THE ENGINEER HAS NOT VERIFIED THE ACCURACY OF THIS INFORMATION AND SHALL NOT BE RESPONSIBLE FOR ANY DISCREPANCIES WHICH MAY BE INCORPORATED HEREIN AS A RESULT.

Hickman Consulting Engineers, Inc.
 3094 County Road 1024
 Farmersville, Texas 75442
 Ph. (817)784-2499
 markredhick@gmail.com
 Engineers

DRAINAGE CALCULATIONS - POND A
 LAKESHORE COMMONS
 LOT 1-4; LAKESHORE COMMONS
 ROCKWALL, ROCKWALL COUNTY, TEXAS
 MOORE WORTH INVESTMENTS, LLC
 8445 FREDERICKS BLVD SUITE 175
 IRVING, TX 75063
 214-415-9993

SCALE: N/A
 DATE: SEPT2016
 DRAWN BY: FP
 CHK'D BY: MHH
 JOB NO: 1501-357
 FILE: 68-180187-Land
 DATE SUBMITTED: 03/22/17(1)
 F-12172

REVISION	DATE	BY	DESCRIPTION

SHEET
 C-6

Note: Copyright © Hickman Consulting Engineers, Inc. All rights reserved. No part of this drawing may be reproduced by photocopying, recording or by any other means, or stored, processed or transmitted in or by any computer or other systems without the prior written permission of Hickman Consulting Engineers, Inc. Copies of this plan without an original signature and seal are not valid.

5 YEAR STORM

AREA	ACRE	C	Tc	I ₁₀	Q ₁₀
PRE-DEV (AREA 3)	1.22	0.35	20	4.9	2.09
POST-DEV (BY-PASS)	N/A	0.46	10	6.1	0
3a (PASS-THRU)	0.09	0.90	10	6.1	0.49

Allowable Q from Pond = Q₁₀ - Q_{By Pass} = Q_{Storage}
 Allowable Q from Pond = 2.09 - 0 = 2.09 cfs

A = 1.22 ACRES				
CA = 0.46 * 1.22 = 0.56				
DURATION	I ₁₀	CA	Q ₁₀	Q ₁₅
10	6.1	0.56	3.42	
20	4.9	0.56	2.74	
30	4.1	0.56	2.30	
40	3.4	0.56	1.90	
50	2.8	0.56	1.57	
60	2.5	0.56	1.46	
70	2.4	0.56	1.34	
80	2.3	0.56	1.29	

POND VOLUME CALCULATIONS - 5 YEAR STORM		
10	10 * 3.42 * 60 = 2052	0.50 * 20 * 2.09 * 60 = 1254
		798 ft ³
20	20 * 2.74 * 60 = 3288	0.50 * 30 * 2.09 * 60 = 1881
		1407 ft ³
30	30 * 2.30 * 60 = 4140	0.50 * 40 * 2.09 * 60 = 2508
		1632 ft ³
40	40 * 1.90 * 60 = 4560	0.50 * 50 * 2.09 * 60 = 3135
		1425 ft ³

PEAK STORM = 30 MIN.
 REQUIRED STORAGE = 1632 ft³

ELEVATION @ 1632 ft³ = 468.95

10 YEAR STORM

AREA	ACRE	C	Tc	I ₁₀	Q ₁₀
PRE-DEV (AREA 3)	1.22	0.35	20	5.9	2.52
POST-DEV (BY-PASS)	N/A	0.46	10	7.1	0
3a (PASS-THRU)	0.09	0.90	10	7.1	0.56

Allowable Q from Pond = Q₁₀ - Q_{By Pass} = Q_{Storage}
 Allowable Q from Pond = 2.52 - 0 = 2.52 cfs

A = 1.22 ACRES				
CA = 0.46 * 1.22 = 0.56				
DURATION	I ₁₀	CA	Q ₁₀	Q ₁₅
10	7.1	0.56	3.98	
20	5.9	0.56	3.30	
30	4.8	0.56	2.69	
40	4.0	0.56	2.24	
50	3.5	0.56	1.96	
60	3.0	0.56	1.68	
70	2.8	0.56	1.57	
80	2.6	0.56	1.46	

POND VOLUME CALCULATIONS - 10 YEAR STORM		
10	10 * 3.98 * 60 = 2388	0.50 * 20 * 2.52 * 60 = 1512
		876 ft ³
20	20 * 3.30 * 60 = 3960	0.50 * 30 * 2.52 * 60 = 2268
		1692 ft ³
30	30 * 2.69 * 60 = 4842	0.50 * 40 * 2.52 * 60 = 3024
		1818 ft ³
40	40 * 2.24 * 60 = 5376	0.50 * 50 * 2.52 * 60 = 3780
		1596 ft ³

PEAK STORM = 30 MIN.
 REQUIRED STORAGE = 1818 ft³

ELEVATION @ 1818 ft³ = 469.08

25 YEAR STORM

AREA	ACRE	C	Tc	I ₁₀	Q ₁₀
PRE-DEV (AREA 3)	0.78	0.35	20	6.6	2.82
POST-DEV (BY-PASS)	N/A	0.46	10	8.3	0
3a (PASS-THRU)	0.09	0.90	10	8.3	0.67

Allowable Q from Pond = Q₁₀ - Q_{By Pass} = Q_{Storage}
 Allowable Q from Pond = 2.82 - 0 = 2.82 cfs

A = 1.22 ACRES				
CA = 0.46 * 1.22 = 0.56				
DURATION	I ₁₀	CA	Q ₁₀	Q ₁₅
10	8.3	0.56	4.65	
20	6.6	0.56	3.70	
30	5.5	0.56	3.08	
40	4.6	0.56	2.58	
50	4.0	0.56	2.24	
60	3.5	0.56	1.96	
70	3.3	0.56	1.85	
80	3.1	0.56	1.74	

POND VOLUME CALCULATIONS - 25 YEAR STORM		
10	10 * 4.65 * 60 = 2790	0.50 * 20 * 2.82 * 60 = 1692
		1098 ft ³
20	20 * 3.70 * 60 = 4440	0.50 * 30 * 2.82 * 60 = 2538
		1902 ft ³
30	30 * 3.08 * 60 = 5544	0.50 * 40 * 2.82 * 60 = 3384
		2160 ft ³
40	40 * 2.58 * 60 = 6192	0.50 * 50 * 2.82 * 60 = 3780
		1962 ft ³

PEAK STORM = 30 MIN.
 REQUIRED STORAGE = 2160 ft³

ELEVATION @ 2160 ft³ = 469.30

100 YEAR STORM

AREA	ACRE	C	Tc	I ₁₀	Q ₁₀
PRE-DEV (AREA 3)	1.22	0.35	15	8.3	3.54
POST-DEV (BY-PASS)	N/A	0.46	10	9.8	0
3a (PASS-THRU)	0.09	0.90	10	9.8	0.79

Allowable Q from Pond = Q₁₀ - Q_{By Pass} = Q_{Storage}
 Allowable Q from Pond = 3.54 - 0 = 3.54 cfs

A = 1.22 ACRES				
CA = 0.46 * 1.22 = 0.56				
DURATION	I ₁₀	CA	Q ₁₀	Q ₁₅
10	9.8	0.56	5.50	
20	8.3	0.56	4.65	
30	6.9	0.56	3.86	
40	5.8	0.56	3.25	
50	5.0	0.56	2.8	
60	4.5	0.56	2.52	
70	4.0	0.56	2.24	
80	3.7	0.56	2.07	
90	3.5	0.56	1.96	

POND VOLUME CALCULATIONS - 100 YEAR STORM		
10	10 * 5.50 * 60 = 3300	0.50 * 20 * 3.54 * 60 = 2124
		1176 ft ³
20	20 * 4.65 * 60 = 5580	0.50 * 30 * 3.54 * 60 = 3198
		2384 ft ³
30	30 * 3.86 * 60 = 6948	0.50 * 40 * 3.54 * 60 = 4248
		2700 ft ³
40	40 * 3.25 * 60 = 7800	0.50 * 50 * 3.54 * 60 = 5310
		2490 ft ³


PEAK STORM = 30 MIN.
 REQUIRED STORAGE = 2700 ft³

ELEVATION @ 2700 ft³ = 469.63


DETENTION POND STAGE/STORAGE CALCS

ELEV.	AREA (SF)	VOLUME (CF)	CUM. VOL. (CF)	NOTES
466.63	0		0	BOTTOM
467.0	225	530	42	
468.0	834	1067	572	
468.95	1067	1139	1639	5 YR WSEL
469.0	1443		1711	
469.08	1487	117	1828	10 YR WSEL
469.30	1610	458	2169	25 YR WSEL
469.63	1826	1028	2739	100 YR WSEL
471.63				TOP OF POND


5 YEAR WEIR CALCULATIONS

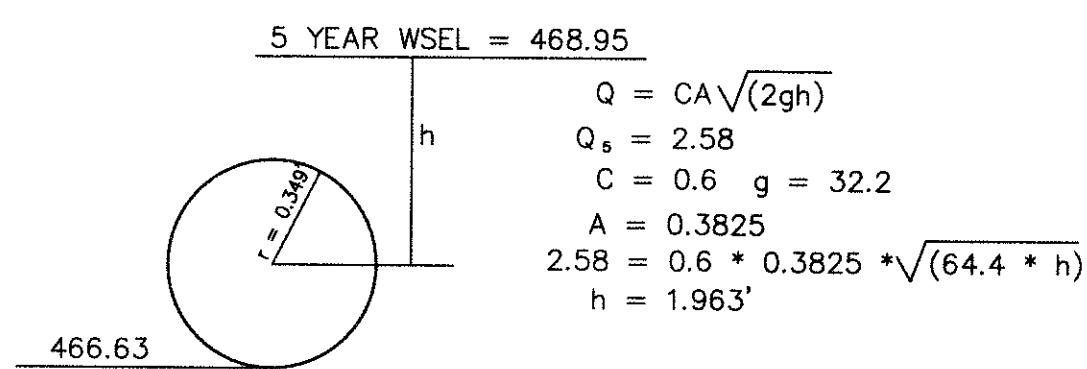


100 YEAR ORIFICE CALCULATIONS

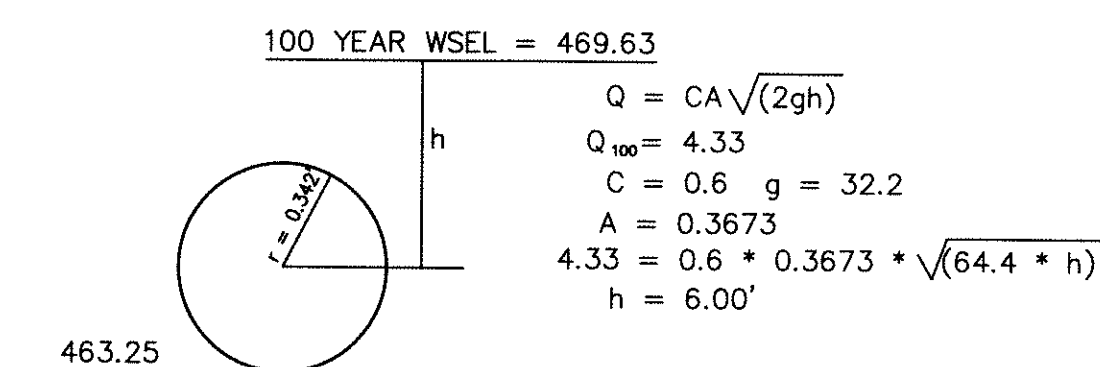

10 YEAR WEIR CALCULATIONS


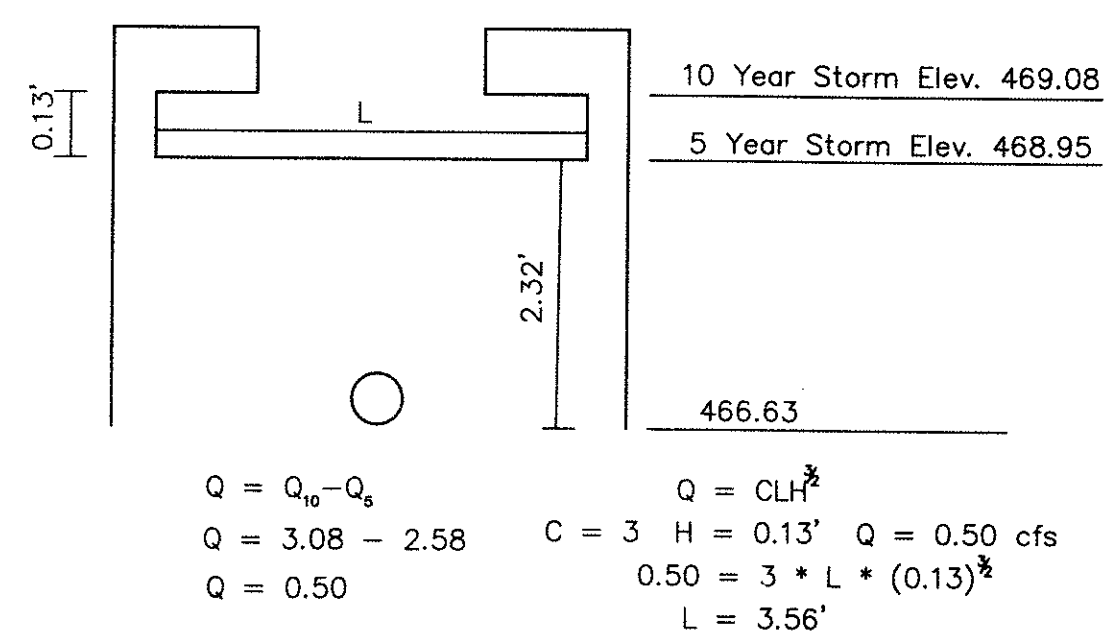


25 YEAR WEIR CALCULATIONS

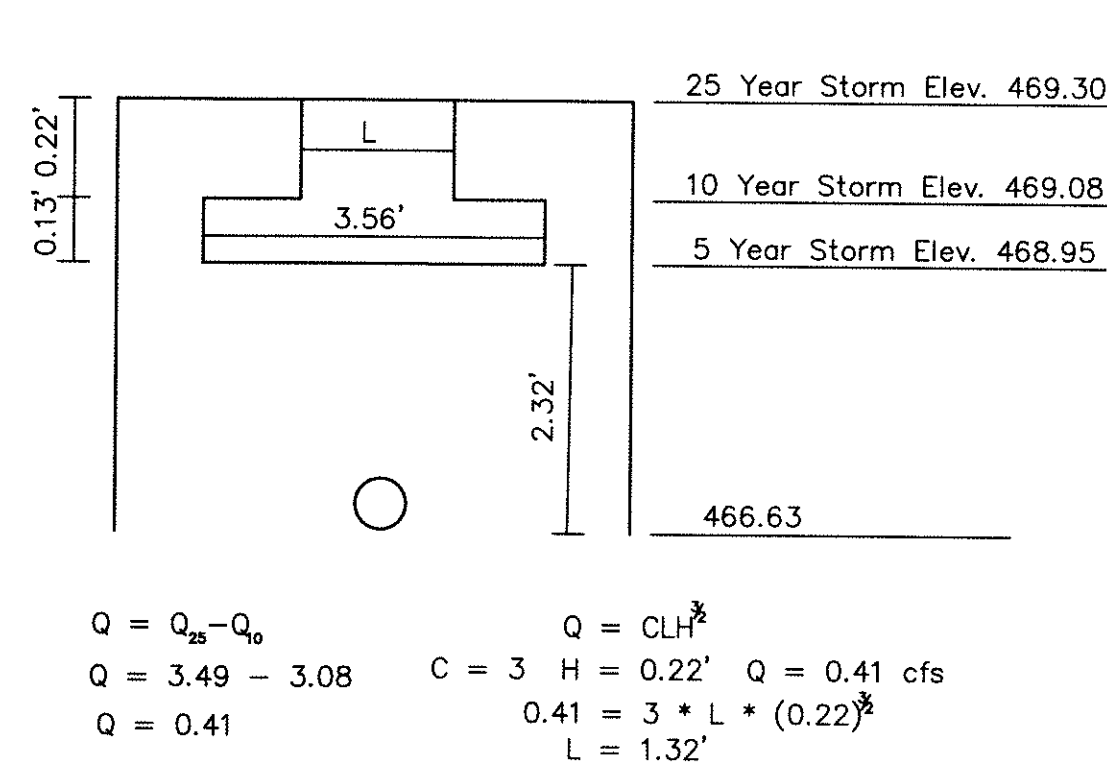


ALLOWABLE RELEASE RATES

	PASS-THRU	ADJUSTED ALLOWABLE
5 YR	0.49 cfs	0.49 + 2.09 = 2.58 cfs
10 YR	0.56 cfs	0.56 + 2.52 = 3.08 cfs
25 YR	0.67 cfs	0.67 + 2.82 = 3.49 cfs
100 YR	0.79 cfs	0.79 + 3.54 = 4.33 cfs

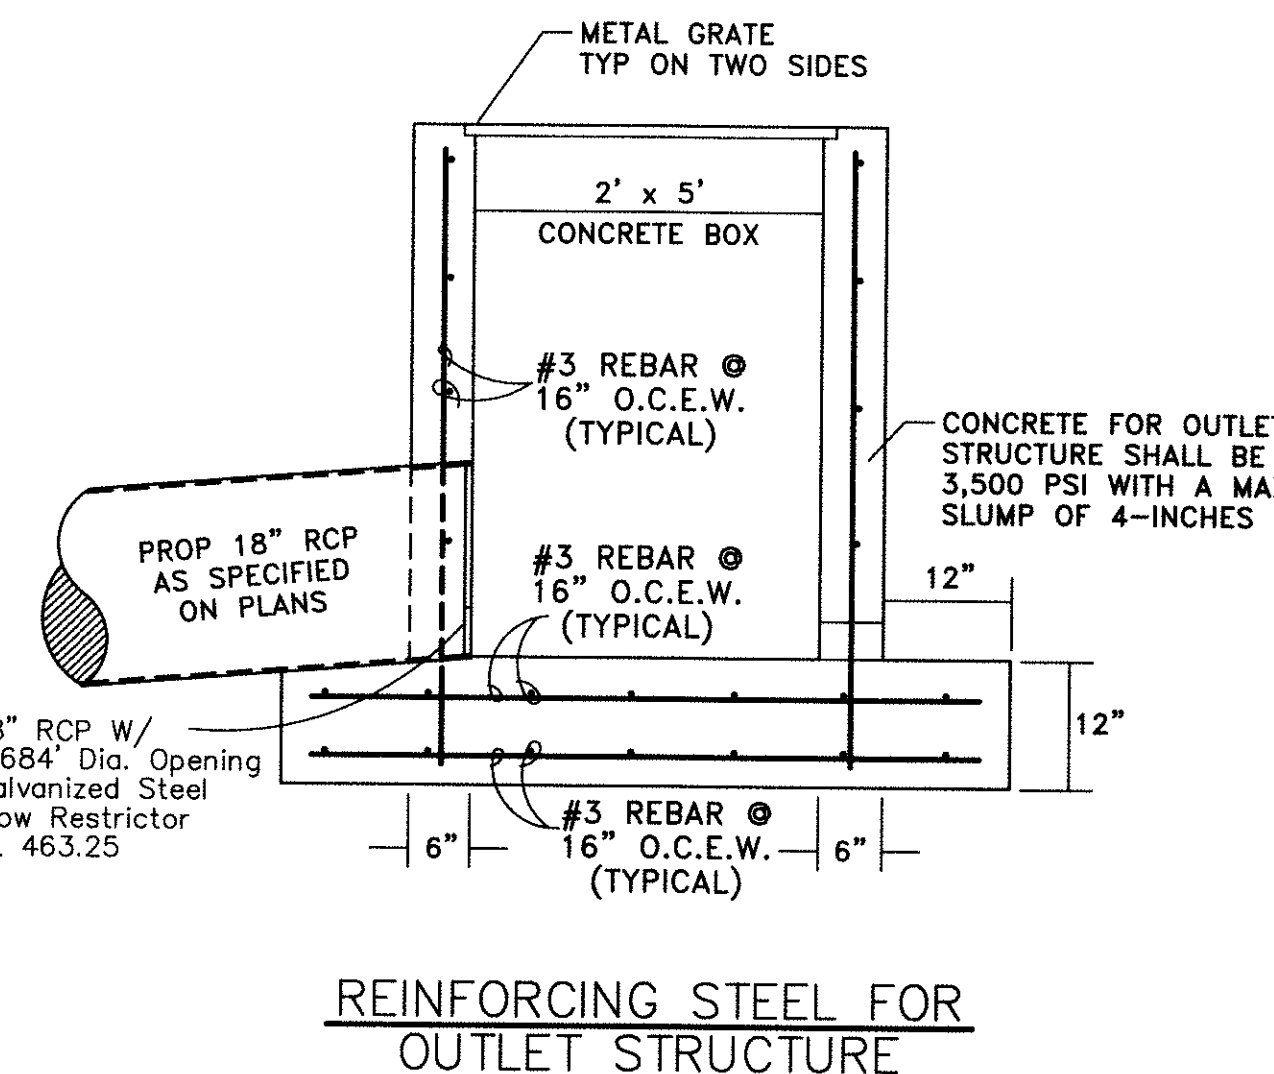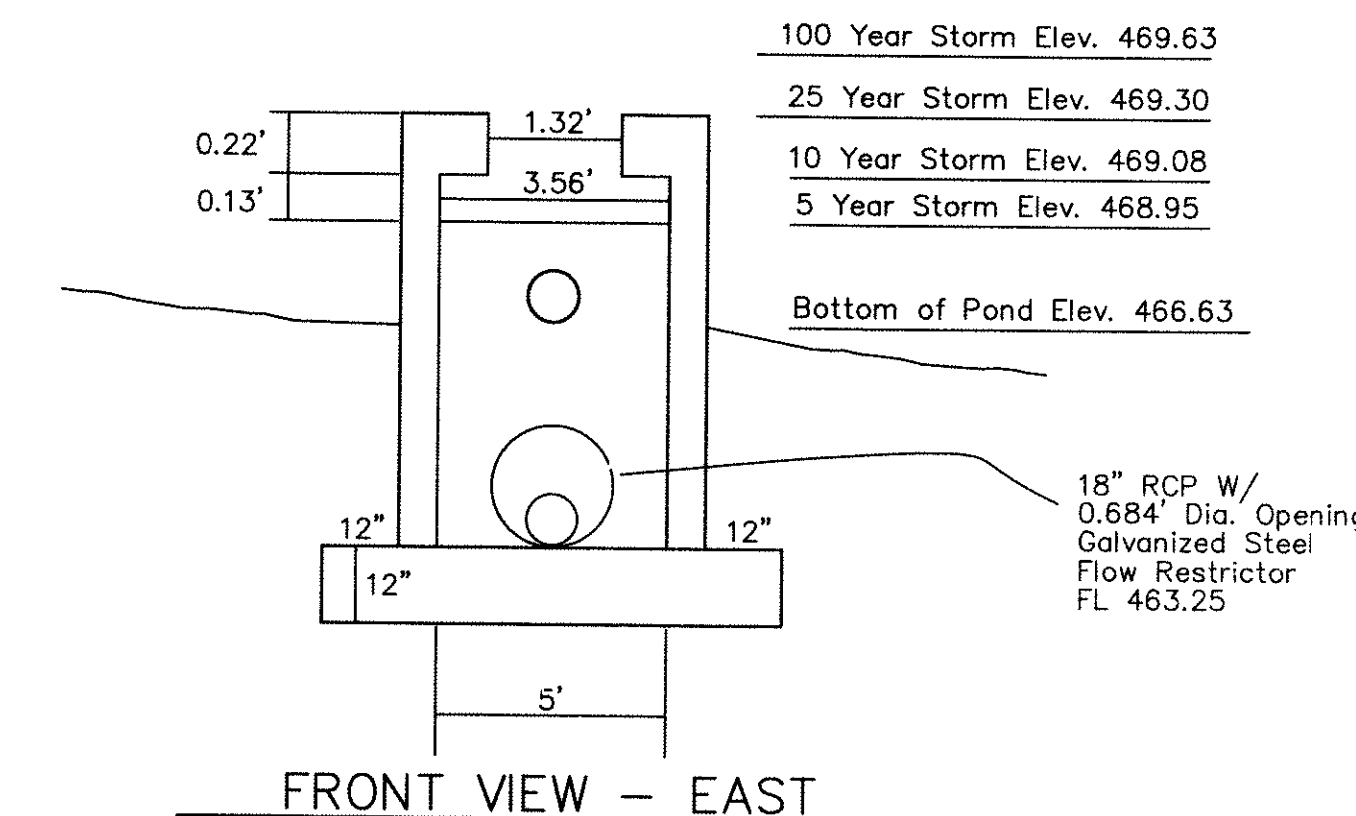

REINFORCING STEEL FOR OUTLET STRUCTURE

OUTLET STRUCTURE

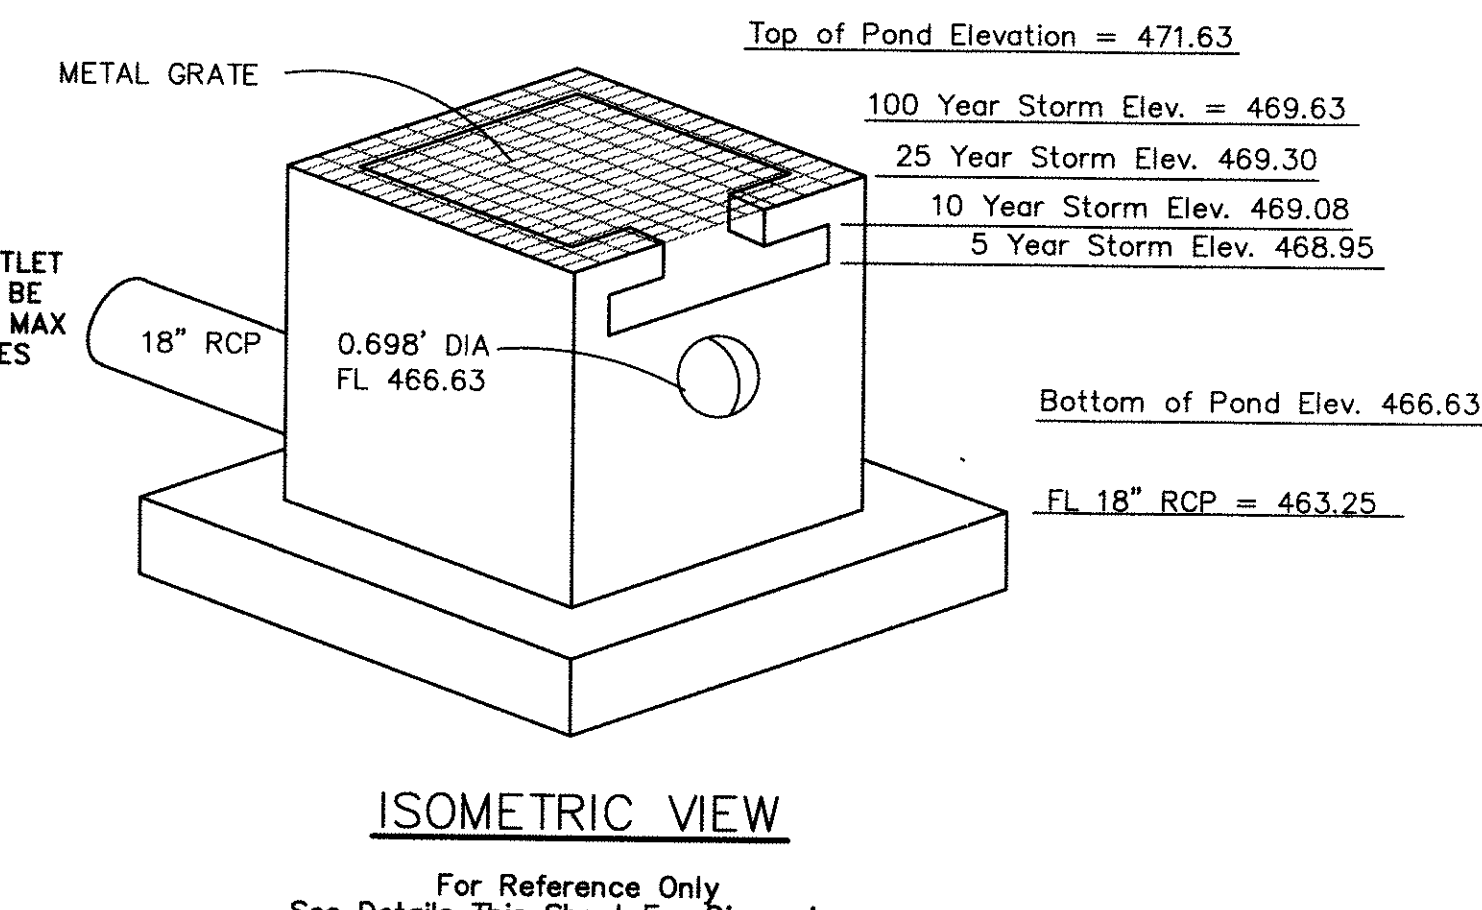

ISOMETRIC VIEW

For Reference Only
 See Details This Sheet For Dimensions

RECORD DRAWING

THIS RECORD DRAWING HAS BEEN PREPARED BASED ON INFORMATION PROVIDED BY OTHERS. THE ENGINEER HAS NOT VERIFIED THE ACCURACY OF THIS INFORMATION AND SHALL NOT BE RESPONSIBLE FOR ANY DISCREPANCIES WHICH MAY BE INCORPORATED HEREIN AS A RESULT.

Note: Copyright © Hickman Consulting Engineers, Inc. All rights reserved. No part of this drawing may be reproduced by photocopying, recording or by any other means, or stored, processed or transmitted in or by any computer or other systems without the prior written permission of Hickman Consulting Engineers, Inc. Copies of this plan without an original signature and seal are not valid.

Hickman Consulting Engineers, Inc.
 3084 County Road 1024
 Farmersville, Texas 75442
 Ph. (972) 784-8499
 markredhick@gmail.com
 Engineers

DRAINAGE CALCULATIONS - POND B
 LAKESHORE COMMONS
 LOT 1-4; LAKESHORE COMMONS
 ROCKWALL, ROCKWALL COUNTY, TEXAS
 MOORE WORTH INVESTMENTS, LLC
 8445 FREEMONT PARKWAY, SUITE 175
 IRVING, TX 75063
 214-415-9933

SCALE: N/A
 DATE: SEPT2016
 DRAWN BY: FP
 CHK'D BY: WHH
 JOB NO: 1501-357
 FILE: 1501-357-Land
 DATE SUBMITTED: 03/22/17

REVISION	DATE	BY	DESCRIPTION

5 YEAR STORM					10 YEAR STORM					25 YEAR STORM					100 YEAR STORM					
AREA	ACRE	C	Tc	Q _p	AREA	ACRE	C	Tc	Q _p	AREA	ACRE	C	Tc	Q _p	AREA	ACRE	C	Tc	Q _p	
PRE-DEV (AREAS F1, F2 & F3)	1.80	0.35	20	4.9	1.80	0.35	20	5.9	3.72	1.80	0.35	20	6.6	4.16	1.80	0.35	20	8.3	5.23	
POST-DEV (AREA F2, & F3; BY-PASS)	0.25	0.90	10	6.1	0.25	0.90	10	7.1	1.60	0.25	0.90	10	8.3	4.87	0.25	0.90	10	9.8	2.21	
F1a (PASS-THRU)	0.61	0.90	10	6.1	0.61	0.90	10	7.1	3.90	0.61	0.90	10	8.3	4.56	0.61	0.90	10	8.3	5.38	
Allowable Q from Pond =	Q ₁₀ - Q ₅					Q ₁₀ - Q ₅					Q ₁₀ - Q ₅					Q ₁₀₀ - Q ₁₀				
Allowable Q from Pond =	3.09 - 1.37 =	1.72 cfs				3.72 - 1.60 =	2.12 cfs				4.16 - 1.87 =	2.29 cfs				5.23 - 2.21 =	3.02 cfs			

DURATION	I _w	CA	Q _p
10	6.1	1.62	9.88
20	4.9	1.62	7.94
30	4.1	1.62	6.64
40	3.4	1.62	5.51
50	2.8	1.62	4.54
60	2.6	1.62	4.21
70	2.4	1.62	3.89
80	2.3	1.62	3.73
90	2.1	1.62	3.40

DURATION	I _w	CA	Q _p
10	7.1	1.62	11.50
20	5.9	1.62	9.56
30	4.8	1.62	7.78
40	4.0	1.62	6.48
50	3.5	1.62	5.67
60	3.0	1.62	4.86
70	2.8	1.62	4.54
80	2.6	1.62	4.21
90	2.5	1.62	4.05

DURATION	I _w	CA	Q _p
10	8.3	1.62	13.45
20	6.6	1.62	10.69
30	5.5	1.62	8.91
40	4.6	1.62	7.45
50	4.0	1.62	6.48
60	3.5	1.62	5.67
70	3.3	1.62	5.35
80	3.1	1.62	5.02
90	2.9	1.62	4.70
100	2.4	1.62	3.89

DURATION	I _w	CA	Q _p
10	9.8	1.62	15.88
20	8.3	1.62	13.45
30	6.9	1.62	11.18
40	5.8	1.62	9.40
50	5.0	1.62	8.10
60	4.5	1.62	7.29
70	4.0	1.62	6.48
80	3.7	1.62	5.99
90	3.5	1.62	5.67
100	3.3	1.62	5.35
110	3.0	1.62	4.86

10	10 * 9.88 * 60 = 5928	0.50 * 20 * 1.72 * 60 = 1032	4896 ft. ³
20	20 * 7.94 * 60 = 9528	0.50 * 30 * 1.72 * 60 = 1548	7980 ft. ³
30	30 * 6.64 * 60 = 11952	0.50 * 40 * 1.72 * 60 = 2064	9888 ft. ³
40	40 * 5.51 * 60 = 13224	0.50 * 50 * 1.72 * 60 = 2580	10644 ft. ³
50	50 * 4.54 * 60 = 15620	0.50 * 60 * 1.72 * 60 = 3096	10524 ft. ³

PEAK STORM = 40 MIN.
REQUIRED STORAGE = 10,524 ft.³

ELEVATION @ 10,524 ft.³ = 467.06

10	10 * 11.50 * 60 = 6900	0.50 * 20 * 2.12 * 60 = 1272	5628 ft. ³
20	20 * 9.56 * 60 = 11470	0.50 * 30 * 2.12 * 60 = 1908	9562 ft. ³
30	30 * 7.78 * 60 = 14004	0.50 * 40 * 2.12 * 60 = 2544	11460 ft. ³
40	40 * 6.48 * 60 = 15552	0.50 * 50 * 2.12 * 60 = 3180	12372 ft. ³
50	50 * 5.67 * 60 = 17010	0.50 * 60 * 2.12 * 60 = 3816	13194 ft. ³
60	60 * 4.86 * 60 = 17496	0.50 * 70 * 2.12 * 60 = 4452	13044 ft. ³

PEAK STORM = 50 MIN.
REQUIRED STORAGE = 13,194 ft.³

ELEVATION @ 13,194 ft.³ = 467.53

10	10 * 13.45 * 60 = 8070	0.50 * 20 * 2.29 * 60 = 1374	6696 ft. ³
20	20 * 10.69 * 60 = 12828	0.50 * 30 * 2.29 * 60 = 2061	10767 ft. ³
30	30 * 8.91 * 60 = 16038	0.50 * 40 * 2.29 * 60 = 2748	13290 ft. ³
40	40 * 7.45 * 60 = 17880	0.50 * 50 * 2.29 * 60 = 3435	14445 ft. ³
50	50 * 6.48 * 60 = 18440	0.50 * 60 * 2.29 * 60 = 4122	15318 ft. ³
60	60 * 5.67 * 60 = 20412	0.50 * 70 * 2.29 * 60 = 4809	15603 ft. ³
70	70 * 5.35 * 60 = 22470	0.50 * 80 * 2.29 * 60 = 5490	16974 ft. ³
80	80 * 5.02 * 60 = 24096	0.50 * 90 * 2.29 * 60 = 6183	17913 ft. ³
90	90 * 4.70 * 60 = 25380	0.50 * 100 * 2.29 * 60 = 6870	18510 ft. ³
100	100 * 3.89 * 60 = 23340	0.50 * 110 * 2.29 * 60 = 7557	15783 ft. ³

PEAK STORM = 90 MIN.
REQUIRED STORAGE = 18,510 ft.³

ELEVATION @ 18,510 ft.³ = 468.55

10	10 * 15.88 * 60 = 9528	0.50 * 20 * 3.02 * 60 = 1812	7716 ft. ³
20	20 * 13.45 * 60 = 15140	0.50 * 30 * 3.02 * 60 = 2718	12422 ft. ³
30	30 * 11.18 * 60 = 20124	0.50 * 40 * 3.02 * 60 = 3624	16500 ft. ³
40	40 * 9.40 * 60 = 22560	0.50 * 50 * 3.02 * 60 = 4530	18030 ft. ³
50	50 * 8.10 * 60 = 24300	0.50 * 60 * 3.02 * 60 = 5436	18864 ft. ³
60	60 * 7.29 * 60 = 25644	0.50 * 70 * 3.02 * 60 = 6342	19902 ft. ³
70	70 * 6.48 * 60 = 27216	0.50 * 80 * 3.02 * 60 = 7248	19968 ft. ³
80	80 * 5.99 * 60 = 28752	0.50 * 90 * 3.02 * 60 = 8154	20598 ft. ³
90	90 * 5.67 * 60 = 30618	0.50 * 100 * 3.02 * 60 = 9060	21558 ft. ³
100	100 * 5.35 * 60 = 32100	0.50 * 110 * 3.02 * 60 = 9966	22134 ft. ³
110	110 * 4.86 * 60 = 32076	0.50 * 120 * 3.02 * 60 = 10872	21204 ft. ³

PEAK STORM = 100 MIN.
REQUIRED STORAGE = 22,134 ft.³

ELEVATION @ 22,134 ft.³ = 469.59

UDS STAGE/STORAGE CALCS

CONTECH ENGINEERED SOLUTIONS
 Date: 2/27/17
 Project Name: Lakeshore Commons
 City / Country: Rockwall
 State: TX
 Designed By: MJR
 Company: Contech
 Telephone:


Contech Engineered Solutions, LLC is pleased to offer the following estimate of storage volume for the above named project. The results are submitted as an estimate only, without liability on the part of Contech Engineered Solutions, LLC for accuracy or suitability to any particular application and are subject to verification of the Engineer of Record. This tool is only applicable for rectangular shaped systems.

System Information	Backfill Information	Pipe & Analysis Information
Out-to-out length (ft):	Backfill Porosity (%):	System Diameter (in):
Out-to-out width (ft):	Depth Above Pipe (in):	Pipe Spacing (in):
Number of Manholes (ea):	Depth Below Pipe (in):	Incremental Analysis (in):
Number of Barrels (ea):	Width At Ends (ft):	System Invert (Elevation):
	Width At Sides (ft):	


System	Pipe	Stone	Total System	Miscellaneous
Depth (ft)	Incremental Storage (cf)	Incremental Storage (cf)	Incremental Storage (cf)	Percent Open Area Surface Storage (%)
0.00	464.67	0.0	0.0	0.0
0.17	464.83	227.5	227.5	100.0%
0.33	465.00	455.0	455.0	100.0%
0.50	465.17	682.5	682.5	100.0%
0.67	465.33	910.0	910.0	100.0%
0.83	465.50	1137.5	1137.5	100.0%
1.00	465.67	1365.0	1365.0	100.0%
1.17	465.83	1592.5	1592.5	100.0%
1.33	466.00	1820.0	1820.0	100.0%
1.50	466.17	2047.5	2047.5	100.0%
1.67	466.33	2275.0	2275.0	100.0%
1.83	466.50	2502.5	2502.5	100.0%
2.00	466.67	2730.0	2730.0	100.0%
2.17	466.83	2957.5	2957.5	100.0%
2.33	467.00	3185.0	3185.0	100.0%
2.50	467.17	3412.5	3412.5	100.0%
2.67	467.33	3640.0	3640.0	100.0%
2.83	467.50	3867.5	3867.5	100.0%
3.00	467.67	4095.0	4095.0	100.0%
3.17	467.83	4322.5	4322.5	100.0%
3.33	468.00	4550.0	4550.0	100.0%
3.50	468.17	4777.5	4777.5	100.0%
3.67	468.33	5005.0	5005.0	100.0%
3.83	468.50	5232.5	5232.5	100.0%
4.00	468.67	5460.0	5460.0	100.0%
4.17	468.83	5687.5	5687.5	100.0%
4.33	469.00	5915.0	5915.0	100.0%
4.50	469.17	6142.5	6142.5	100.0%
4.67	469.33	6370.0	6370.0	100.0%
4.83	469.50	6597.5	6597.5	100.0%
5.00	469.67	6825.0	6825.0	100.0%

These results are submitted to you as a guideline only, without liability on the part of CONTECH Engineered Solutions, LLC for accuracy or suitability to any particular application, and are subject to your verification.


5 YEAR WEIR CALCULATIONS

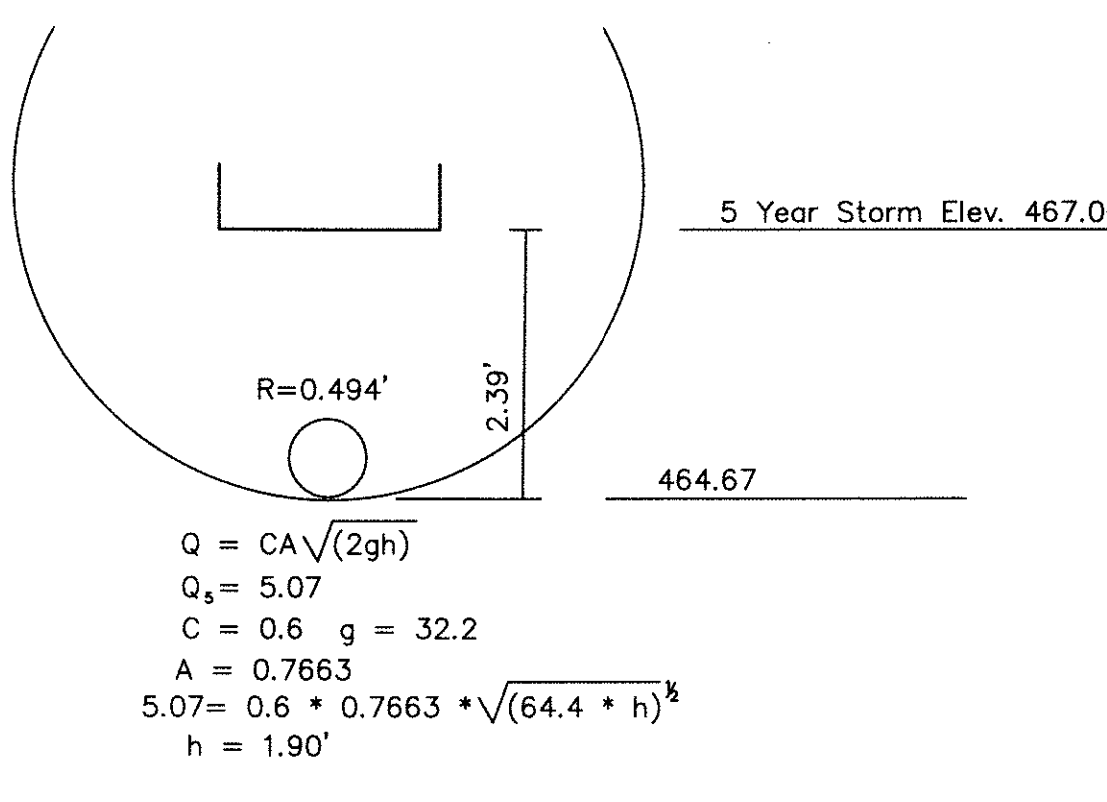


25 YEAR WEIR CALCULATIONS

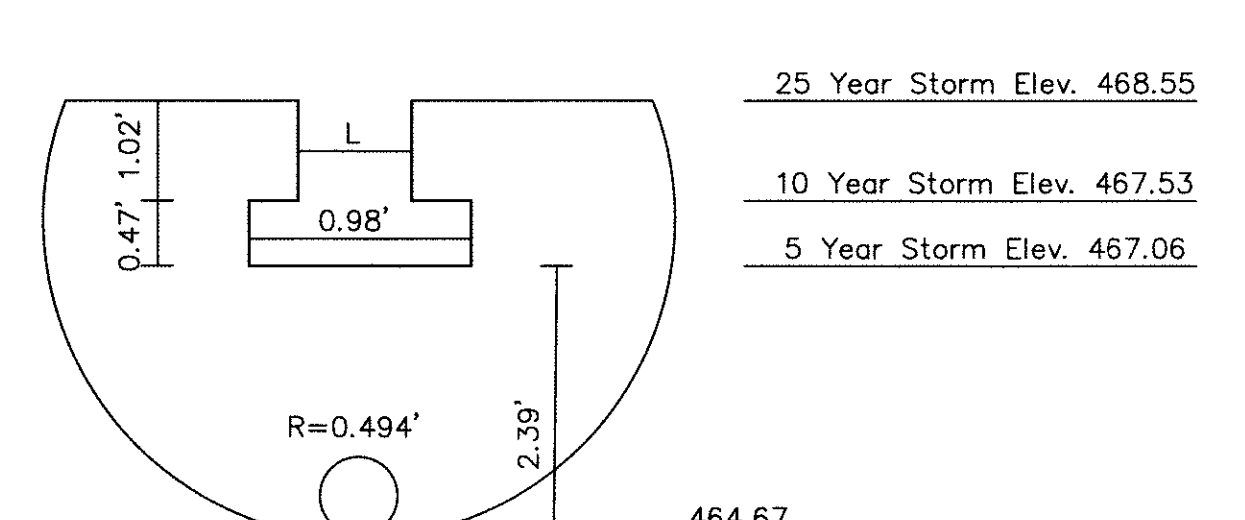


WEIR PLATE UPSTREAM

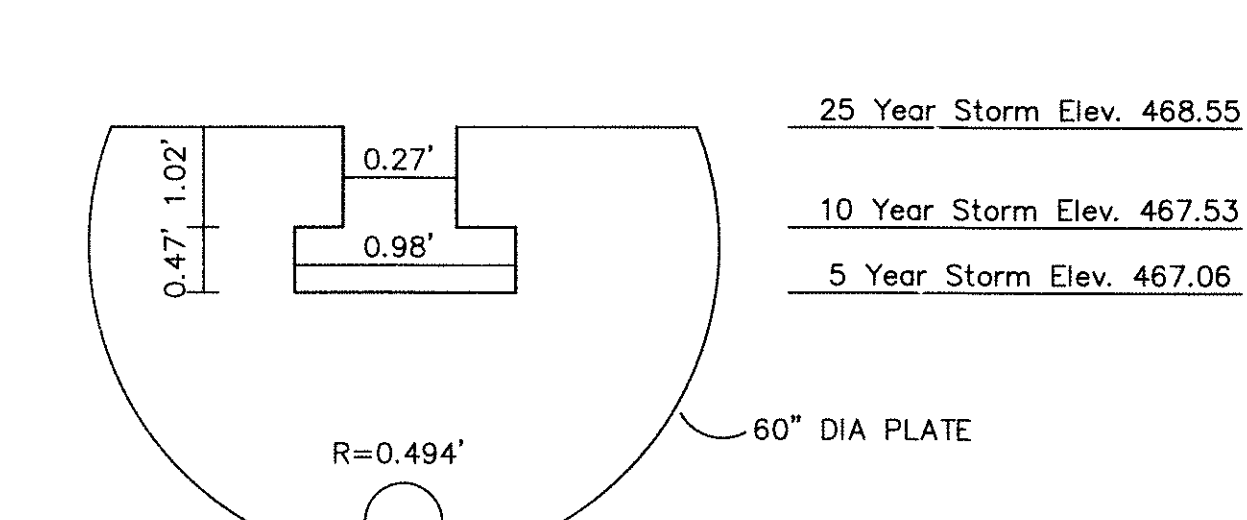


10 YEAR WEIR CALCULATIONS

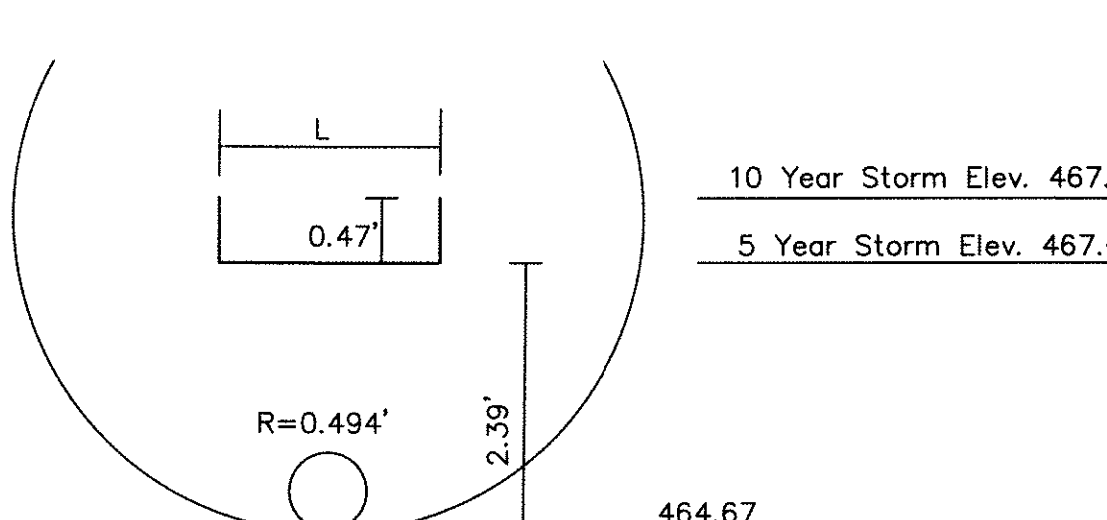

100 YEAR ORIFICE CALCULATIONS

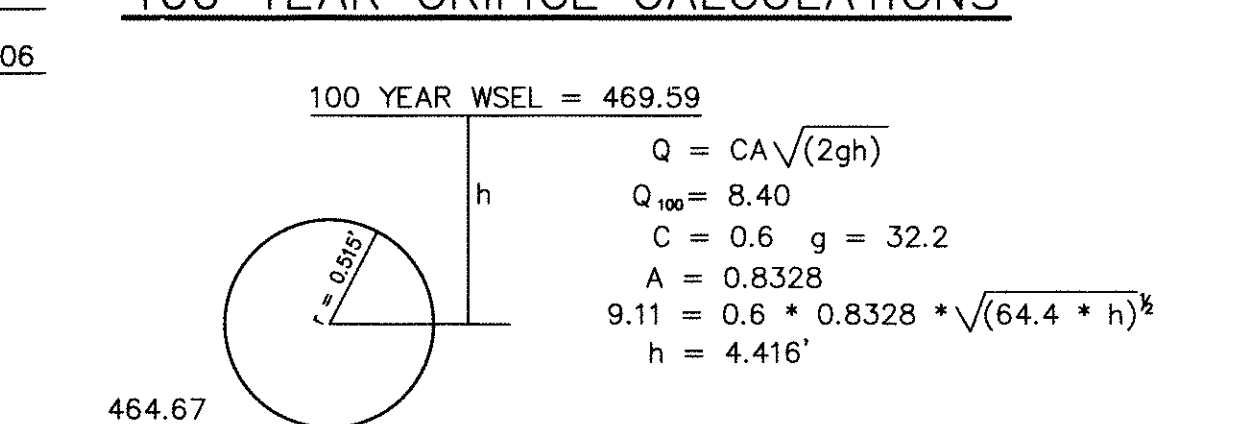

WEIR PLATE DOWNSTREAM

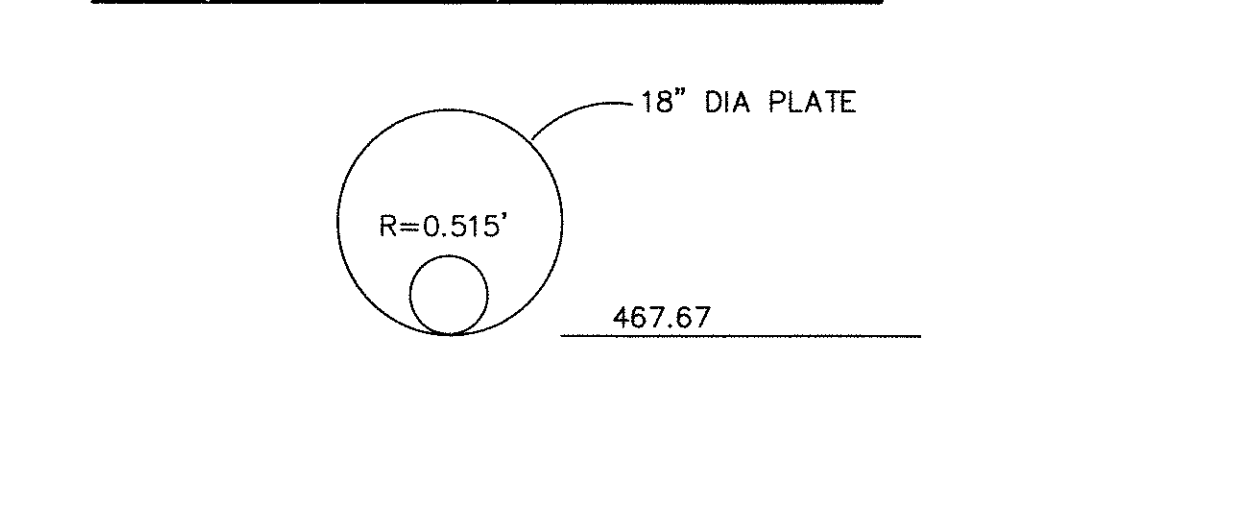

Note: Copyright © Hickman Consulting Engineers, Inc. All rights reserved. No part of this drawing may be reproduced by photocopying, recording or by any other means, or stored, processed or transmitted in or by any computer or other systems without the prior written permission of Hickman Consulting Engineers, Inc. Copies of this plan without an original signature and seal are not valid.

UDS LOTS 3 & 4 IS DESIGNED FOR FUTURE CONDITIONS

RECORD DRAWING

THIS RECORD DRAWING HAS BEEN PREPARED BASED ON INFORMATION PROVIDED BY OTHERS. THE ENGINEER HAS NOT VERIFIED THE ACCURACY OF THIS INFORMATION AND SHALL NOT BE RESPONSIBLE FOR ANY DISCREPANCIES WHICH MAY BE INCORPORATED HEREIN AS A RESULT.

Hickman Consulting Engineers, Inc.
 3094 County Road 1024
 Farmersville, Texas 75442
 Ph (972)764-2499
 markredick@gmail.com
 Engineers Planners

DETENTION CALCS - UDS
 LAKESHORE COMMONS
 LOT 1-4; LAKESHORE COMMONS
 ROCKWALL, ROCKWALL COUNTY, TEXAS
 MOORE WORTH INVESTMENTS, LLC
 8445 FREERPORT PARKWAY, SUITE 175
 IRVING, TX 75063
 214-415-8993





SCALE: N/A
 DATE: SEPT2016
 DRAWN BY: FP
 CHK'D BY: MIH
 JOB NO: 1501-357
 FILE# 1501-1501-1501-LWD
 DATE SUBMITTED: 02/27/2016

Hickman Consulting Engineers, Inc.

 MARK H. HICKMAN
 REGISTERED PROFESSIONAL ENGINEER
 F-12172

DATE: _____
 BY: _____
 DESCRIPTION: _____
 REVISION: _____

SHEET
C-8

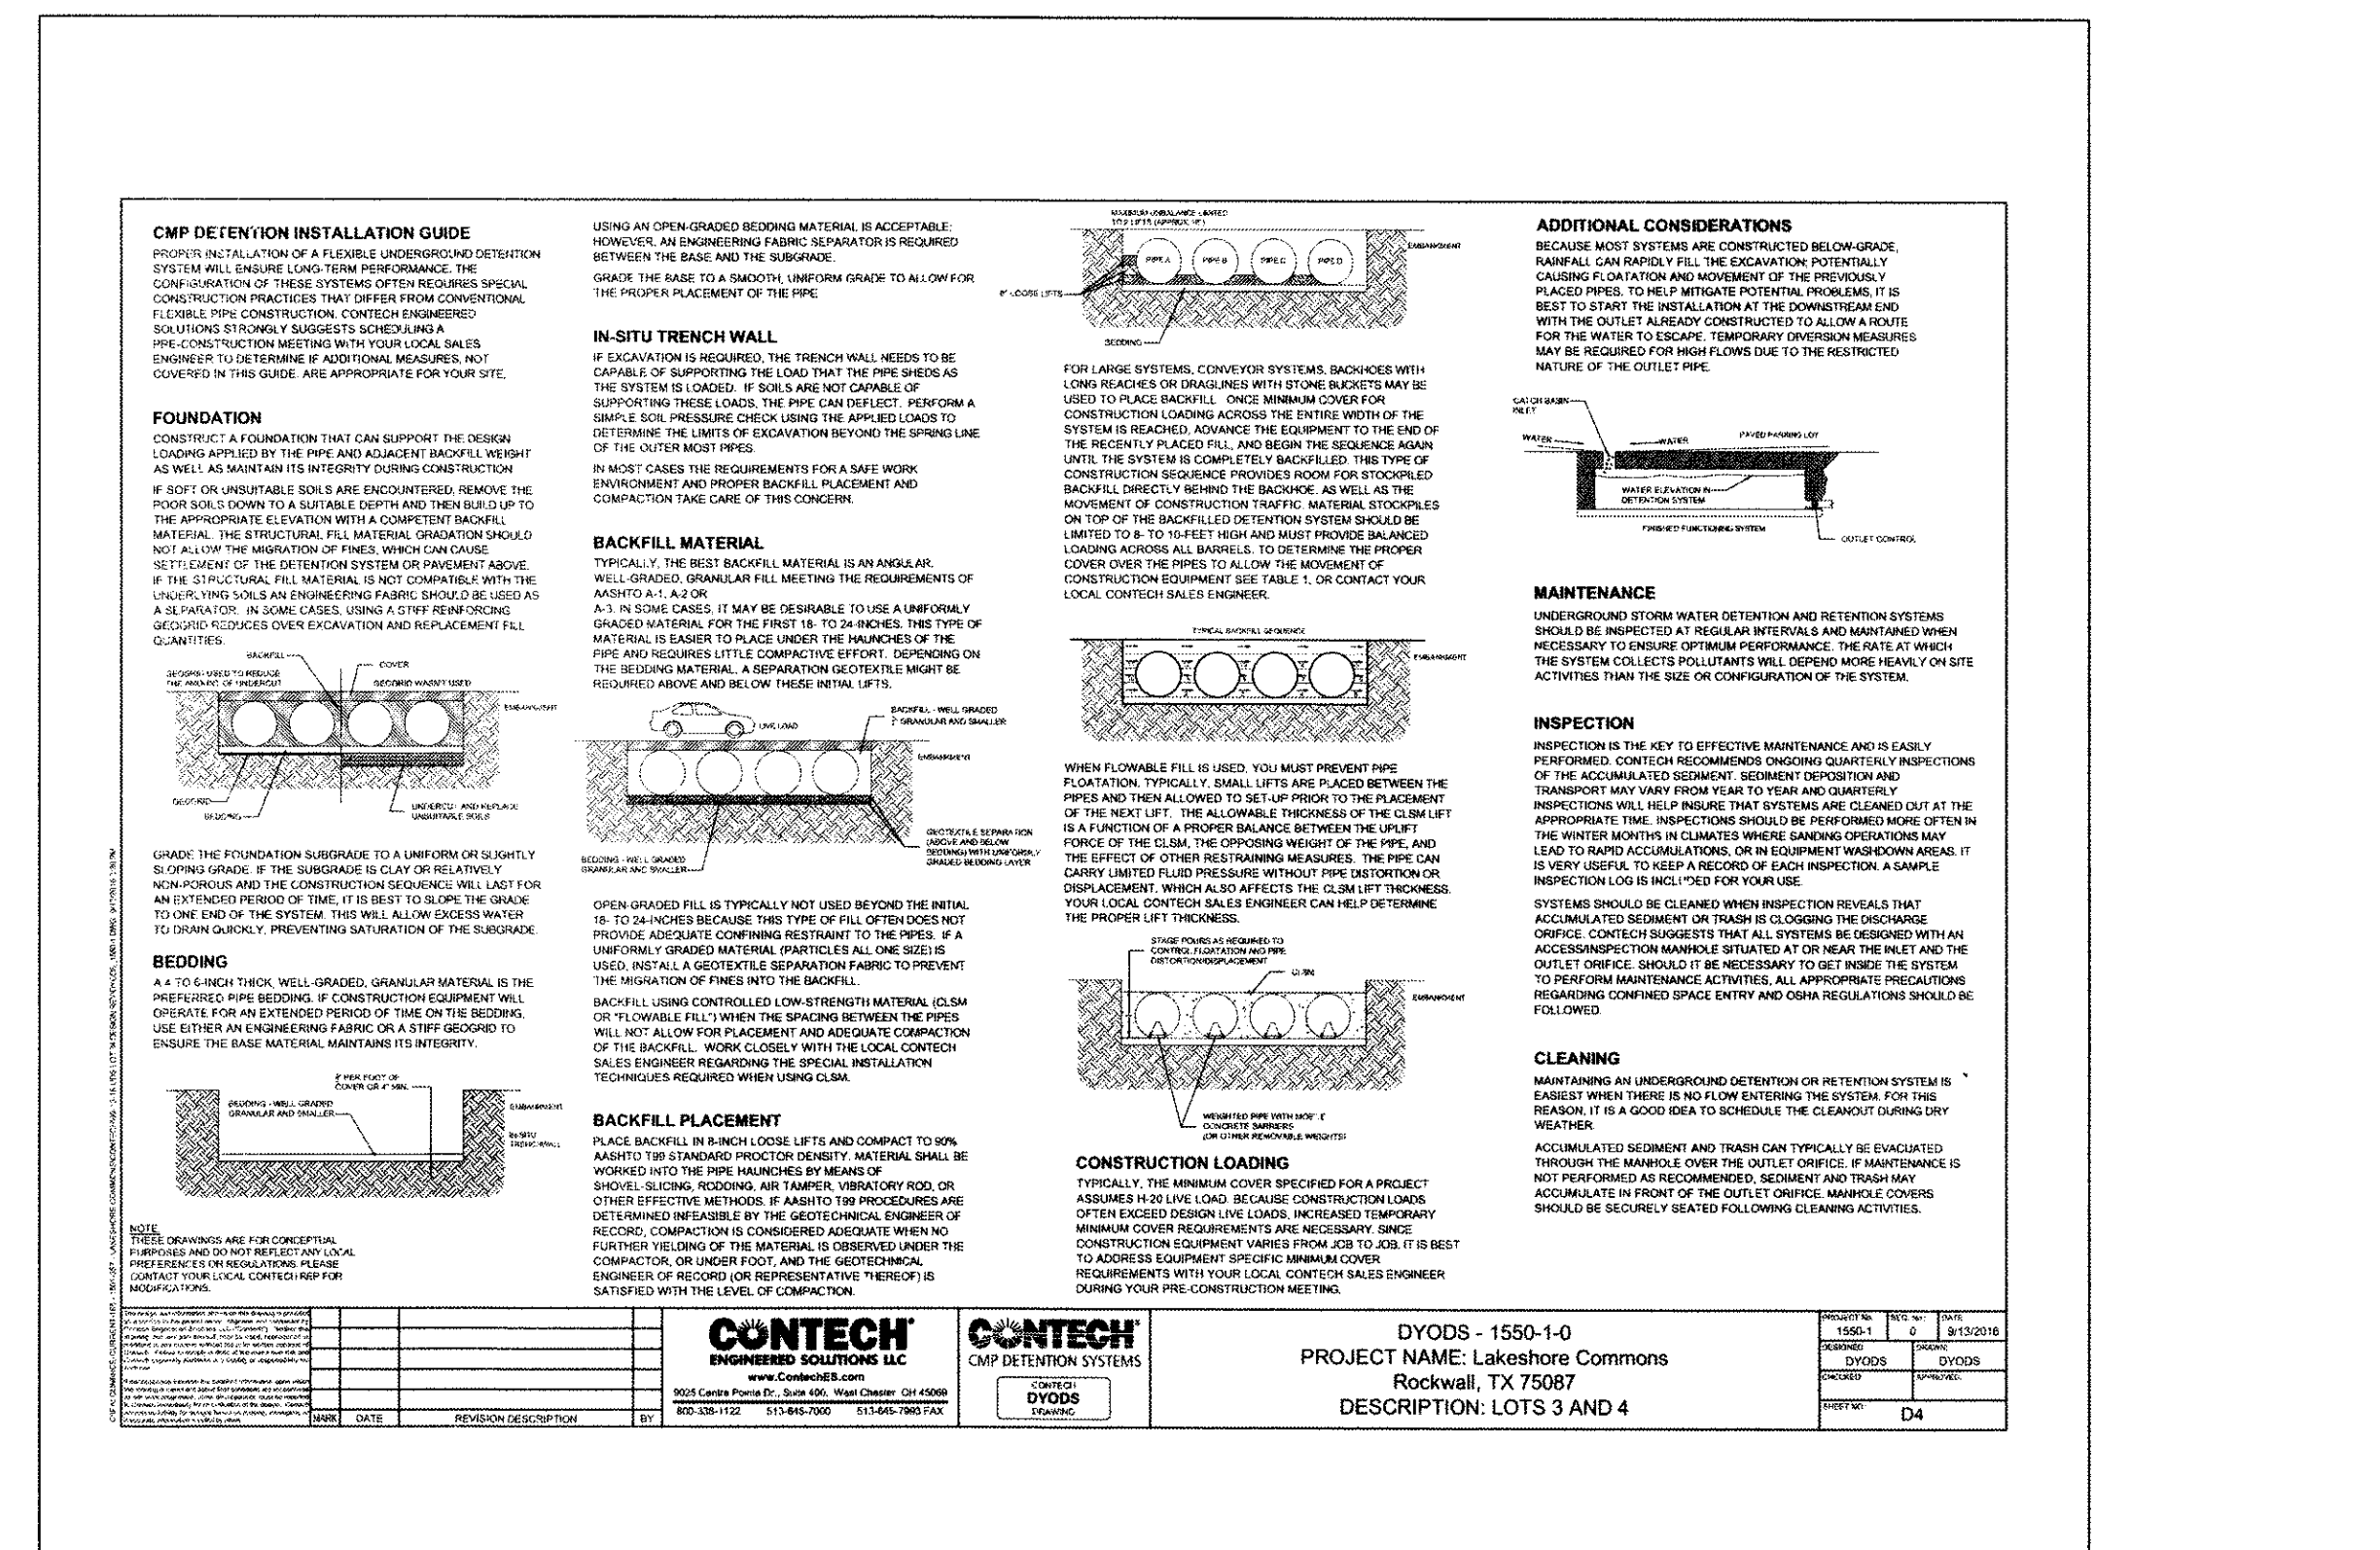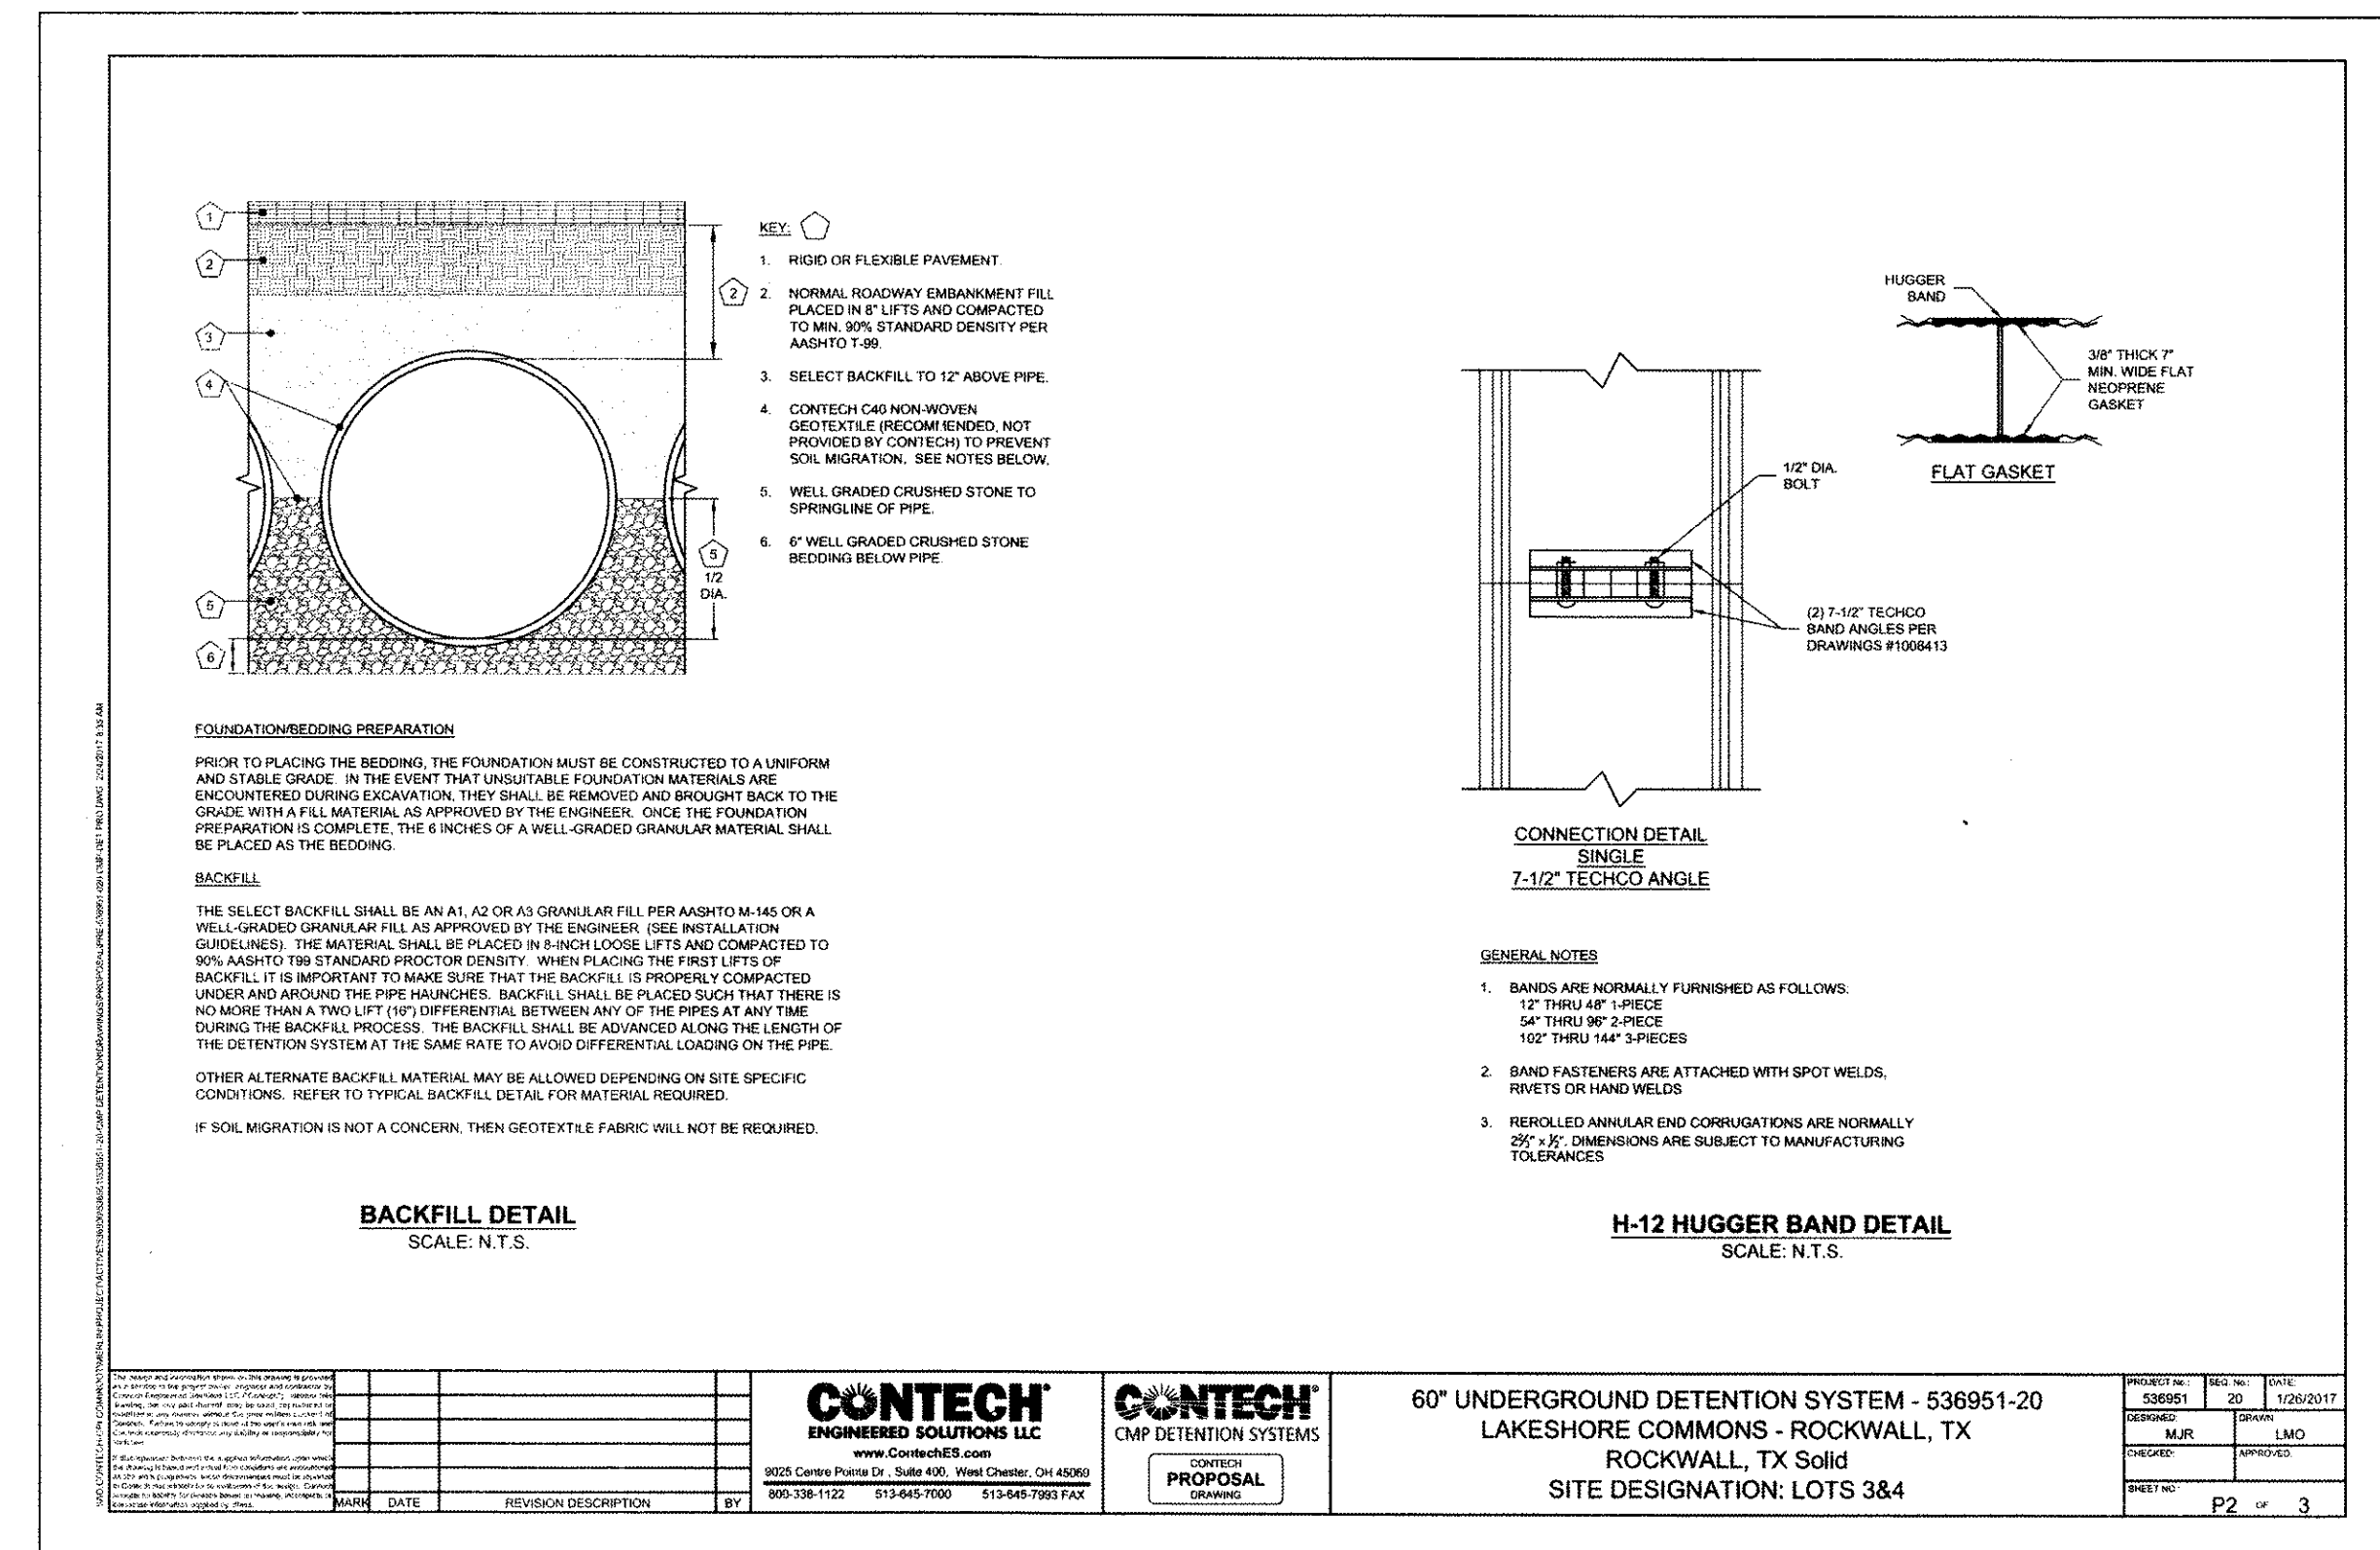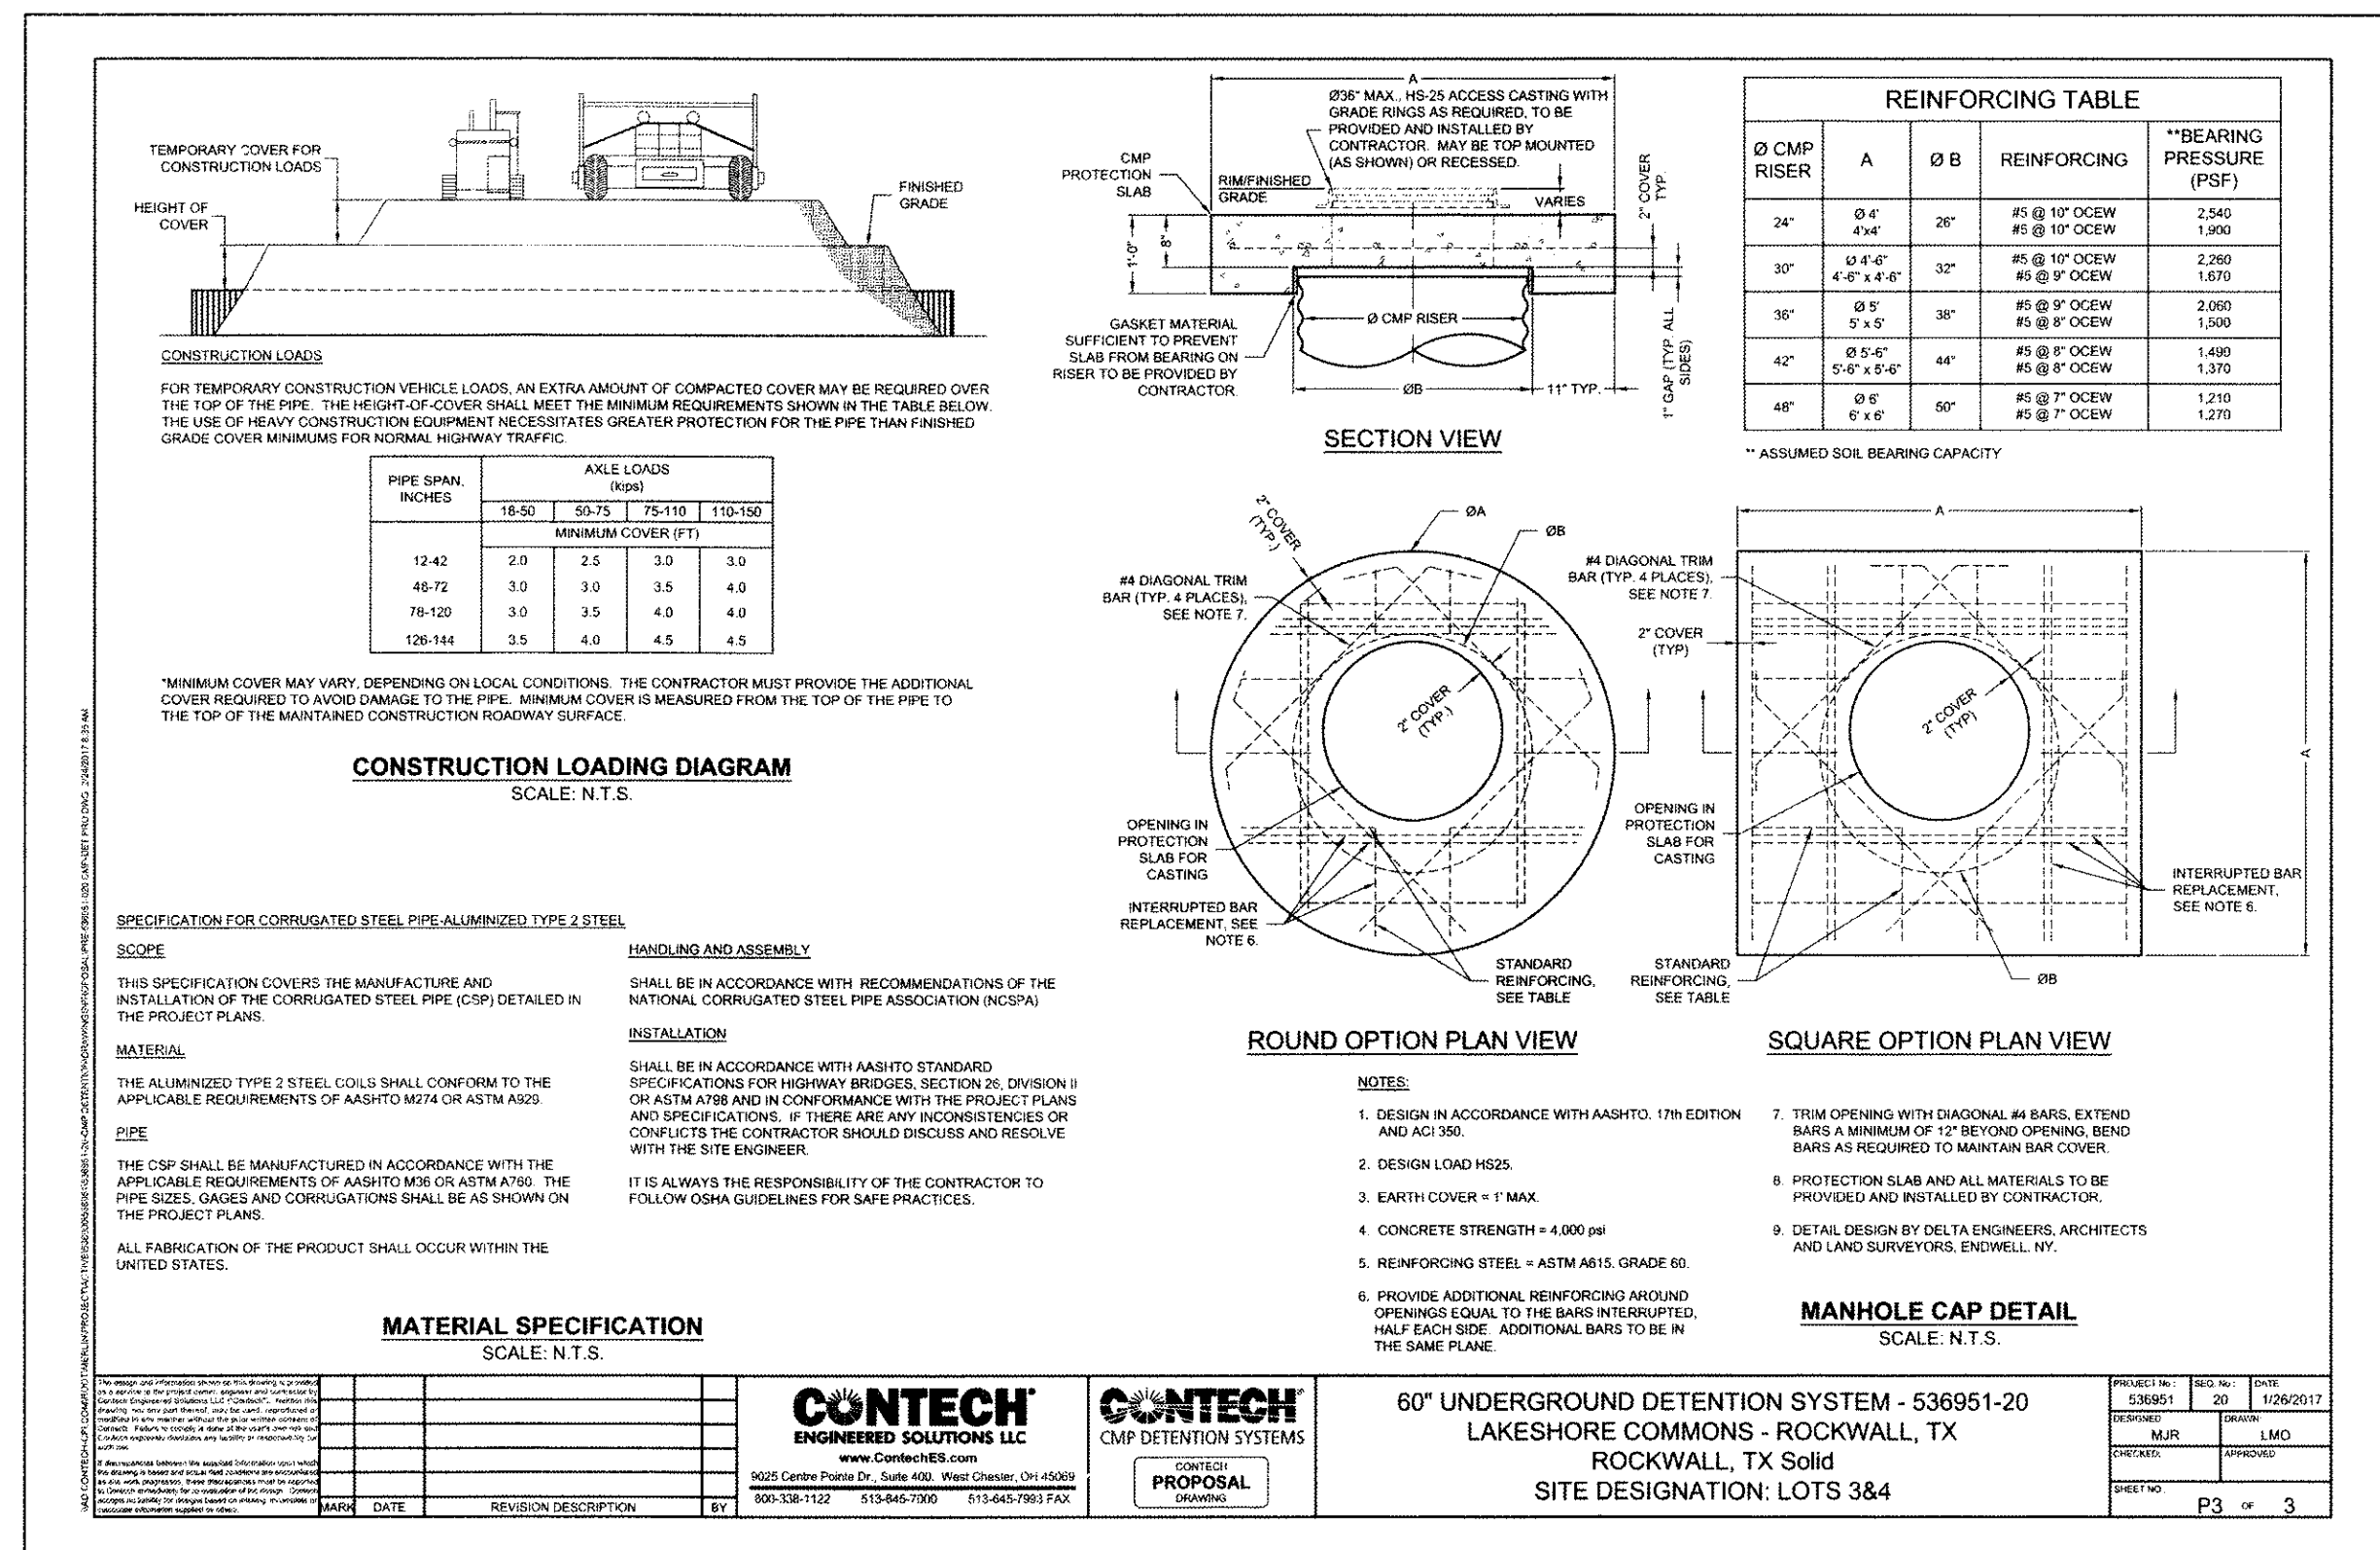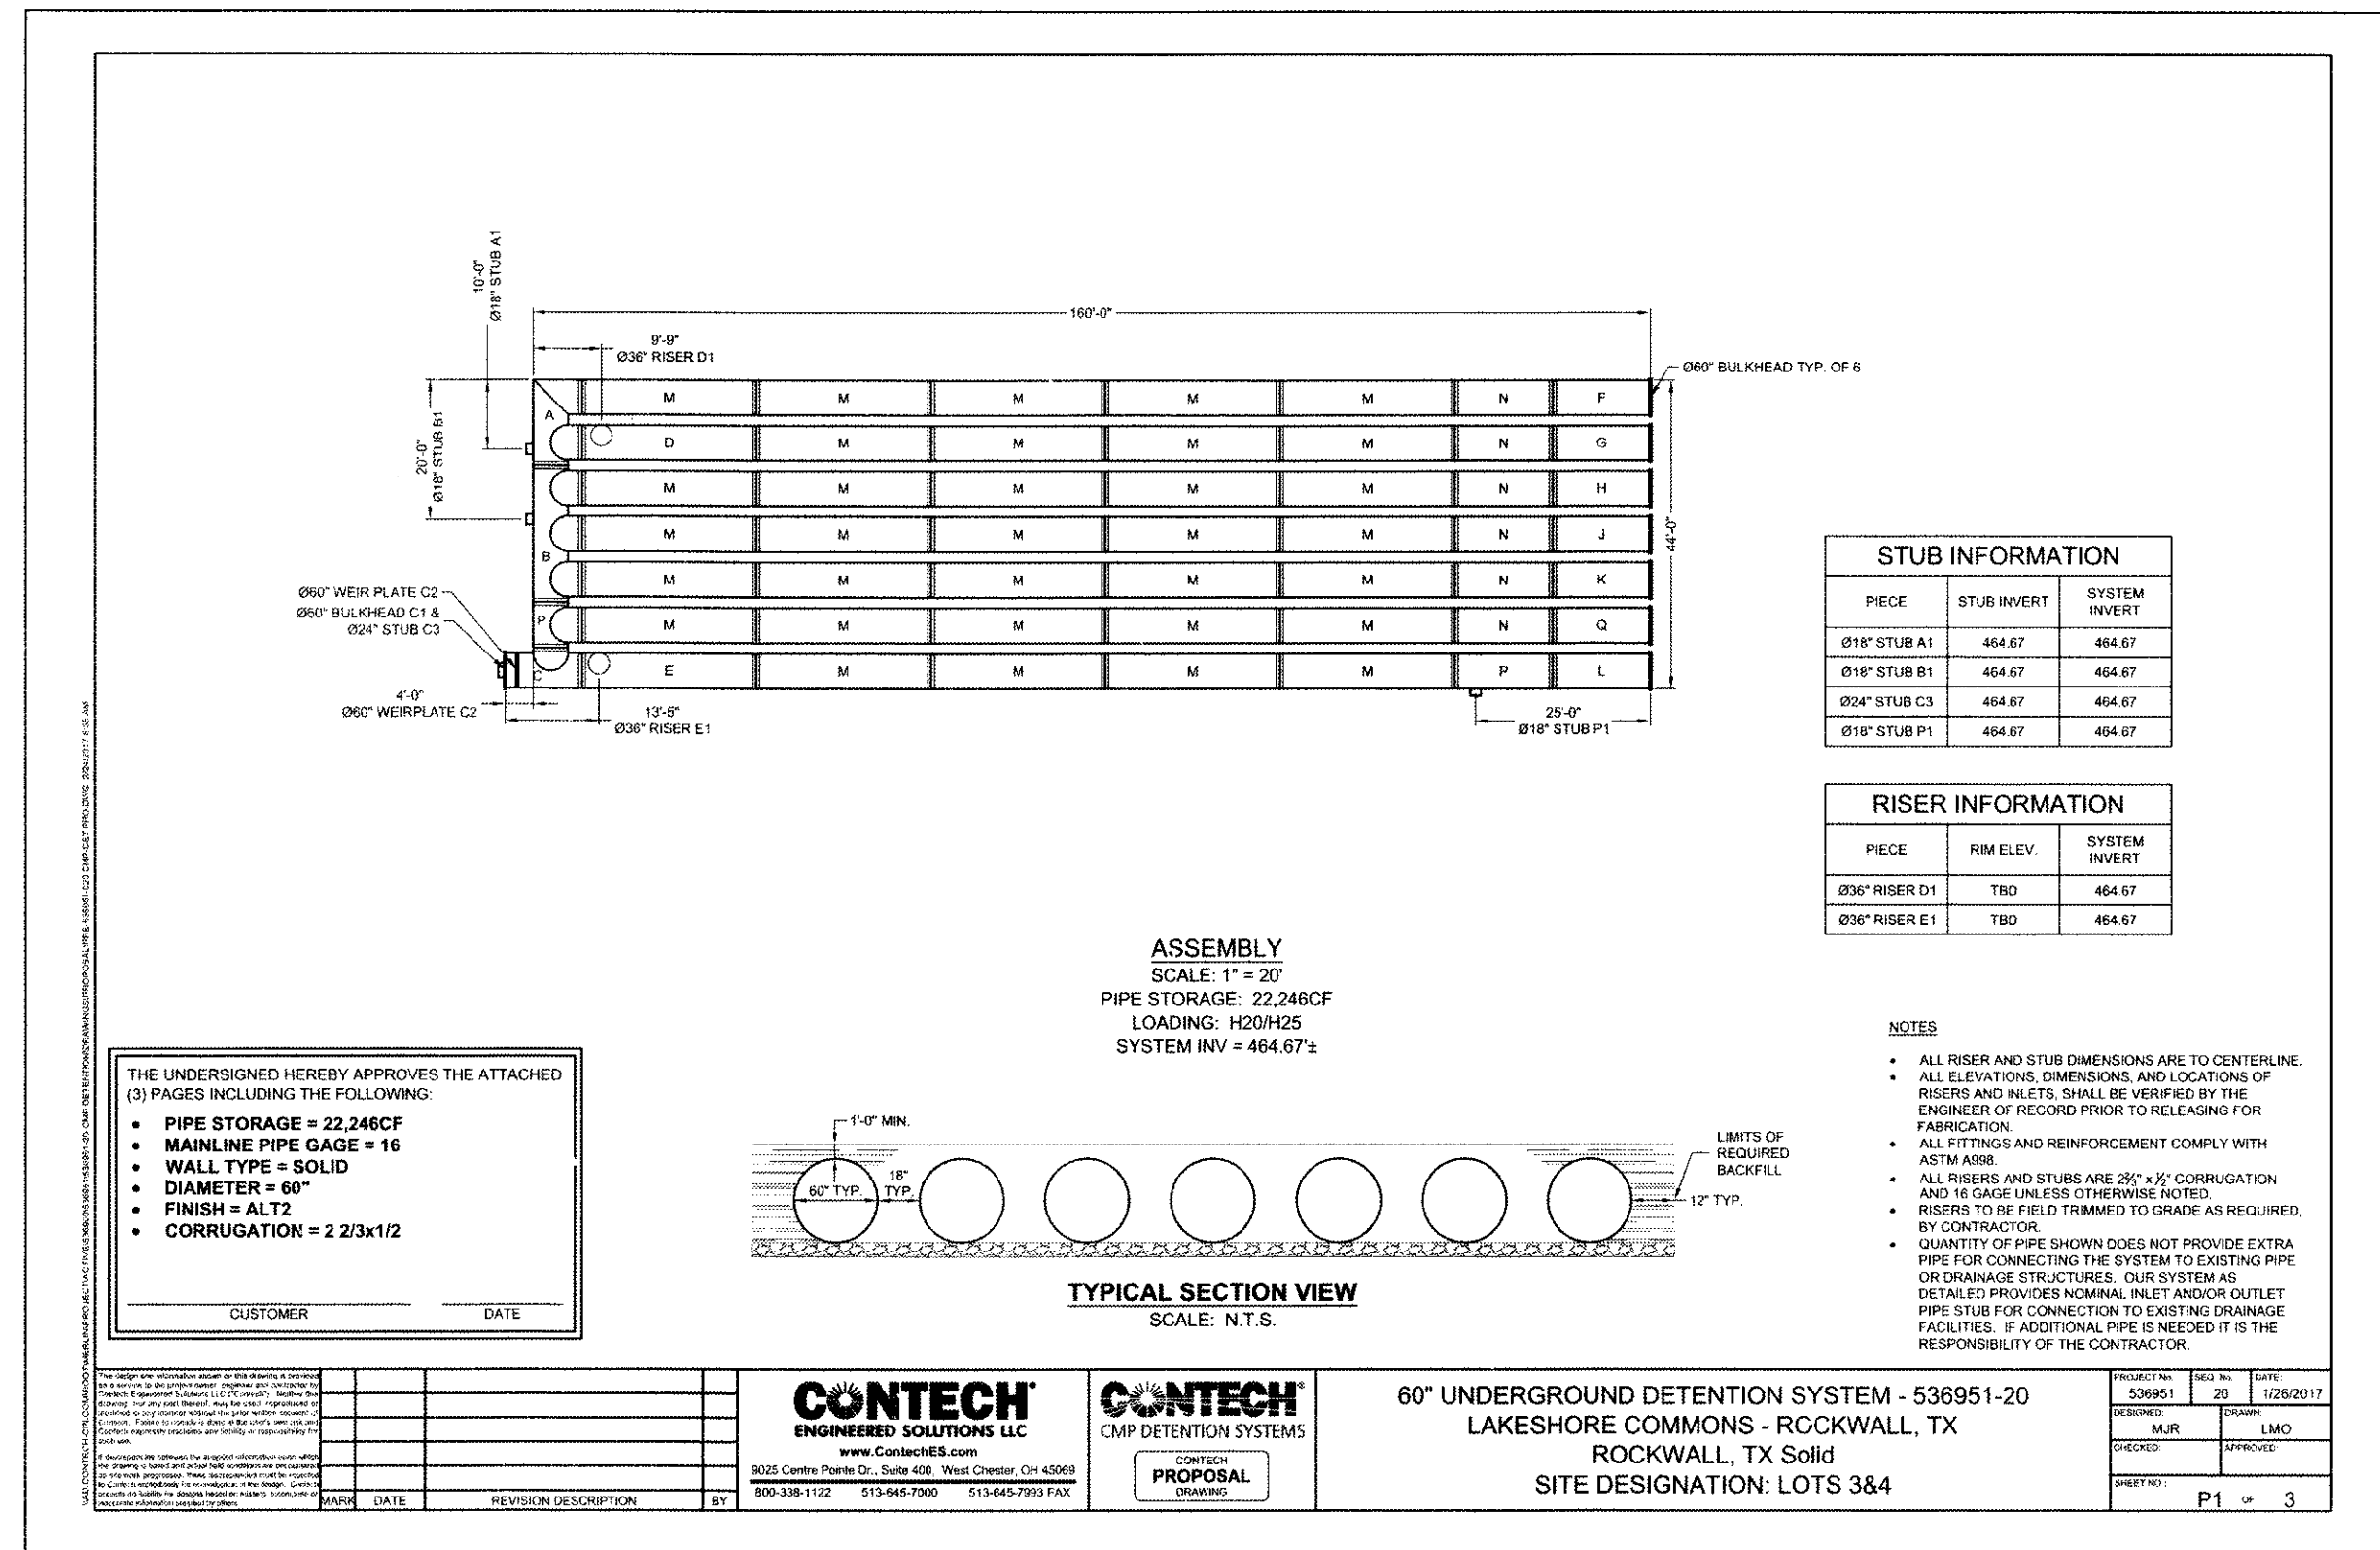

Note: Copyright © Hickman Consulting Engineers, Inc. All rights reserved. No part of this drawing may be reproduced by photocopying, recording or by any other means, or stored, processed or transmitted in any computer or other systems without the prior written permission of Hickman Consulting Engineers, Inc. Copies of this plan without an original signature and seal are not valid.

UDS LOTS 3 & 4 IS DESIGNED FOR FUTURE CONDITIONS

RECORD DRAWING

THIS RECORD DRAWING HAS BEEN PREPARED BASED ON INFORMATION PROVIDED BY OTHERS. THE ENGINEER HAS NOT VERIFIED THE ACCURACY OF THIS INFORMATION AND SHALL NOT BE RESPONSIBLE FOR ANY DISCREPANCIES WHICH MAY BE INCORPORATED HEREIN AS A RESULT.

Hickman Consulting Engineers, Inc.
 3094 County Road 1084
 Rockwall, TX 75084
 Phone: (972) 779-0900
 Fax: (972) 779-0901
 Email: mark@hickman-engineers.com
 Planners

UDS DETAILS
 LAKESHORE COMMONS
 LOT 1-4; LAKESHORE COMMONS
 ROCKWALL, ROCKWALL COUNTY, TEXAS
 MOORE WORTH INVESTMENTS, LLC
 8445 FREEMONT PARKWAY SUITE 175
 IRVING, TX 75063
 214-415-9893


DATE: 03/22/17
 SCALE: N/S
 DATE: SEP 2016
 DRAWN BY: FP
 CHK'D BY: MHH
 JOB NO: 1501-357
 FILE: 16-1501357-LWD
 DATE: 03/22/17

Hickman Consulting Engineers, Inc.
 MARK H. HICKMAN
 78409
 11/16 F-12172


DESCRIPTION: LOTS 3 AND 4

REVISION


SHEET C-9

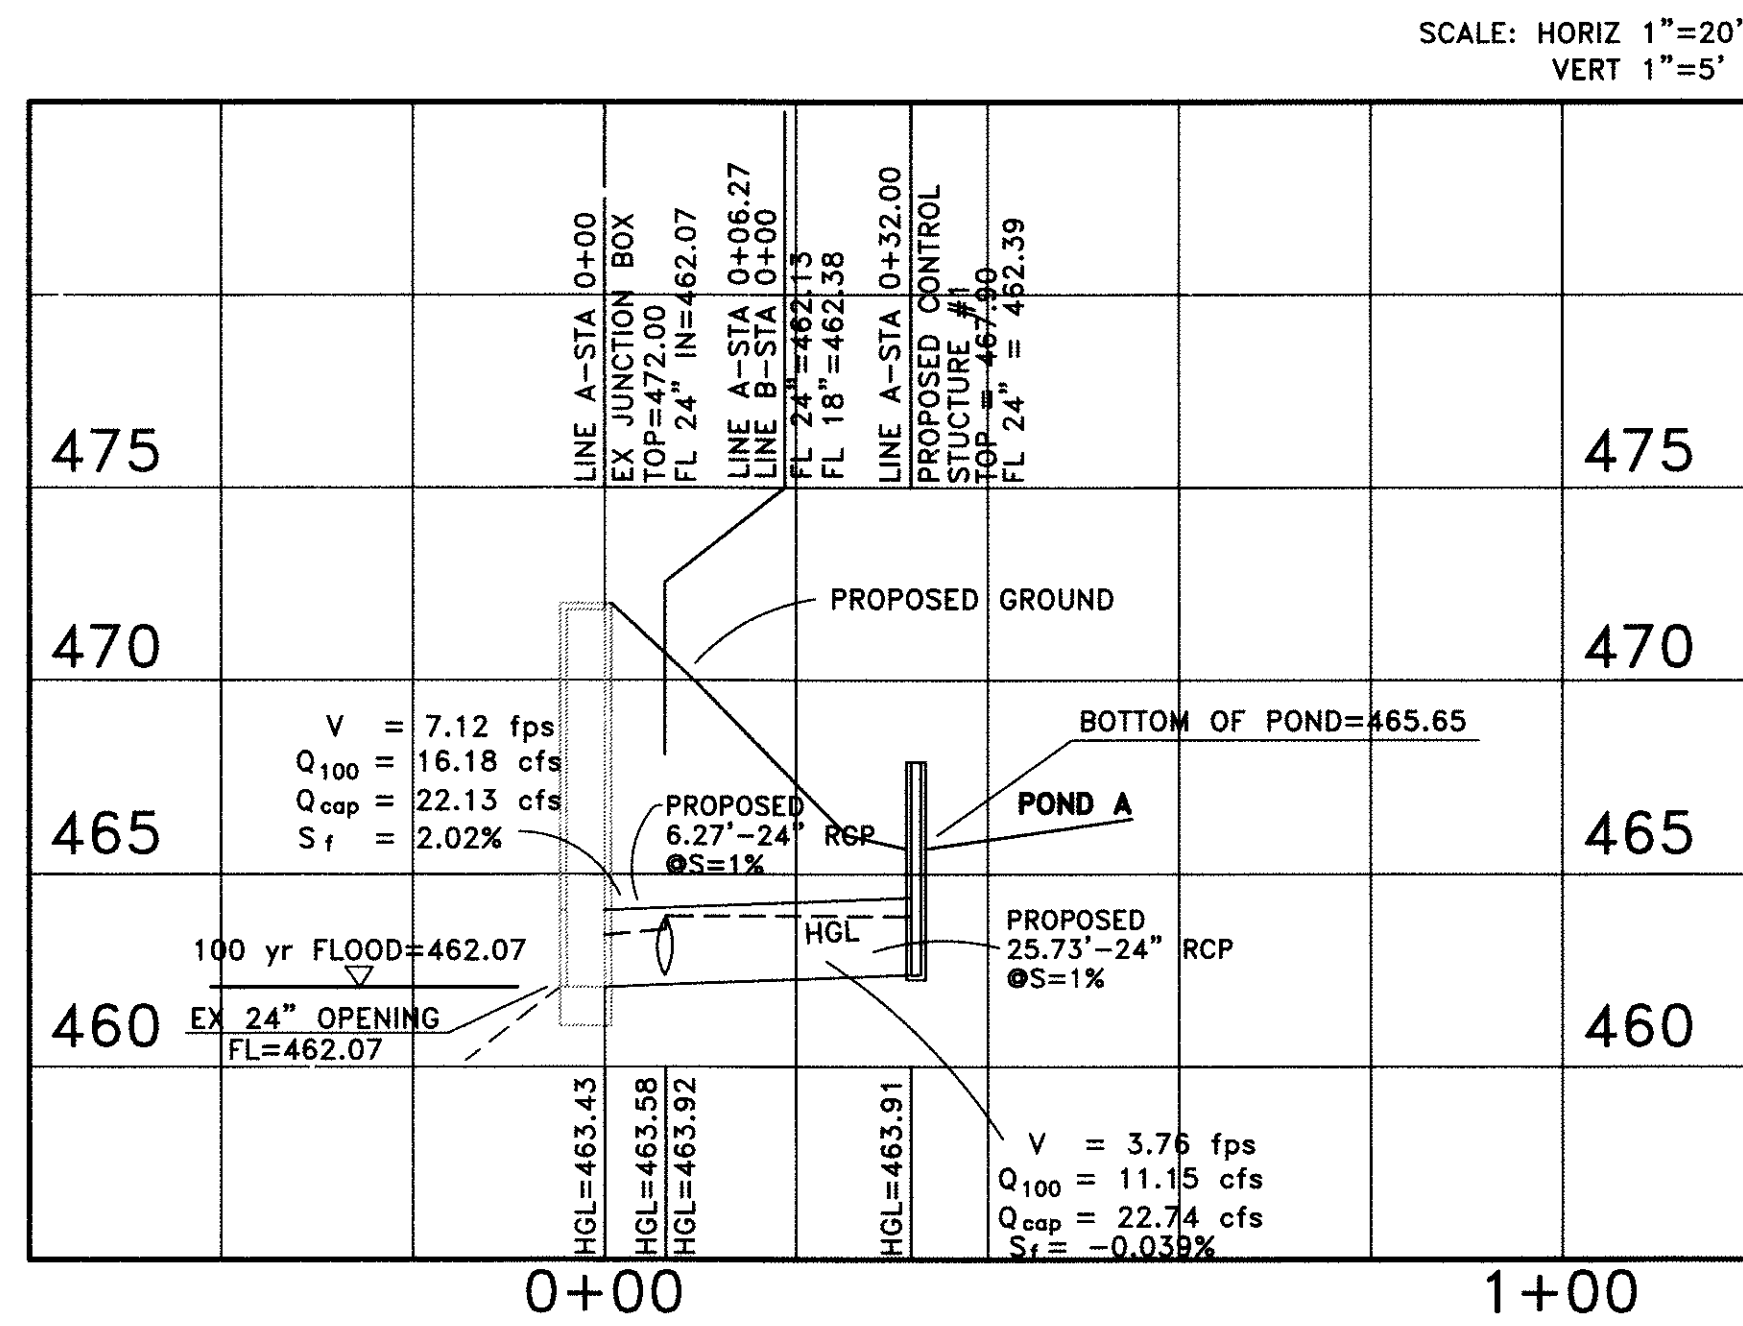


STORM SEWER PROFILE - LINE A

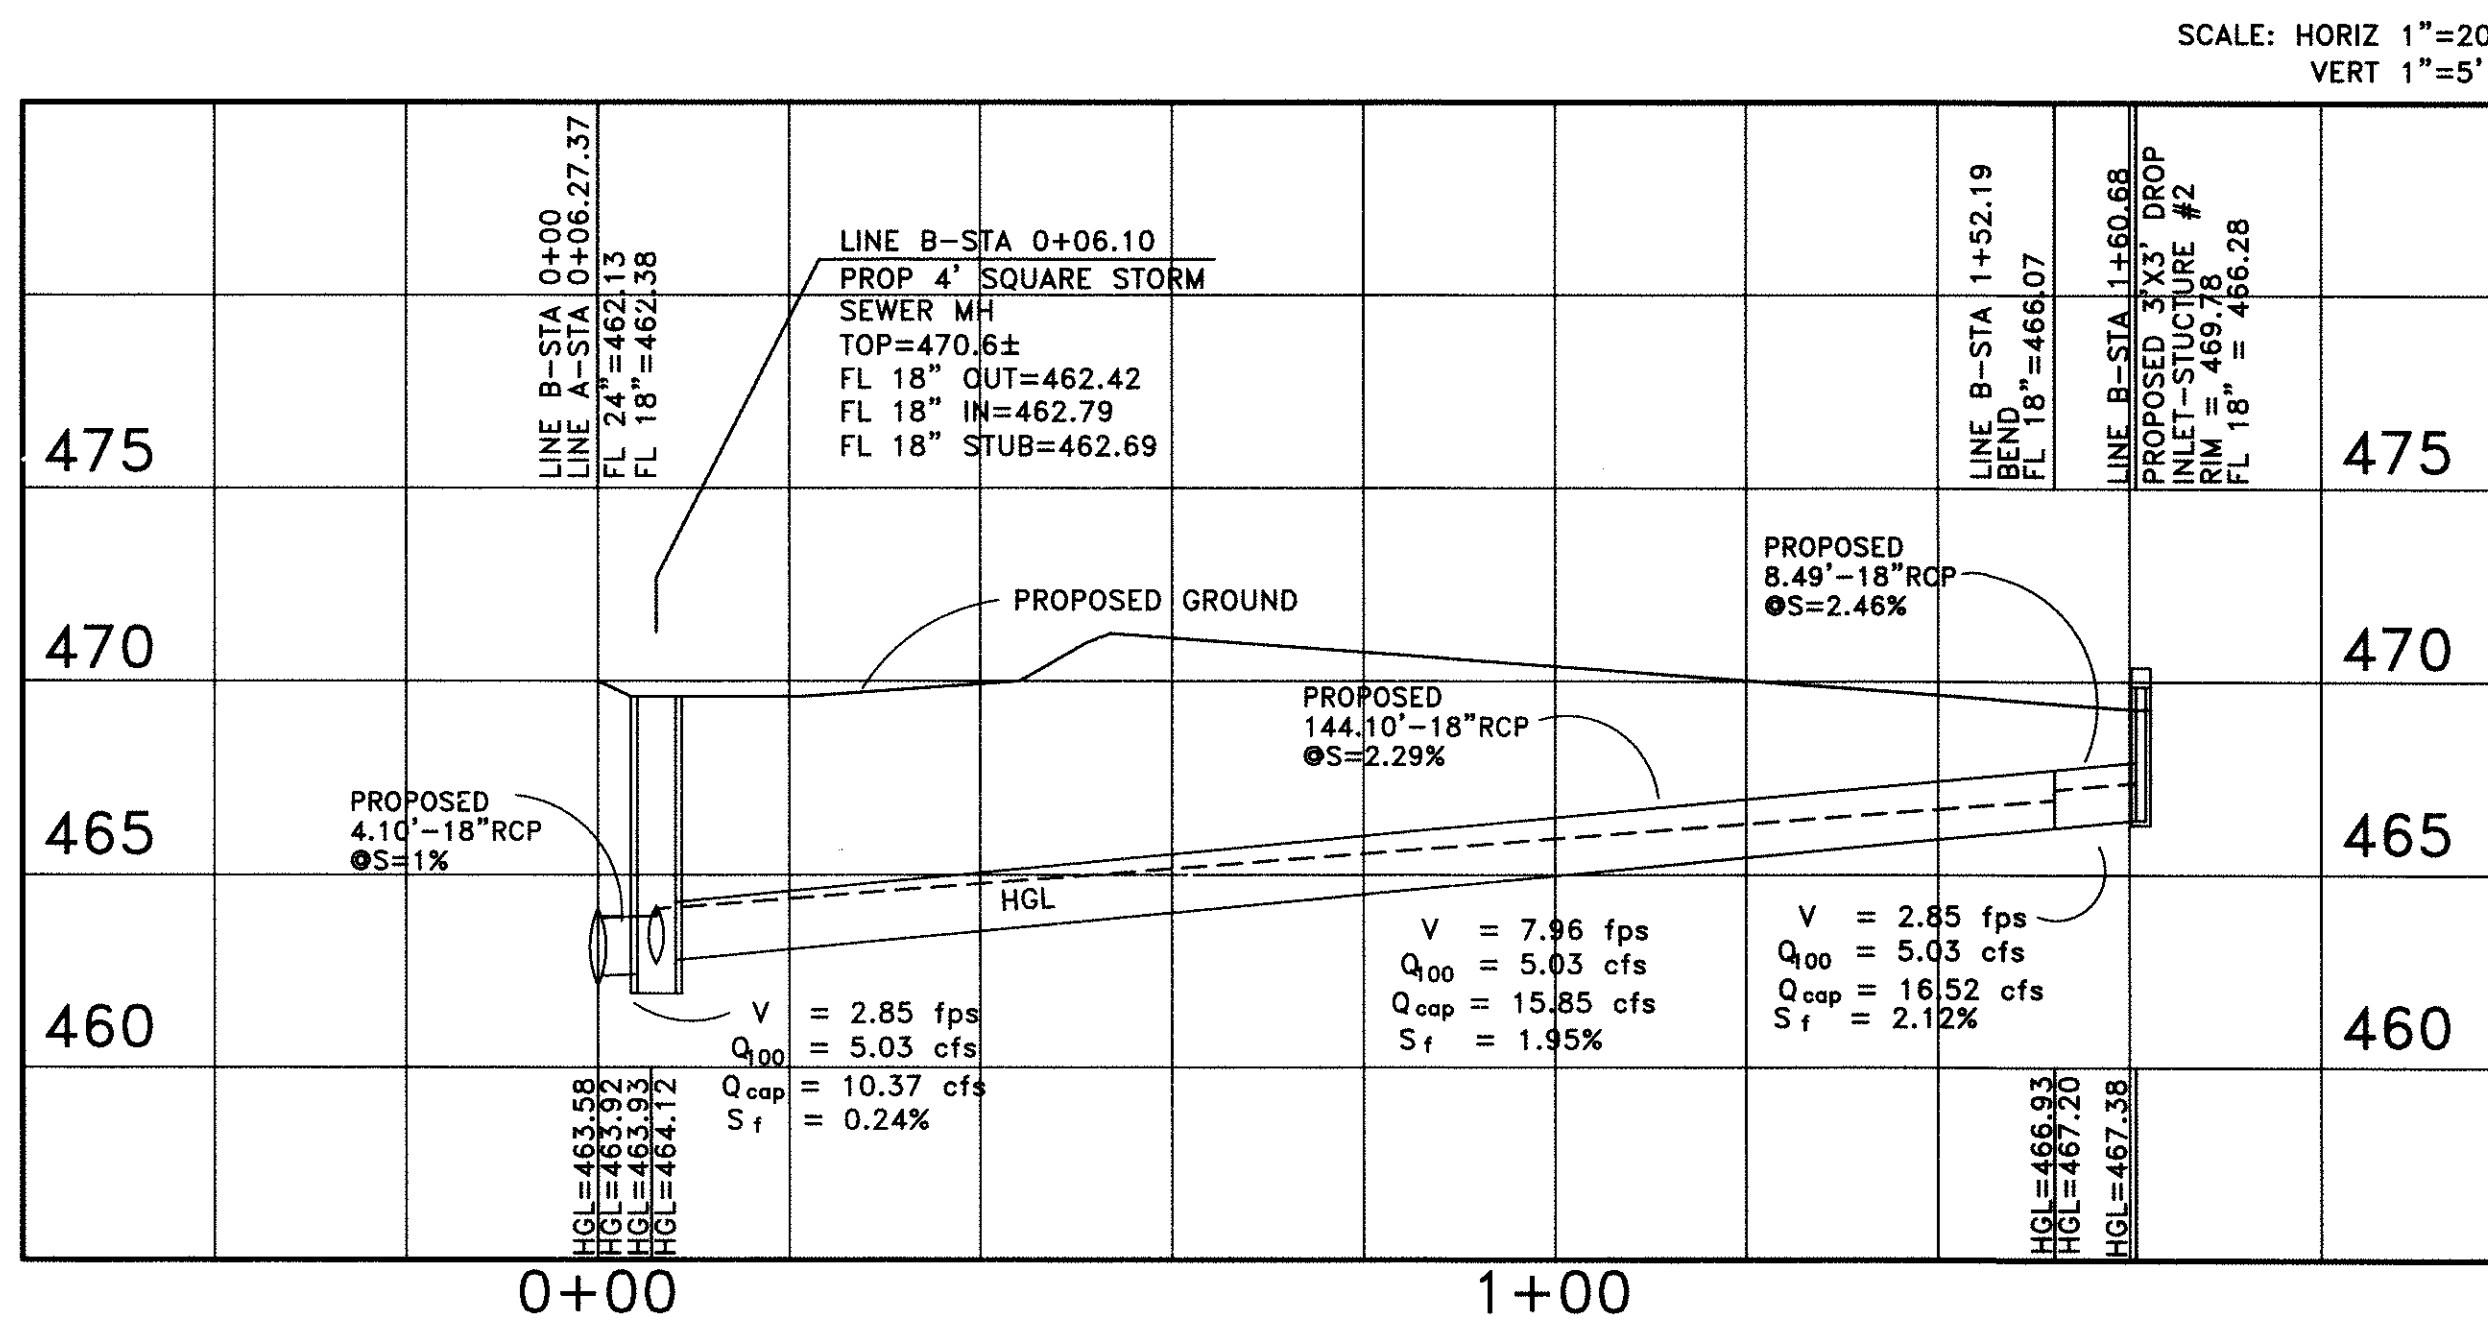

STORM SEWER PROFILE - LINE B

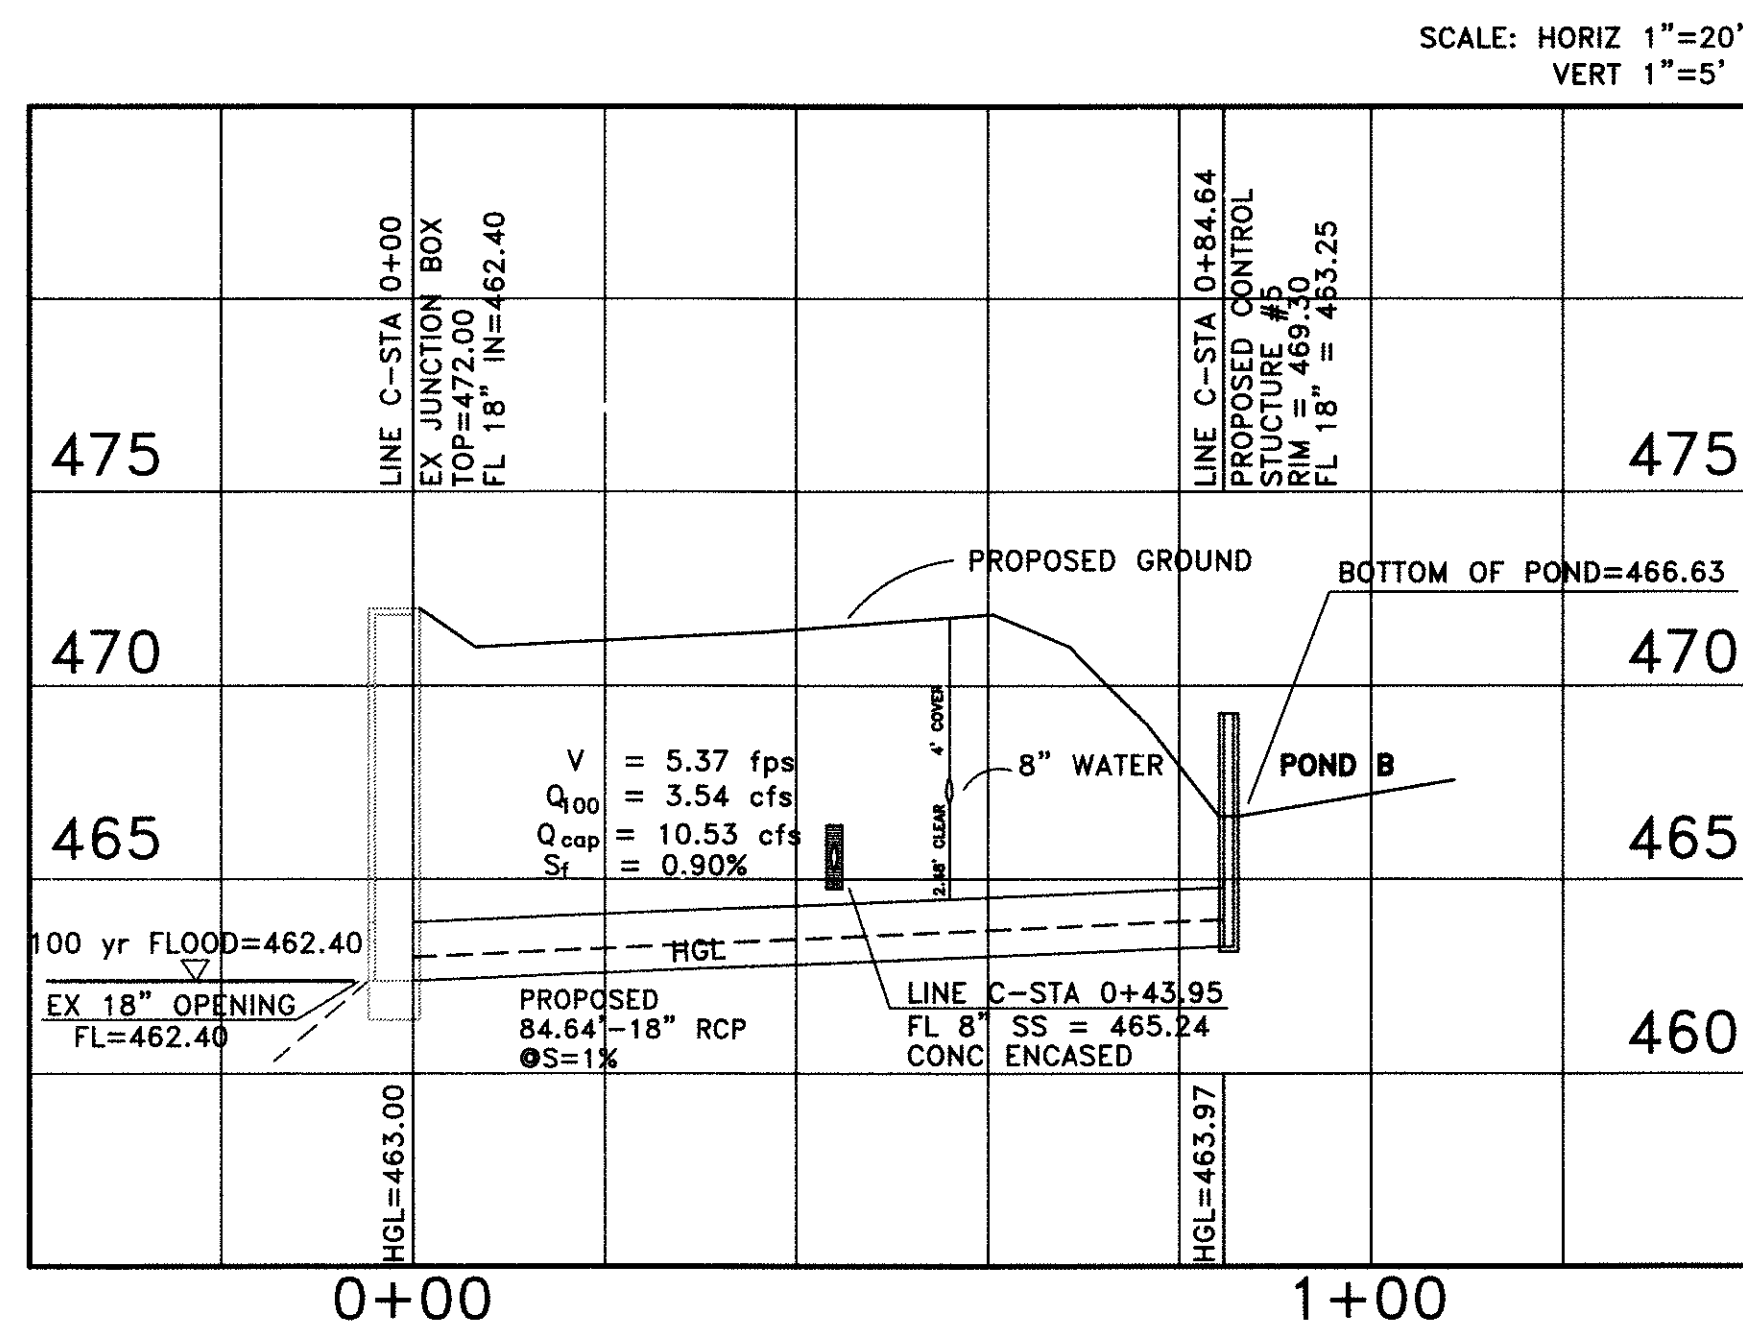

STORM SEWER PROFILE - LINE C

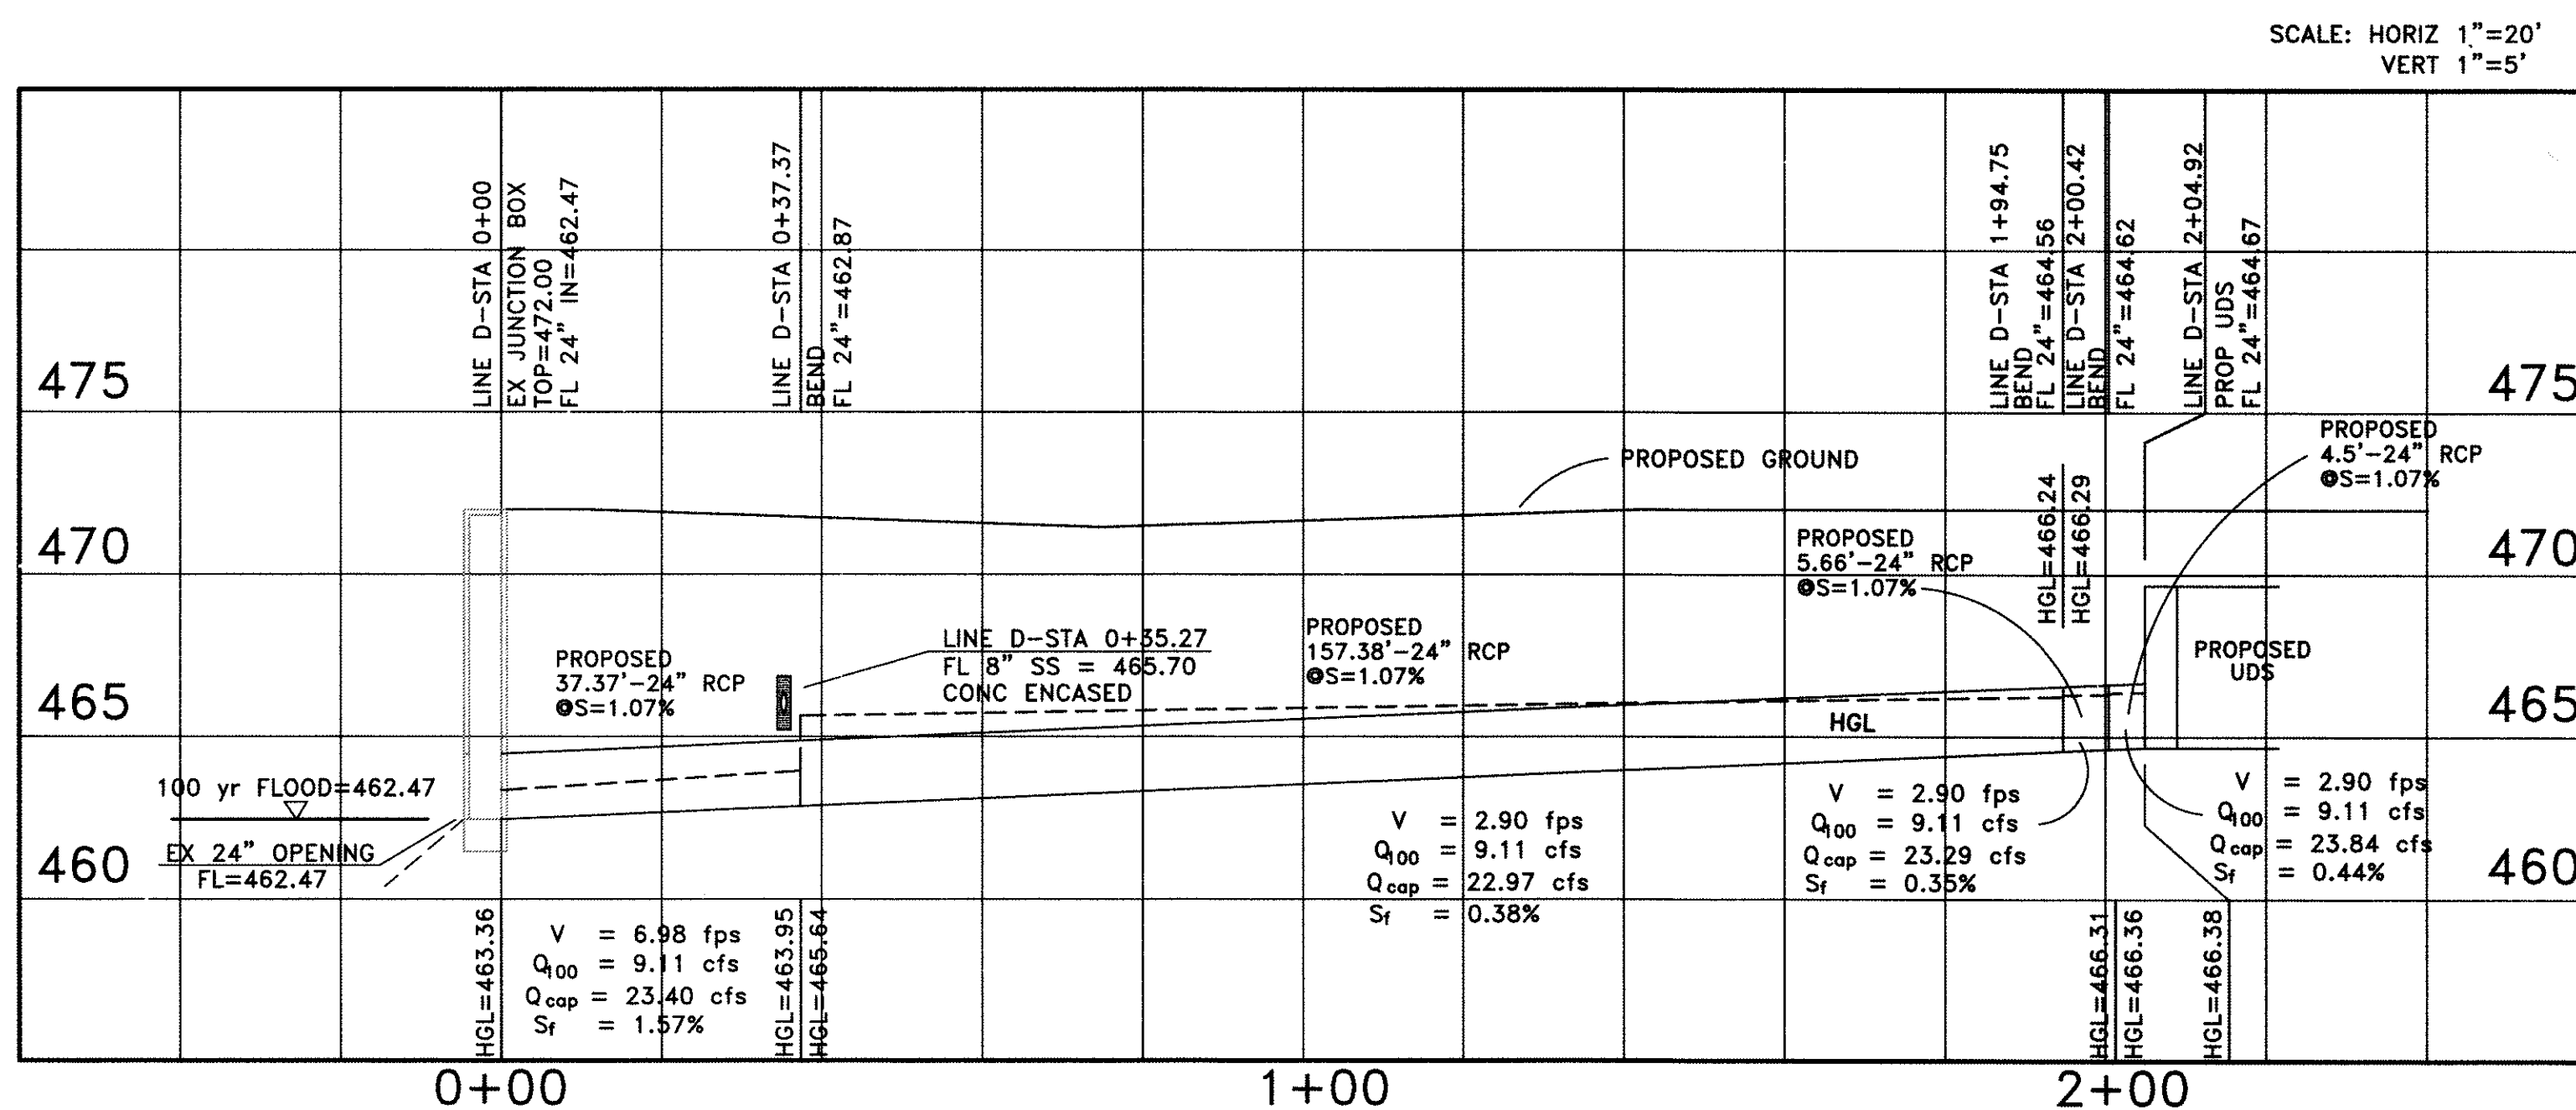

STORM SEWER PROFILE - LINE D

NOTE:
 CONC ENCASE WATER LINE WHERE
 9' OF HORIZONTAL & VERTICAL CLEARANCE
 TO SANITARY SEWER LINE CANNOT BE MAINTAINED
 ENCASEMENT SHALL BE CENTERED ON CROSSING
 AND EXTENDED 10' EACH WAY-TOTAL 20' ENCASEMENT

CONC ENCASE SANITARY SEWER LINE WHERE
 2' OF VERTICAL CLEARANCE TO STORM SEWER
 LINE CANNOT BE MAINTAINED
 ENCASEMENT SHALL BE CENTERED ON CROSSING
 AND EXTENDED 10' EACH WAY-TOTAL 20' ENCASEMENT

NOTES
 2) OPPOSITE BENCHMARK - STEEL ROD W/ ACCESS CAP STAMPED N 1486 1986 @ THE
 INTERSECTION OF THE NORTH LINE OF AIRPORT ROAD WITH THE
 WEST LINE OF THE AIRPORT ACCESS ROAD.
 ELEVATION = 466.70' (VERTICAL DATUM: NAD 1986)

BM#1 = 1/2" IRON ROD WITH CAP STAMPED "TROYALL TRAVELERS" LOCATED AT THE
 INTERSECTION OF THE SOUTH LINE OF LAKESHORE DRIVE WITH THE WEST LINE
 OF STATE HIGHWAY NO. 206.
 ELEVATION = 470.76'

BM#2 = 1" CUT ON TOP OF INLET IN THE NORTH LINE OF PECAN VALLEY DRIVE ± 564'
 WEST OF STATE HIGHWAY NO. 206.
 ELEVATION = 466.51'

Note: Copyright © Hickman Consulting Engineers, Inc. All rights reserved.
 No part of this drawing may be reproduced by photocopying, recording or
 by any other means, or stored, processed or transmitted in or by any
 computer or other systems without the prior written permission of Hickman
 Consulting Engineers, Inc. Copies of this plan without an original signature
 and seal are not valid.

RECORD DRAWING

THIS RECORD DRAWING HAS BEEN PREPARED
 BASED ON INFORMATION PROVIDED BY OTHERS.
 THE ENGINEER HAS NOT VERIFIED THE ACCURACY
 OF THIS INFORMATION AND SHALL NOT BE
 RESPONSIBLE FOR ANY DISCREPANCIES WHICH MAY
 BE INCORPORATED HEREIN AS A RESULT.

Hickman Consulting Engineers, Inc.
 3094 County Road 1024
 Farmersville, Texas 75442
 mark@hickman.com
 markrednick@gmail.com
 Engineers Planners

HCE

STORM SEWER PROFILES
 LAKESHORE COMMONS
 LOTS 1 - 4; LAKESHORE COMMONS
 ROCKWALL, ROCKWALL COUNTY, TEXAS
 MOORE WORTH INVESTMENTS, LLC
 8445 FREEMONT PARKWAY, SUITE 175
 IRVING, TX 75063
 214-415-9993

SCALE: AS SHOWN
 DATE: AUG2016
 DRAWN BY: FP
 CHK'D BY: MHH
 JOB NO: 1501-357
 FILE: 65-1501357-Low
 DATE SUBMITTED: 03/22/17 (E)

Hickman Consulting Engineers, Inc.
 REGISTERED PROFESSIONAL ENGINEER
 MARK H. HICKMAN
 78408
 F-12172

REVISION	DATE	BY	DESCRIPTION

SHEET
C-10


BEFORE YOU DIG CALL:
1-800-245-4545



TEXAS ONE CALL SYSTEM


NOTES:

1 BOUNDARY/TOPO SURVEY PROVIDED BY:
STOVALL & ASSOCIATES LAND SURVEYING
6417 WESLEY STREET
GREENVILLE, TEXAS 75402
903-450-1120

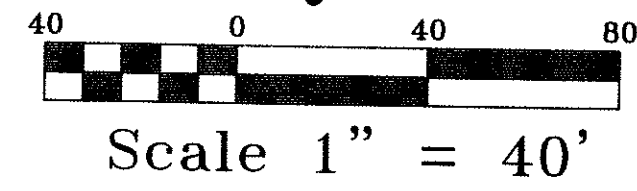

LEGEND	
PROPOSED	EXISTING
500 - PROPOSED CONTOURS	○ = POWER POLE
515.00 - SPOT ELEVATION AT FINISHED GRADE	○ = ANCHOR
514.00 - INDICATES TOP OF STRUCTURE	○ = WATER METER
513.50 - INDICATES FLOW LINE ELEVATION	○ = WATER VALVE
W - PROPOSED WATER LINE	○ = IRRIGATION CONTROL VALVE
SS - PROPOSED SANITARY SEWER LINE	○ = TELEPHONE PEDESTAL
SD - PROPOSED STORM DRAIN LINE	○ = GAS METER
○ - PROPOSED CONDUIT	○ = MAILBOX
○ - PROPOSED GAS	○ = LIGHT POLE
○ - CONCRETE CURB PER CITY STD	○ = FIRE HYDRANT
○ - WATER SERVICE TAP NO	○ = BUILDING LINE
	○ = UTILITY EASEMENT
	○ = DRAINAGE & UTILITY EASEMENT
	○ = FIBER OPTIC CABLE MARKER
	○ = GAS SIGN
	○ = SUB SURFACE SERVICE BOX
	○ = TRAFFIC SIGN
	○ = TRAFFIC SIGNAL
	○ = UTILITY EASEMENT
	○ = GAS STUB
	○ = GAS TEST STATION
	○ = BURIED CABLE SIGN

NOTE:
CONTRACTOR TO VERIFY HORIZONTAL & VERTICAL LOCATION OF ALL EXISTING UTILITIES PRIOR TO BEGINNING ANY CONSTRUCTION/EXCAVATION AND NOTIFY THE ENGINEER OF ANY DISCREPANCIES. EXISTING UTILITIES SHOWN ON THESE PLANS ARE BASED ON COMBINATION OF FIELD SURVEY & CITY RECORD DRAWINGS.

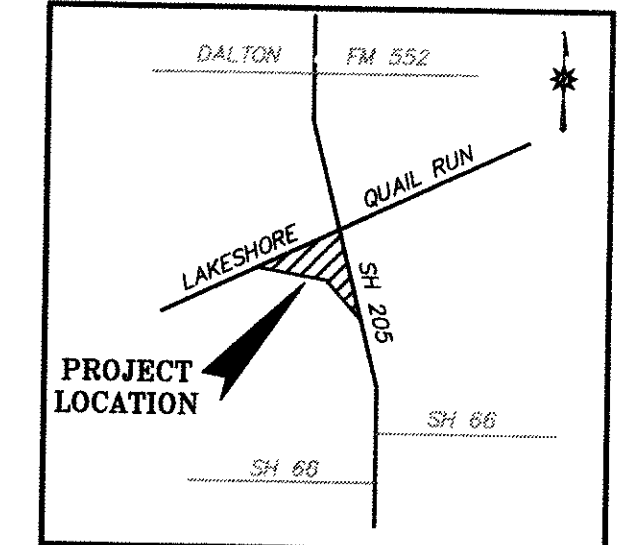

WATER & WASTEWATER NOTES:

- ALL WATER AND SANITARY SEWER MAIN CONSTRUCTION WITHIN PUBLIC RIGHT-OF-WAY OR EASEMENT SHALL CONFORM TO THE REQUIREMENTS OF THE TEXAS COMMISSION ON ENVIRONMENTAL QUALITY (TCEQ) GUIDELINES FOR CONSTRUCTION OF PUBLIC WATER AND SEWER SYSTEMS. WATER AND SANITARY SERVICES SHALL BE TESTED IN ACCORDANCE WITH CITY STANDARDS AND SPECIFICATIONS.
- CONSTRUCTION SHALL BE IN ACCORDANCE WITH THE CITY STANDARD SPECIFICATIONS & NCTCOG 3RD EDITION.
- CONTRACTOR SHALL MAINTAIN EXISTING SANITARY SEWER AND WATER SERVICE AT ALL TIMES DURING CONSTRUCTION.
- THE CONTRACTOR SHALL PROVIDE "AS-BUILT" PLANS TO THE OWNER SO THAT THE REPRODUCIBLES OF THE PLANS MAY BE CORRECTED TO REFLECT "AS-BUILT" CONDITIONS.
- THE CONTRACTOR SHALL BE REQUIRED TO MAINTAIN ALL NECESSARY WARNING AND SAFETY DEVICES (FLASHING LIGHTS, BARRICADES, SIGNS, ETC.) TO PROTECT THE PUBLIC SAFETY AND HEALTH UNTIL ALL WORK HAS BEEN COMPLETED AND ACCEPTED BY THE CITY.
- THE LOCATION OF EXISTING UTILITIES SHOWN ON THESE PLANS ARE APPROXIMATE. IT IS THE RESPONSIBILITY OF THE CONTRACTOR TO LOCATE AND VERIFY IN THE FIELD ANY UTILITIES THAT MAY CONFLICT WITH HIS CONSTRUCTION. CONTRACTOR IS RESPONSIBLE FOR ANY RELOCATION OR ADJUSTMENT COST ASSOCIATED WITH HIS WORK. AT LEAST 48 HOURS PRIOR TO BEGINNING CONSTRUCTION IN THE VICINITY OF EXISTING UNDERGROUND UTILITIES, THE CONTRACTOR SHALL NOTIFY UTILITY COMPANIES TO LOCATE ALL UNDERGROUND UTILITIES.
- ALL SANITARY SEWER PIPES SHALL BE SDR 35 CLASS 150 AND SHALL BE TESTED IN ACCORDANCE WITH CITY REQUIREMENTS.
- ALL DIMENSIONS SHOWN ARE TO CENTERLINE OF PIPE AND RIGHT-OF-WAY OR PROPERTY LINE, UNLESS NOTED OTHERWISE.
- WATER SERVICES SHALL BE POLY SDR 9, LOCATED AS INDICATED ON THE PLANS. METER BOXES SHALL MEET CITY SPECIFICATIONS.
- SANITARY SEWER LATERALS SHALL BE AS INDICATED ON THE PLAN.
- EMBEDMENTS SHALL BE PER CITY REQUIREMENTS.
- THE CONTRACTOR SHALL PROVIDE A TRENCH SAFETY PLAN AND BE RESPONSIBLE FOR FIELD VERIFYING ALL EXISTING UTILITY LOCATIONS PRIOR TO HIS WORK.
- ALL WATER METERS ARE TO BE LOCATED IN NON-TRAFFIC AREAS.
- CONSTRUCTION SHALL NOT PROCEED ABOVE THE FOUNDATION PRIOR TO COMPLETION OF ALL FIRE LANS AND FIRE HYDRANTS.
- ALL SANITARY SEWER LATERALS OUTSIDE OF EASEMENT SHALL BE INSPECTED BY THE CITY BUILDING INSPECTOR PRIOR TO BACKFILL.
- A CLEAR SPACE OF 5' SHALL BE MAINTAINED AROUND ALL FIRE HYDRANTS.
- WHEN TYING TO EXISTING MANHOLES, THE INVERT SHALL BE REWORKED.
- THE FIRE SYSTEM REQUIRES A SEPARATE PERMIT.
- PRIVATE WATER LINES AND SEWER LINES REQUIRE A SEPARATE PERMIT.
- WATER MAIN LINES TO BE CLASS 200 DR-14.
- ALL MANHOLES TO BE RAVEN LINED OR APPROVED EQUAL.
- INSTALL BLUE EMS DISK ON THE WATER LINES AT EVERY CHANGE IN DIRECTION, VALVE, SERVICE CONNECTION AND 250'.
- INSTALL GREEN EMS DISK ON THE SANITARY SEWER LINES AT EVERY CHANGE IN DIRECTION, MANHOLE, CLEANOUT AND SERVICE CONNECTION.
- MIN SEPARATION BETWEEN FIRE SPRINKLER LINE AND ALL OTHER UTILITIES SHALL BE 10'.
- MIN SEPARATION BETWEEN WATER & SANITARY SEWER LINES SHALL BE 10'.

- KEY NOTES:**
- 1 - 8"x2" TEE
2" PLUG
2" DOMESTIC SERVICE
W/TESTABLE BACKFLOW DEVICE W/DBL CHECK METER TO BE INSTALLED BY OTHERS
 - 1 - 8"x2" TEE
2" PLUG
2" IRRIGATION LINE
W/TESTABLE BACKFLOW DEVICE W/DBL CHECK METER TO BE INSTALLED BY OTHERS
 - 1 - 8"x8" TEE
6" VALVE
6" PLUG
FIRE SPRINKLER LINE
ALL UNDERGROUND FIRE LINE STUBS SHALL BE SEPARATELY PERMITTED AND INSPECTED BY THE FIRE DEPARTMENT

NOTES:

2) OPPOSITE BENCHMARK - STEEL ROD W/ACCESS CAP STAMPED N 1496 1986 @ THE INTERSECTION OF THE NORTH LINE OF AIRPORT ROAD WITH THE WEST LINE OF THE AIRPORT ACCESS ROAD.
ELEVATION = 466.70' (VERTICAL DATUM: NAVD 1988)

BM#1 = 1/2" IRON ROD WITH CAP STAMPED "STOVALL TRAVELER" LOCATED AT THE INTERSECTION OF THE SOUTH LINE OF LAKESHORE DRIVE WITH THE WEST LINE OF STATE HIGHWAY NO. 200.
ELEVATION = 475.79'


BM#2 = "C" CITY ON TOP OF INLET IN THE NORTH LINE OF PECAN VALLEY DRIVE ± 654' WEST OF STATE HIGHWAY NO. 200.
ELEVATION = 466.91'

Note: Copyright © Hickman Consulting Engineers, Inc. All rights reserved. No part of this drawing may be reproduced by photocopying, recording or by any other means, or stored, processed or transmitted in or by any computer or other systems without the prior written permission of Hickman Consulting Engineers, Inc. Copies of this plan without an original signature and seal are not valid.

RECORD DRAWING

THIS RECORD DRAWING HAS BEEN PREPARED BASED ON INFORMATION PROVIDED BY OTHERS. THE ENGINEER HAS NOT VERIFIED THE ACCURACY OF THIS INFORMATION AND SHALL NOT BE RESPONSIBLE FOR ANY DISCREPANCIES WHICH MAY BE INCORPORATED HEREIN AS A RESULT.

Hickman Consulting Engineers, Inc.
3094 County Road 1024
Farmers Branch, Texas 75442
Phone: (972) 779-2829
markredhick@gmail.com
markredhick@hickman.com
Engineers
Planners

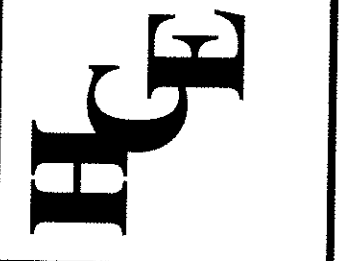

UTILITY PLAN
LAKESHORE COMMONS
LOTS 1 - 4; LAKESHORE COMMONS
ROCKWALL, ROCKWALL COUNTY, TEXAS
MOORE WORTH INVESTMENTS, LLC
8445 FREEMONT PARKWAY, SUITE 175
IRVING, TX 75063
214-415-9993

SCALE: 1"=40'
DATE: MAY 2016
DRAWN BY: FP
CHK'D BY: WHH
JOB NO: 1501-357
FILE: 165-1501357-1C-WO
DATE SUBMITTED: 03/22/17(17)



Hickman Consulting Engineers, Inc.
78409
F-12172

REVISION	DATE	DESCRIPTION

SHEET
C-13

NOTES

- 2) OPPOSITE BENCHMARK - STEEL ROD W/ ACCESS CAP STAMPED N 1495 1006 @ THE INTERSECTION OF THE NORTH LINE OF AIRPORT ROAD WITH THE WEST LINE OF THE AIRPORT ACCESS ROAD. ELEVATION = 586.70' (VERTICAL DATUM: NAVD 1988)
- BM#1 = 1/2" IRON ROD WITH CAP STAMPED "STOVALL TRAVELERS" LOCATED AT THE INTERSECTION OF THE SOUTH LINE OF LAKESHORE DRIVE WITH THE WEST LINE OF STATE HIGHWAY NO. 205. ELEVATION = 476.76'
- BM#2 = "X" CUT ON TOP OF INLET IN THE NORTH LINE OF PECAN VALLEY DRIVE ± 564' WEST OF STATE HIGHWAY NO. 205. ELEVATION = 468.31'

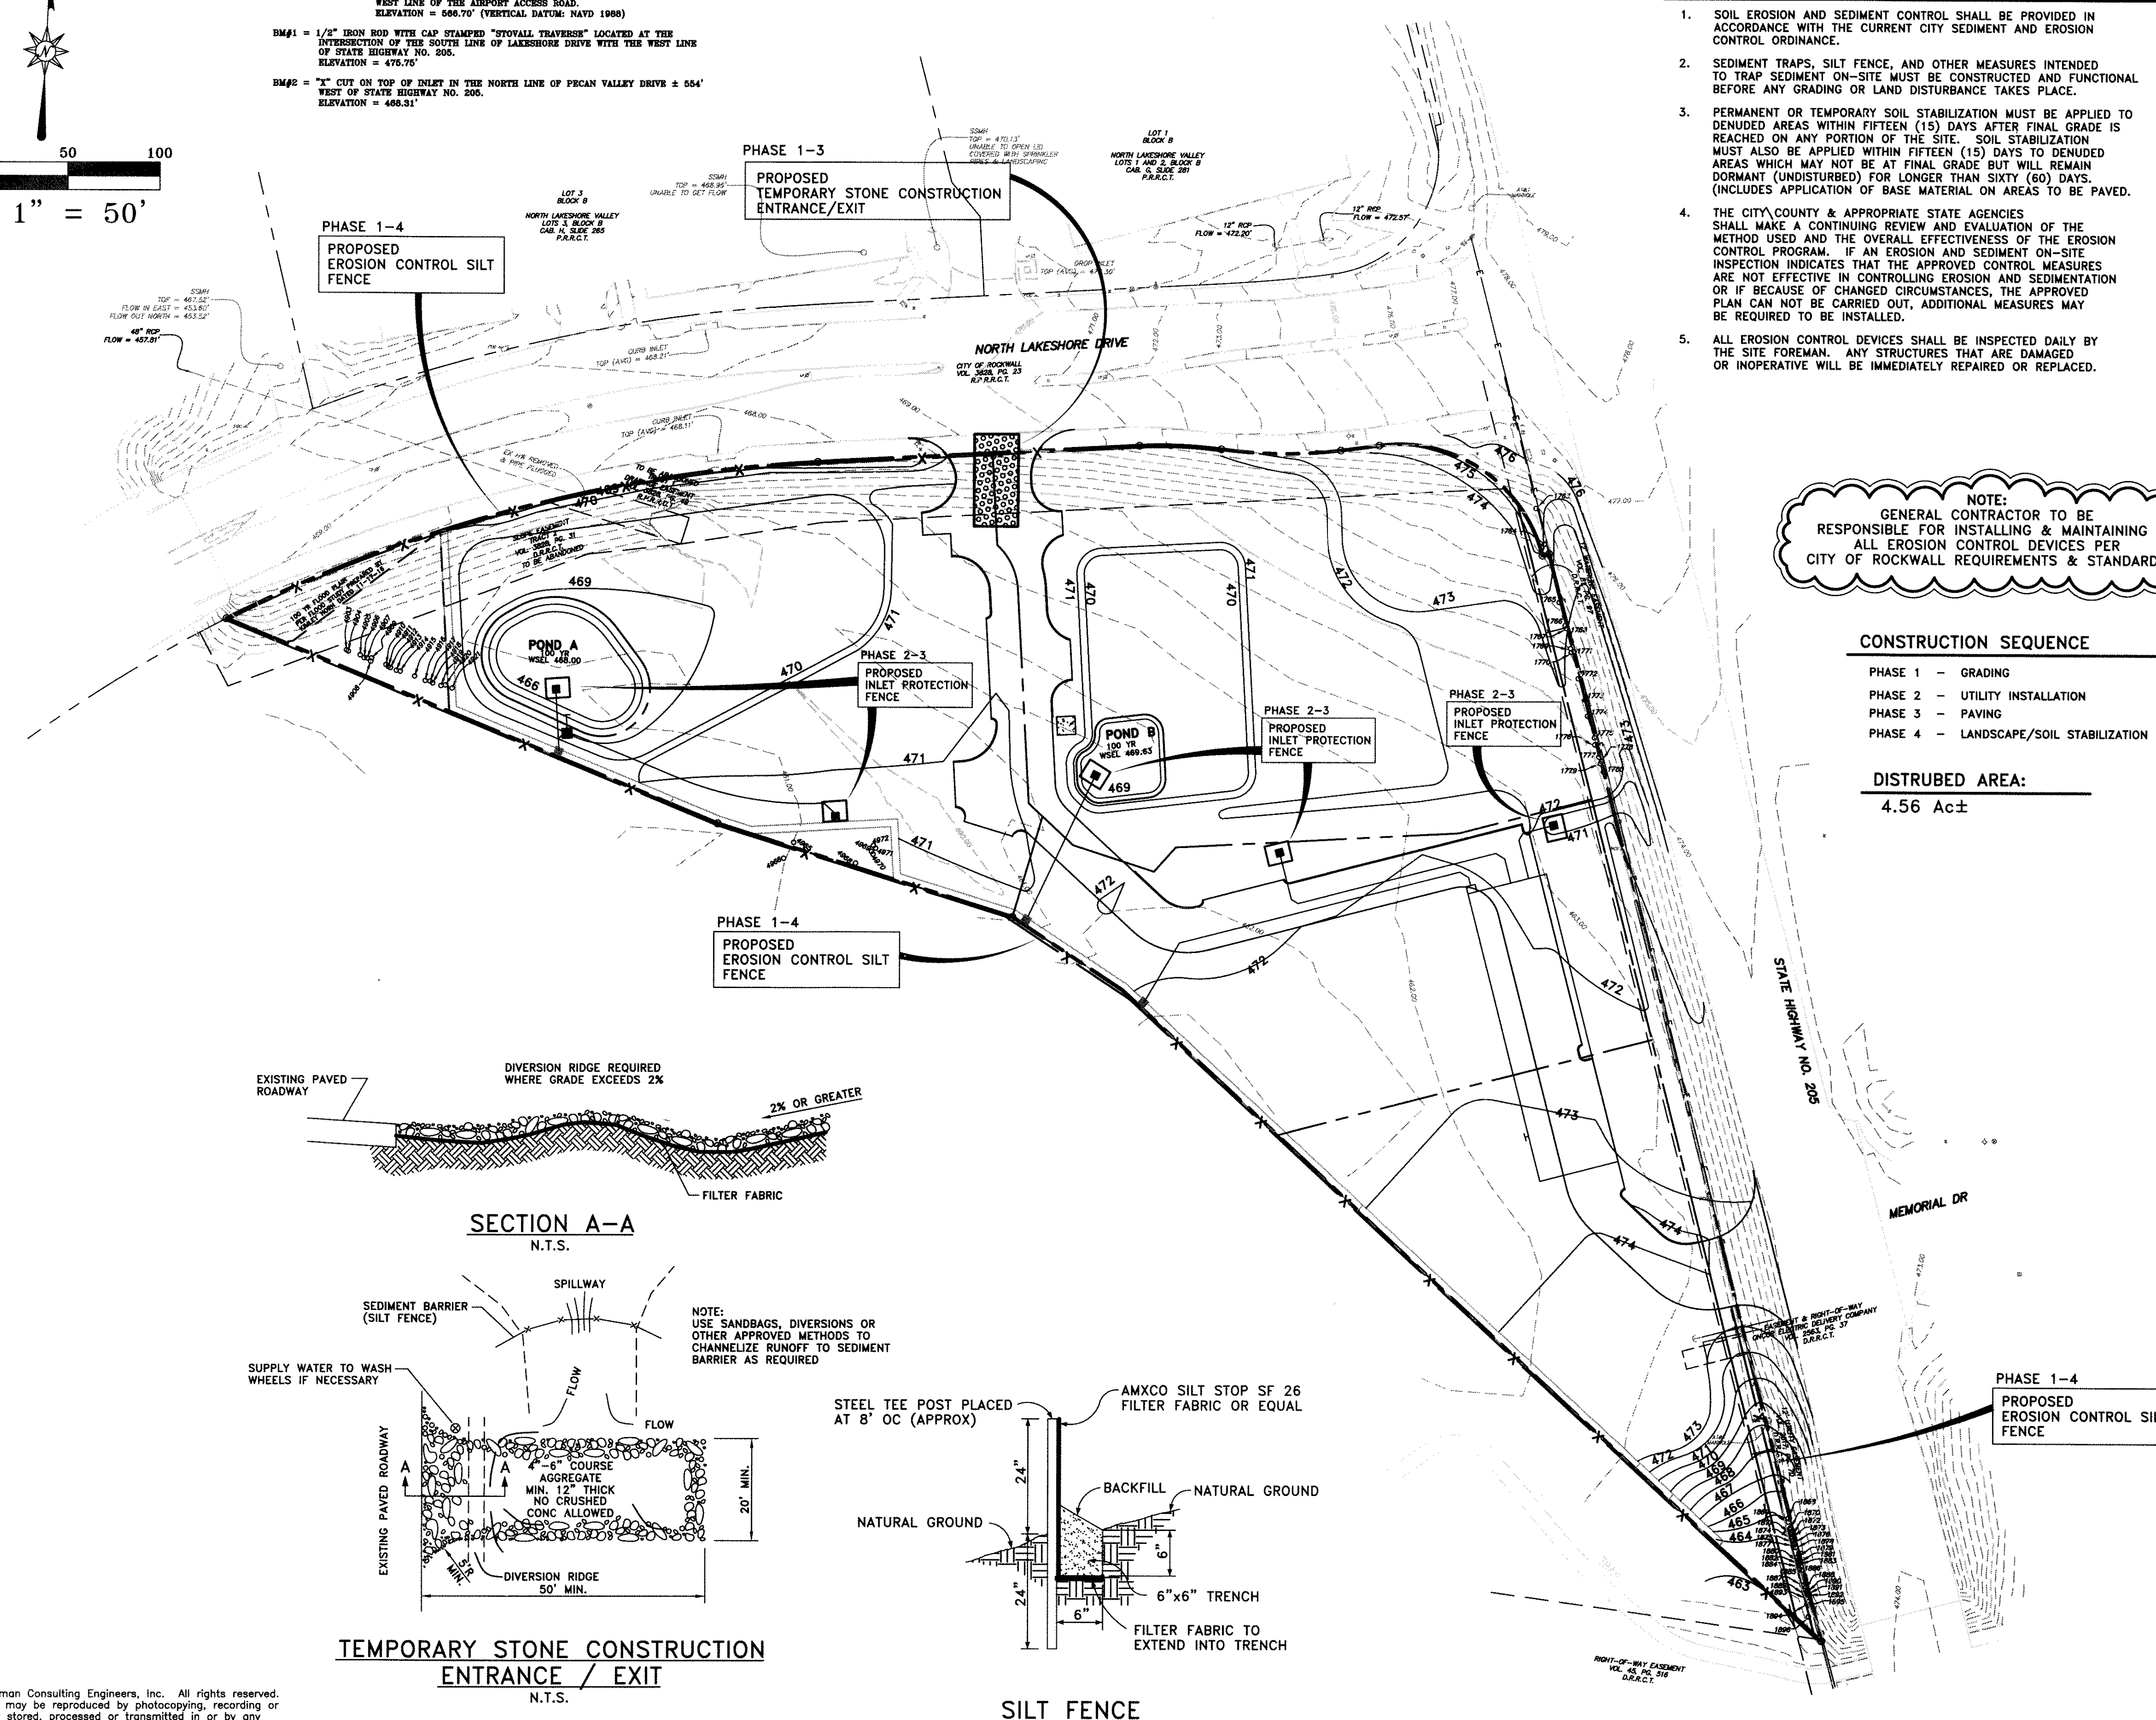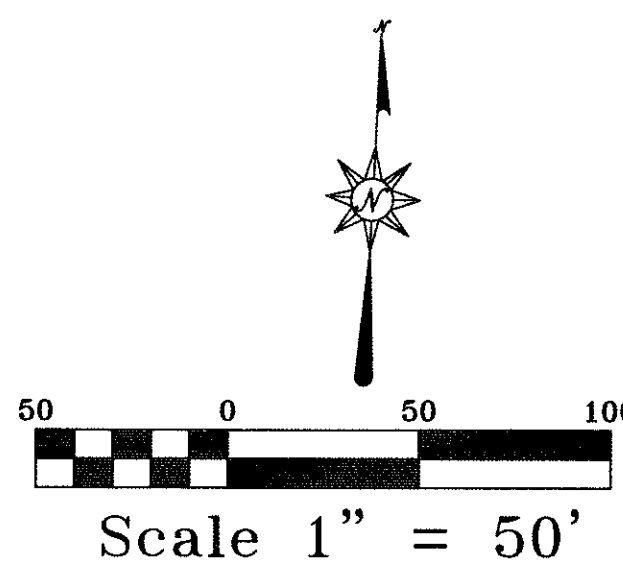

EROSION CONTROL NOTES

- SOIL EROSION AND SEDIMENT CONTROL SHALL BE PROVIDED IN ACCORDANCE WITH THE CURRENT CITY SEDIMENT AND EROSION CONTROL ORDINANCE.
- SEDIMENT TRAPS, SILT FENCE, AND OTHER MEASURES INTENDED TO TRAP SEDIMENT ON-SITE MUST BE CONSTRUCTED AND FUNCTIONAL BEFORE ANY GRADING OR LAND DISTURBANCE TAKES PLACE.
- PERMANENT OR TEMPORARY SOIL STABILIZATION MUST BE APPLIED TO DENUDED AREAS WITHIN FIFTEEN (15) DAYS AFTER FINAL GRADE IS REACHED ON ANY PORTION OF THE SITE. SOIL STABILIZATION MUST ALSO BE APPLIED WITHIN FIFTEEN (15) DAYS TO DENUDED AREAS WHICH MAY NOT BE AT FINAL GRADE BUT WILL REMAIN DORMANT (UNDISTURBED) FOR LONGER THAN SIXTY (60) DAYS. (INCLUDES APPLICATION OF BASE MATERIAL ON AREAS TO BE PAVED.)
- THE CITY/COUNTY & APPROPRIATE STATE AGENCIES SHALL MAKE A CONTINUING REVIEW AND EVALUATION OF THE METHOD USED AND THE OVERALL EFFECTIVENESS OF THE EROSION CONTROL PROGRAM. IF AN EROSION AND SEDIMENT ON-SITE INSPECTION INDICATES THAT THE APPROVED CONTROL MEASURES ARE NOT EFFECTIVE IN CONTROLLING EROSION AND SEDIMENTATION OR IF BECAUSE OF CHANGED CIRCUMSTANCES, THE APPROVED PLAN CAN NOT BE CARRIED OUT, ADDITIONAL MEASURES MAY BE REQUIRED TO BE INSTALLED.
- ALL EROSION CONTROL DEVICES SHALL BE INSPECTED DAILY BY THE SITE FOREMAN. ANY STRUCTURES THAT ARE DAMAGED OR INOPERATIVE WILL BE IMMEDIATELY REPAIRED OR REPLACED.
- CONTRACTOR TO CONSTRUCT A PIT OR WASH BASIN FOR "WASH OUT" OF CONCRETE TRUCKS. CONTRACTOR TO CONSTRUCT AN ENCLOSURE TO STORE ALL TRASH AND WASTE MATERIALS UNTIL PROPER DISPOSAL AT OFF-SITE FACILITY.
- CONTRACTOR TO SUPPLY SPILL PROTECTION FOR ANY TEMPORARY FUEL STORAGE TANK ON SITE DURING CONSTRUCTION.
- EROSION CONTROL DEVICES AS SHOWN ON THE EROSION CONTROL PLAN FOR THE PROJECT SHALL BE INSTALLED PRIOR TO THE START OF LAND DISTURBING ACTIVITIES ON THE PROJECT.
- ALL EROSION CONTROL DEVICES ARE TO BE INSTALLED IN ACCORDANCE WITH THE APPROVED PLANS AND SPECIFICATIONS FOR THE PROJECT. CHANGES ARE TO BE APPROVED BEFORE CONSTRUCTION BY THE DESIGN ENGINEER AND THE CITY ENGINEERING DEPT.
- IF THE EROSION CONTROL PLAN AS APPROVED CANNOT CONTROL EROSION AND OFF-SITE SEDIMENTATION FROM THE PROJECT THE EROSION CONTROL PLAN WILL BE REQUIRED TO BE REVISED AND/OR ADDITIONAL EROSION CONTROL DEVICES WILL BE REQUIRED ON SITE.
- IF OFF-SITE SOIL BORROW OR SPOIL SITES ARE USED IN CONJUNCTION WITH THIS PROJECT, THIS INFORMATION SHALL BE DISCLOSED AND SHOWN ON THE EROSION CONTROL PLAN. OFF-SITE BORROW AND SPOIL AREAS ARE CONSIDERED A PART OF THE PROJECT SITE AND THEREFORE SHALL COMPLY WITH CITY EROSION CONTROL REQUIREMENTS. THESE AREAS SHALL BE STABILIZED WITH PERMANENT GROUND COVER PRIOR TO FINAL APPROVAL OF THE PROJECT.
- MOWABLE VEGETATION SHALL BE ESTABLISHED PRIOR TO RECEIVING A CERTIFICATE OF OCCUPANCY.

NOTE:
GENERAL CONTRACTOR TO BE RESPONSIBLE FOR INSTALLING & MAINTAINING ALL EROSION CONTROL DEVICES PER CITY OF ROCKWALL REQUIREMENTS & STANDARDS

CONSTRUCTION SEQUENCE

- PHASE 1 - GRADING
- PHASE 2 - UTILITY INSTALLATION
- PHASE 3 - PAVING
- PHASE 4 - LANDSCAPE/SOIL STABILIZATION

DISTURBED AREA:

4.56 Ac±

SILT FENCE




SILT FENCE SHOULD BE INSPECTED WEEKLY AND AFTER MAJOR RAIN EVENTS TO ENSURE THAT THE DEVICE IS FUNCTIONING PROPERLY. REMOVE SEDIMENT FROM BEHIND FENCE WHEN THE DEPTH OF SEDIMENT HAS BUILT UP TO ONE-THIRD THE HEIGHT OF THE FENCE ABOVE GRADE. INSPECT THE BASE OF THE FENCE TO ENSURE THAT NO GAPS HAVE DEVELOPED AND RE-TRENCH AS NECESSARY. INSPECT FENCE POSTS TO ENSURE THAT THEY ARE PROPERLY SUPPORTING THE FENCE. STRAIGHTEN, RESET AND ADD POSTS IF NECESSARY. IF FILTER FABRIC IS RIPPED, DAMAGED OR DETERIORATED, REPLACE IT IN ACCORDANCE WITH THE ORIGINAL SPECIFICATIONS AND DETAILS.

INLET PROTECTION

CURB INLET PROTECTION SHOULD BE INSPECTED WEEKLY AND AFTER MAJOR RAIN EVENTS TO ENSURE THAT THE DEVICE IS FUNCTIONING PROPERLY. REMOVE SEDIMENT FROM THE STORAGE AREA WHEN THE DEPTH OF SEDIMENT HAS BUILT UP TO ONE-HALF OF THE STORAGE DEPTH. IF DEWATERING OF THE STORAGE VOLUME IS NOT OCCURRING, CLEAN OR REPLACE THE FILTER STONE. CLEAN THE FILTER STONE SURFACE THE FIRST FEW TIMES BY RAKING. REPEATED SEDIMENT BUILD-UP WILL REQUIRE FILTER STONE REPLACEMENT.

CONSTRUCTION ENTRANCE

INSPECTIONS SHOULD BE MADE WEEKLY AND AFTER RAIN STORM EVENTS TO ENSURE THAT THE DEVICE IS FUNCTIONING PROPERLY. WHEN SEDIMENT OR MUD HAS CLOGGED THE VOID SPACES BETWEEN THE STONES OR MUD IS BEING TRACKED ONTO THE PUBLIC ROADWAY THE AGGREGATE PAD MUST BE WASHED DOWN OR REPLACED. RUNOFF FROM THE WASHDOWN OPERATION SHALL NOT BE ALLOWED TO DRAIN DIRECTLY OFF SITE WITHOUT FIRST FLOWING THROUGH ANOTHER BMP TO CONTROL OFF-SITE SEDIMENTATION. PERIODIC RE-GRADING OR THE ADDITION OF NEW STONE MAY BE REQUIRED TO MAINTAIN THE EFFICIENCY OF THE INSTALLATION.

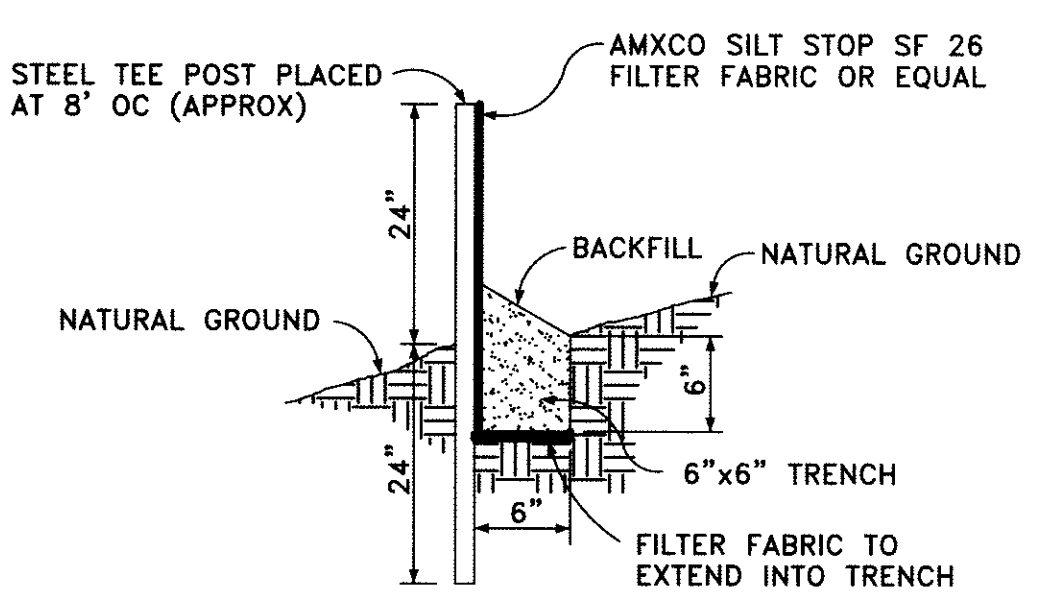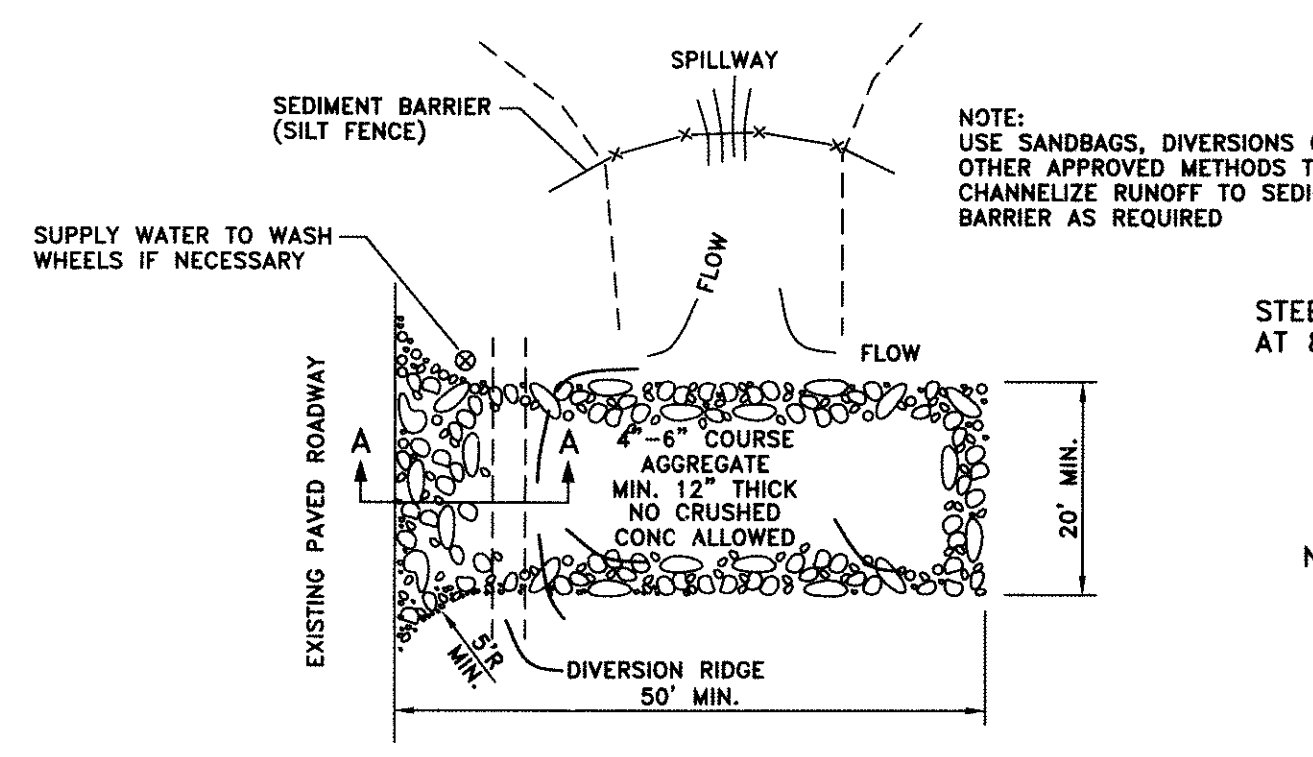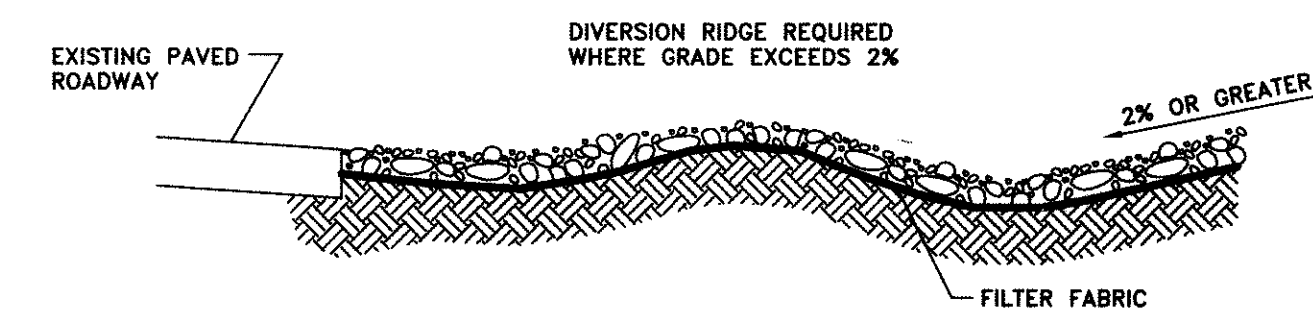


RECORD DRAWING

THIS RECORD DRAWING HAS BEEN PREPARED BASED ON INFORMATION PROVIDED BY OTHERS. THE ENGINEER HAS NOT VERIFIED THE ACCURACY OF THIS INFORMATION AND SHALL NOT BE RESPONSIBLE FOR ANY DISCREPANCIES WHICH MAY BE INCORPORATED HEREIN AS A RESULT.

Hickman Consulting Engineers, Inc.
3084 County Road 1024
Farmersville, TX 76742
Ph: (972) 784-2499
markredhick@gmail.com
Engineers Planners

EROSION CONTROL PLAN
LAKESHORE COMMONS
LOTS 1 - 4; LAKESHORE COMMONS
ROCKWALL, ROCKWALL COUNTY, TEXAS
MOORE WORTH INVESTMENTS, LLC
8445 FREEMPT PARKWAY, SUITE 175
IRVING, TX 75063
214-415-9993

SCALE: 1"=50'
DATE: AUG 2016
DRAWN BY: FP
CHK'D BY: MHH
JOB NO: 1501-357
FILE: 148-1501357-LWD
DATE SUBMITTED: 03/22/17(F)

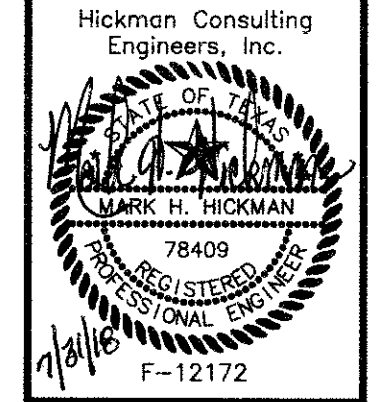


REVISION	DATE	DESCRIPTION

SHEET
C-14

Note: Copyright © Hickman Consulting Engineers, Inc. All rights reserved. No part of this drawing may be reproduced by photocopying, recording or by any other means, or stored, processed or transmitted in or by any computer or other systems without the prior written permission of Hickman Consulting Engineers, Inc. Copies of this plan without an original signature and seal are not valid.

GENERAL NOTES:

- 1) ALL WORK WITHIN RIGHT-OF-WAY SHALL CONFORM TO CITY STANDARDS AND DETAILS & NCTCOG 3RD EDITION.
- 2) EXISTING UTILITIES SHOWN ARE FROM AVAILABLE RECORDS. LOCATIONS SHOWN ARE GENERALLY SCHEMATIC IN NATURE AND MAY NOT ACCURATELY REFLECT THE SIZE AND LOCATION OF EACH PARTICULAR UTILITY. SOME UTILITY LINES MAY NOT BE SHOWN. CONTRACTOR SHALL ASSUME RESPONSIBILITY FOR ACTUAL FIELD LOCATION AND PROTECTION OF EXISTING FACILITIES WHETHER SHOWN OR NOT. CONTRACTOR SHALL ALSO ASSUME RESPONSIBILITY FOR REPAIRS TO EXISTING FACILITIES, WHETHER SHOWN OR NOT, DAMAGED BY CONTRACTOR'S ACTIVITIES. DIFFERENCES IN HORIZONTAL OR VERTICAL LOCATIONS EXISTING UTILITIES SHALL NOT BE A BASIS FOR ADDITIONAL EXPENSES.
- 3) TRAFFIC FLOW AND ACCESS SHALL BE MAINTAINED DURING ALL PHASES OF THE CONSTRUCTION. THE CONTRACTOR IS RESPONSIBLE FOR PROVIDING TRAFFIC SAFETY MEASURES FOR WORK WITHIN THE PUBLIC RIGHT-OF-WAY.
- 4) THE CONTRACTOR SHALL PROVIDE MATERIAL AND QUALITY CONTROL TESTING AS REQUIRED BY OWNER. TESTS SHALL INCLUDE BUT NOT BE LIMITED TO THE FOLLOWING:
 - DENSITY TESTS FOR GENERAL SITE FILL. (MINIMUM ONE TEST PER LIFT PER 10,000 SF. FILL.)
 - DENSITY TESTS FOR UTILITY TRENCH BACK FILL (MINIMUM ONE TEST PER 100 L.F. ON EVERY OTHER LIFT)
 - CONCRETE CYLINDER TESTS. (MINIMUM 4 CYLINDERS PER 100 C.Y. OF MATERIAL.)
- 5) CONTRACTOR SHALL MAINTAIN DRAINAGE AT ALL TIMES DURING CONSTRUCTION. PONDING OF WATER IN STREETS, DRIVES, TRUCK COURTS, TRENCHES, ETC. WILL NOT BE ALLOWED.
- 6) PAVEMENT REMOVAL AND REPAIR SHALL CONFORM TO CITY GUIDELINES. ALL SAW CUTS SHALL BE FULL DEPTH CUTS. CONTRACTOR SHALL MAKE EFFORTS TO PROTECT CONCRETE EDGES. ANY LARGE SPALLED OR BROKEN EDGES SHALL BE REMOVED BY SAW CUTTING PAVEMENT PRIOR TO REPLACEMENT. DOWEL NEW PAVEMENT TO EXISTING CONCRETE PAVEMENT WITH #6 SMOOTH DOWELS AT 15" C-C EACH FACE. DRILL DOWELS TO A DEPTH OF 12 INCHES AND GROUT OR EPOXY IN PLACE.
- 7) EARTHWORK OPERATIONS SHALL BE PERFORMED UNDER THE SUPERVISION OF QUALIFIED PERSONNEL WORKING IN CONJUNCTION WITH THE PROJECT GEOTECHNICAL ENGINEER.
- 8) CONCRETE CURB TO BE CONSTRUCTED PER CITY STANDARDS.
- 9) SEE LANDSCAPE PLAN PRIOR TO ANY CLEARING AND/OR GRUBBING TO LOCATE WHICH TREES AND SHRUBS WILL REMAIN OR BE RELOCATED.
- 10) REVIEW UTILITY PLAN PRIOR TO ANY CLEARING AND/OR GRUBBING.
- 11) REMOVE ALL EXISTING TREES, BUSHES, AND/OR SHRUBS IN THE PATH OF THE SIDEWALK CONSTRUCTION. SPECIAL LANDSCAPE FEATURES TO BE REPLACED WHEN DETERMINED BY THE CITY ENGINEER.
- 12) ALL EXPANSION JOINTS TO BE CONSTRUCTED AT EVERY 40 FEET, AT CURBS AND AT ALL DRIVEWAYS.
- 13) ALL CONSTRUCTION JOINTS SHALL BE PLACED AT 4 OR 5 FOOT INTERVALS ON 4 FOOT WIDE SIDEWALK AND AT EVERY 6 FOOT INTERVALS ON 6 FOOT SIDEWALKS.

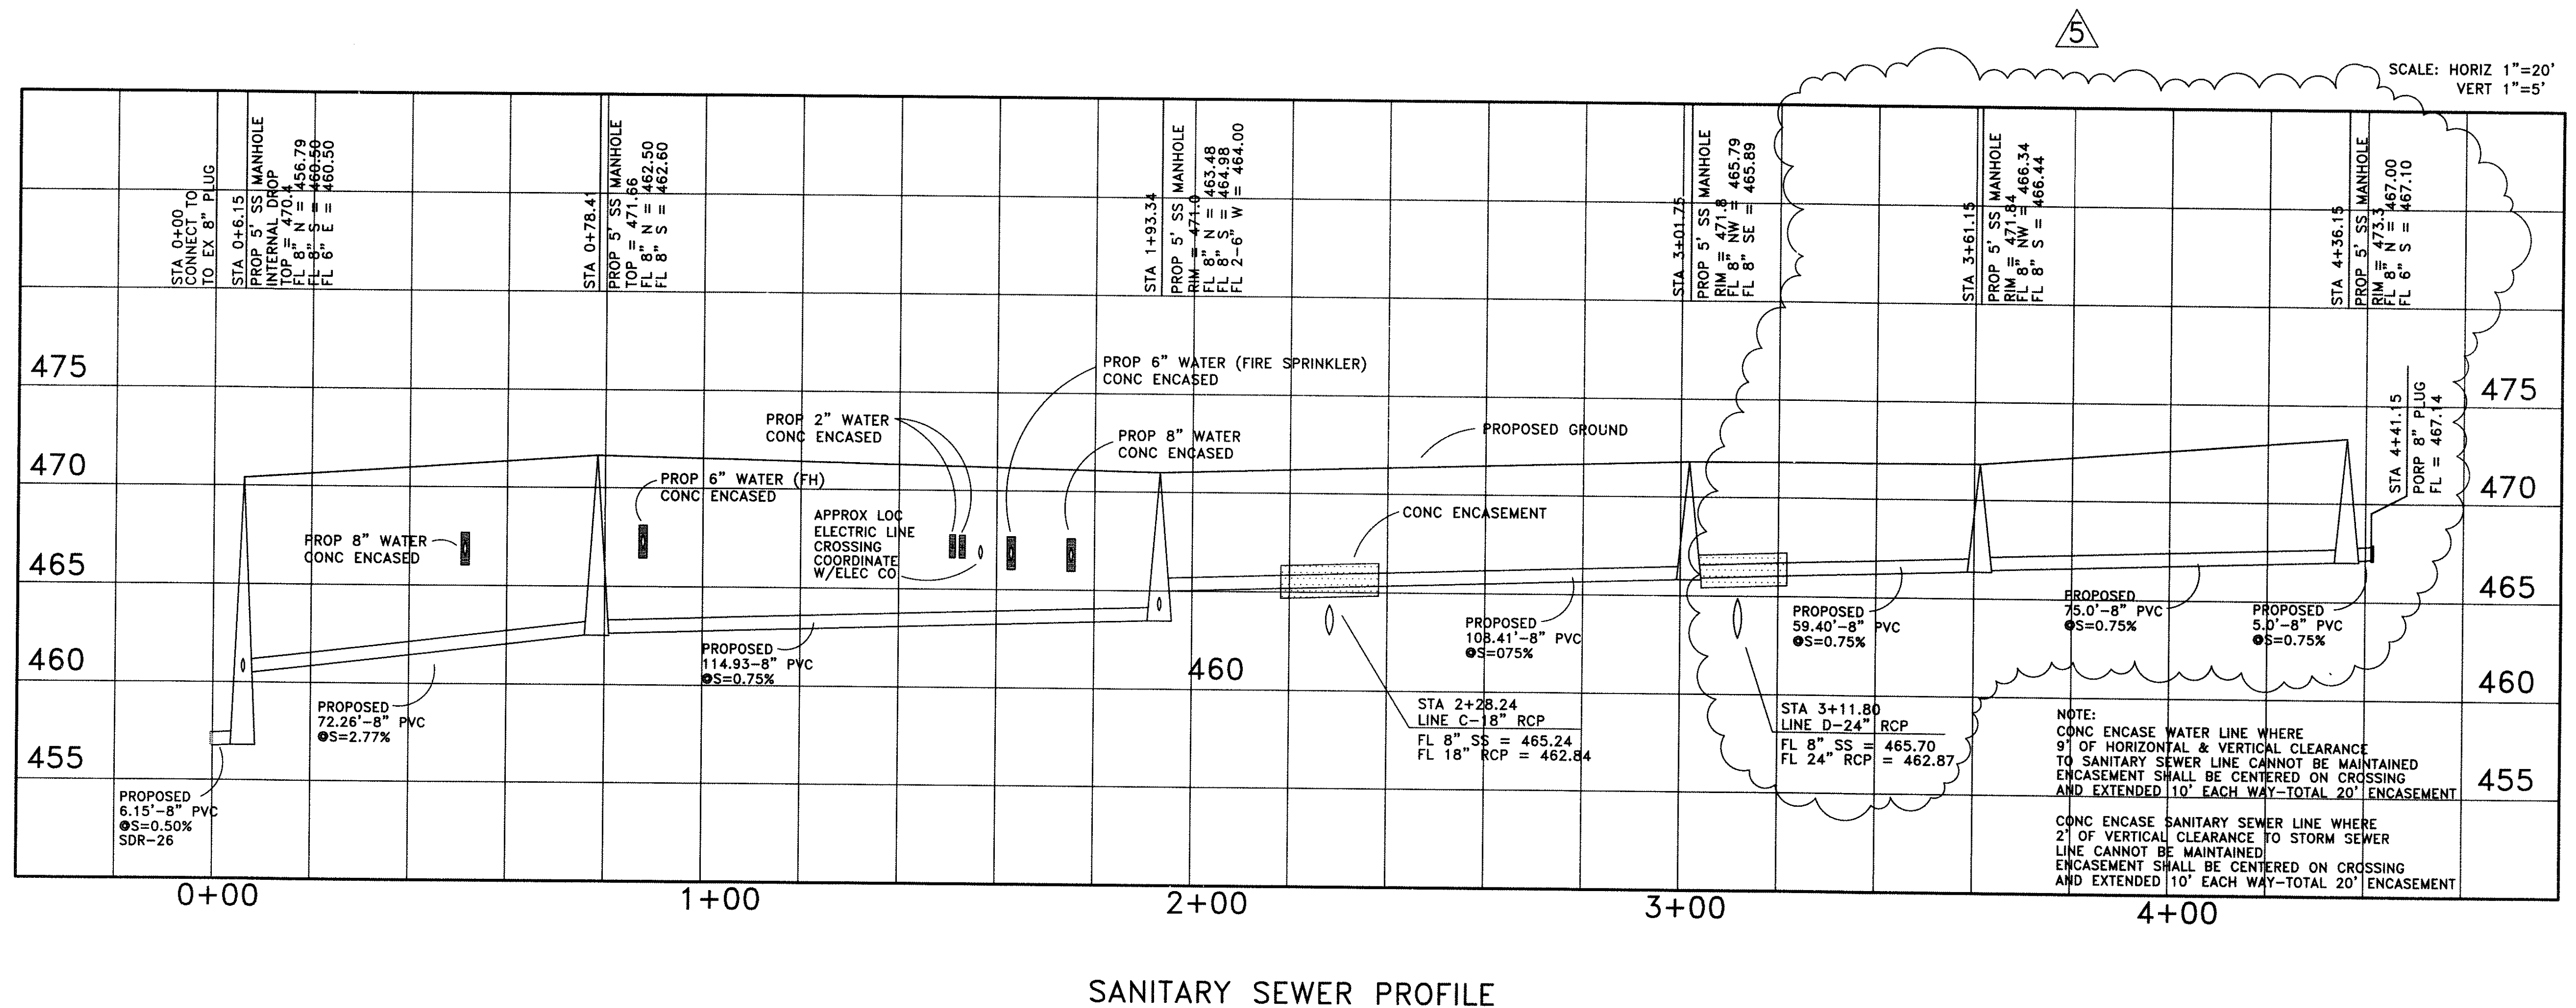

SANITARY SEWER PROFILE

RECORD DRAWING

SEE NCTCOG 3RD EDITION FOR ADDITIONAL SPECIFICATIONS AND DETAILS

Note: Copyright © Hickman Consulting Engineers, Inc. All rights reserved. No part of this drawing may be reproduced by photocopying, recording or by any other means, or stored, processed or transmitted in or by any computer or other systems without the prior written permission of Hickman Consulting Engineers, Inc. Copies of this plan without an original signature and seal are not valid.

THIS RECORD DRAWING HAS BEEN PREPARED BASED ON INFORMATION PROVIDED BY OTHERS. THE ENGINEER HAS NOT VERIFIED THE ACCURACY OF THIS INFORMATION AND SHALL NOT BE RESPONSIBLE FOR ANY DISCREPANCIES WHICH MAY BE INCORPORATED HEREIN AS A RESULT.

Hickman Consulting Engineers, Inc.
 3094 County Road 1024
 Farmersville, Texas 75442
 Ph (972)704-2499
 markredhick@gmail.com
 Engineers

DETAILS & SANITARY SEWER PROFILE
 LAKESHORE COMMONS
 LOTS 1 - 4, LAKESHORE COMMONS
 ROCKWALL, ROCKWALL COUNTY, TEXAS
 MOORE WORTH INVESTMENTS, LLC
 8445 FREEMONT PARKWAY, SUITE 175
 IRVING, TX 75063
 214-415-9993

SCALE: AS SHOWN
 DATE: AUG2016
 DRAWN BY: FP
 CHK'D BY: MHH
 JOB NO: 1501-357
 FILE:165-1501357-16-R-01
 DATE SUBMITTED: 03/22/17(C)

Hickman Consulting Engineers, Inc.
 STATE OF TEXAS
 MARK H. HICKMAN
 78409
 F-12172

REVISION	DATE	DESCRIPTION
2	05-17-17	FP
5	06-26-18	FP