
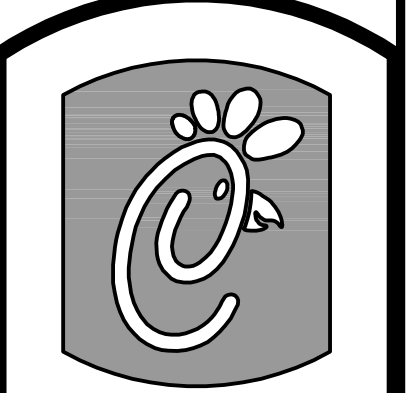
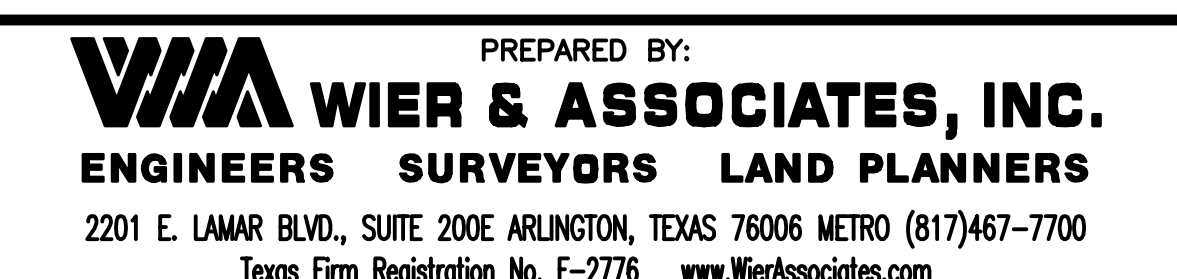
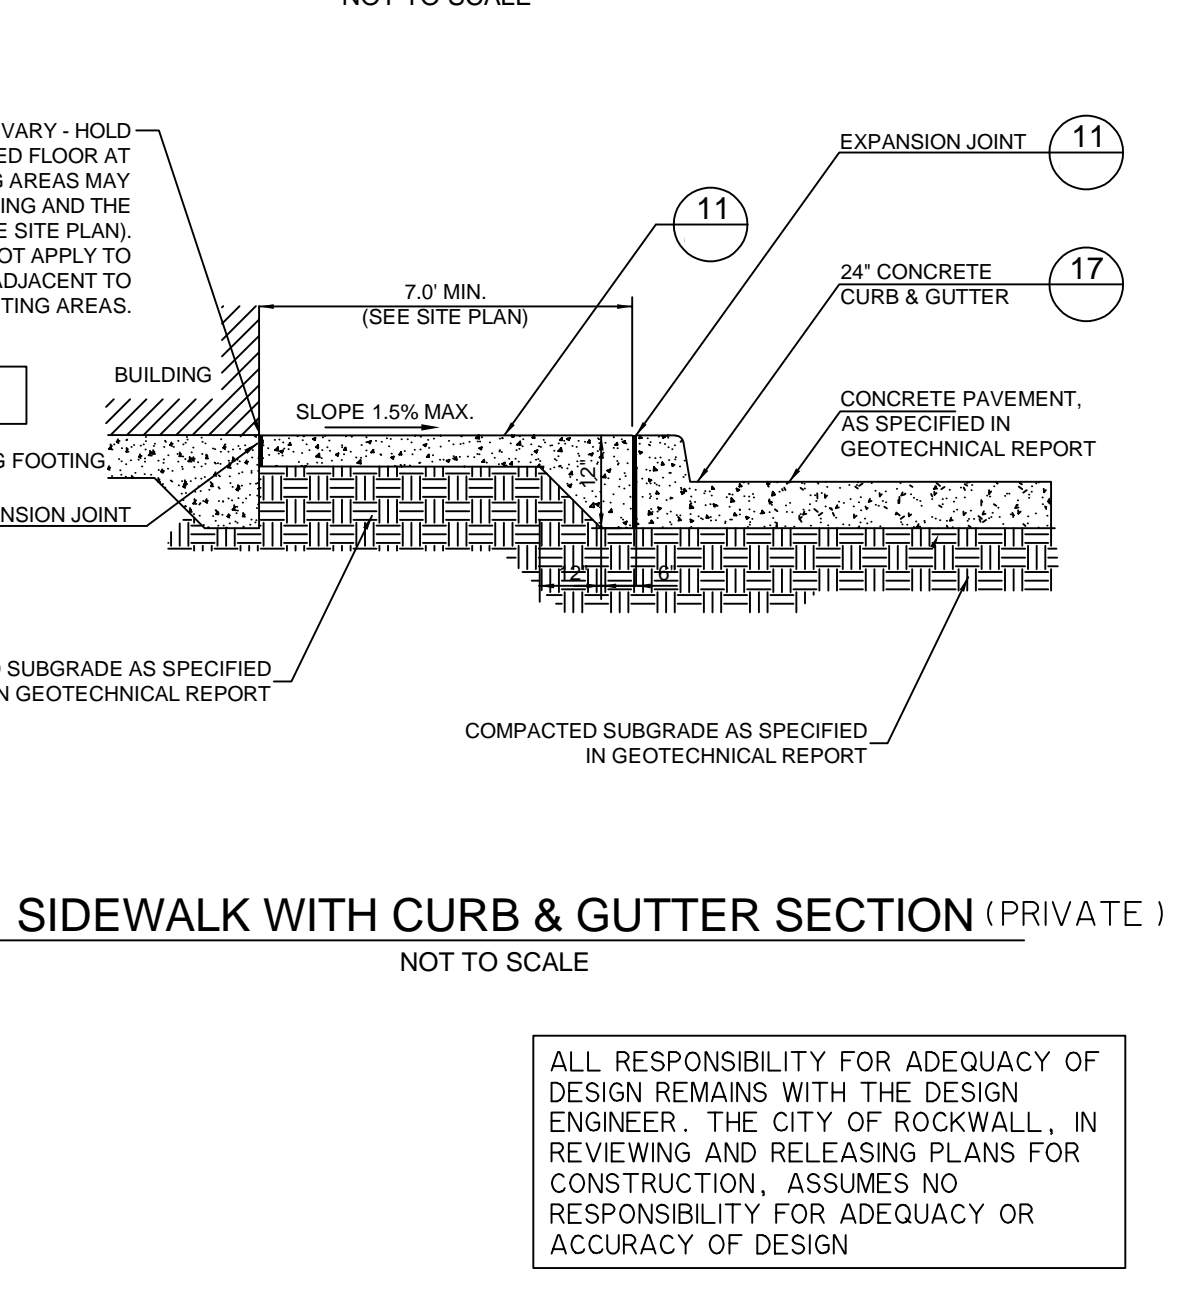
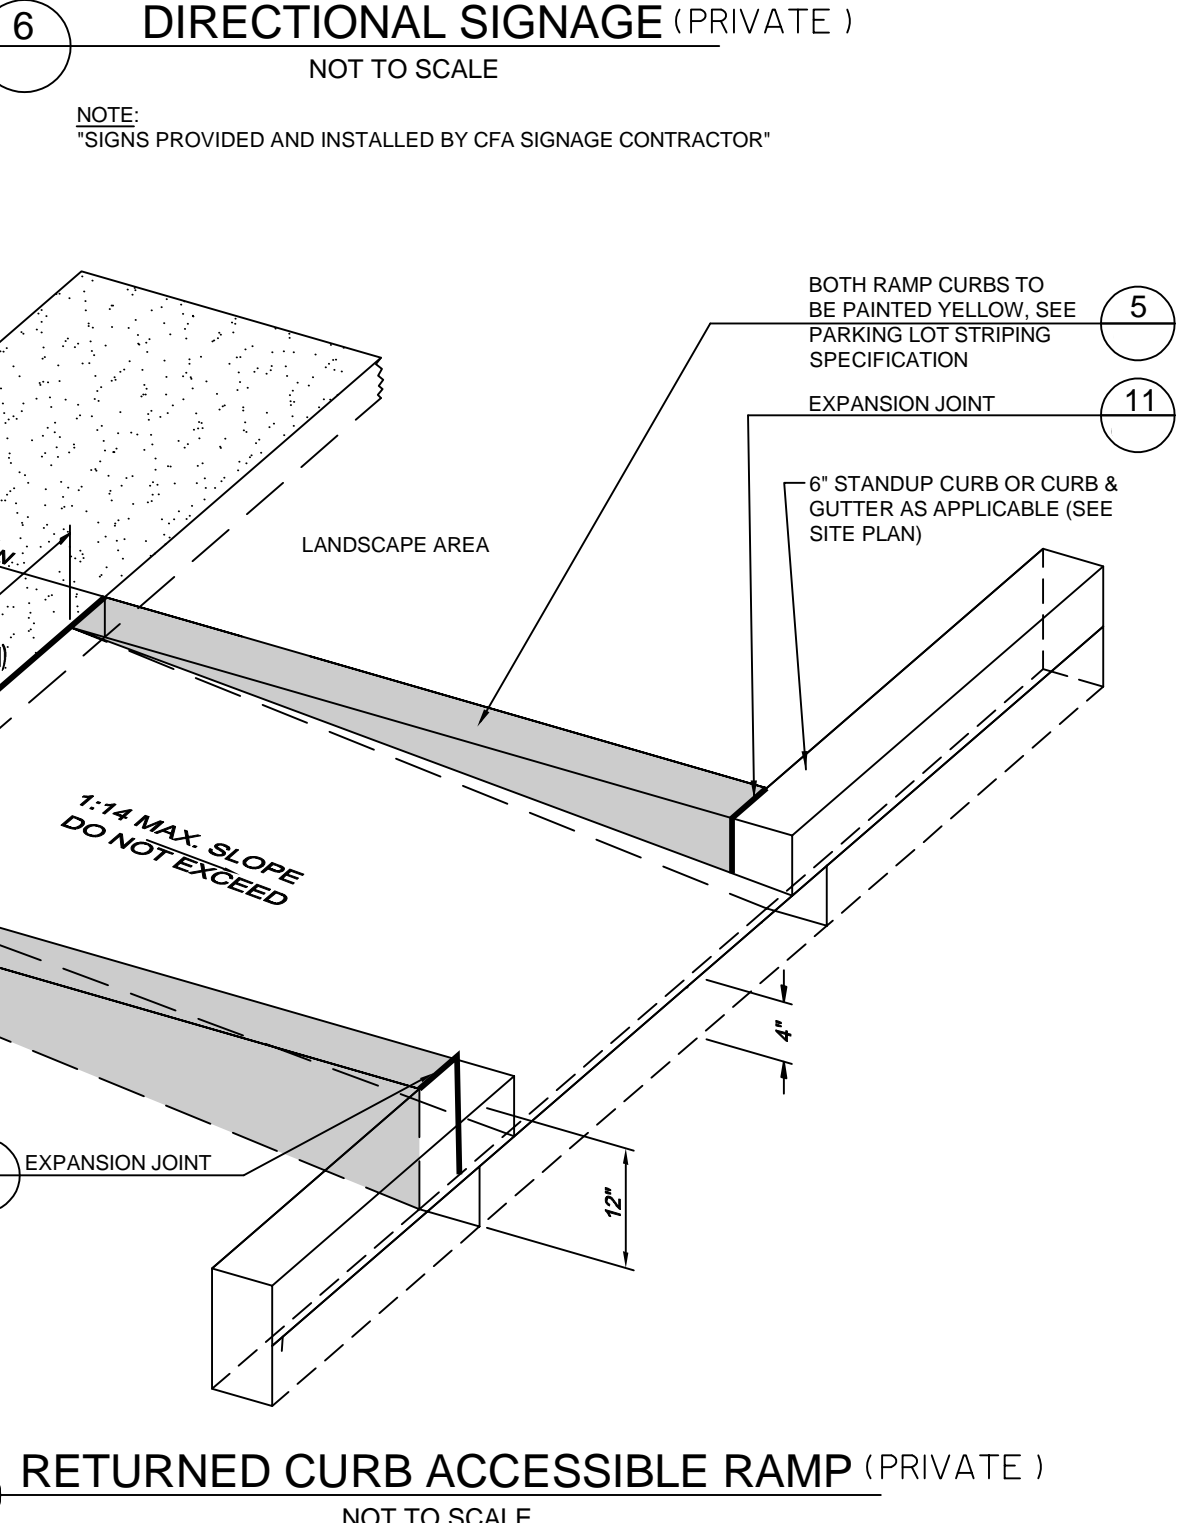


RECORD DRAWING
June 9, 2020
To the best of our knowledge Wier & Associates, Inc., states this plan is As-Built. This information provided is based on surveying at the site and information provided by the contractor.

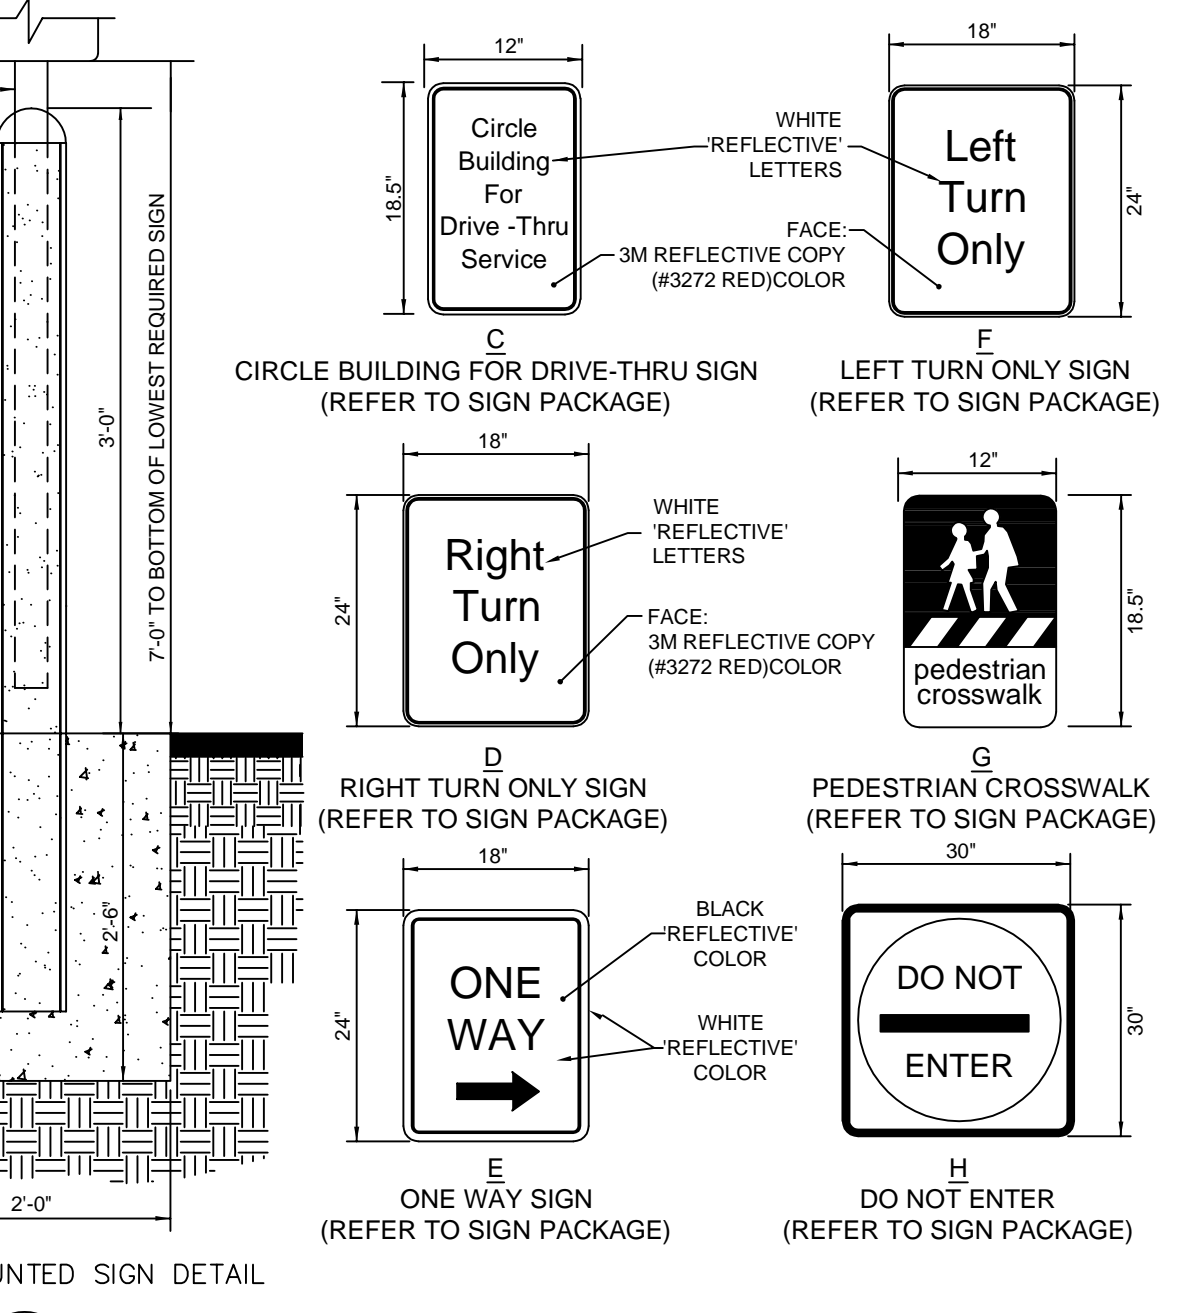

5200 Buffington Rd.
Atlanta Georgia,
30349-2998

Revisions:
Mark Date By
12/17/19 RBC


ISSUED FOR CONSTRUCTION

Mark Date By

Mark Date By

Mark Date By

Mark Date By

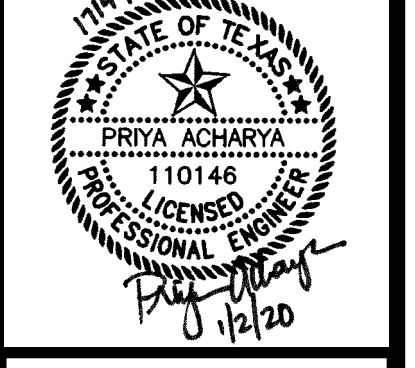

LOT 2, BLOCK A
LAKESHORE COMMONS
1979 NORTH LAKESHORE DRIVE
ROCKWALL, TEXAS
STORE# 03897

STORE SERIES P13-LSR

SHEET TITLE PRIVATE CFA STANDARD DETAILS

For Permit
For Bid
For Construction

Job No. : 17144
Store : #03897
Date : 12/19/2019
Drawn By : MCC
Checked By : RSE

Sheet C-10.1

PRINTED: 1/2/2020 STB FILE: WIER-PAVING-STB LAST SAVED: 12/19/2019 9:13 AM SAVED BY: RILEY.C. FILE: C-10.1 CFA STANDARD DETAILS 1-17144.DWG

PREPARED BY:
WIER & ASSOCIATES, INC.
ENGINEERS SURVEYORS LAND PLANNERS
2201 E. LAMAR BLVD., SUITE 200E ARLINGTON, TEXAS 76006 METRO (817)467-7700
Texas Firm Registration No. F-2776 www.WierAssociates.com

ALL RESPONSIBILITY FOR ADEQUACY OF DESIGN REMAINS WITH THE DESIGN ENGINEER. THE CITY OF ROCKWALL, IN REVIEWING AND RELEASING PLANS FOR CONSTRUCTION, ASSUMES NO RESPONSIBILITY FOR ADEQUACY OR ACCURACY OF DESIGN