



REINFORCED CONCRETE SIDEWALKS JOINTS AND SPACING	CITY OF ROCKWALL	STANDARD SPECIFICATION REFERENCE 305.2
		DATE: Mar. 2018
		STANDARD DRAWING NO. R-2170

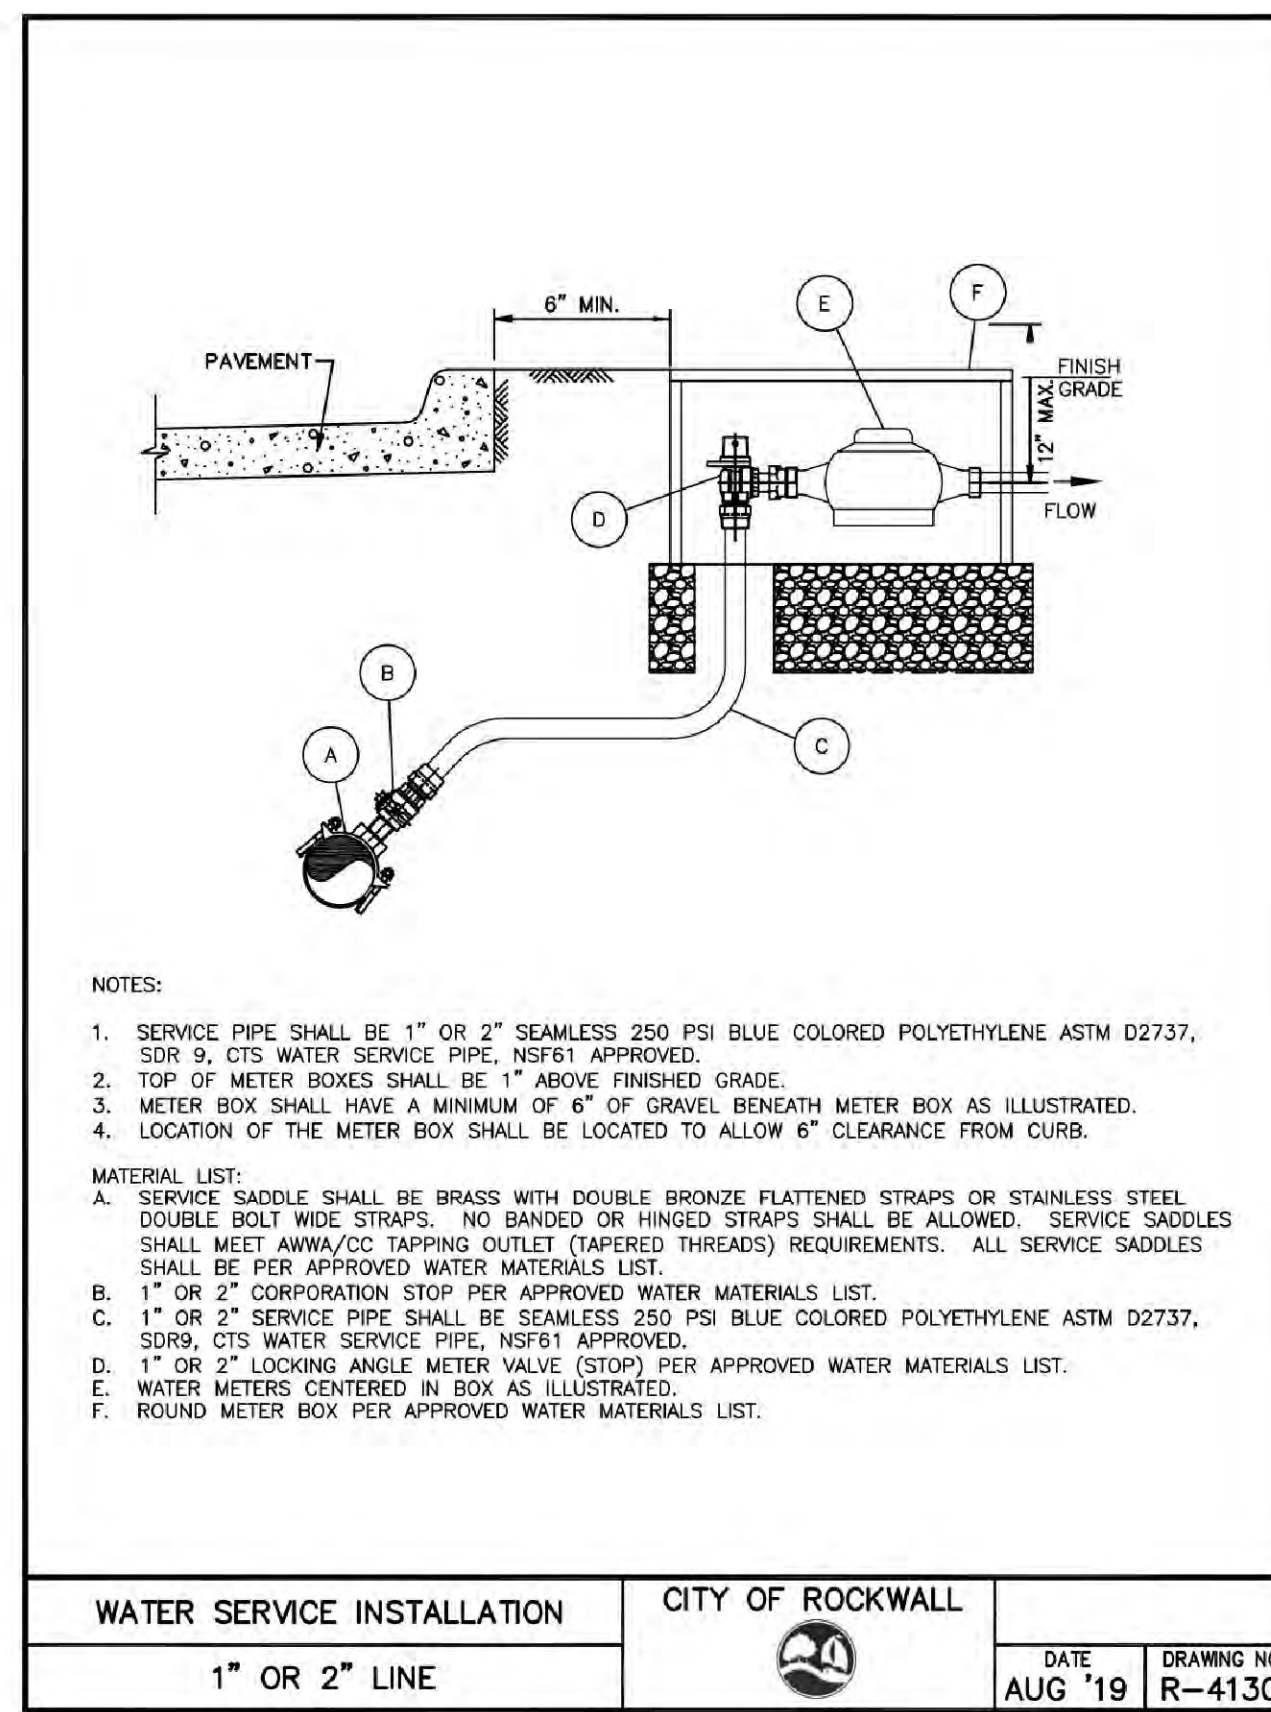

WATER SERVICE INSTALLATION	CITY OF ROCKWALL	DATE: AUG '19	DRAWING NO. R-4130
1" OR 2" LINE			

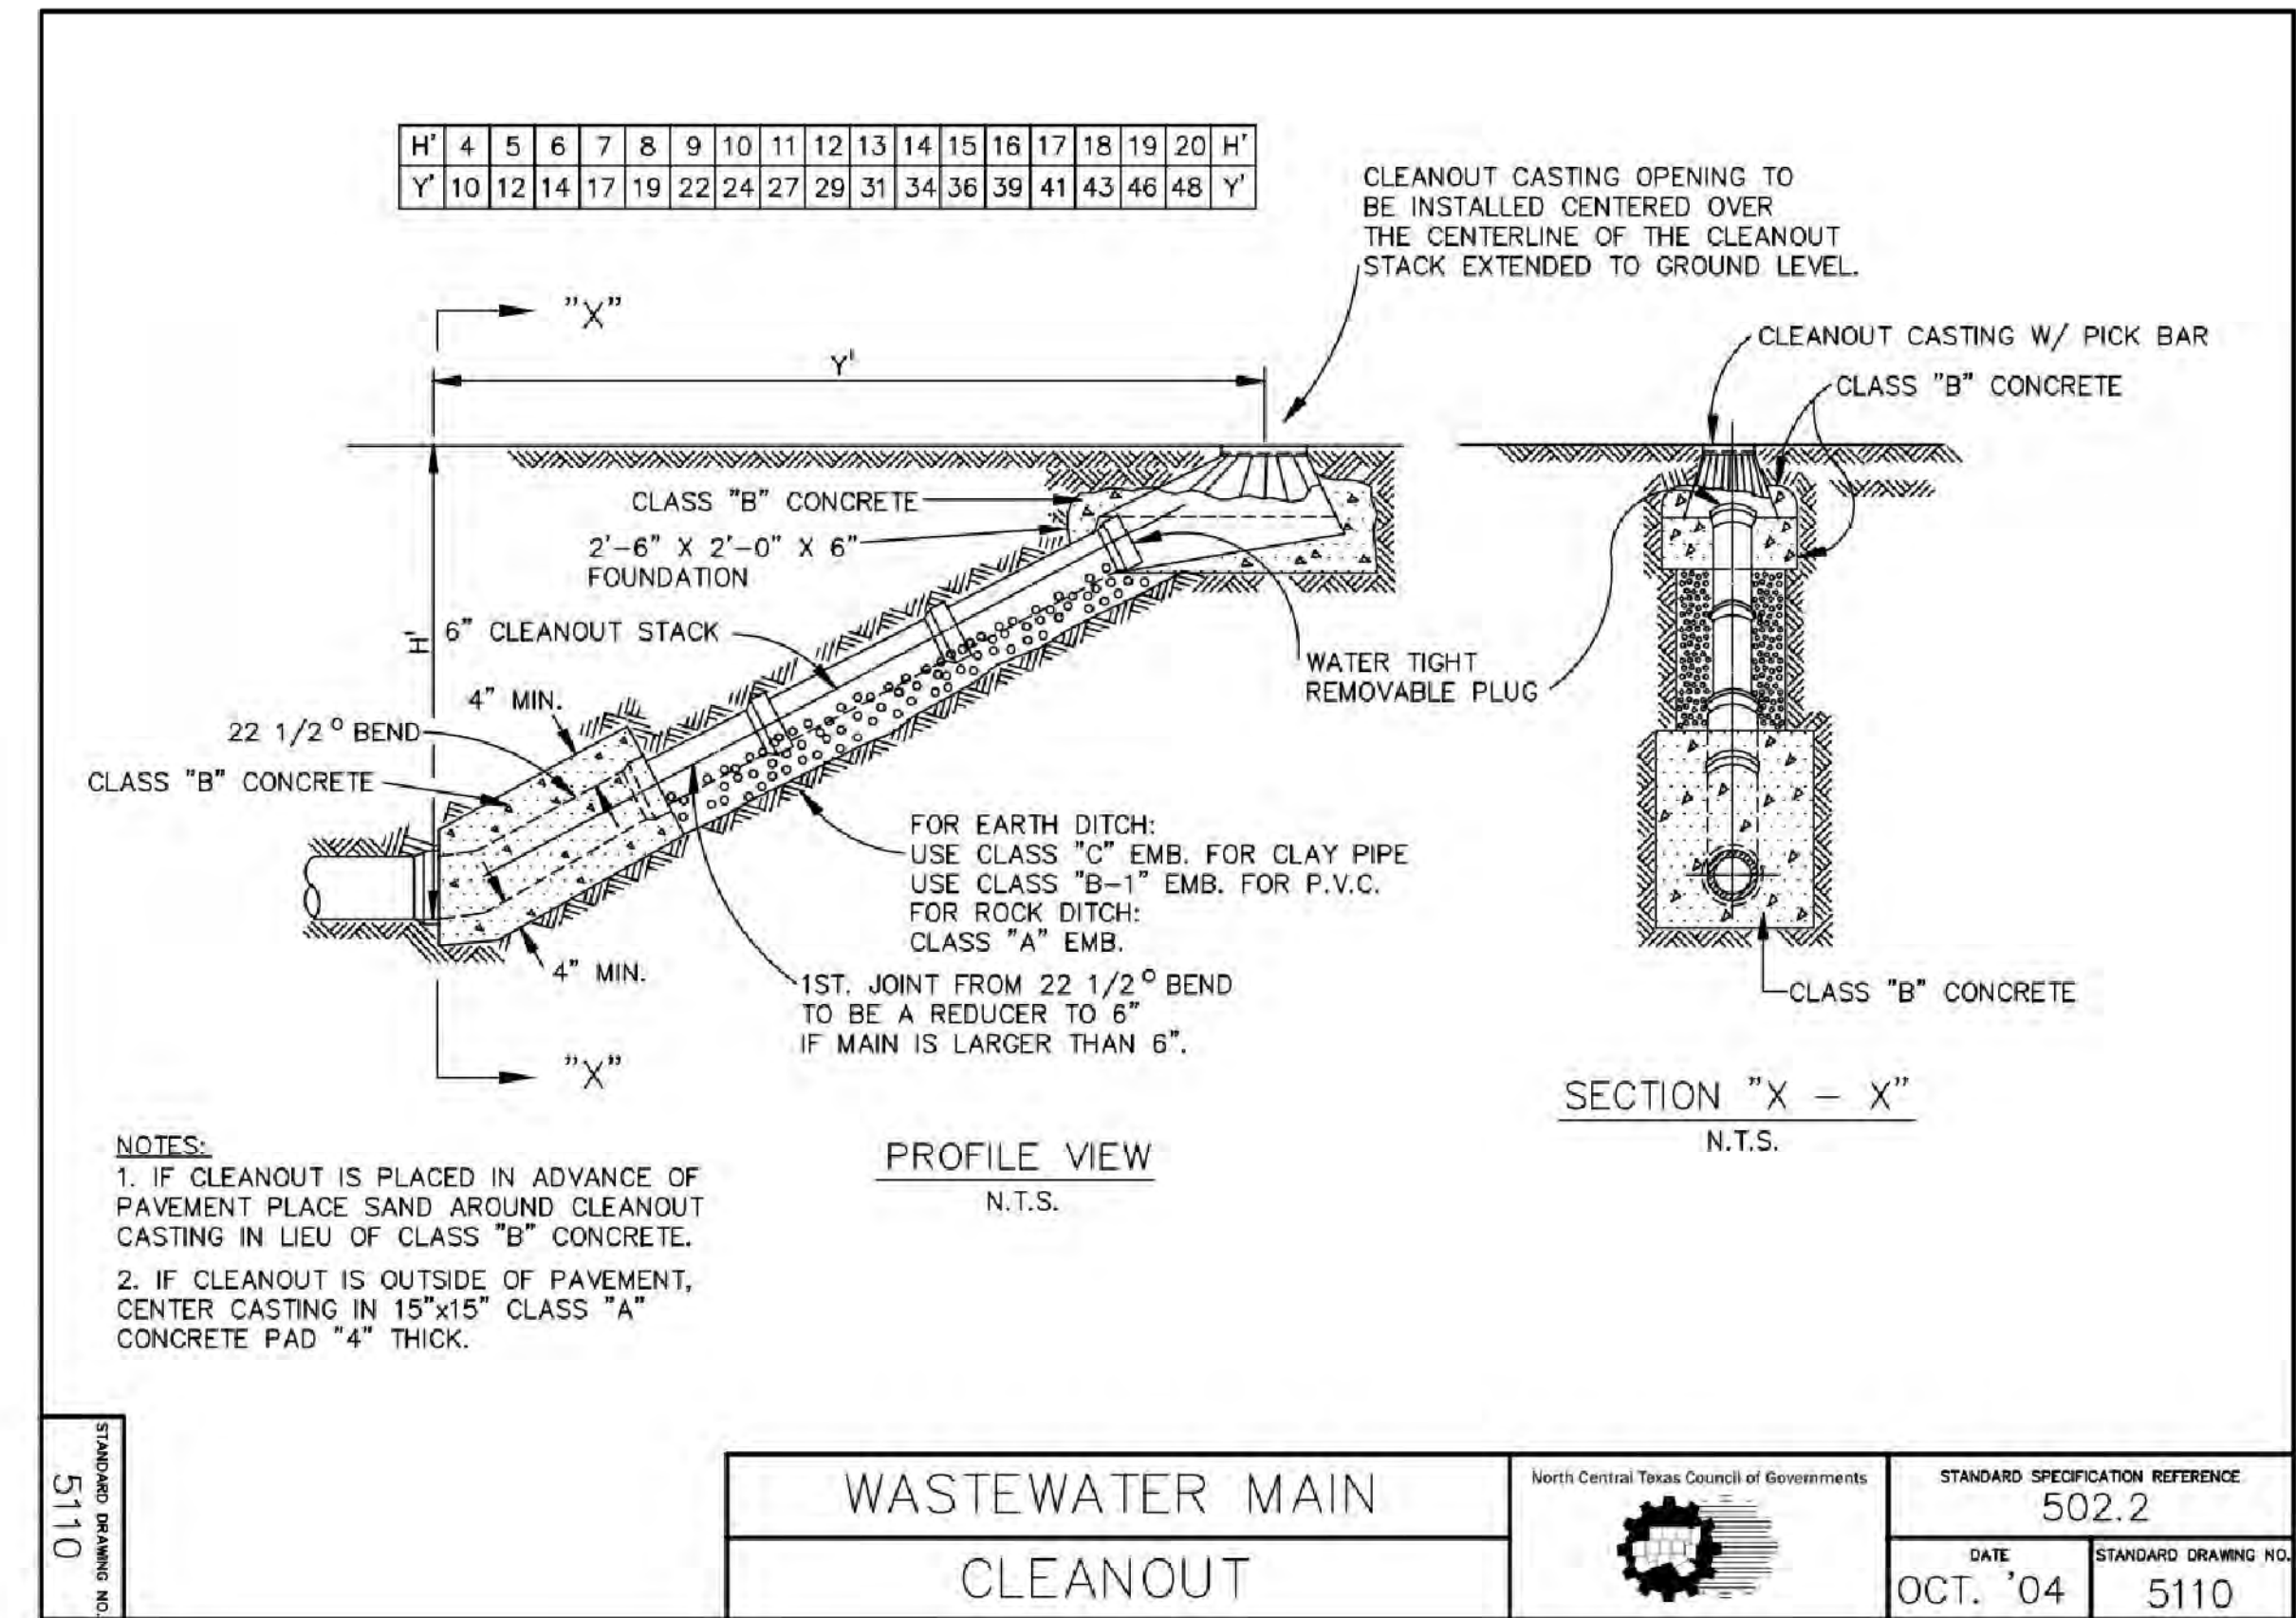


WASTEWATER MAIN CLEANOUT	CITY OF ROCKWALL	DATE: OCT. '04	DRAWING NO. 5110


1. COPPER SERVICE LINE SHALL BE I.D. C.T.S. POLY TUBE SDR-9.
2. A) FOR 1" METER; METER BOX SHALL BE TWO (2) FEET FROM BACK OF CURB OR AS DIRECTED BY THE CITY.
B) FOR 2" METER; METER BOX SHALL BE TWO FEET, 6 INCHES (2'-6") FROM BACK OF CURB OR AS DIRECTED BY THE CITY.
3. METER BOX SHALL BE EIGHTEEN (18) INCH DIAMETER BY FOURTEEN (14) INCH DEEP
4. BLUE EMS DISK SHALL BE SET AT MAIN LINE.
5. NO C.F. CORPORATION STOPS.
6. SEE CITY DETAIL FOR SERVICE METER TAIL CONNECTION.

RECORD DRAWING
June 9, 2020


To the best of our knowledge Wier & Associates, Inc., states this plan is AS-BUILT. This information provided is based on surveying at the site and information provided by the contractor.

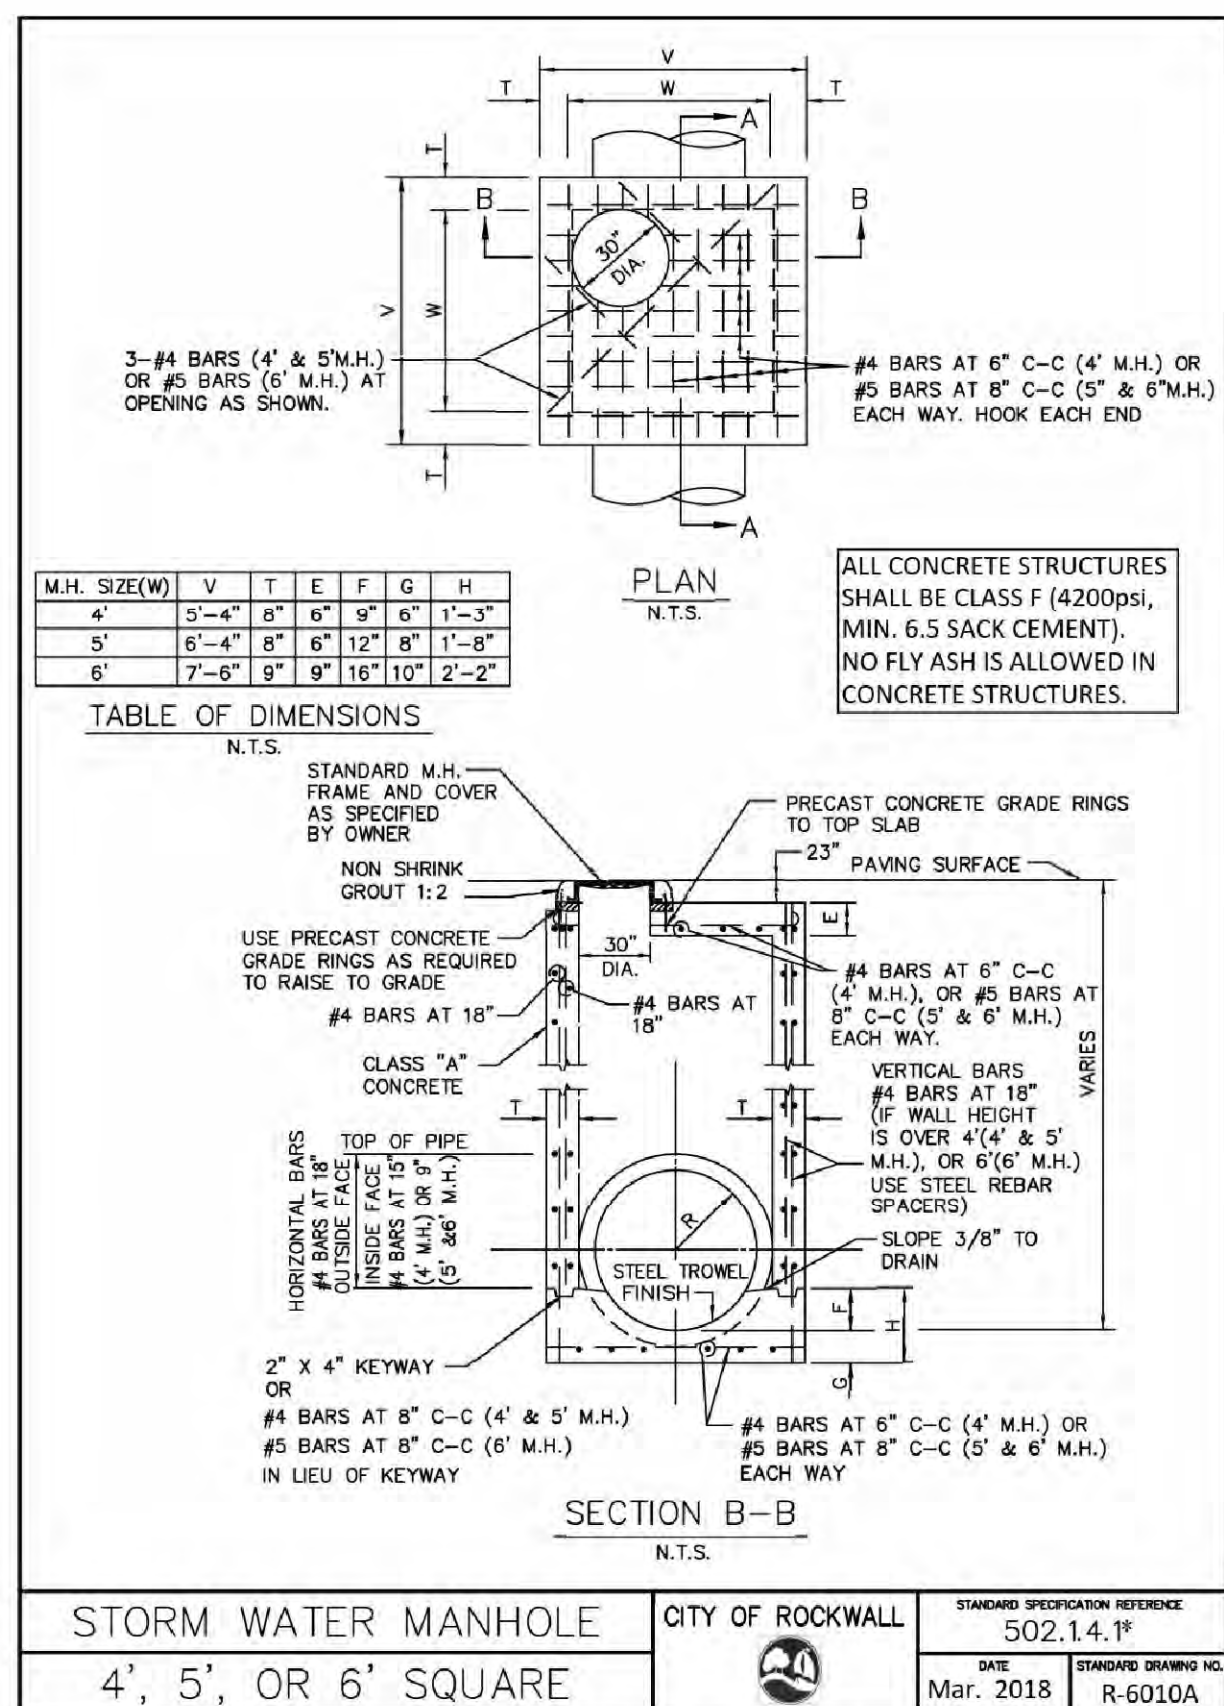


STORM WATER MANHOLE	CITY OF ROCKWALL	STANDARD SPECIFICATION REFERENCE 502.14.1*
4', 5', OR 6' SQUARE		DATE: Mar. 2018
		STANDARD DRAWING NO. R-6010A

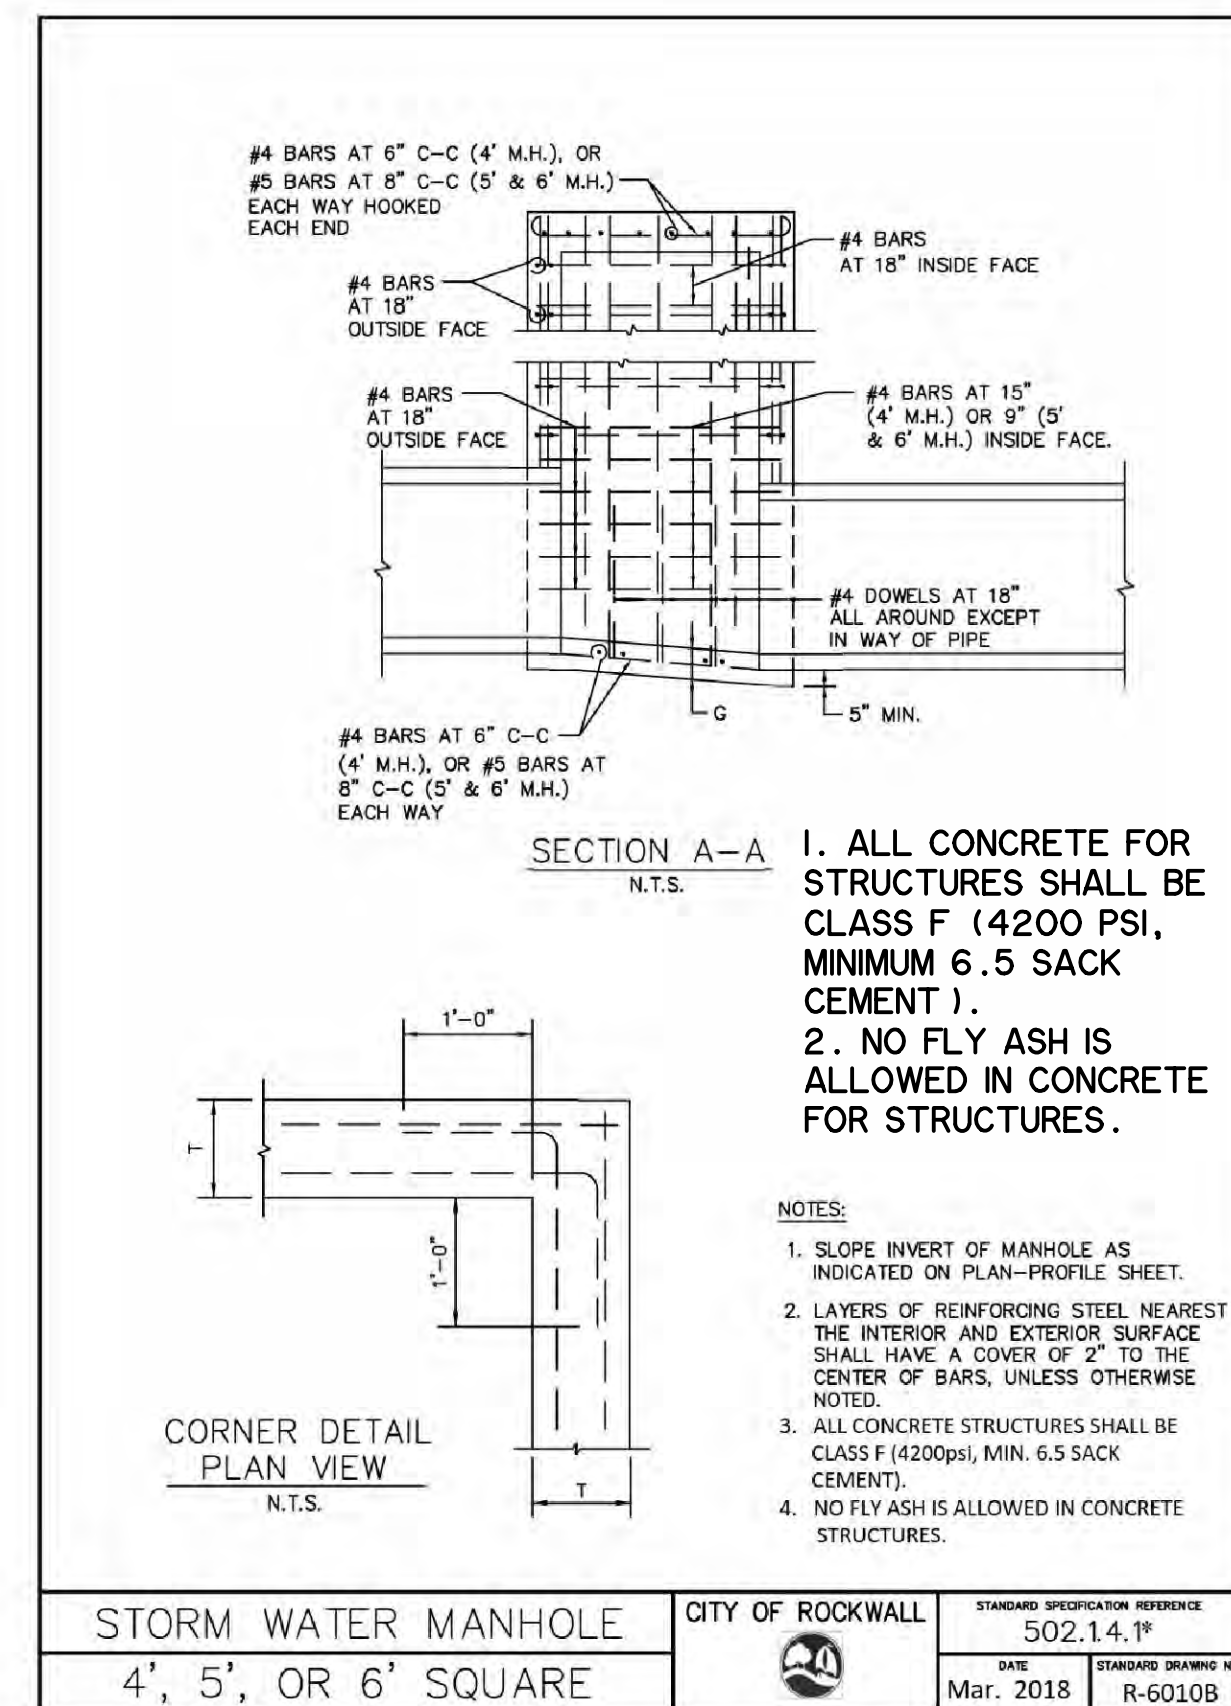


STORM WATER MANHOLE	CITY OF ROCKWALL	STANDARD SPECIFICATION REFERENCE 502.14.1*
4', 5', OR 6' SQUARE		DATE: Mar. 2018
		STANDARD DRAWING NO. R-6010B

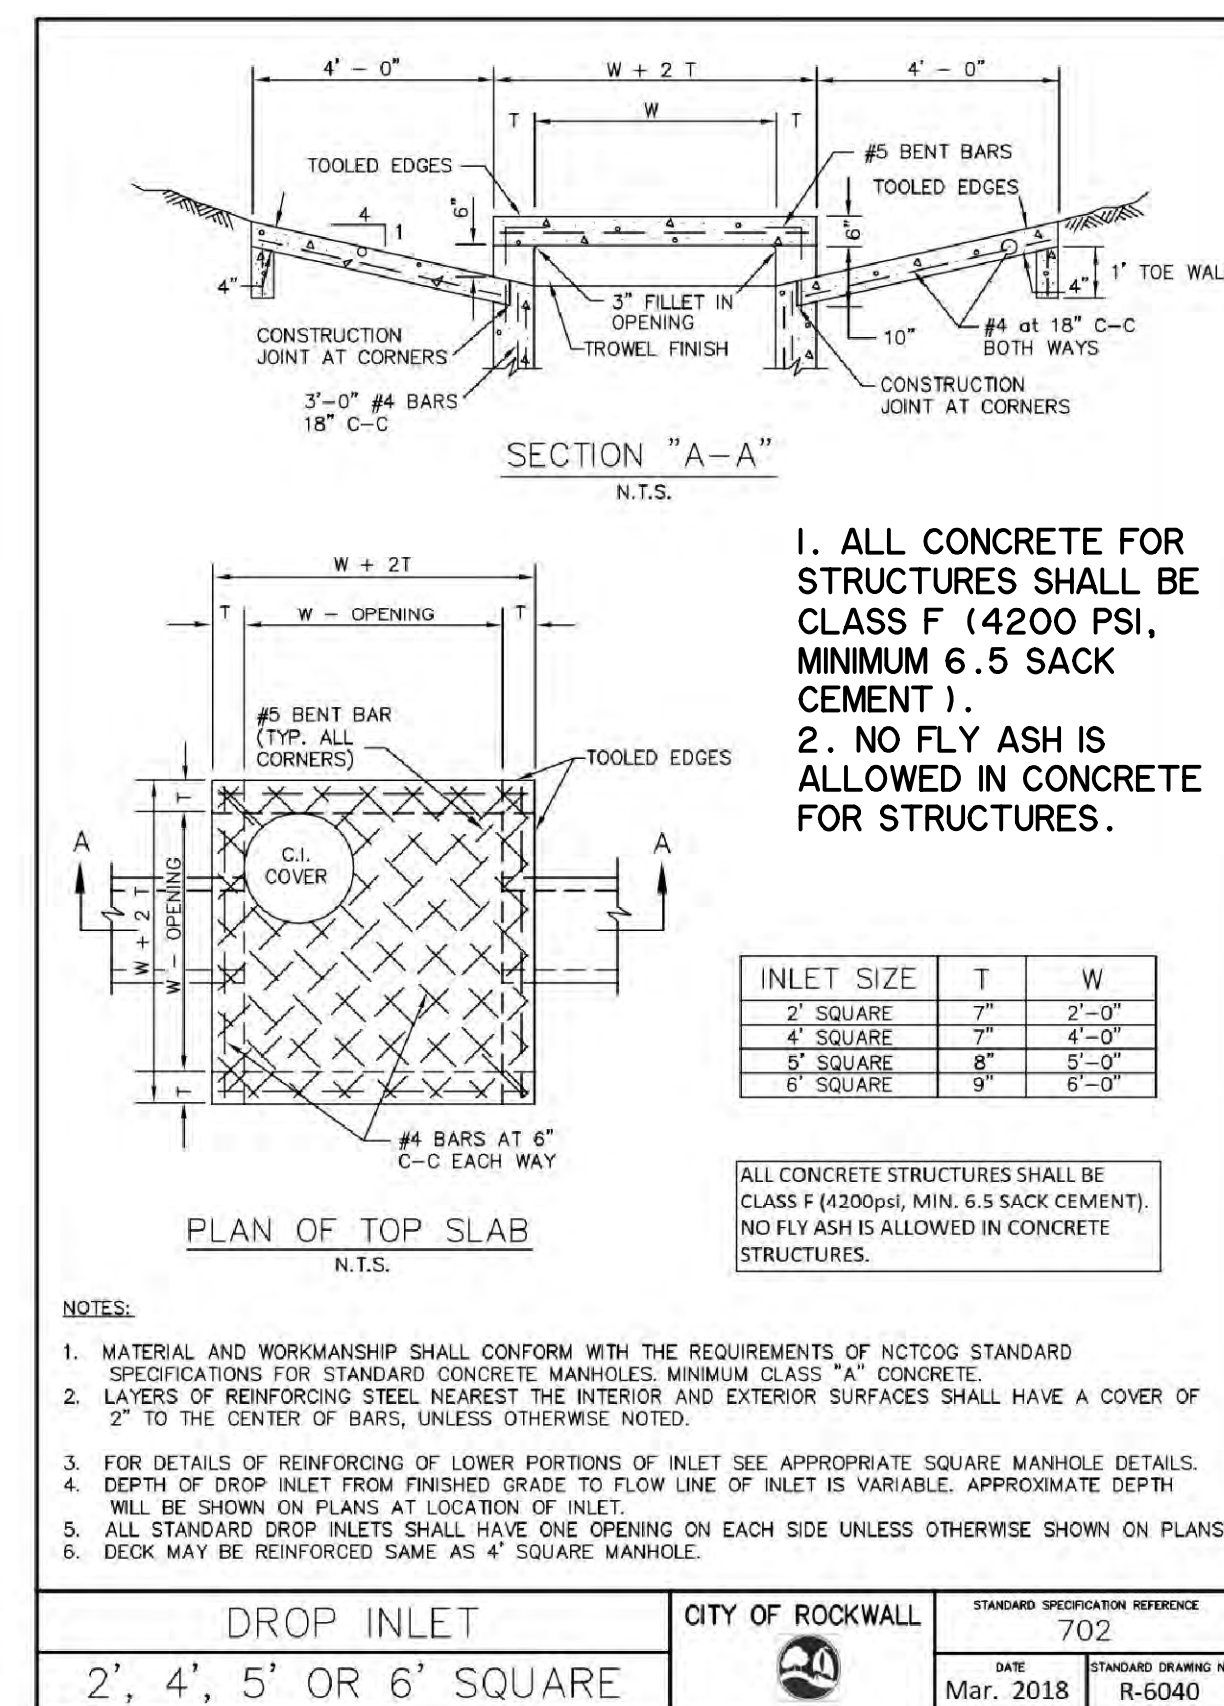

DROP INLET	CITY OF ROCKWALL	STANDARD SPECIFICATION REFERENCE 702
2', 4', 5' OR 6' SQUARE		DATE: Mar. 2018
		STANDARD DRAWING NO. R-6040

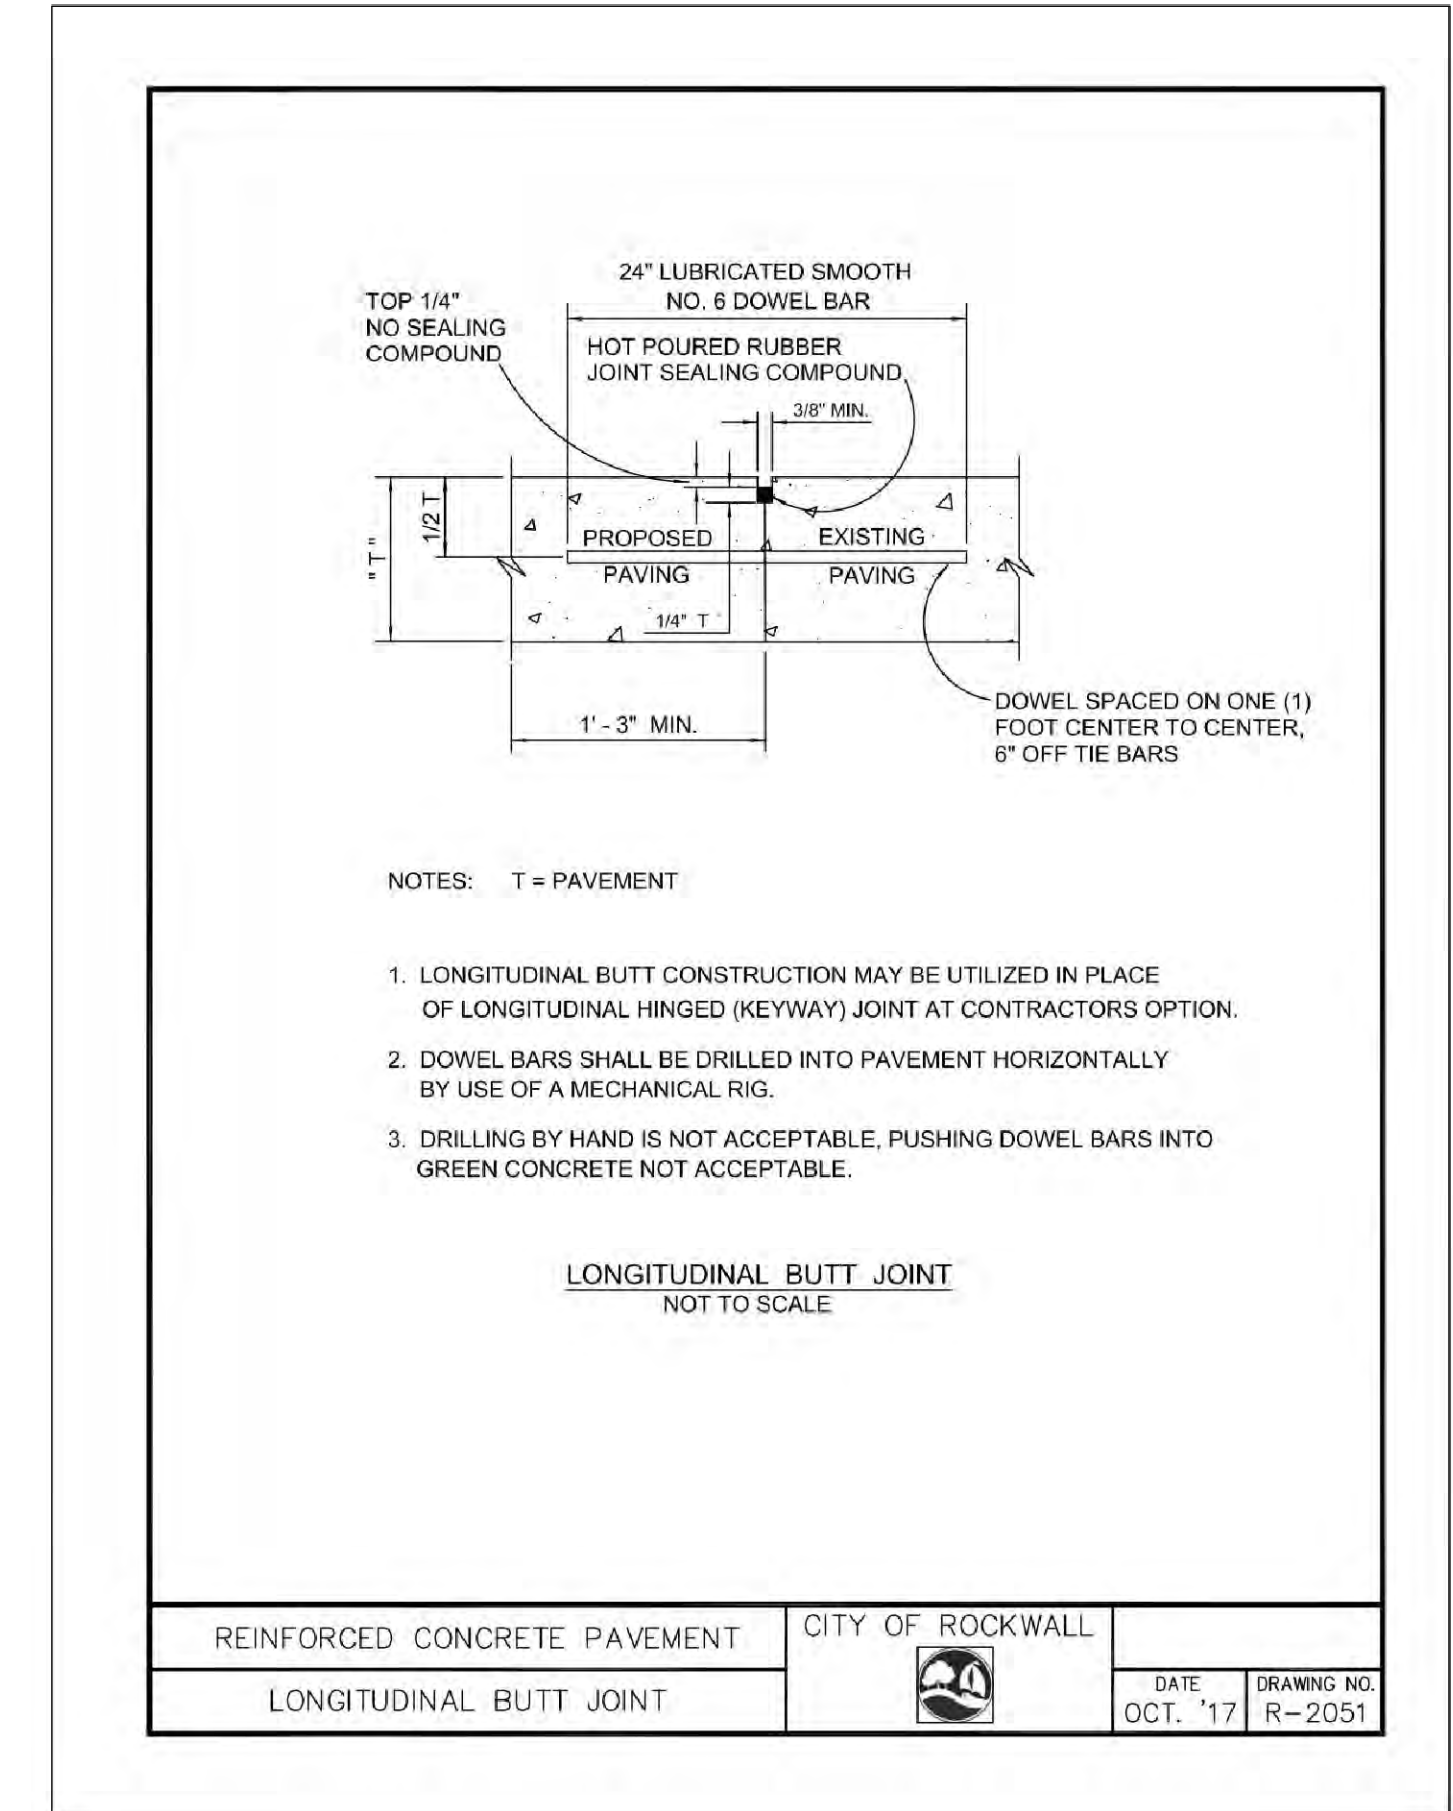

REINFORCED CONCRETE PAVEMENT	CITY OF ROCKWALL	DATE: OCT. '17	DRAWING NO. R-2051
LONGITUDINAL BUTT JOINT			

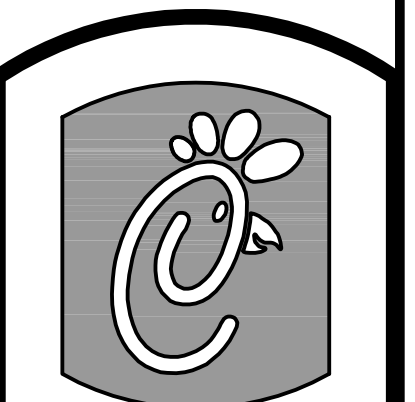

Chick-fil-A


5200 Buffington Rd.
Atlanta Georgia,
30349-2998

Revisions:
Mark Date By
12/17/19 RBC

ISSUED FOR
CONSTRUCTION

Mark Date By
12/17/19 RBC

Mark Date By
12/17/19 RBC

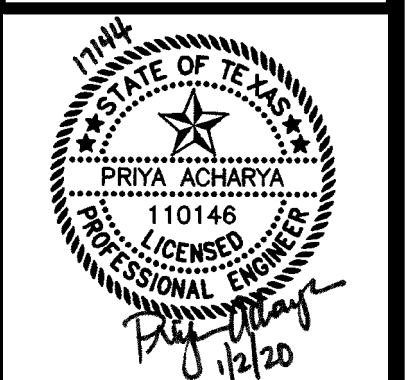

LOT 2, BLOCK A
LAKESHORE COMMONS
1979 NORTH LAKESHORE DRIVE
ROCKWALL, TEXAS
STORE# 03897

STORE
SERIES
P13-LSR

SHEET TITLE
PUBLIC
STANDARD
DETAILS

For Permit
For Bid
For Construction

Job No. : 17144
Store : #03897
Date : 12/19/2019
Drawn By : SCR
Checked By : PNA

Sheet
C-10.4

PREPARED BY:
WIER & ASSOCIATES, INC.
ENGINEERS SURVEYORS LAND PLANNERS
2201 E. LAMAR BLVD., SUITE 200E ARLINGTON, TEXAS 76006 METRO (817)467-7700
Texas Firm Registration No. F-2776 www.WierAssociates.com