




PRIVATE
S.D. LAT '3-1.2'

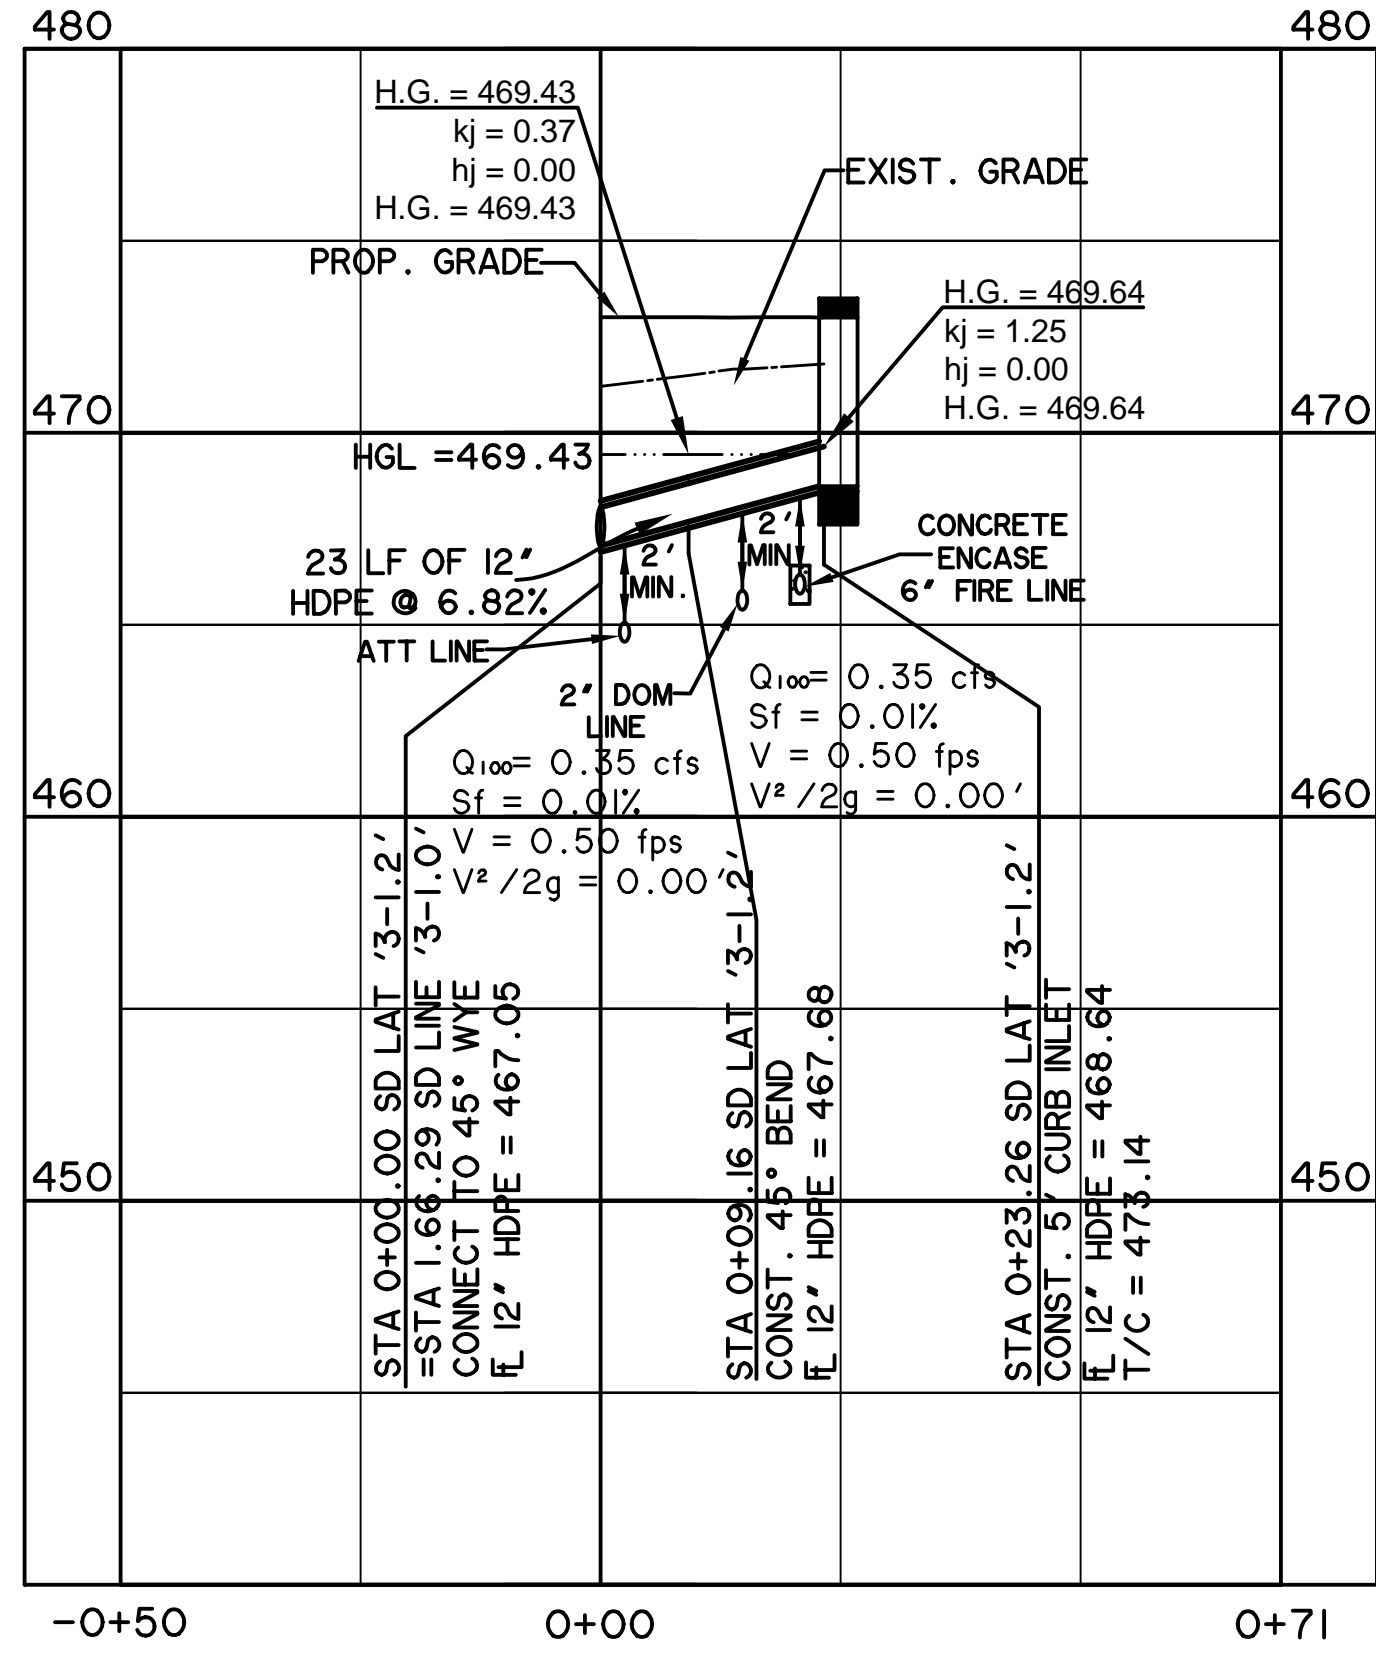


PRIVATE
S.D. LAT '3-1.3'

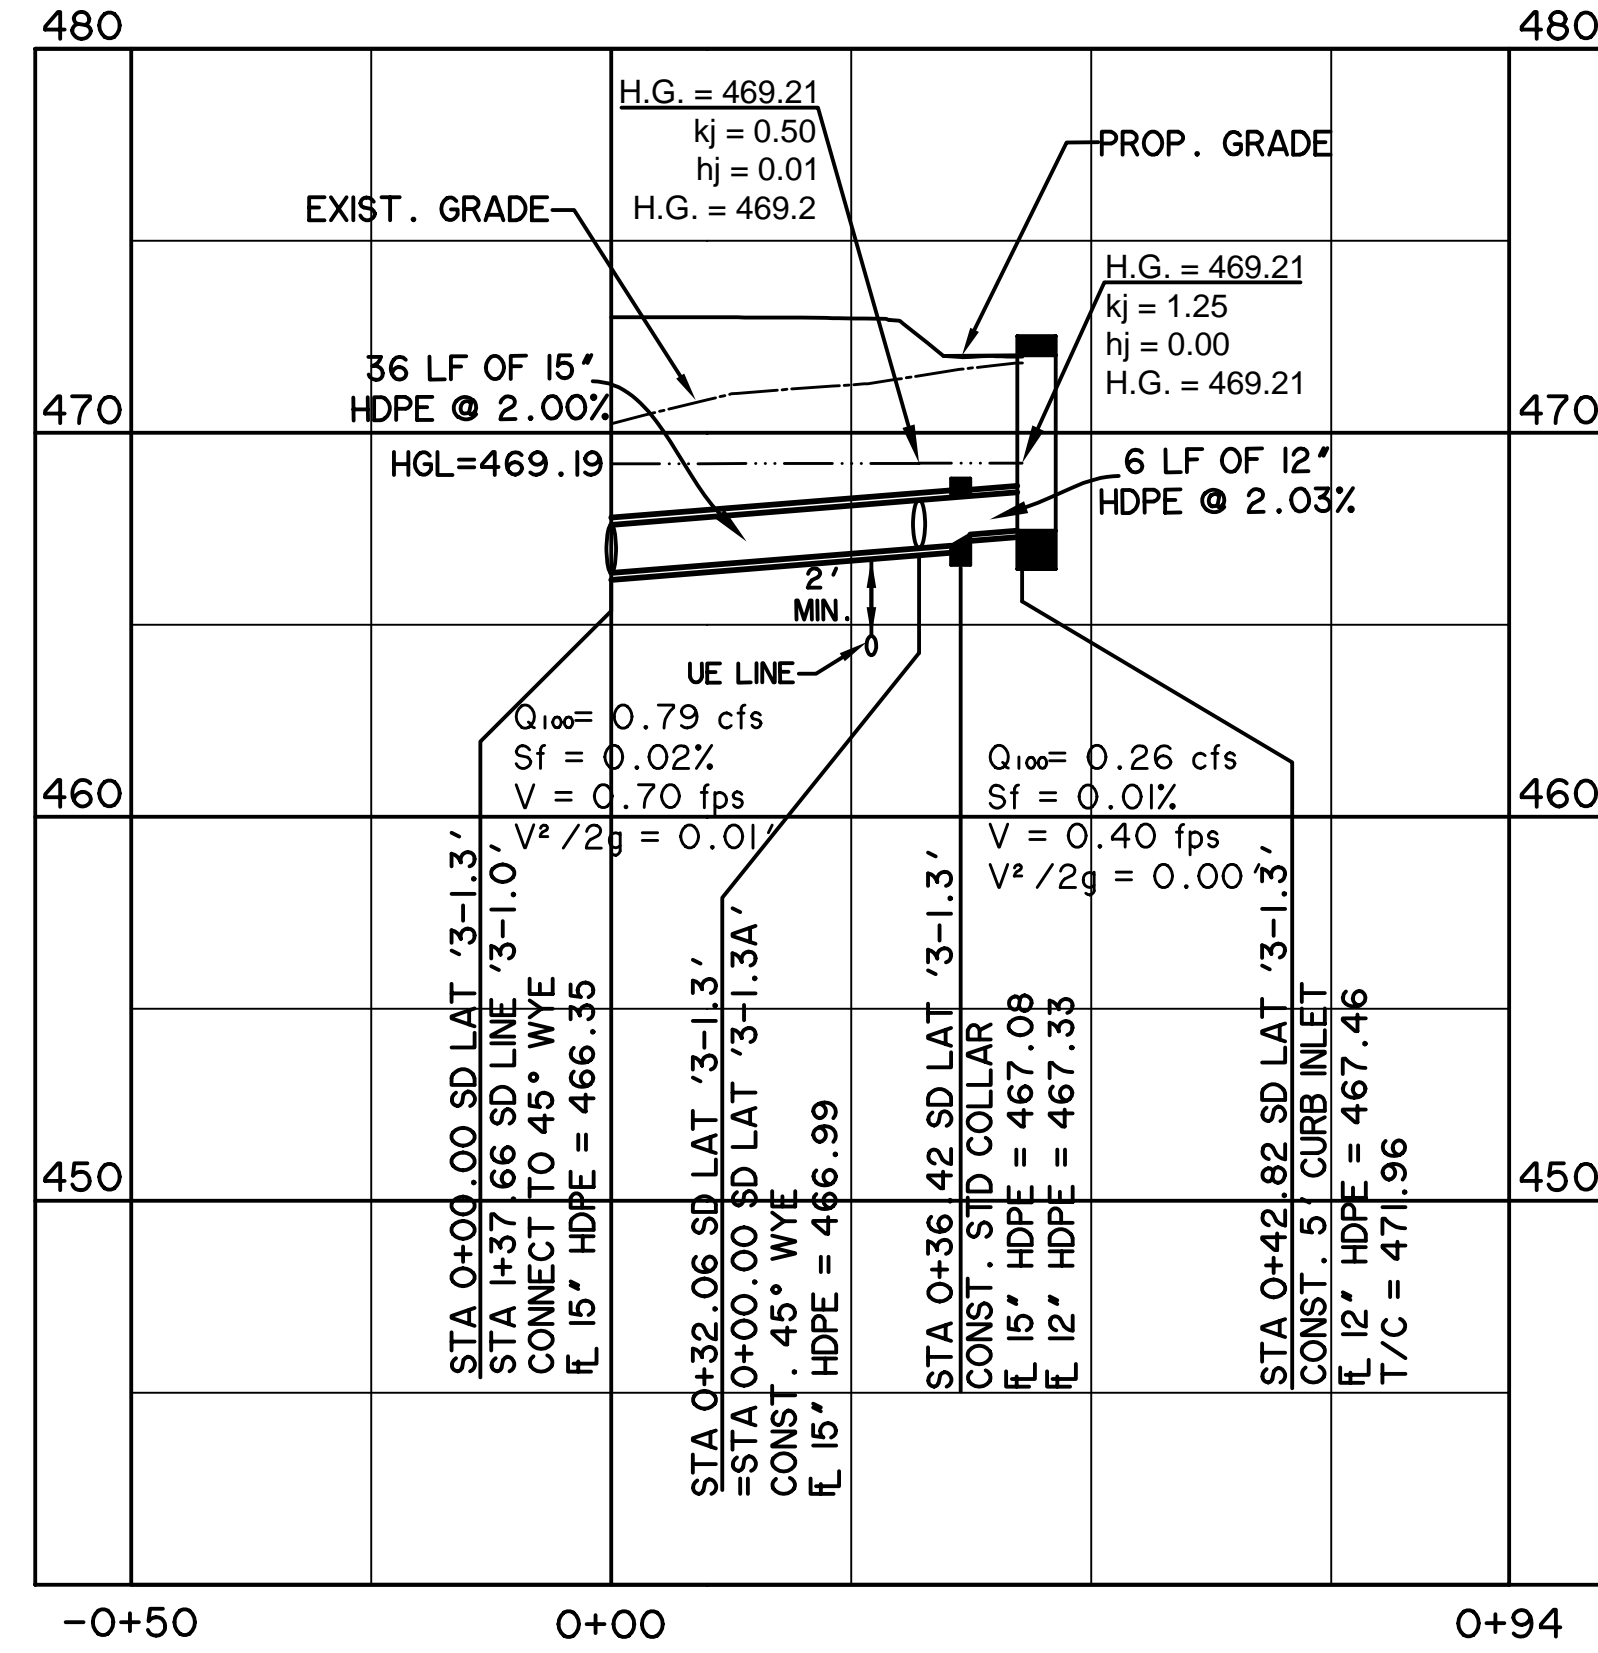


PRIVATE
S.D. LAT '3-1.3A'

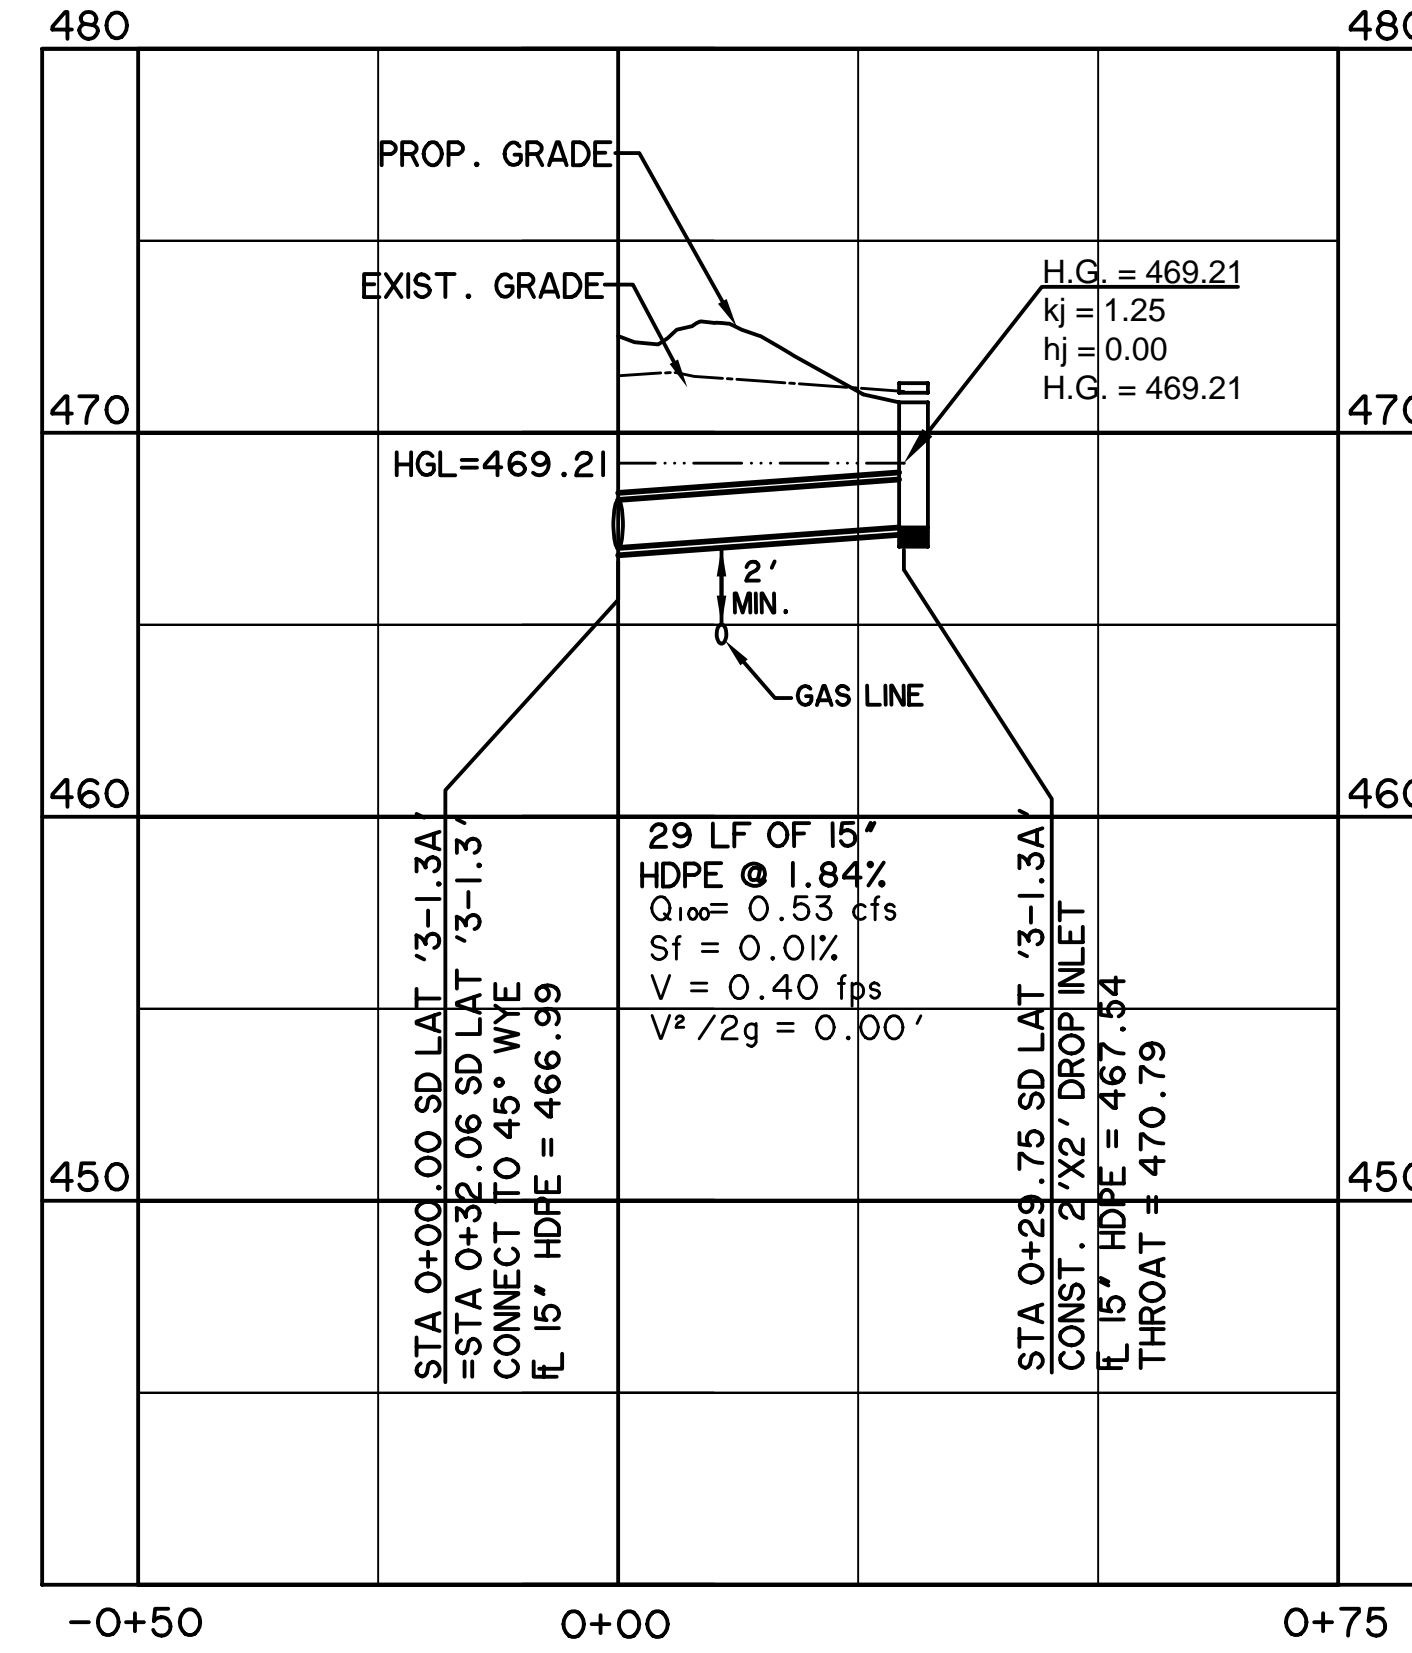


PRIVATE
S.D. LAT '3-1.4'

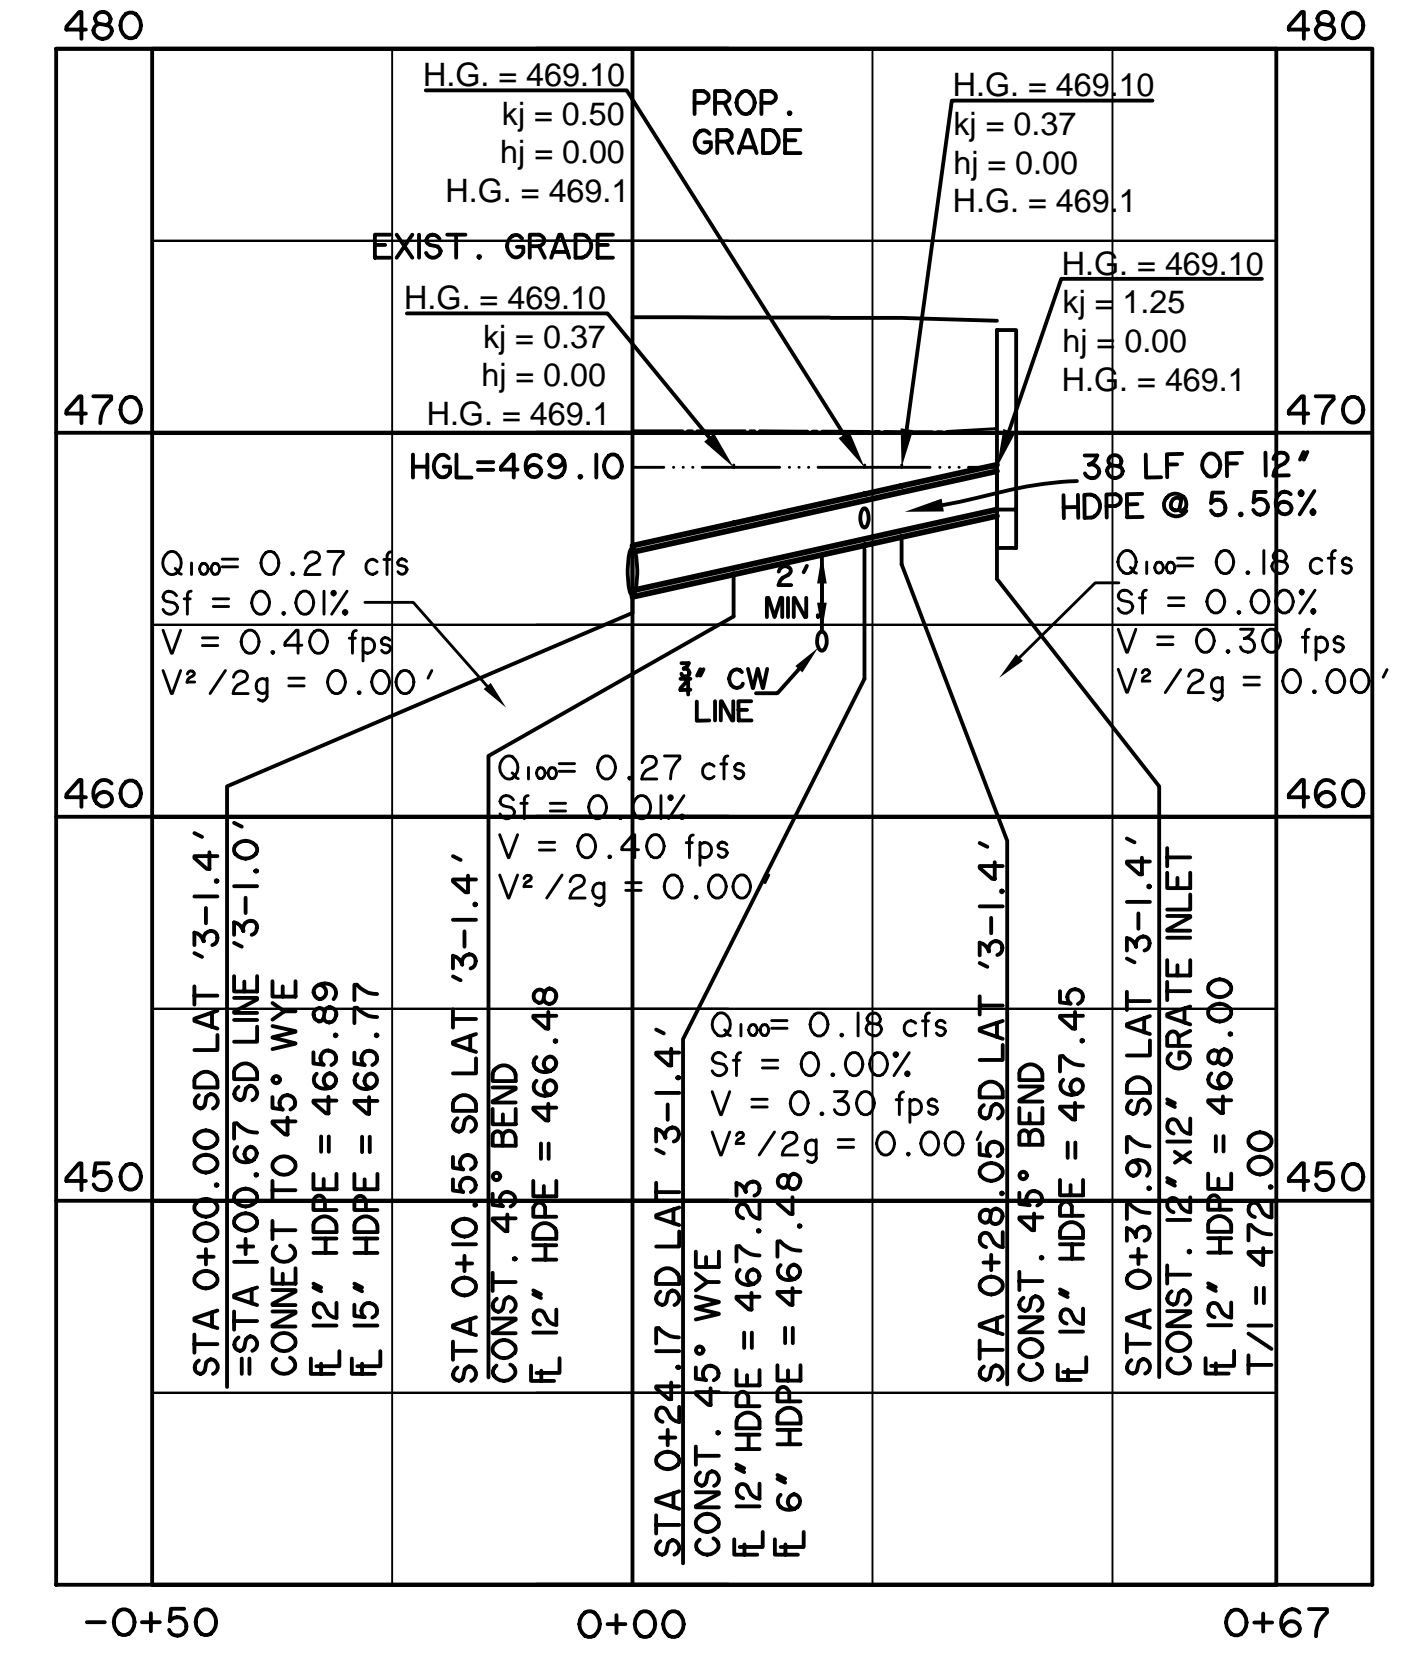


PRIVATE
S.D. LAT '3-1.5'

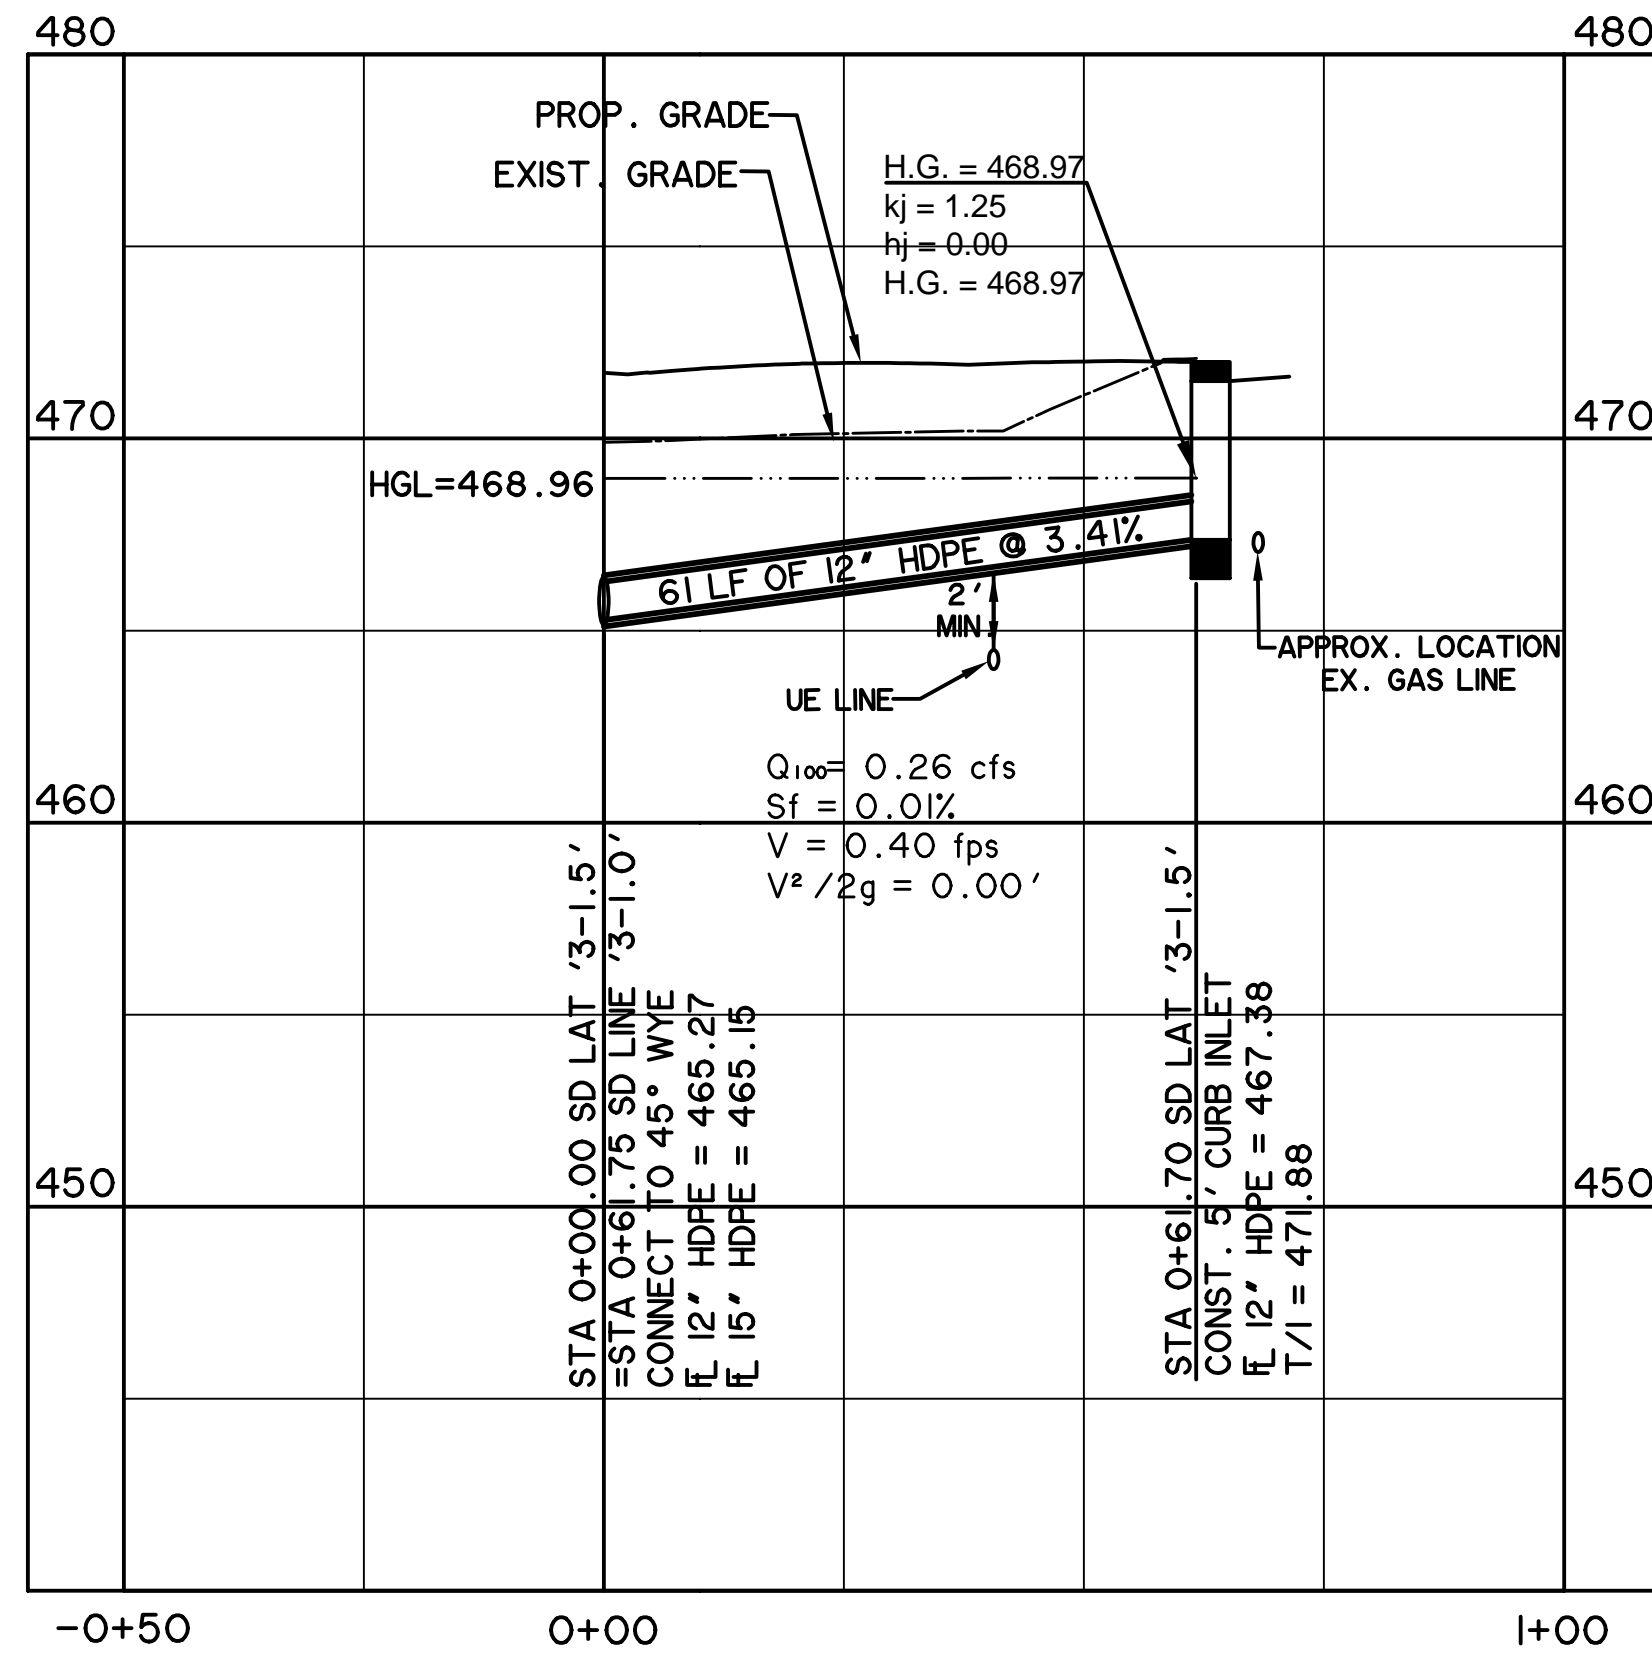


PRIVATE
S.D. LAT '3-1.6'

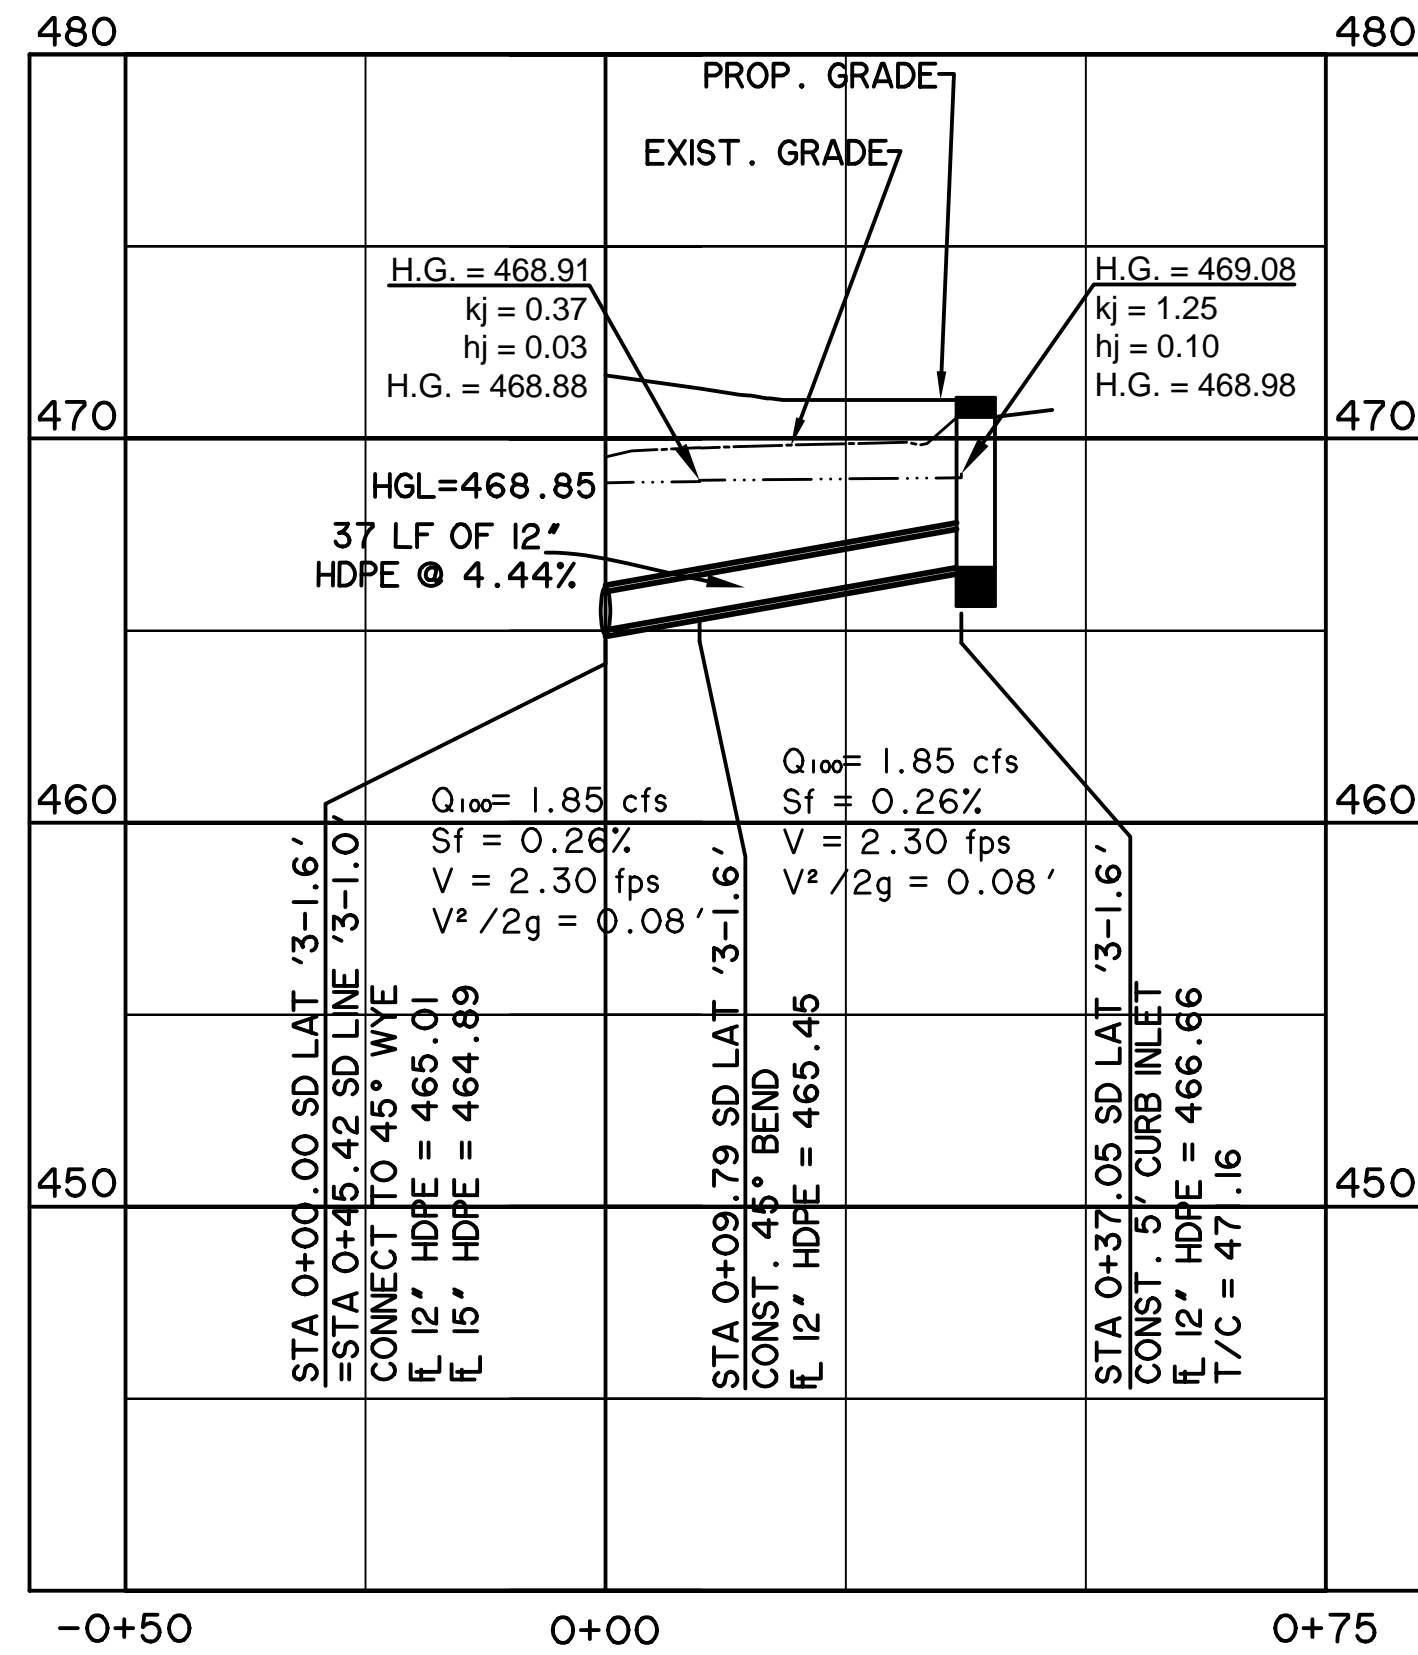

PRIVATE
S.D. LINE '3-2.0'

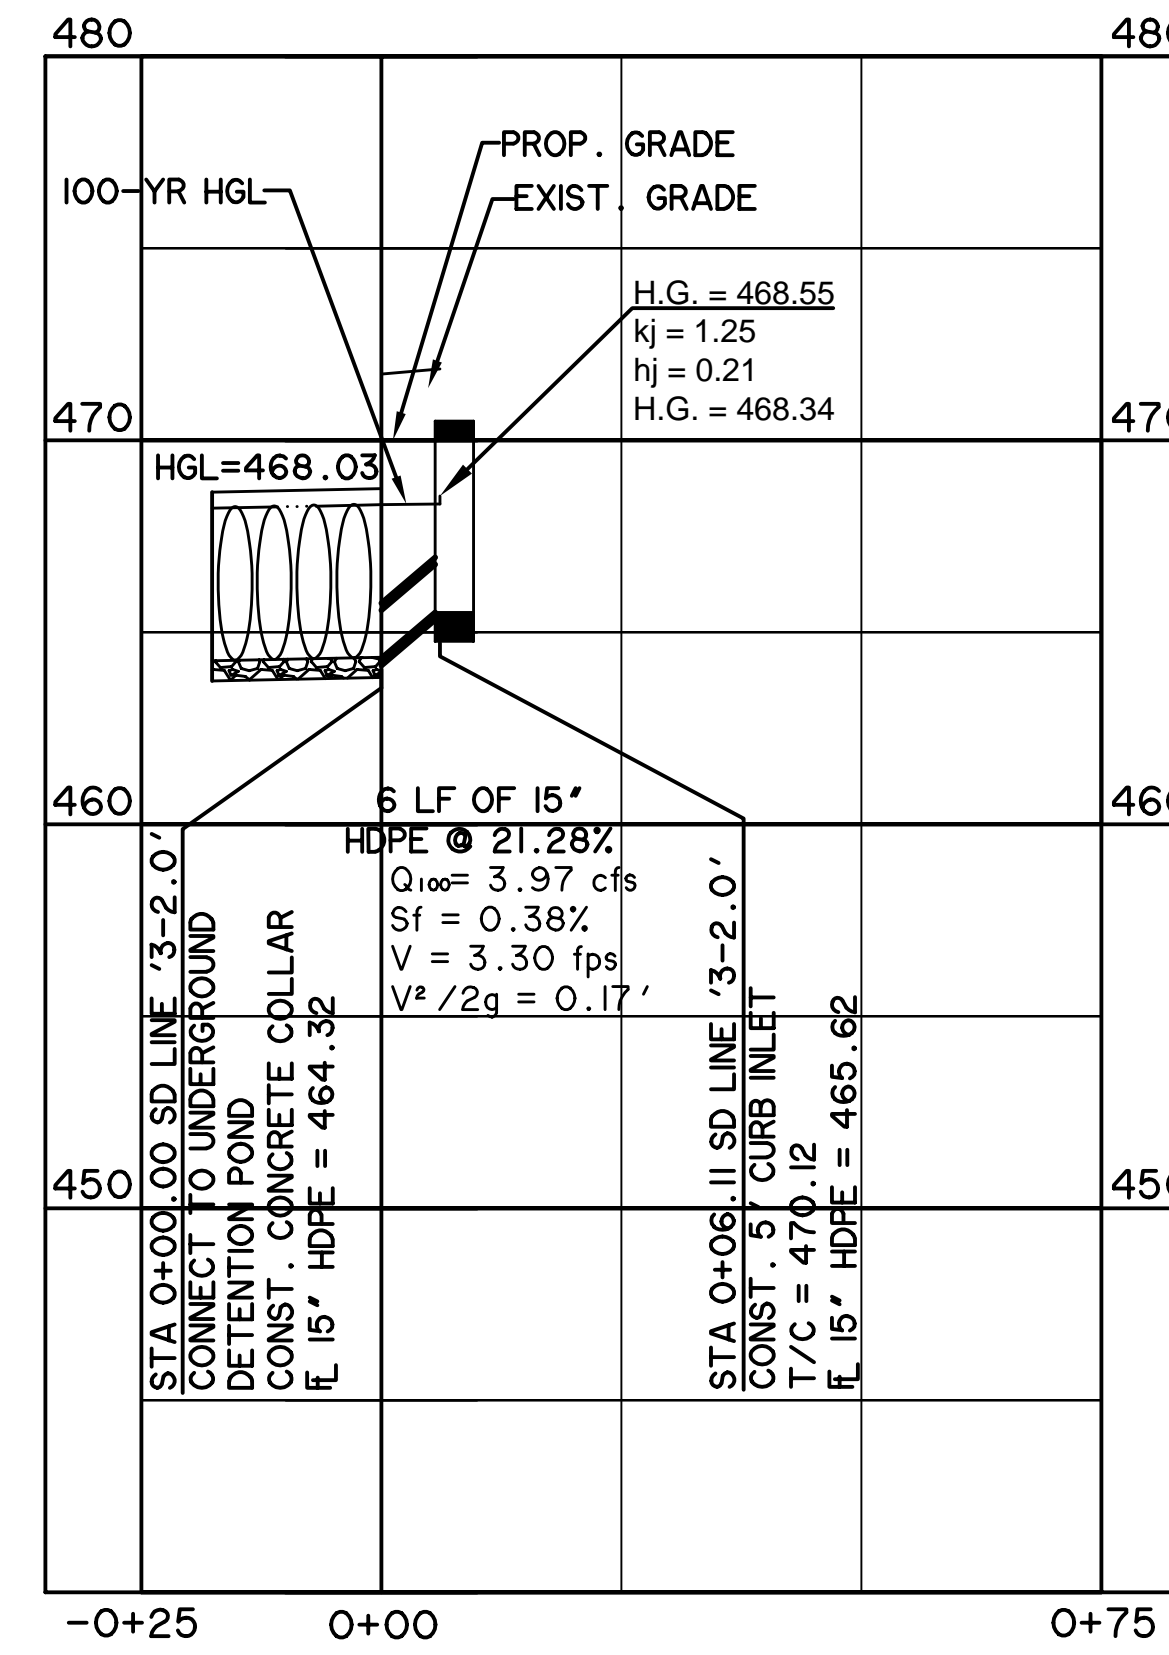

PRIVATE
S.D. LINE '3-3.0'

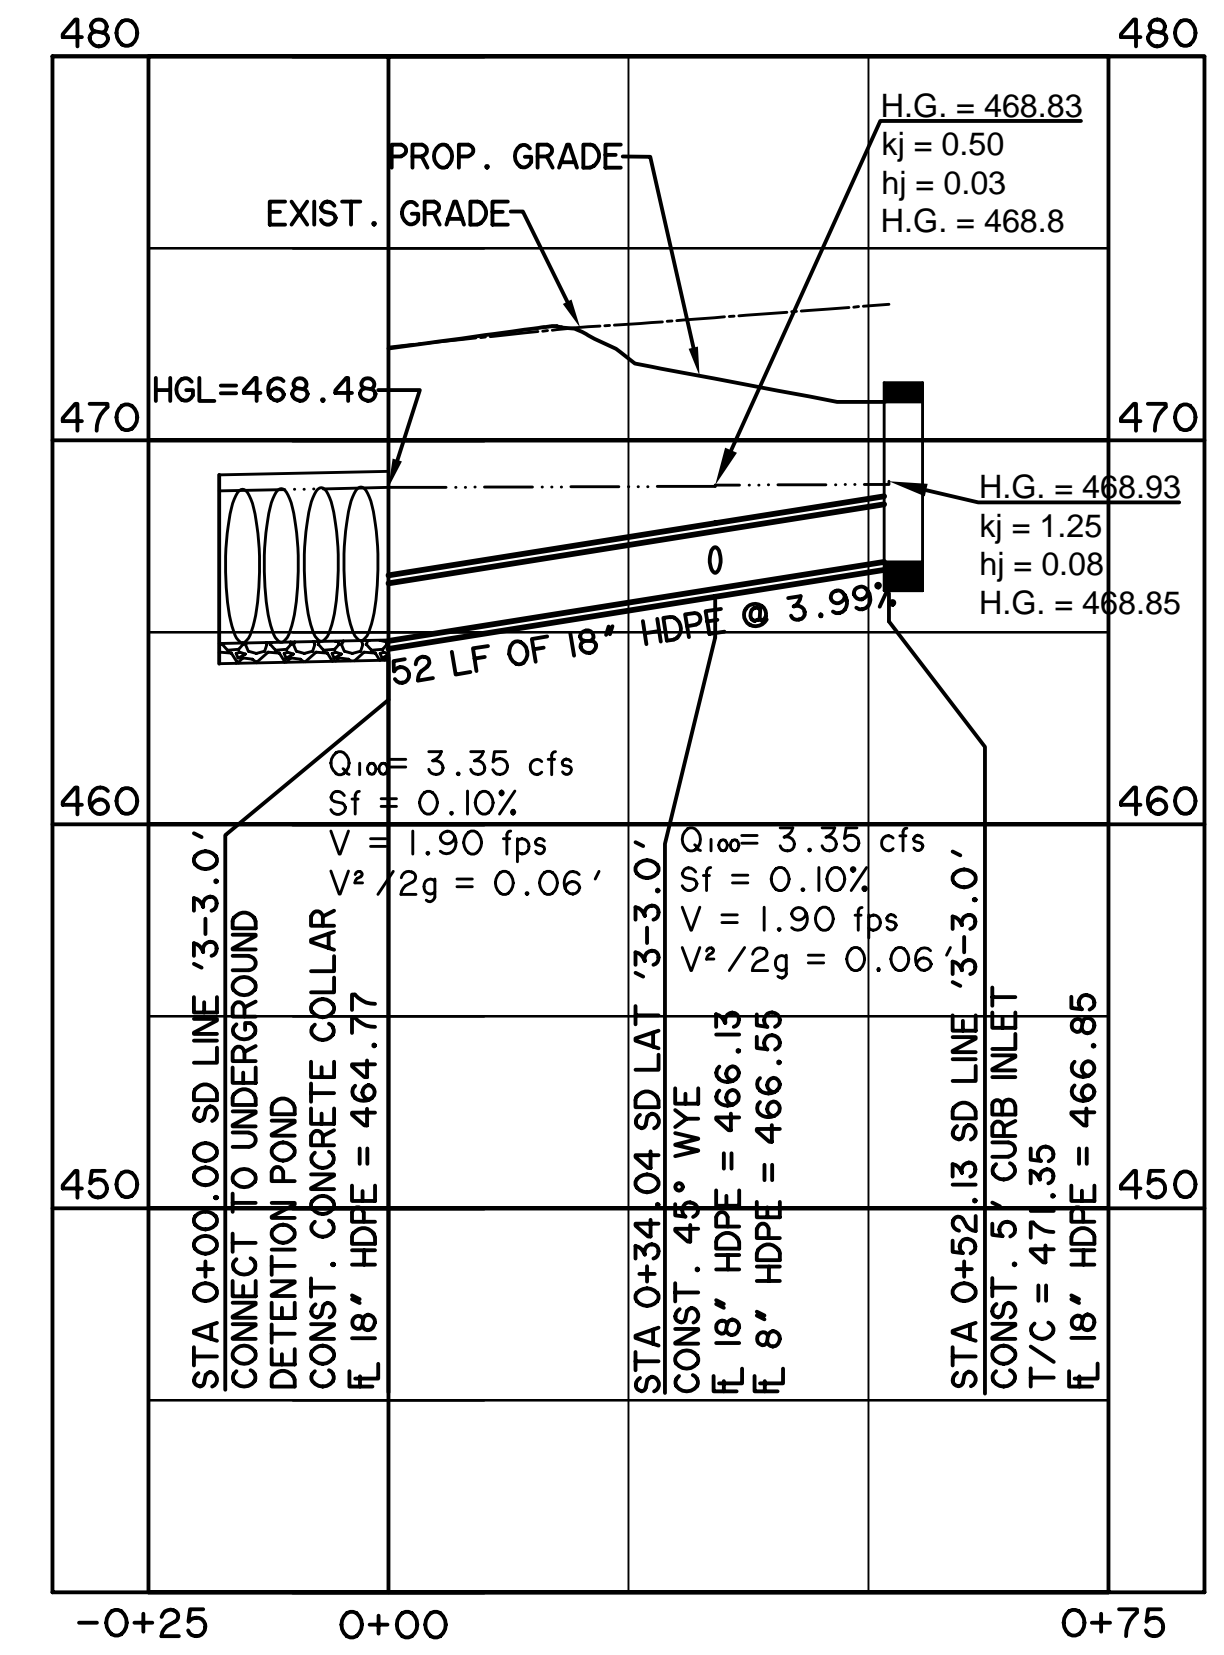

RECORD DRAWING
June 9, 2020

To the best of our knowledge Wier & Associates, Inc. states this plan is As-Built. This information provided is based on surveying at the site and information provided by the contractor.

ALL RESPONSIBILITY FOR ADEQUACY OF DESIGN REMAINS WITH THE DESIGN ENGINEER. THE CITY OF ROCKWALL, IN REVIEWING AND RELEASING PLANS FOR CONSTRUCTION, ASSUMES NO RESPONSIBILITY FOR ADEQUACY OR ACCURACY OF DESIGN.


CAUTION !!

EXISTING UTILITIES ARE INDICATED ON THE PLANS FROM AVAILABLE INFORMATION. IT SHALL BE THE RESPONSIBILITY OF THE CONTRACTOR TO VERIFY THE LOCATION OF ALL UTILITIES, TO NOTIFY ALL UTILITY COMPANIES OF THE CONTRACTORS OPERATIONS, TO PROTECT ALL UTILITIES FROM DAMAGE, TO REPAIR ALL UTILITIES DAMAGED DUE TO THE CONTRACTORS OPERATIONS, AND TO NOTIFY THE ENGINEER PROMPTLY OF ALL CONFLICTS OF THE WORK WITH EXISTING UTILITIES.

HORIZONTAL




VERTICAL

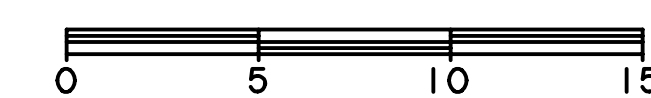

PREPARED BY:
WIA WIER & ASSOCIATES, INC.
ENGINEERS SURVEYORS LAND PLANNERS

2201 E. LAMAR BLVD., SUITE 200E ARLINGTON, TEXAS 76006 METRO (817)467-7700
Texas Firm Registration No. F-2776 www.WierAssociates.com

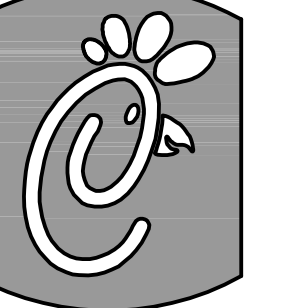

5200 Buffington Rd.
Atlanta Georgia,
30349-2998

Revisions:
Mark Date By
12/17/19 RBC

ISSUED FOR
CONSTRUCTION

Mark Date By

Mark Date By

LOT 2, BLOCK A
LAKESHORE COMMONS
1979 NORTH LAKESHORE DRIVE
ROCKWALL, TEXAS
STORE# 03897

STORE
SERIES
P13-LSR

SHEET TITLE
STORM
SEWER
PROFILES

For Permit
For Bid
For Construction

Job No. : 17144
Store : #03897
Date : 12/19/2019
Drawn By : MCC
Checked By : RRR

Sheet

PS-2.1