

### 5 YEAR STORM - DETENTION STORAGE VOLUME

5 YR POND DESIGN		Rainfall Intensity, I (in/hr)				A	Q <sub>peak</sub> = Q <sub>0</sub>
Step		K	C	T <sub>c</sub> (min)	I (in/hr)	(acres)	(cfs)
1	Existing Conditions						2.76
2	Proposed Conditions	1	0.90	10	6.10	1.4	7.74

**EXISTING CONDITIONS**  
 C<sub>ex</sub> = UNDEVELOPED RUN-OFF COEFFICIENT = 0.35  
 I<sub>20</sub> = 4.9 in/hr  
 A<sub>ex</sub> = UNDEVELOPED AREA = DRAINAGE AREAS 3-1.0, 3-1.1, 3-1.2, 3-1.3, 3-1.3A, 3-1.4, 3-1.4A, 3-1.5, 3-1.6, 3-2.0, & 3-3.0 (SEE DA MAP SHEET C-7)

C<sub>dev</sub> = DEVELOPED RUN-OFF COEFFICIENT = 0.90  
 I<sub>10</sub> = 6.1 in/hr  
 A<sub>dev</sub> = DEVELOPED AREA = DRAINAGE AREA 3A (SEE DA MAP SHEET C-7)

$Q_{5,ex} = C_{ex} * I_{20} * A_{ex} + C_{dev} * I_{10} * A_{dev}$   
 $Q_{5,ex} = 0.35 * 4.9 * 1.32 + 0.90 * 6.1 * 0.09$   
 $Q_{5,ex} = 2.76 \text{ cfs}$

Time Step	T <sub>d</sub> duration (min)	K	C	I (in/hr)	A (acres)	Q <sub>peak</sub> (cfs)	Volume (ft <sup>3</sup> )			Volume (acre-ft)
							Inflow T <sub>d</sub> *Q*60	Outflow 0.5*(T <sub>c</sub> +T <sub>d</sub> )*Q*60	Required Storage Inflow-Outflow	
1	10	1	0.90	6.10	1.41	7.74	4,645	1,655	2,990	0.069
2	20	1	0.90	4.90	1.41	6.22	7,462	2,482	4,980	0.114
3	30	1	0.90	4.10	1.41	5.20	9,365	3,309	6,056	0.139
4	40	1	0.90	3.40	1.41	4.31	10,355	4,137	6,218	0.143
5	50	1	0.90	2.80	1.41	3.55	10,660	4,964	5,695	0.131
6	60	1	0.90	2.60	1.41	3.30	11,878	5,792	6,086	0.140
7	70	1	0.90	2.40	1.41	3.05	12,792	6,619	6,173	0.142

MAX STORAGE (AC-FT) 0.14  
6,218

**PROPOSED CONDITIONS**  
 C<sub>dev</sub> = DEVELOPED RUN-OFF COEFFICIENT = 0.90  
 I<sub>10</sub> = 6.1 in/hr  
 A<sub>dev</sub> = DEVELOPED AREA = DRAINAGE AREAS 3-1.0, 3-1.1, 3-1.2, 3-1.3, 3-1.3A, 3-1.4, 3-1.4A, 3-1.5, 3-1.6, 3-2.0, 3-3.0, & 3A (SEE DA MAP SHEET C-7)

Q<sub>5,ult</sub> = C<sub>dev</sub>\*I<sub>10</sub>\*A<sub>dev</sub>  
 Q<sub>5,ult</sub> = 0.9\*6.1\*1.4  
 Q<sub>5,ult</sub> = 7.74 cfs

### 10 YEAR STORM - DETENTION STORAGE VOLUME

10 YR POND DESIGN		Rainfall Intensity, I (in/hr)				A	Q <sub>peak</sub> = Q <sub>0</sub>
Step		K	C	T <sub>c</sub> (min)	I (in/hr)	(acres)	(cfs)
1	Existing Conditions						3.30
2	Proposed Conditions	1	0.90	10	7.10	1.4	9.01

**EXISTING CONDITIONS**  
 C<sub>ex</sub> = UNDEVELOPED RUN-OFF COEFFICIENT = 0.35  
 I<sub>20</sub> = 5.9 in/hr  
 A<sub>ex</sub> = UNDEVELOPED AREA = DRAINAGE AREAS 3-1.0, 3-1.1, 3-1.2, 3-1.3, 3-1.3A, 3-1.4, 3-1.4A, 3-1.5, 3-1.6, 3-2.0, & 3-3.0 (SEE DA MAP SHEET C-7)

C<sub>dev</sub> = DEVELOPED RUN-OFF COEFFICIENT = 0.90  
 I<sub>10</sub> = 7.1 in/hr  
 A<sub>dev</sub> = DEVELOPED AREA = DRAINAGE AREA 3A (SEE DA MAP SHEET C-7)

$Q_{10,ex} = C_{ex} * I_{20} * A_{ex} + C_{dev} * I_{10} * A_{dev}$   
 $Q_{10,ex} = 0.35 * 5.9 * 1.32 + 0.90 * 7.1 * 0.09$   
 $Q_{10,ex} = 3.30 \text{ cfs}$

Time Step	T <sub>d</sub> duration (min)	K	C	I (in/hr)	A (acres)	Q <sub>peak</sub> (cfs)	Volume (ft <sup>3</sup> )			Volume (acre-ft)
							Inflow T <sub>d</sub> *Q*60	Outflow 0.5*(T <sub>c</sub> +T <sub>d</sub> )*Q*60	Required Storage Inflow-Outflow	
1	10	1	0.90	7.10	1.41	9.01	5,406	1,981	3,425	0.079
2	20	1	0.90	5.90	1.41	7.49	8,985	2,971	6,014	0.138
3	30	1	0.90	4.80	1.41	6.09	10,964	3,961	7,003	0.161
4	40	1	0.90	4.00	1.41	5.08	12,182	4,951	7,231	0.166
5	50	1	0.90	3.50	1.41	4.44	13,325	5,942	7,383	0.169
6	60	1	0.90	3.00	1.41	3.81	13,705	6,932	6,773	0.155
7	70	1	0.90	2.80	1.41	3.55	14,923	7,922	7,001	0.161

MAX STORAGE (AC-FT) 0.17  
7,383

**PROPOSED CONDITIONS**  
 C<sub>dev</sub> = DEVELOPED RUN-OFF COEFFICIENT = 0.90  
 I<sub>10</sub> = 7.1 in/hr  
 A<sub>dev</sub> = DEVELOPED AREA = DRAINAGE AREAS 3-1.0, 3-1.1, 3-1.2, 3-1.3, 3-1.3A, 3-1.4, 3-1.4A, 3-1.5, 3-1.6, 3-2.0, 3-3.0, & 3A (SEE DA MAP SHEET C-7)

Q<sub>10,ult</sub> = C<sub>dev</sub>\*I<sub>10</sub>\*A<sub>dev</sub>  
 Q<sub>10,ult</sub> = 0.9\*7.1\*1.4  
 Q<sub>10,ult</sub> = 9.01 cfs

### 25 YEAR STORM - DETENTION STORAGE VOLUME

25 YR POND DESIGN		Rainfall Intensity, I (in/hr)				A	Q <sub>peak</sub> = Q <sub>0</sub>
Step		K	C	T <sub>c</sub> (min)	I (in/hr)	(acres)	(cfs)
1	Existing Conditions						3.72
2	Proposed Conditions	1	0.90	10	8.30	1.4	10.53

**EXISTING CONDITIONS**  
 C<sub>ex</sub> = UNDEVELOPED RUN-OFF COEFFICIENT = 0.35  
 I<sub>20</sub> = 6.6 in/hr  
 A<sub>ex</sub> = UNDEVELOPED AREA = DRAINAGE AREAS 3-1.0, 3-1.1, 3-1.2, 3-1.3, 3-1.3A, 3-1.4, 3-1.4A, 3-1.5, 3-1.6, 3-2.0, & 3-3.0 (SEE DA MAP SHEET C-7)

C<sub>dev</sub> = DEVELOPED RUN-OFF COEFFICIENT = 0.90  
 I<sub>10</sub> = 8.3 in/hr  
 A<sub>dev</sub> = DEVELOPED AREA = DRAINAGE AREA 3A (SEE DA MAP SHEET C-7)

$Q_{25,ex} = C_{ex} * I_{20} * A_{ex} + C_{dev} * I_{10} * A_{dev}$   
 $Q_{25,ex} = 0.35 * 6.6 * 1.32 + 0.90 * 8.3 * 0.09$   
 $Q_{25,ex} = 3.72 \text{ cfs}$

Time Step	T <sub>d</sub> duration (min)	K	C	I (in/hr)	A (acres)	Q <sub>peak</sub> (cfs)	Volume (ft <sup>3</sup> )			Volume (acre-ft)
							Inflow T <sub>d</sub> *Q*60	Outflow 0.5*(T <sub>c</sub> +T <sub>d</sub> )*Q*60	Required Storage Inflow-Outflow	
1	10	1	0.90	8.30	1.41	10.53	6,320	2,233	4,087	0.094
2	20	1	0.90	6.60	1.41	8.38	10,050	3,349	6,701	0.154
3	30	1	0.90	5.50	1.41	6.98	12,563	4,466	8,097	0.186
4	40	1	0.90	4.60	1.41	5.84	14,010	5,582	8,428	0.193
5	50	1	0.90	4.00	1.41	5.08	15,228	6,699	8,529	0.196
6	60	1	0.90	3.50	1.41	4.44	15,989	7,815	8,174	0.188
7	70	1	0.90	3.30	1.41	4.19	17,588	8,932	8,657	0.199

MAX STORAGE (AC-FT) 0.20  
8,657

**PROPOSED CONDITIONS**  
 C<sub>dev</sub> = DEVELOPED RUN-OFF COEFFICIENT = 0.90  
 I<sub>10</sub> = 8.3 in/hr  
 A<sub>dev</sub> = DEVELOPED AREA = DRAINAGE AREAS 3-1.0, 3-1.1, 3-1.2, 3-1.3, 3-1.3A, 3-1.4, 3-1.4A, 3-1.5, 3-1.6, 3-2.0, 3-3.0, & 3A (SEE DA MAP SHEET C-7)

Q<sub>25,ult</sub> = C<sub>dev</sub>\*I<sub>10</sub>\*A<sub>dev</sub>  
 Q<sub>25,ult</sub> = 0.9\*8.3\*1.4  
 Q<sub>25,ult</sub> = 10.53 cfs

### 100 YEAR STORM - DETENTION STORAGE VOLUME

100 YR POND DESIGN		Rainfall Intensity, I (in/hr)				A	Q <sub>peak</sub> = Q <sub>0</sub>
Step		K	C	T <sub>c</sub> (min)	I (in/hr)	(acres)	(cfs)
1	Existing Conditions						4.63
2	Proposed Conditions	1	0.90	10	9.80	1.4	12.44

**EXISTING CONDITIONS**  
 C<sub>ex</sub> = UNDEVELOPED RUN-OFF COEFFICIENT = 0.35  
 I<sub>20</sub> = 8.3 in/hr  
 A<sub>ex</sub> = UNDEVELOPED AREA = DRAINAGE AREAS 3-1.0, 3-1.1, 3-1.2, 3-1.3, 3-1.3A, 3-1.4, 3-1.4A, 3-1.5, 3-1.6, 3-2.0, & 3-3.0 (SEE DA MAP SHEET C-7)

C<sub>dev</sub> = DEVELOPED RUN-OFF COEFFICIENT = 0.90  
 I<sub>10</sub> = 9.8 in/hr  
 A<sub>dev</sub> = DEVELOPED AREA = DRAINAGE AREA 3A (SEE DA MAP SHEET C-7)

$Q_{100,ex} = C_{ex} * I_{20} * A_{ex} + C_{dev} * I_{10} * A_{dev}$   
 $Q_{100,ex} = 0.35 * 8.3 * 1.32 + 0.90 * 9.8 * 0.09$   
 $Q_{100,ex} = 4.63 \text{ cfs}$

Time Step	T <sub>d</sub> duration (min)	K	C	I (in/hr)	A (acres)	Q <sub>peak</sub> (cfs)	Volume (ft <sup>3</sup> )			Volume (acre-ft)
							Inflow T <sub>d</sub> *Q*60	Outflow 0.5*(T <sub>c</sub> +T <sub>d</sub> )*Q*60	Required Storage Inflow-Outflow	
1	10	1	0.90	9.80	1.41	12.44	7,462	2,777	4,685	0.108
2	20	1	0.90	8.30	1.41	10.53	12,639	4,166	8,474	0.195
3	30	1	0.90	6.90	1.41	8.76	15,761	5,554	10,207	0.234
4	40	1	0.90	5.80	1.41	7.36	17,664	6,943	10,722	0.246
5	50	1	0.90	5.00	1.41	6.35	19,035	8,331	10,704	0.246
6	60	1	0.90	4.50	1.41	5.71	20,558	9,720	10,838	0.249
7	70	1	0.90	4.00	1.41	5.08	21,319	11,108	10,211	0.234

MAX STORAGE (AC-FT) 0.25  
10,838

**PROPOSED CONDITIONS**  
 C<sub>dev</sub> = DEVELOPED RUN-OFF COEFFICIENT = 0.90  
 I<sub>10</sub> = 9.8 in/hr  
 A<sub>dev</sub> = DEVELOPED AREA = DRAINAGE AREAS 3-1.0, 3-1.1, 3-1.2, 3-1.3, 3-1.3A, 3-1.4, 3-1.4A, 3-1.5, 3-1.6, 3-2.0, 3-3.0, & 3A (SEE DA MAP SHEET C-7)


Q<sub>100,ult</sub> = C<sub>dev</sub>\*I<sub>10</sub>\*A<sub>dev</sub>  
 Q<sub>100,ult</sub> = 0.9\*9.8\*1.4  
 Q<sub>100,ult</sub> = 12.44 cfs

**RECORD DRAWING**  
**June 9, 2020**  
 To the best of our knowledge Wier & Associates, Inc., states this plan is As-Built. This information provided is based on surveying at the site and information provided by the contractor.

ALL RESPONSIBILITY FOR ADEQUACY OF DESIGN REMAINS WITH THE DESIGN ENGINEER. THE CITY OF ROCKWALL, IN REVIEWING AND RELEASING PLANS FOR CONSTRUCTION, ASSUMES NO RESPONSIBILITY FOR ADEQUACY OR ACCURACY OF DESIGN

**CAUTION !!**  
 EXISTING UTILITIES ARE INDICATED ON THE PLANS FROM AVAILABLE INFORMATION. IT SHALL BE THE RESPONSIBILITY OF THE CONTRACTOR TO VERIFY THE LOCATION OF ALL UTILITIES, TO NOTIFY ALL UTILITY COMPANIES OF THE CONTRACTORS OPERATIONS, TO PROTECT ALL UTILITIES FROM DAMAGE, TO REPAIR ALL UTILITIES DAMAGED DUE TO THE CONTRACTORS OPERATIONS, AND TO NOTIFY THE ENGINEER PROMPTLY OF ALL CONFLICTS OF THE WORK WITH EXISTING UTILITIES.

PREPARED BY:  
**WIA WIER & ASSOCIATES, INC.**  
 ENGINEERS SURVEYORS LAND PLANNERS  
 2201 E. LAMAR BLVD., SUITE 200E ARLINGTON, TEXAS 76006 METRO (817)467-7700  
 Texas Firm Registration No. F-2776 www.WierAssociates.com

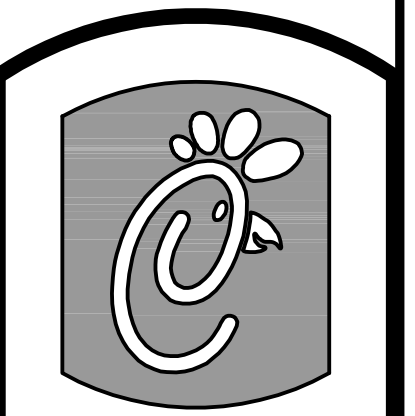


**Chris Wier**  
 5200 Buffington Rd.  
 Atlanta Georgia,  
 30349-2998

Revisions:  
 Mark Date By  
 12/17/19 RBC

ISSUED FOR CONSTRUCTION

Mark Date By

Mark Date By

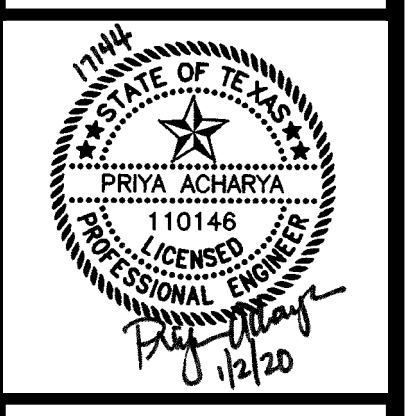

LOT 2, BLOCK A  
 LAKESHORE COMMONS  
 1979 NORTH LAKESHORE DRIVE  
 ROCKWALL, TEXAS  
 STORE# 03897

STORE SERIES P13-LSR

SHEET TITLE  
**DETENTION POND VOLUME REQUIREMENTS**

For Permit  
 For Bid  
 For Construction  
 Job No. : 17144  
 Store : #03897  
 Date : 10/4/2018  
 Drawn By : RRW  
 Checked By: PNA

Sheet  
**PS-3.1**