


STUB INFORMATION		
PIECE	STUB INVERT	SYSTEM INVERT
1	464.17	464.17
2	464.17	464.17
3	464.32	464.32
4	464.77	464.77

RISER INFORMATION		
PIECE	RIM ELEV.	SYSTEM INVERT
1	470.78	464.18
2	472.22	464.73

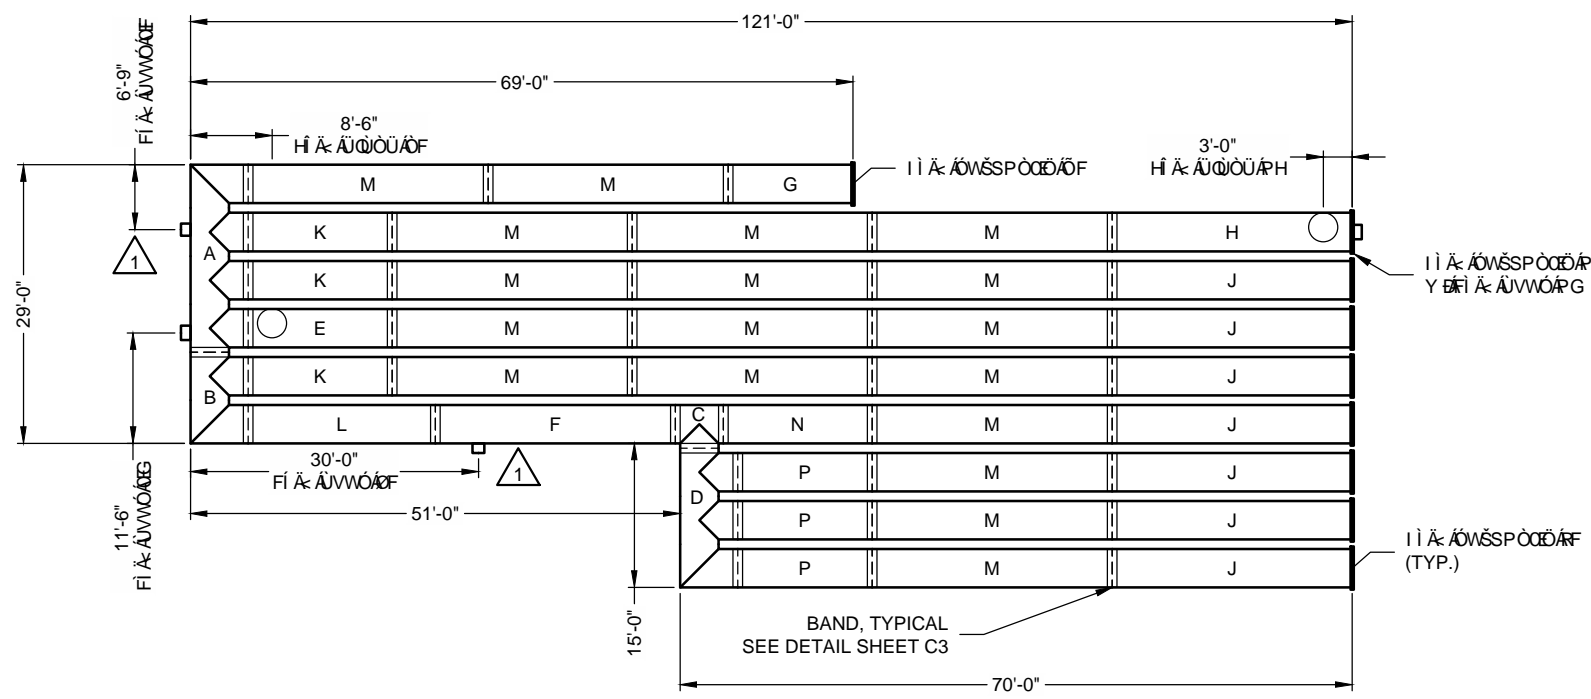


**RECORD DRAWING**  
**June 9, 2020**  
 To the best of our knowledge Wier & Associates, Inc., states this plan is As-Built. This information provided is based on surveying at the site and information provided by the contractor.

THE UNDERSIGNED HEREBY APPROVES THE ATTACHED (C5) PAGES INCLUDING THE FOLLOWING:

- PIPE STORAGE = 11,210 CF
- MAINLINE PIPE GAGE = 16
- WALL TYPE = SOLID
- DIAMETER = 48"
- FINISH = ALT2
- CORRUGATION = 2 2/3x1/2

CUSTOMER \_\_\_\_\_ DATE \_\_\_\_\_

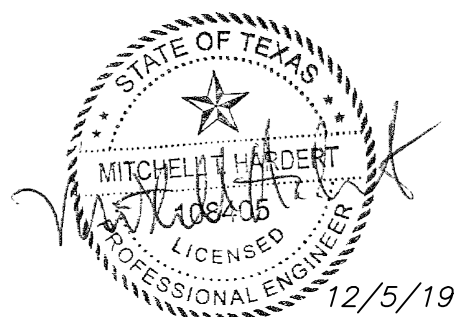

CBC ENGINEERS & ASSOCIATES, LTD.  
 TBPE FIRM NUMBER F-16105

**ASSEMBLY**  
 SCALE: 1" = 20'  
 PIPE STORAGE: 11,210 CF  
 LOADING: H2O  
 PIPE INV. = VARIES

- NOTES**
- ALL RISER AND STUB DIMENSIONS ARE TO CENTERLINE.
  - ALL ELEVATIONS, DIMENSIONS, AND LOCATIONS OF RISERS AND INLETS, SHALL BE VERIFIED BY THE ENGINEER OF RECORD (EOR) PRIOR TO RELEASING FOR FABRICATION.
  - ALL FITTINGS AND REINFORCEMENT COMPLY WITH ASTM A998.
  - ALL RISERS AND STUBS ARE 2 2/3" x 1/2" CORRUGATION AND 16 GAGE UNLESS OTHERWISE NOTED.
  - RISERS TO BE FIELD TRIMMED TO GRADE AS REQUIRED, BY CONTRACTOR.
  - QUANTITY OF PIPE SHOWN DOES NOT PROVIDE EXTRA PIPE FOR CONNECTING THE SYSTEM TO EXISTING PIPE OR DRAINAGE STRUCTURES. OUR SYSTEM AS DETAILED PROVIDES NOMINAL INLET AND/OR OUTLET PIPE STUB FOR CONNECTION TO EXISTING DRAINAGE FACILITIES. IF ADDITIONAL PIPE IS NEEDED IT IS THE RESPONSIBILITY OF THE CONTRACTOR.
  - ALL ACCESS CASTINGS ARE THE RESPONSIBILITY OF THE CONTRACTOR AND ARE NOT SUPPLIED BY CONTECH.

Approved By	Date		Rev.	Date	By	Description
MTH	12/5/19					
Project No.	Rev.					
CBC-22908	-					

The design and information shown on this drawing is provided as a service to the project owner, engineer and contractor by Contech Engineered Solutions LLC ("Contech"). Neither this drawing, nor any part thereof, may be used, reproduced or modified in any manner without the prior written consent of Contech. Failure to comply is done at the user's own risk and Contech expressly disclaims any liability or responsibility for such use.

If discrepancies between the supplied information upon which the drawing is based and actual field conditions are encountered as site work progresses, these discrepancies must be reported to Contech immediately for re-evaluation of the design. Contech accepts no liability for designs based on missing, incomplete or inaccurate information supplied by others.

MARK	DATE	REVISION DESCRIPTION	BY
1	10/15/2019	STUB SIZE CHANGE	SJ

**CONTECH**  
 ENGINEERED SOLUTIONS LLC  
 www.ContechES.com  
 11815 NE Glenn Widing Drive, Portland, OR 97220  
 800-548-4667 503-240-3393 800-561-1271 FAX

**CONTECH**  
 CMP DETENTION SYSTEMS  
 CONTECH CONTRACT DRAWING

11815 NE Glenn Widing Drive, Portland, OR 97220 - 577163-010  
 CHICK FIL A - LAKESHORE COMMONS  
 ROCKWALL, TX  
 SITE DESIGNATION: UNDERGROUND STORAGE

PROJECT No.:	SEQ. No.:	DATE:
577163	010	10/15/2019
DESIGNED:	DRAWN:	
LMO	PDW/SJ	
CHECKED:	APPROVED:	
SHEET NO.:		
C1		OF C5