


# CONSTRUCTION PLANS FOR LAKESIDE CHEVROLET

5.240 ACRES

JOSEPH CADLE SURVEY, ABSTRACT No. 65,  
CITY OF ROCKWALL, ROCKWALL COUNTY, TEXAS

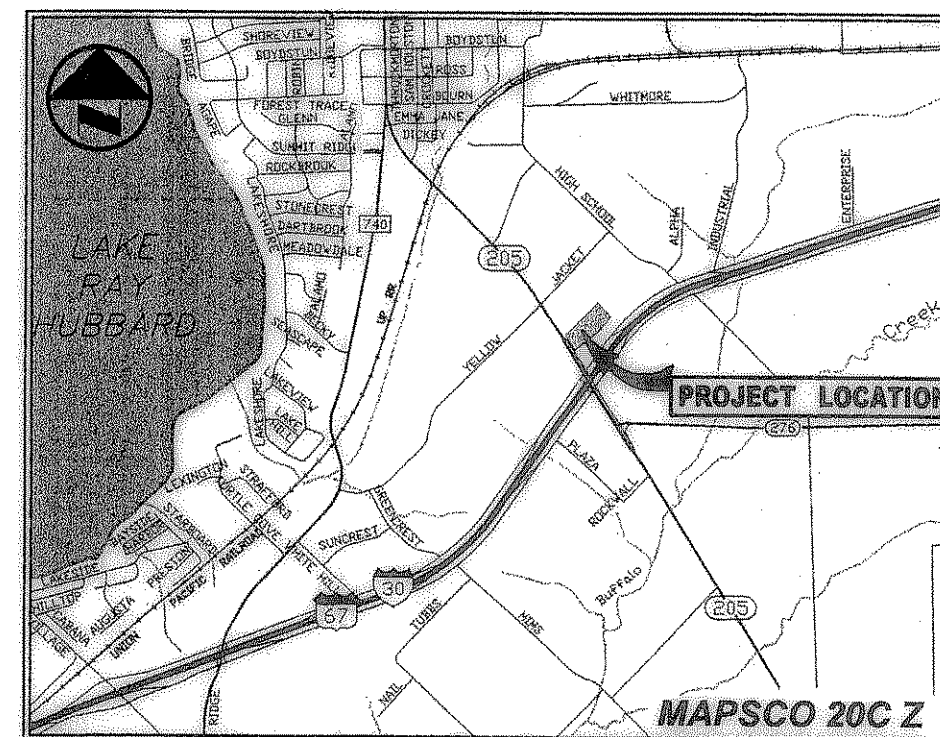

VICINITY MAP

FOR


HILL & WILKINSON  
800 KLEIN ROAD, SUITE 100  
PLANO, TEXAS 75074

PREPARED BY

 **Pacheco Koch Consulting Engineers**  
9401 LBJ FREEWAY SUITE 300 DALLAS, TEXAS 75243 972.235.3031

## DRAWING SHEET INDEX

SHEET	DESCRIPTION
-	FINAL PLAT (SHEET 1)
-	FINAL PLAT (SHEET 2)
C1.0	DEMOLITION PLAN
C2.0	DIMENSIONAL CONTROL PLAN
C3.0	GRADING PLAN
C4.0	DRAINAGE PLAN
C4.1	STORM SEWER PROFILES
C4.2	DRAINAGE AREA MAP
C5.0	WATER & SANITARY SEWER PLAN
C6.0	PAVING PLAN
C6.1	PAVING DETAILS
C7.0	EROSION CONTROL PLAN
C7.1	EROSION CONTROL DETAILS

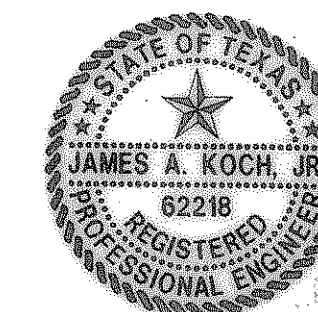

THIS DOCUMENT IS RELEASED FOR THE PURPOSE  
OF INTERIM REVIEW UNDER THE AUTHORITY OF JAMES  
A. KOCH JR., P.E. 62218 ON 08/28/01. IT IS  
NOT TO BE USED FOR CONSTRUCTION, BIDDING OR  
PERMIT PURPOSES.

# PROJECT RECORD