



THE SEAL APPEARING ON THIS DOCUMENT WAS AUTHORIZED BY JOE T. MILLICAN, P.E. NO. 35154 ON 08/04/05

Revisions:
07.22.04: DOMESTIC WATER SERVICE

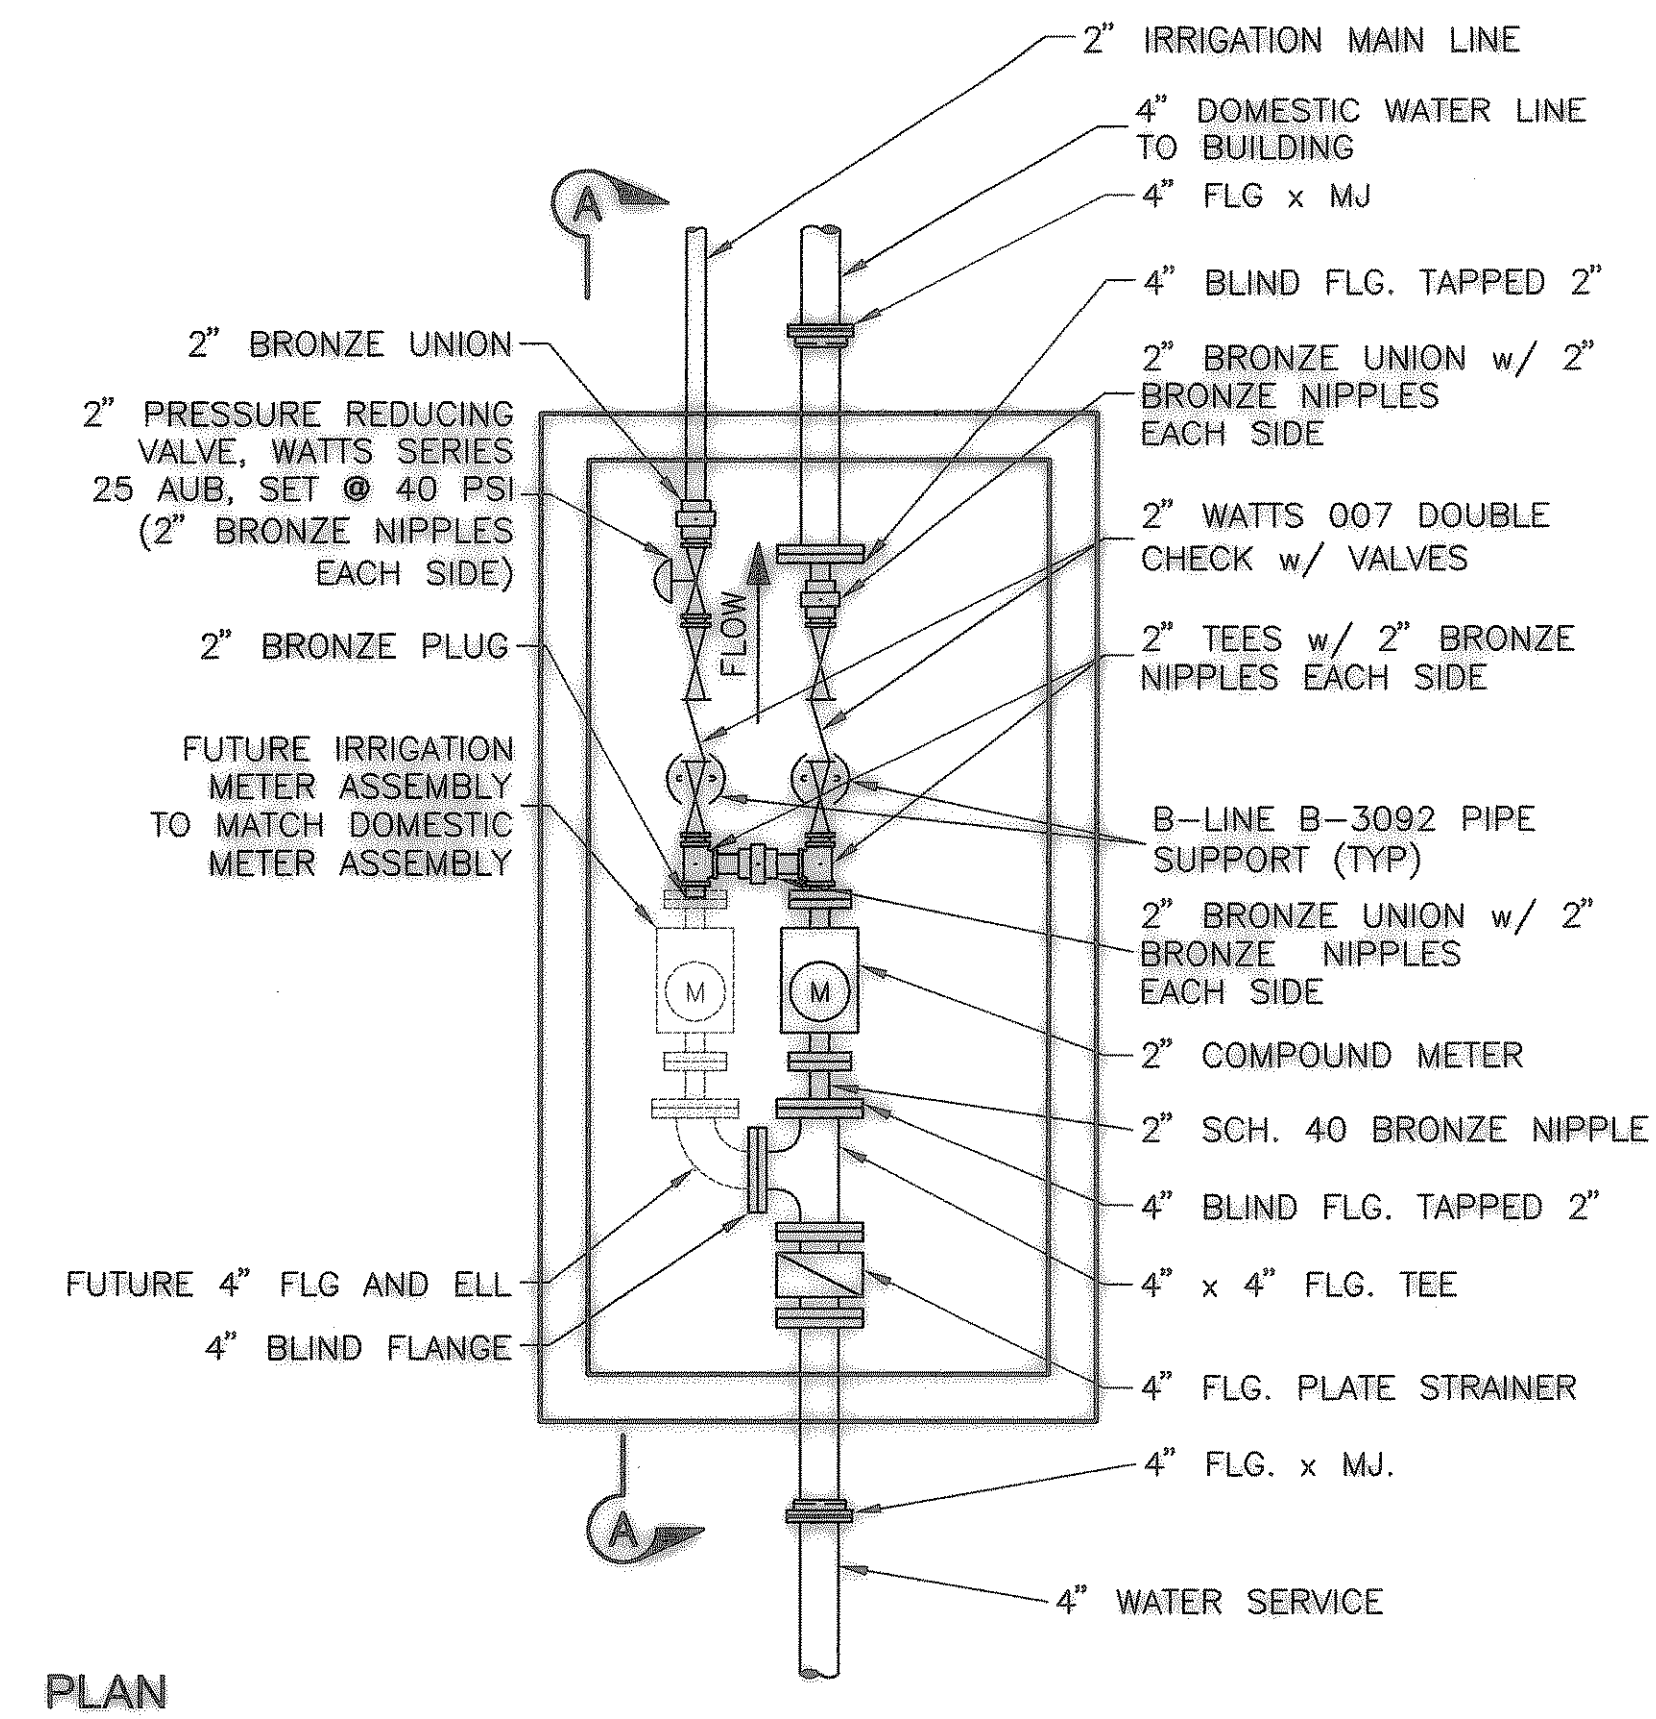

PLAN

NOTE: OBTAIN WATER METERS FROM BLACKLAND W.S.C. COMPLETE ASSEMBLY MUST BE APPROVED BY BLACKLAND W.S.C INSPECTOR.

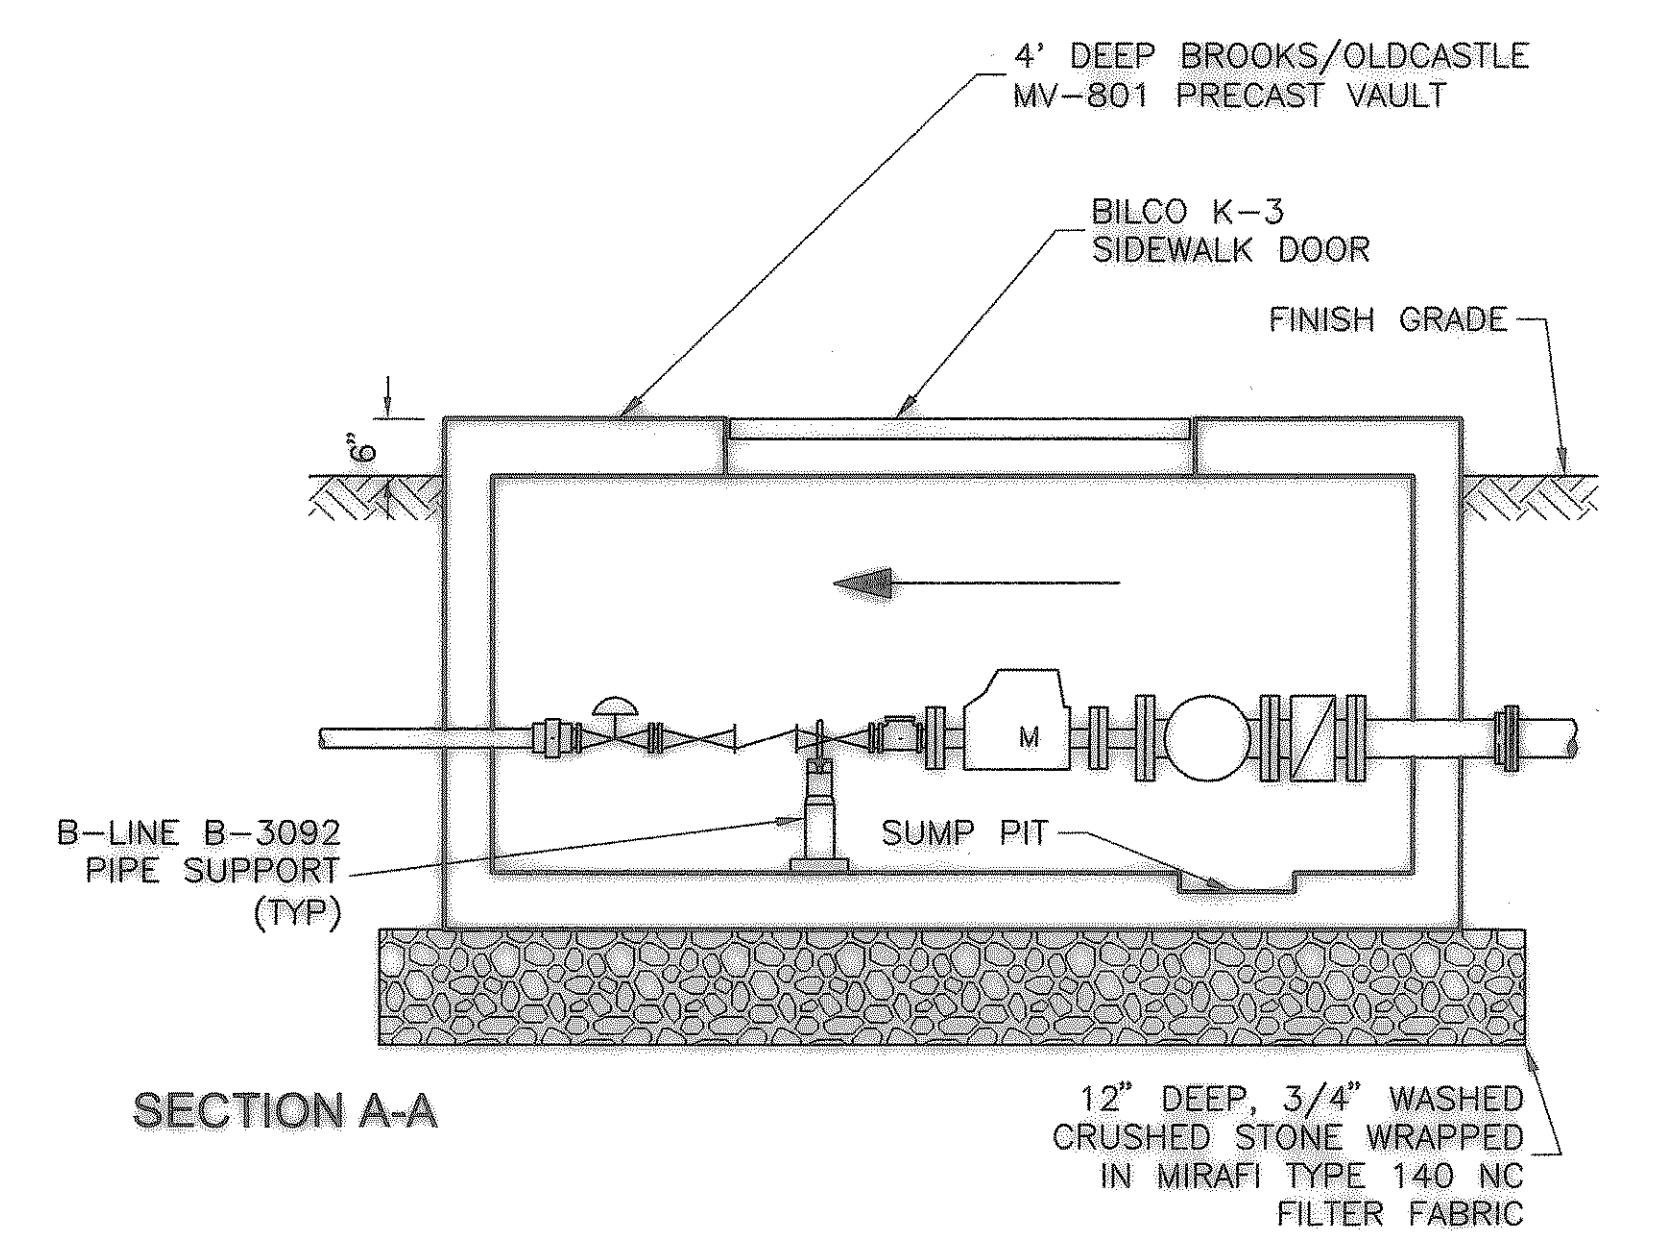

SECTION A-A

④ METER/BACKFLOW PREVENTER
NO SCALE

HALLUM ARCHITECTS, INC.
2501 PARKVIEW DRIVE SUITE 430
FORT WORTH, TEXAS 76102
PHONE: 817.332.2422 FAX: 817.338.1949
email: info@hallumarch.com

Rockwall Lakeside Church of Christ
New Auditorium and Education Facilities
485 North FM 549, Rockwall, Texas 75087

SITE IRRIGATION DETAILS
RECORD DRAWING
(ALL REVISIONS ARE BASED UPON NOTES AND COMMENTS SUBMITTED BY FRANK DALE CONSTRUCTION CO., LTD.)

Date: 8-4-2005
Scale: AS NOTED
Drawn: FMI
Job: 2002-10

Sheet Number:
C4.3