




S:\DRAWING\03-13-2013 - 1:40PM\02\ARSENUS\03-11-03S-COVER SHEET.DWG
 02 ARSENUS\03-11-03S-COVER SHEET.DWG
 03-11-03S-COVER SHEET.DWG
 04-30-12 REVISED DUMPSTER DRAIN
 02-28-12 REVISED WATER TAP
 02-09-12 ADDED DETAILS FOR FIRE LINE
 10-31-11 CITY COMMENTS
 09-16-11 CITY COMMENTS
 S:\DRAWING\03-13-2013 - 1:40PM\02\ARSENUS\03-11-03S-COVER SHEET.DWG
 02 ARSENUS\03-11-03S-COVER SHEET.DWG
 03-11-03S-COVER SHEET.DWG
 04-30-12 REVISED DUMPSTER DRAIN
 02-28-12 REVISED WATER TAP
 02-09-12 ADDED DETAILS FOR FIRE LINE
 10-31-11 CITY COMMENTS
 09-16-11 CITY COMMENTS

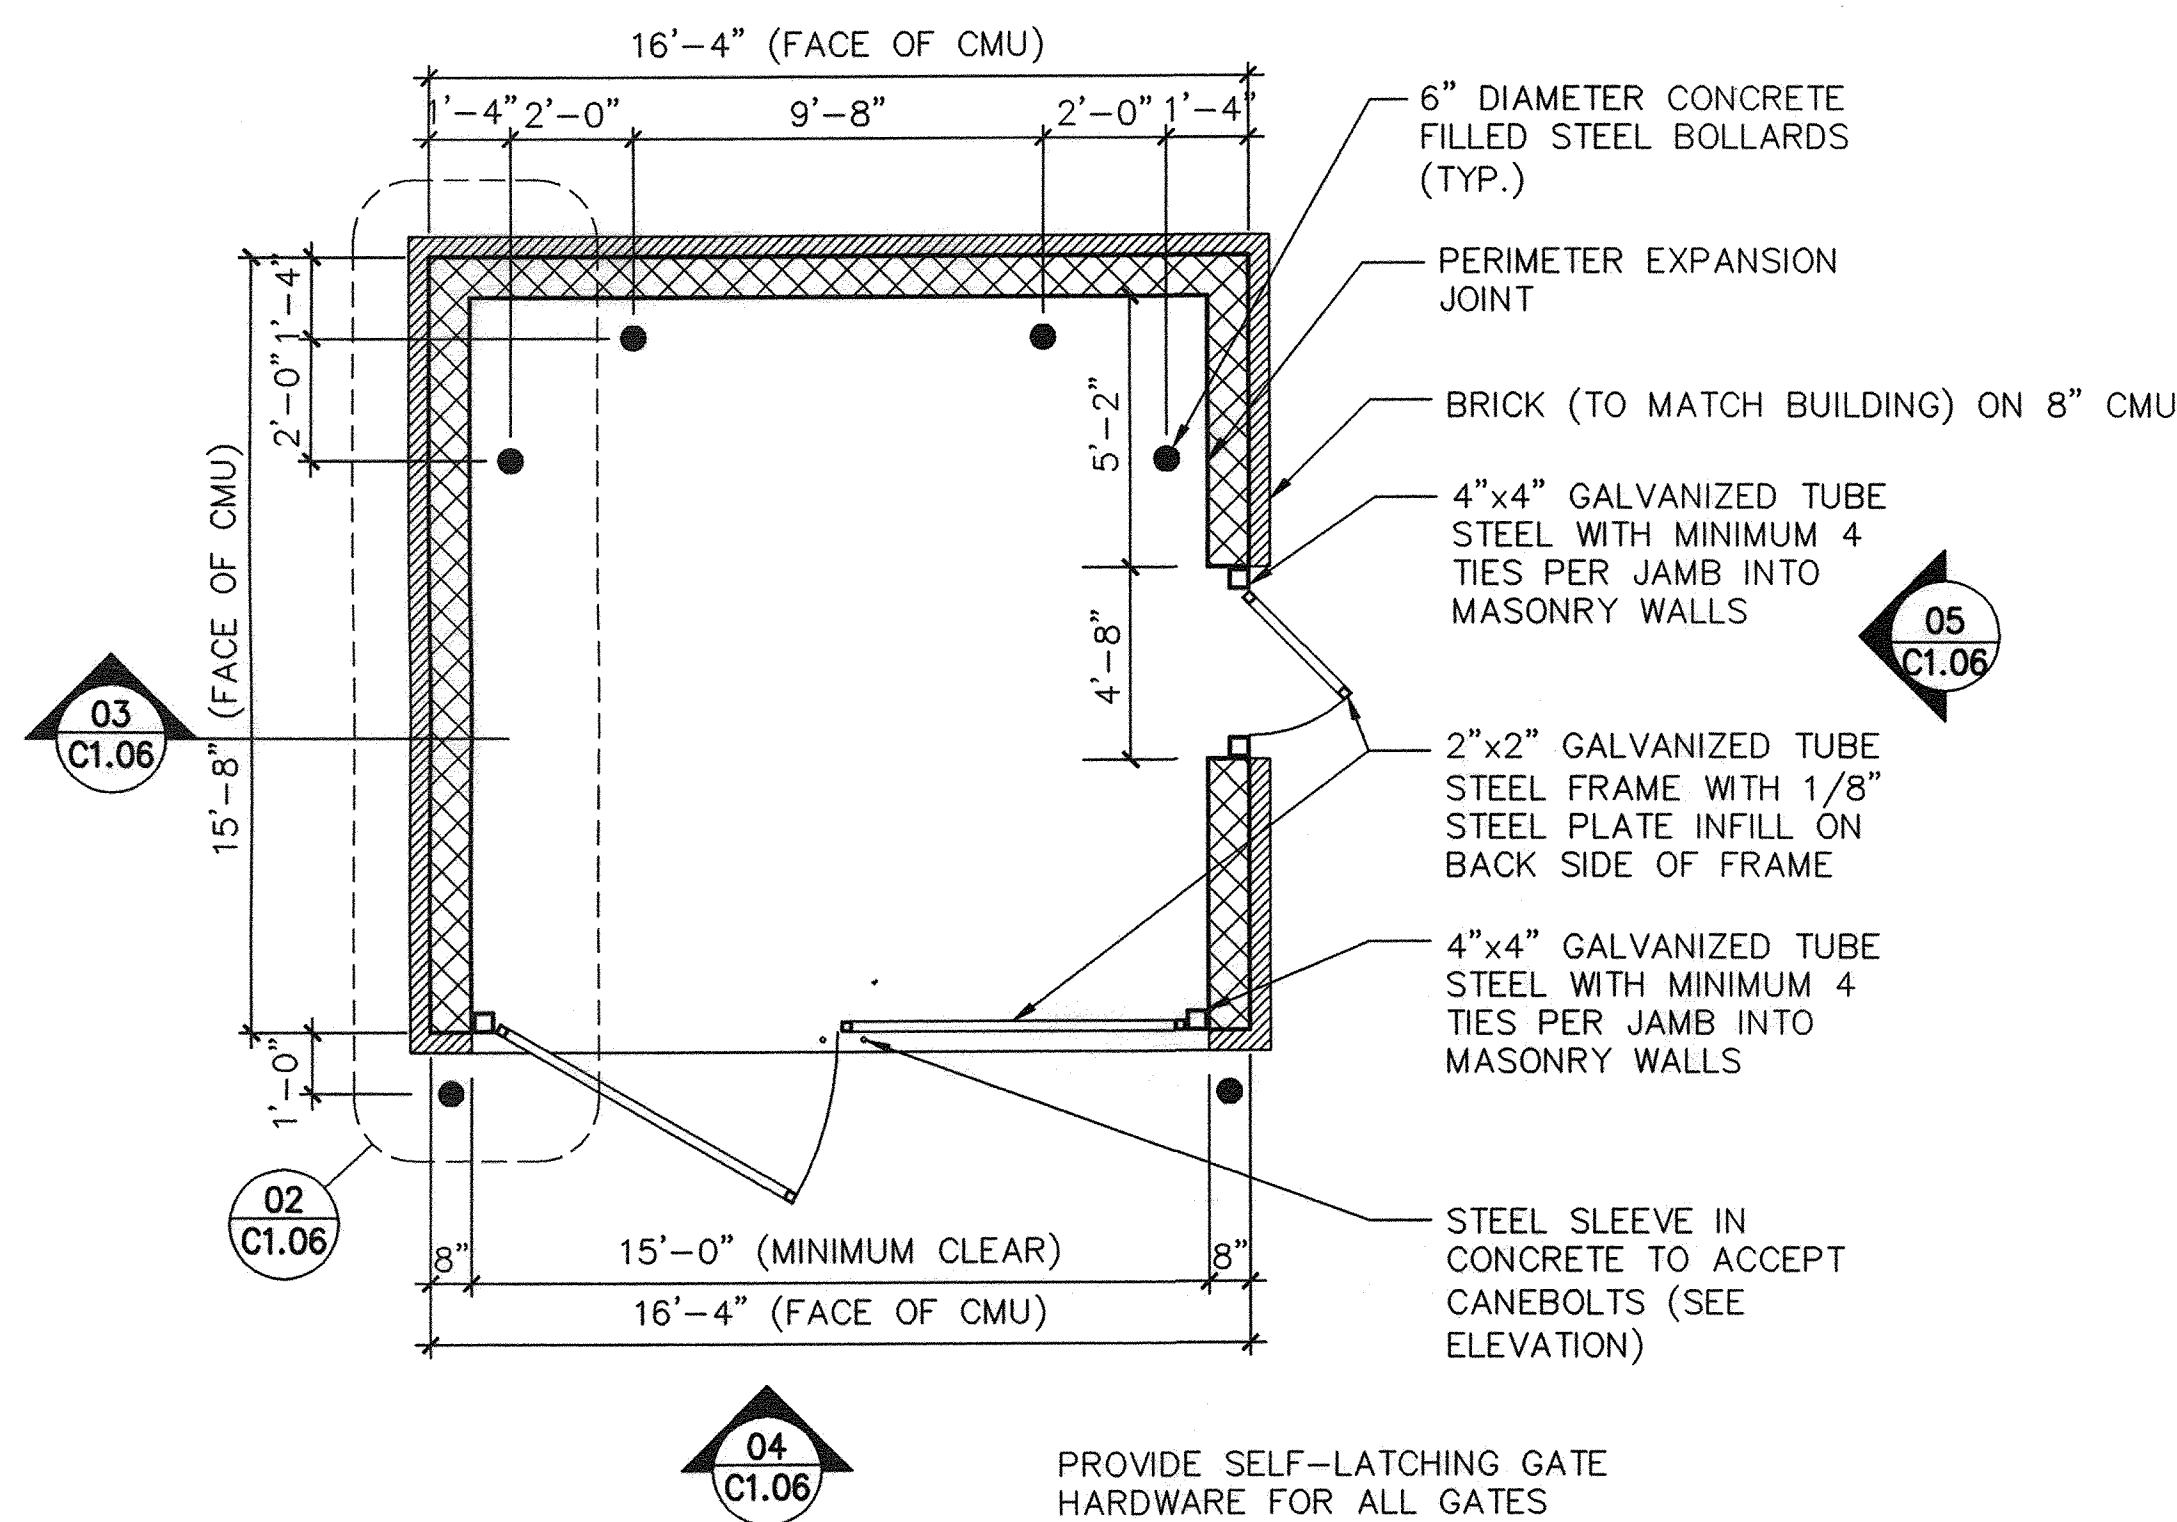

01 DUMPSTER PLAN DETAIL
NOT TO SCALE

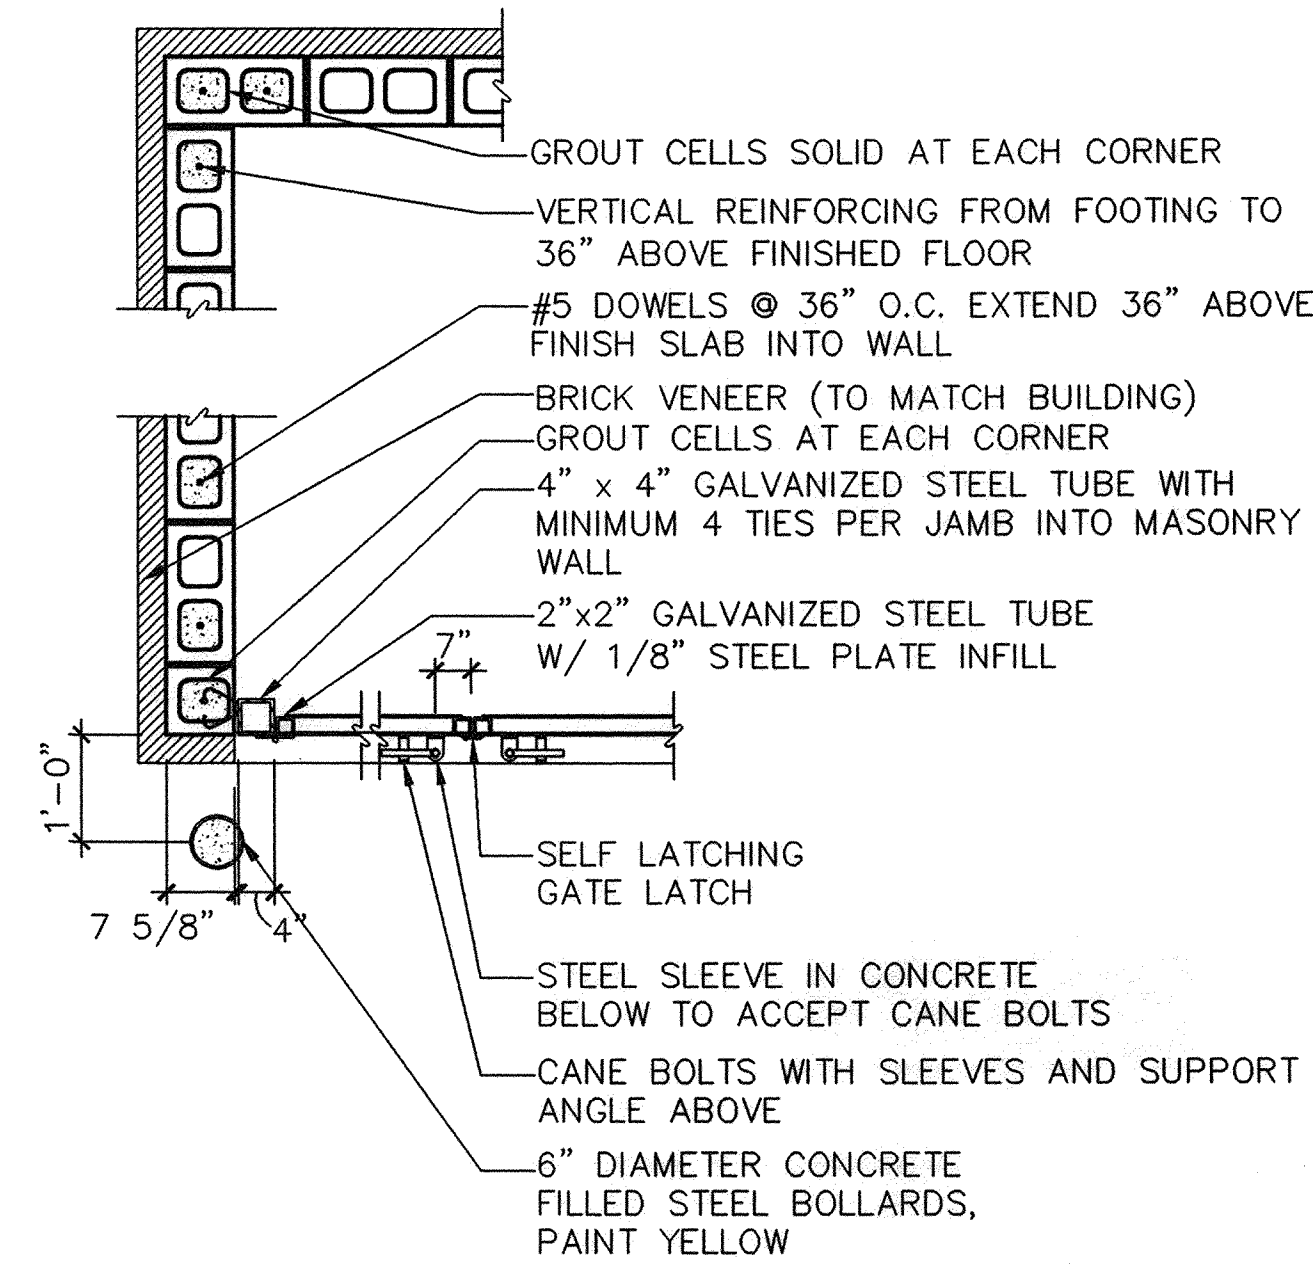


02 DUMPSTER PLAN SECTION DETAIL
NOT TO SCALE

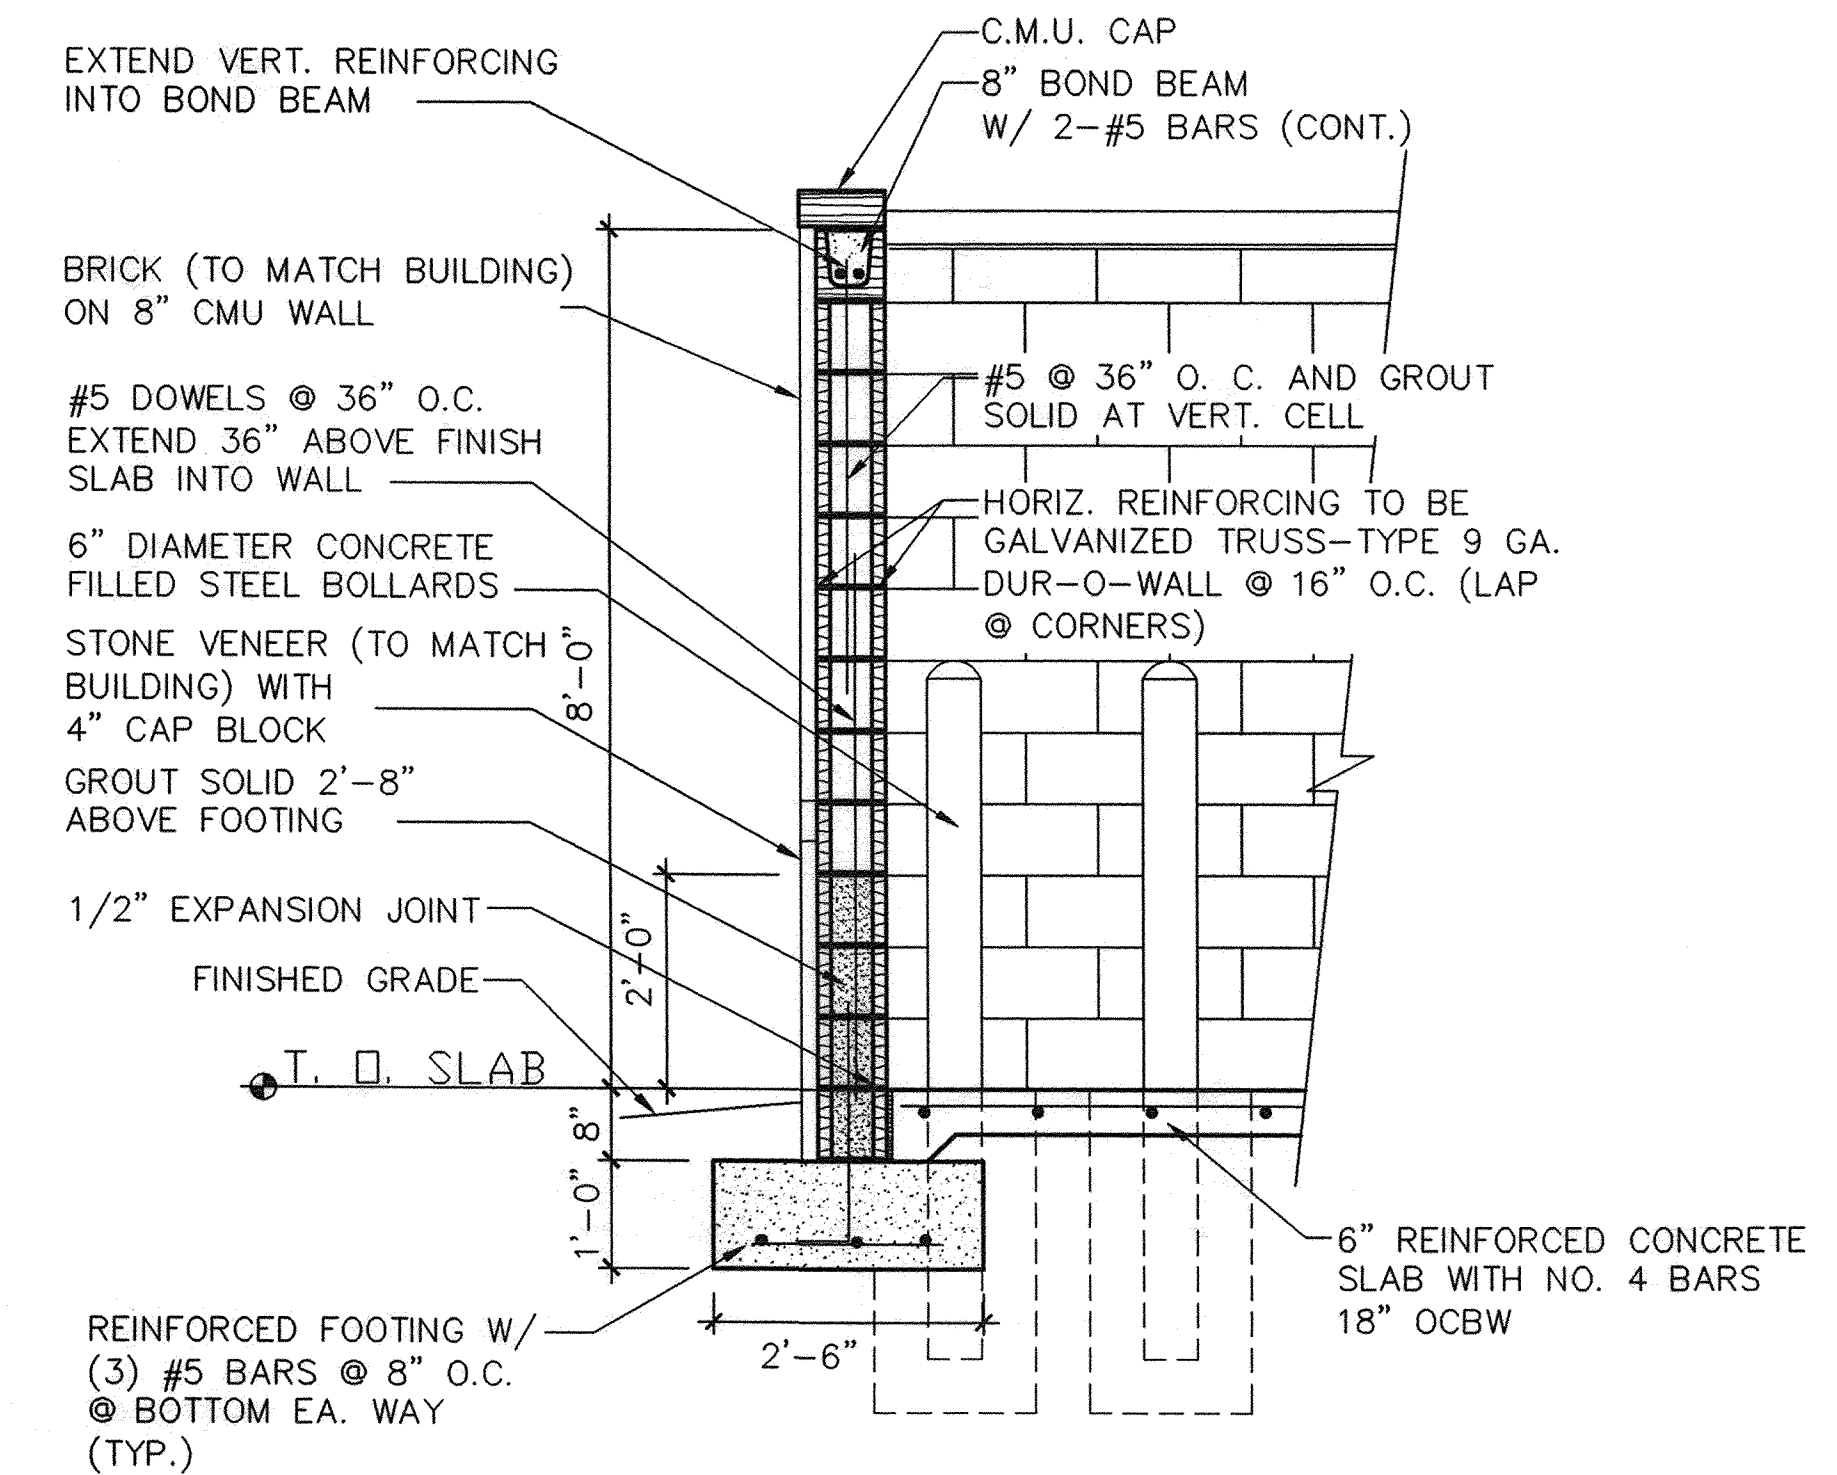


PREPEARE SUBGRADE ACCORDING TO GEOTECH REPORT (TYPICAL)

03 DUMPSTER SECTION DETAIL
NOT TO SCALE

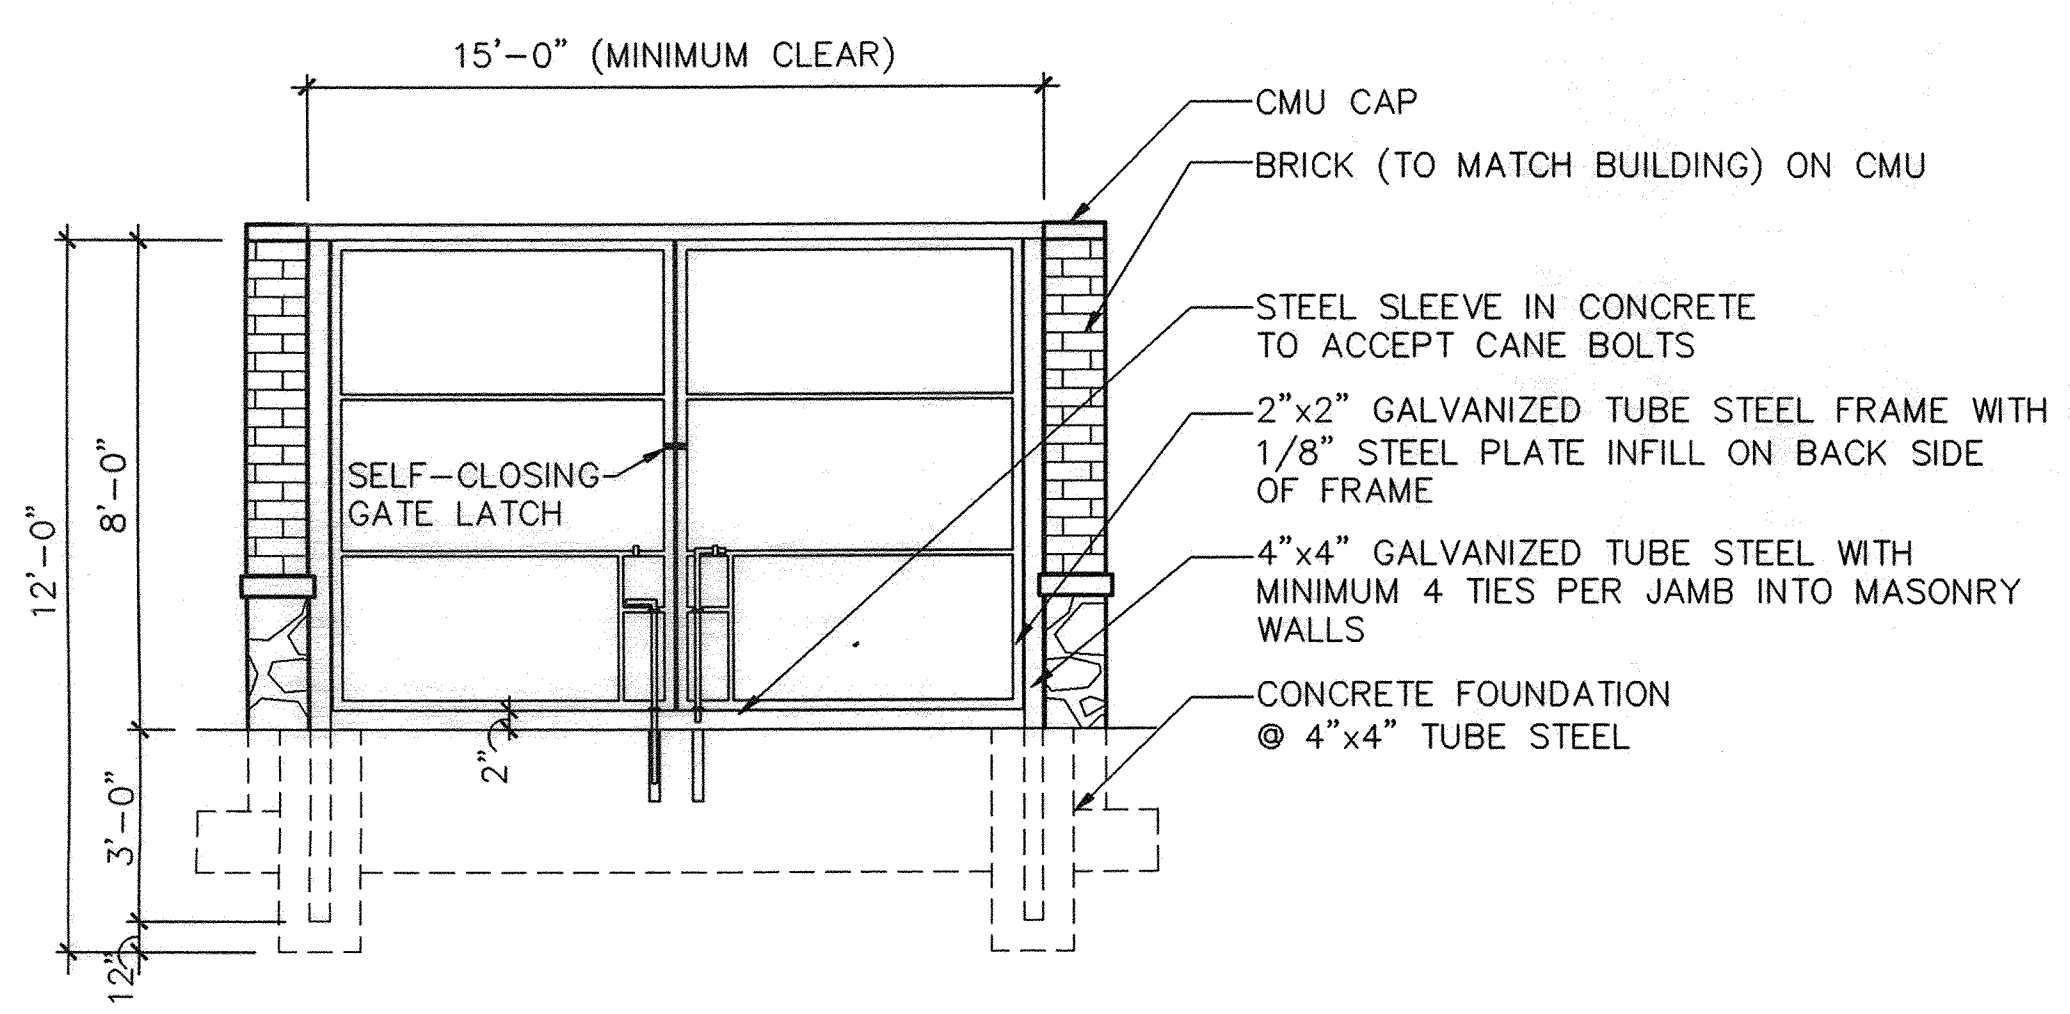

04 DUMPSTER FRONT ELEVATION
NOT TO SCALE

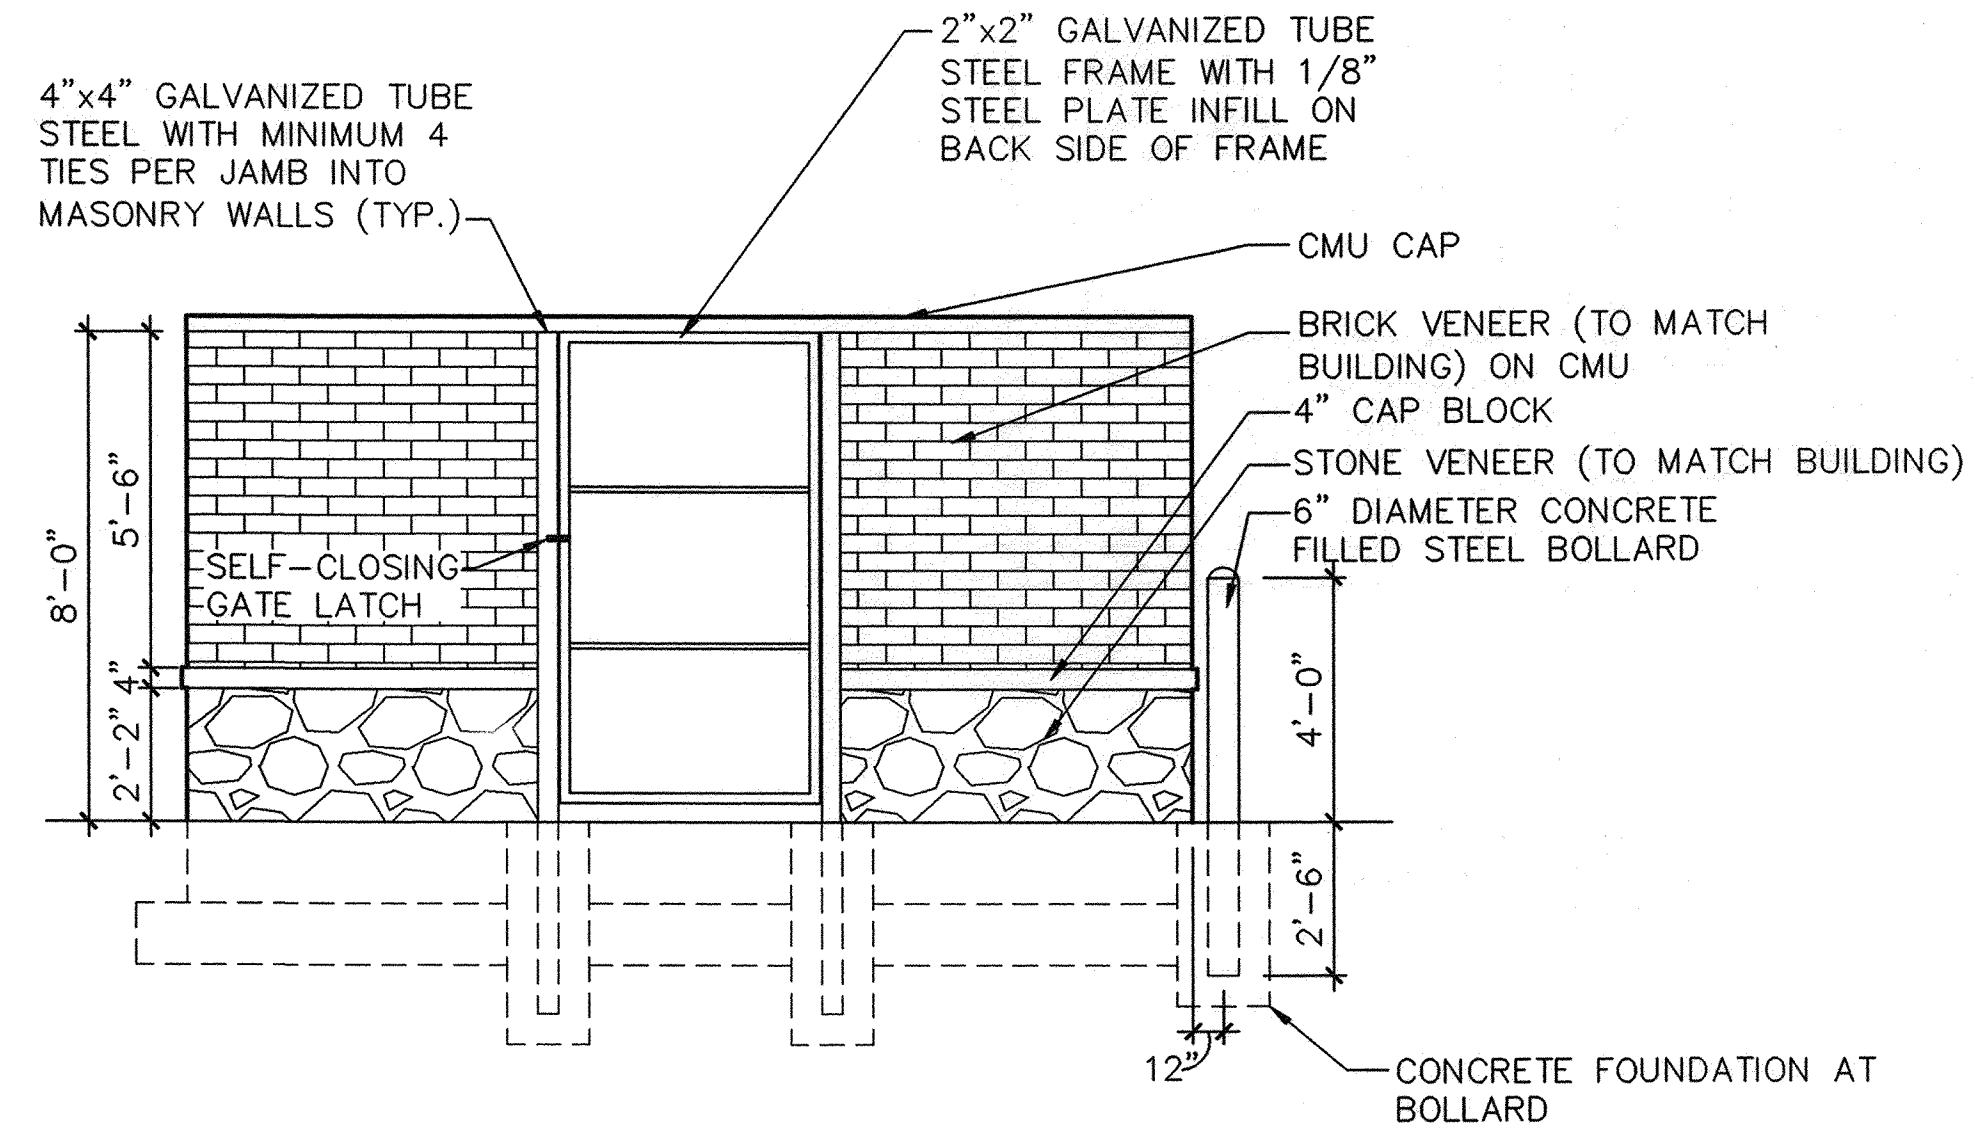

05 DUMPSTER SIDE ELEVATION
NOT TO SCALE

RECORD DRAWINGS:
IT WAS THE INTENT THAT THE IMPROVEMENTS SHOWN BE CONSTRUCTED ACCORDING TO THESE PLANS AS APPROVED BY THE CITY. THE LINES AND GRADES WERE SET ON THE GROUND FOR CONSTRUCTION ACCORDING TO SAID PLANS. THE CITY INSPECTED THE CONSTRUCTION. THE ENGINEER DID NOT VERIFY LINES OR GRADES AFTER CONSTRUCTION. WE ARE NOT AWARE OF ANY CHANGES OR REVISIONS TO THESE PLANS DURING CONSTRUCTION OTHER THAN THOSE SHOWN. DATE: MARCH 4, 2013


DESIGN	DRAWN	DATE	PI NUMBER
AWS	WTW	09-01-2011	1483-11-027

PROJECT INFORMATION
 LAKESIDE REHABILITATION CENTER
 BLOCK C, LOT 6, HORIZON RIDGE MEDICAL PARK
 CITY OF ROCKWALL, TEXAS
 EDWARD TEAL SURVEY, ABSTRACT NO. 207
 PROPOSED USE: NURSING & REHABILITATION CENTER

DEVELOPER
 SMITHERS MERCHANT BUILDERS, LP
 21726 HARDY OAK BOULEVARD
 SAN ANTONIO, TEXAS 78258
 MR. DAVID FRICK
 (210) 479-2500 PHONE
 (210) 479-2507 FAX

THE SEAL APPEARING ON THIS DOCUMENT WAS AUTHORIZED BY ARLYN W. SAMUELSON, P.E. 95871 ON 03-01-2011. ALTERATION OF A SEALED DOCUMENT WITHOUT PROPER NOTIFICATION TO THE RESPONSIBLE ENGINEER IS AN OFFENSE UNDER THE TEXAS ENGINEERING PRACTICE ACT.

Arlyn W. Samuelson 09-01-11

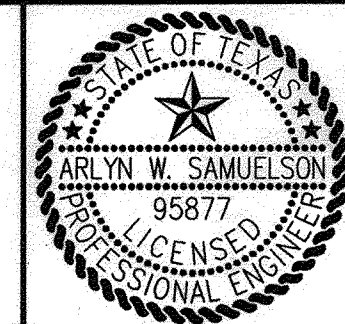

POGUE
 ENGINEERING & DEVELOPMENT COMPANY, INC.
 1512 BRAY CENTRAL DRIVE
 SUITE 100
 MCKINNEY, TEXAS 75069
 (214) 544-8880 PHONE
 (214) 544-8882 FAX
 www.PogueEngineering.com

DUMPSTER DETAILS
 LAKESIDE REHABILITATION CENTER
 BLOCK C, LOT 6, HORIZON RIDGE MEDICAL PARK
 EDWARD TEAL SURVEY, ABSTRACT NO. 207
 CITY OF ROCKWALL, TEXAS

SHEET NO. **C1.06**

LAKESIDE REHABILITATION CENTER
 TEXAS BOARD OF PROFESSIONAL ENGINEERS, CERTIFICATE OF REGISTRATION #--000481, TEXAS BOARD OF PROFESSIONAL LAND SURVEYING, CERTIFICATE OF REGISTRATION 100421-00