



SKILLED NURSING - ROCKWALL
HORIZON RIDGE MEDICAL ADDITION

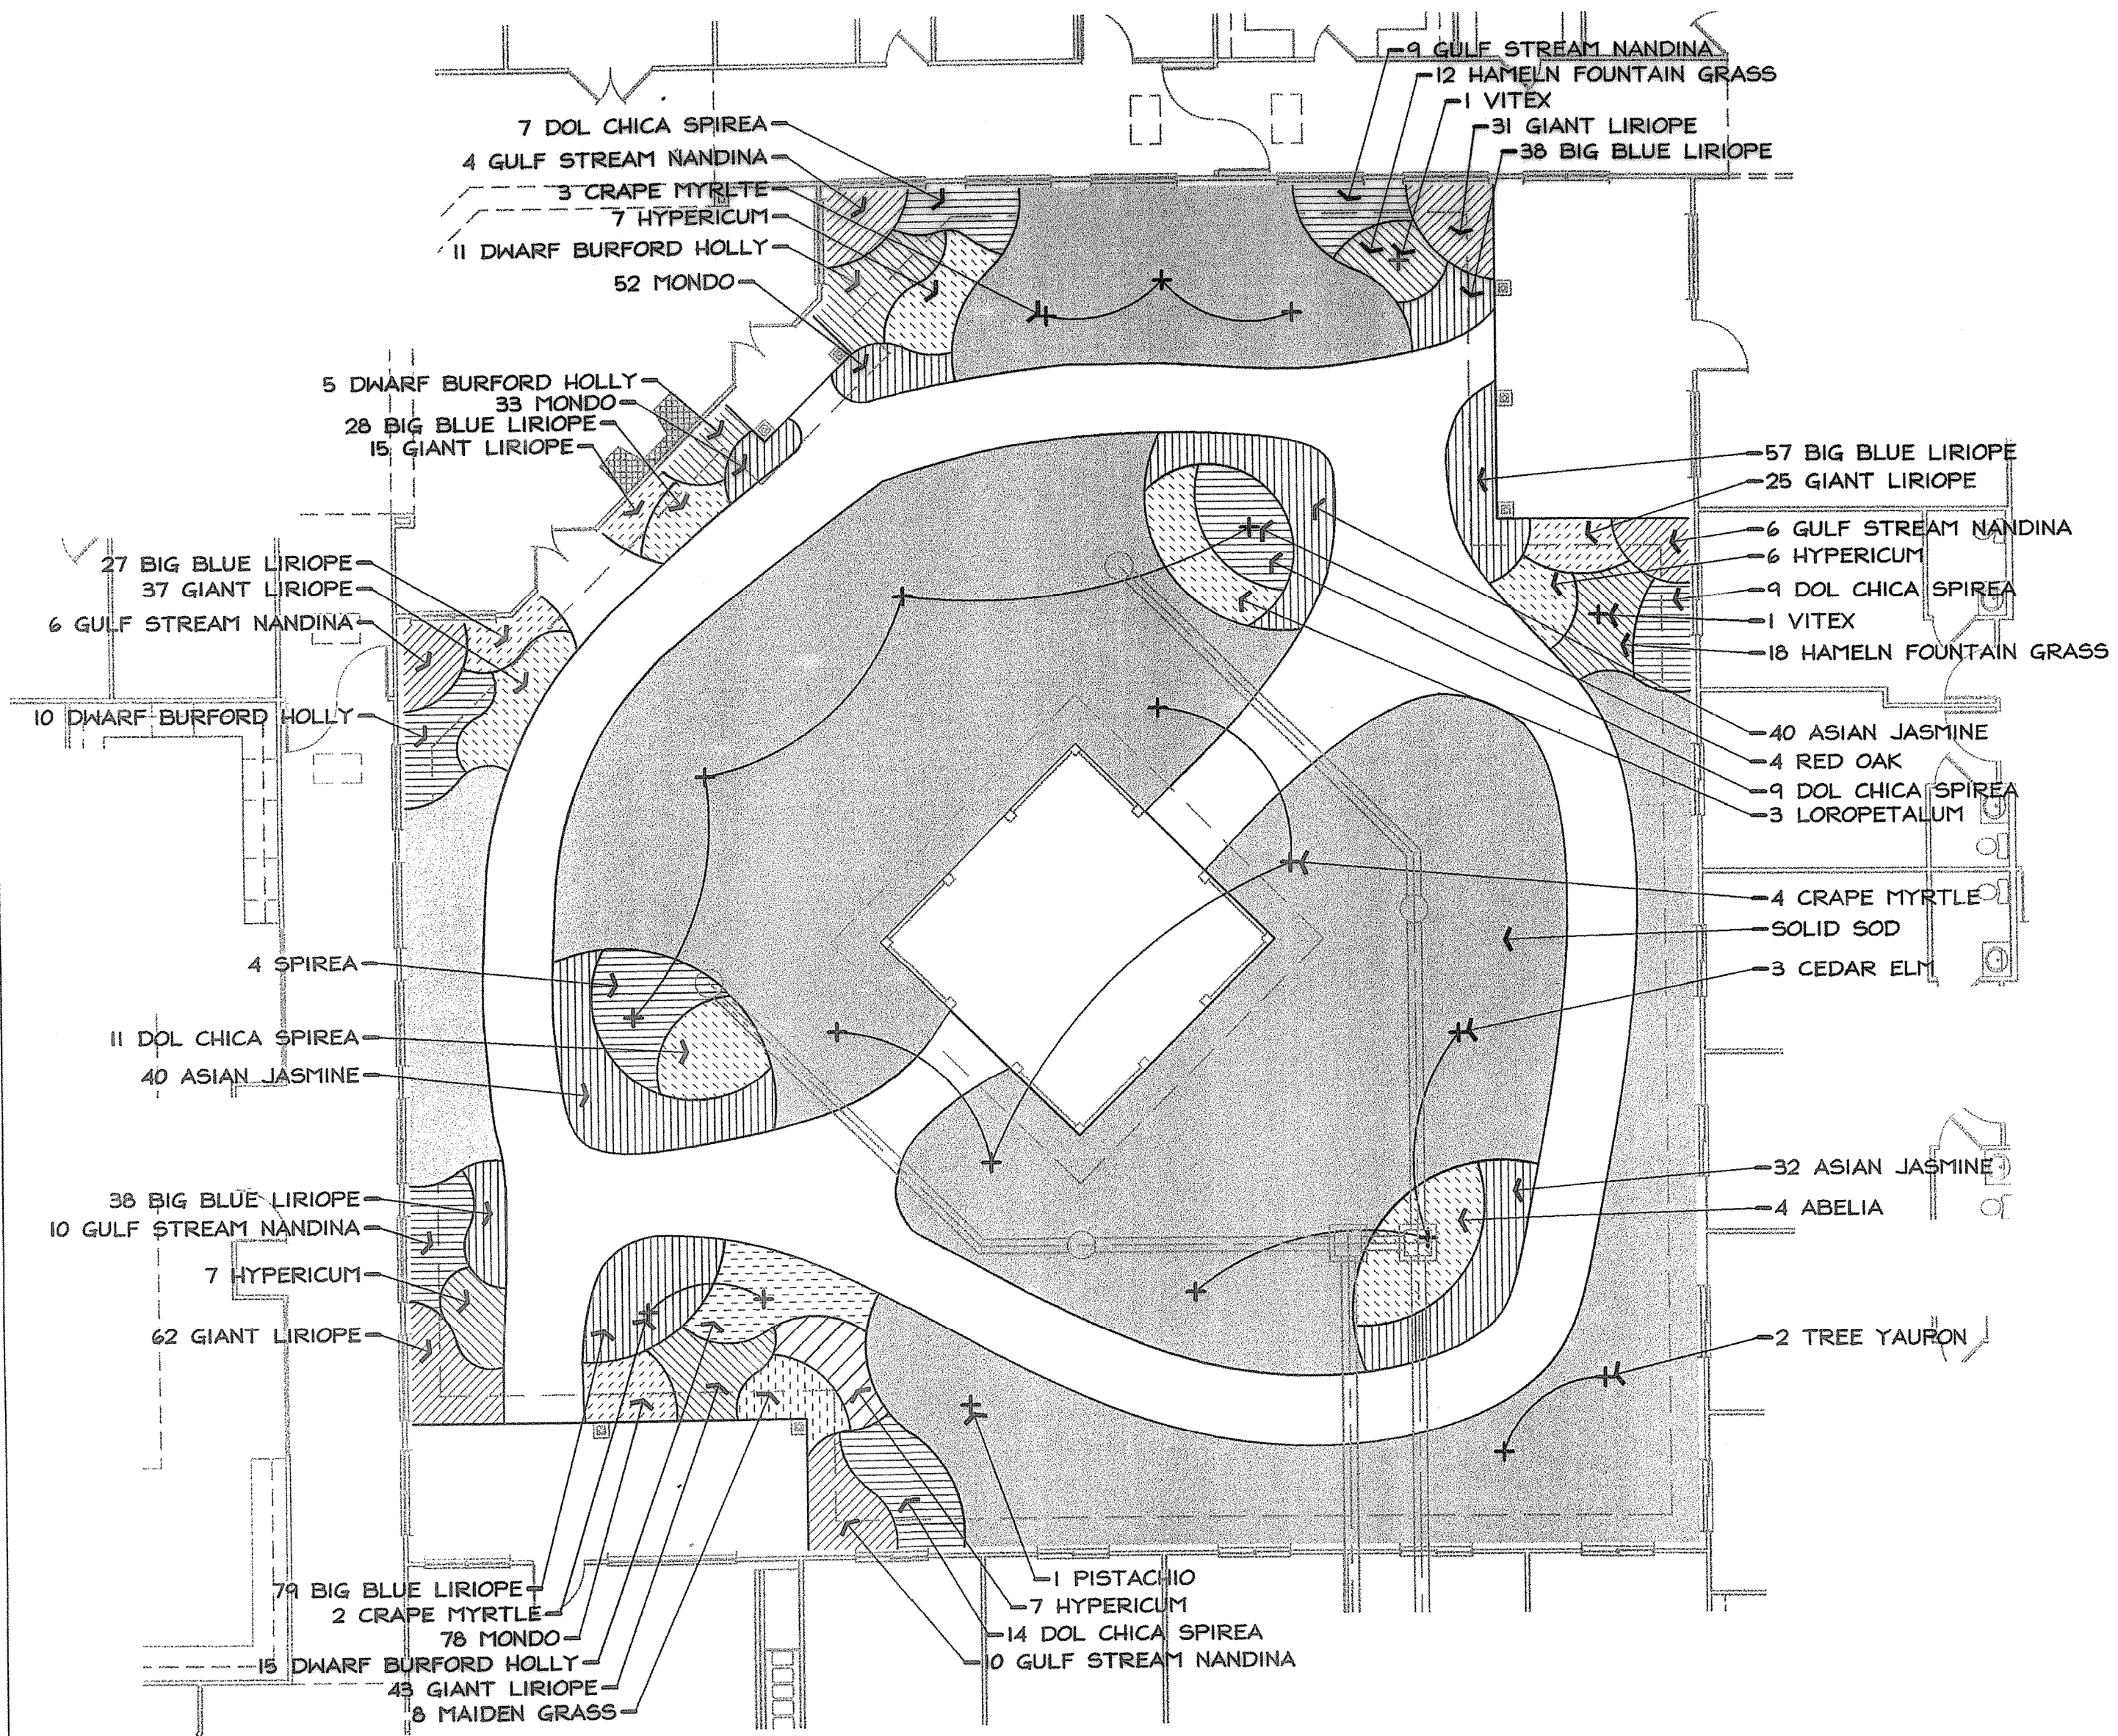


A ENLARGED COURTYARD LANDSCAPE PLAN

1" = 10'-0" 0 5 10 20'

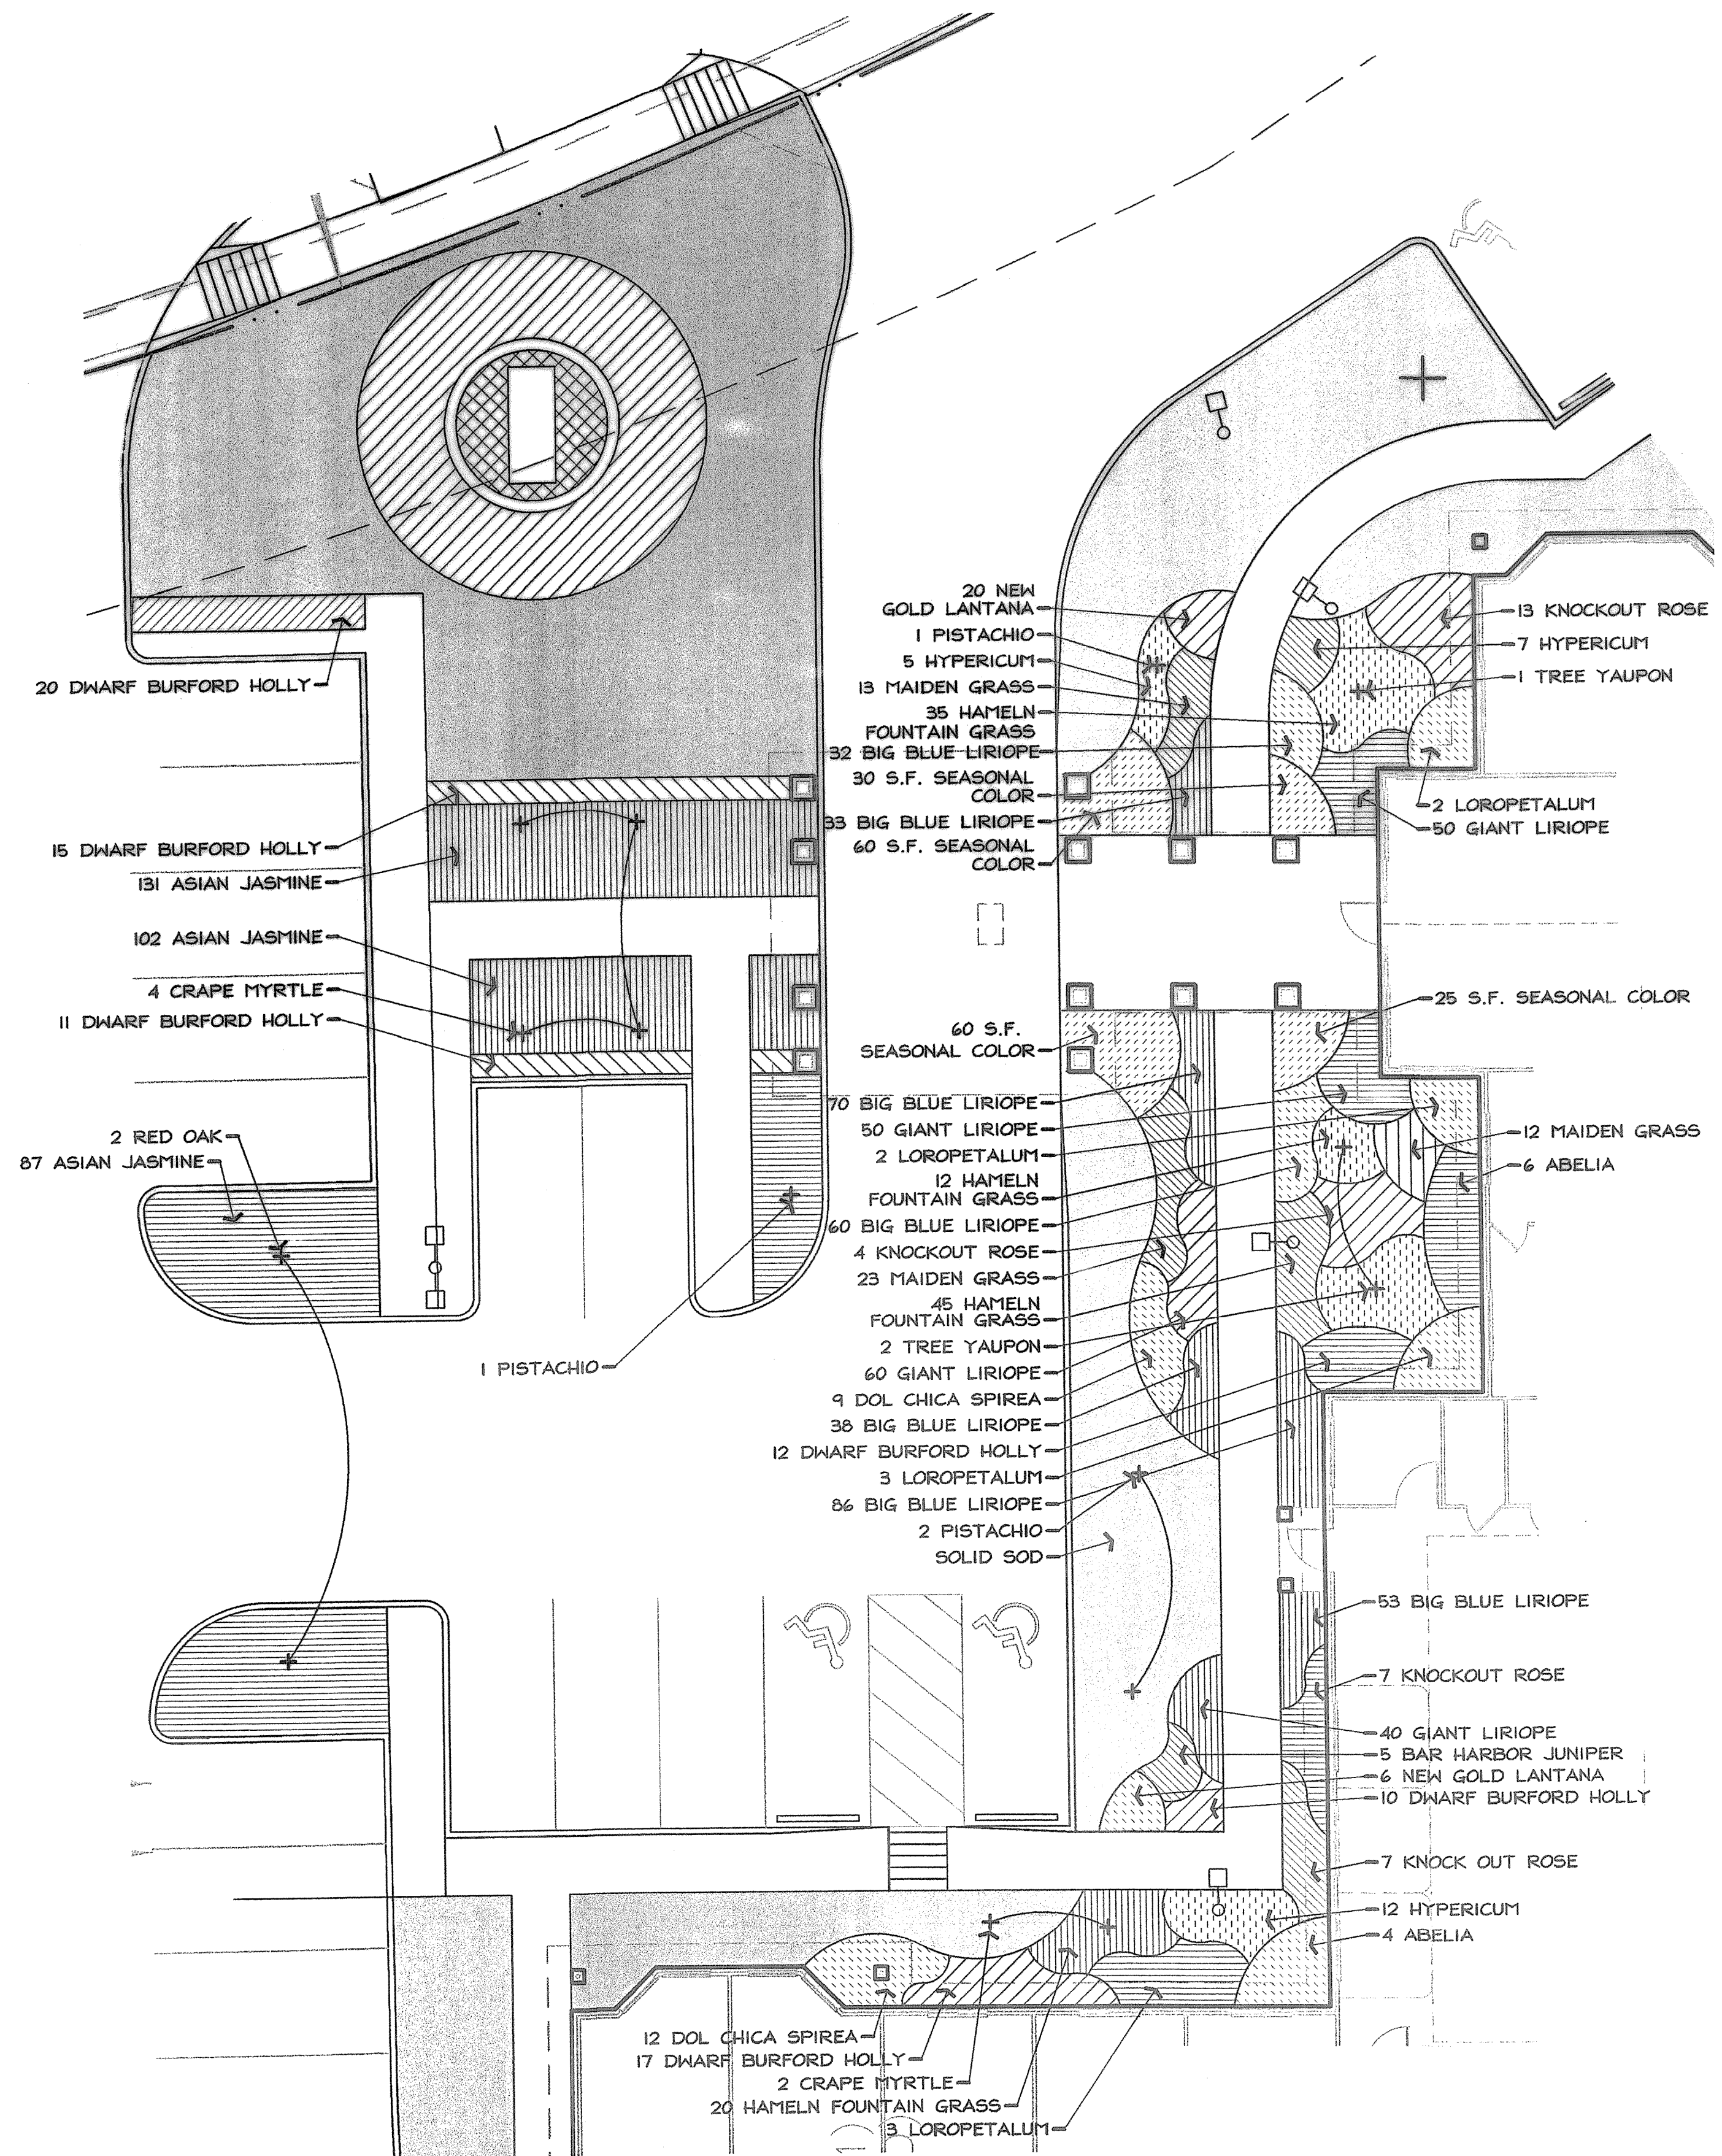

A ENLARGED MAIN ENTRY LANDSCAPE PLAN

1" = 10'-0" 0 5 10 20'

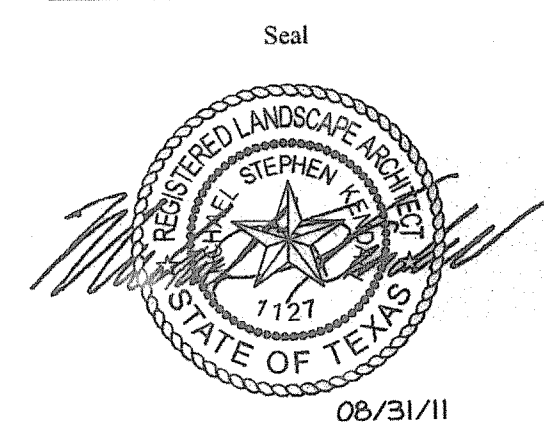

Revisions

Issue Date

31 AUGUST, 2011

Sheet Name

Enlarged Landscape Plans

Sheet Number

L1.2