


SCALE:
 1" = 40' HORIZONTAL
 1" = 6' VERTICAL

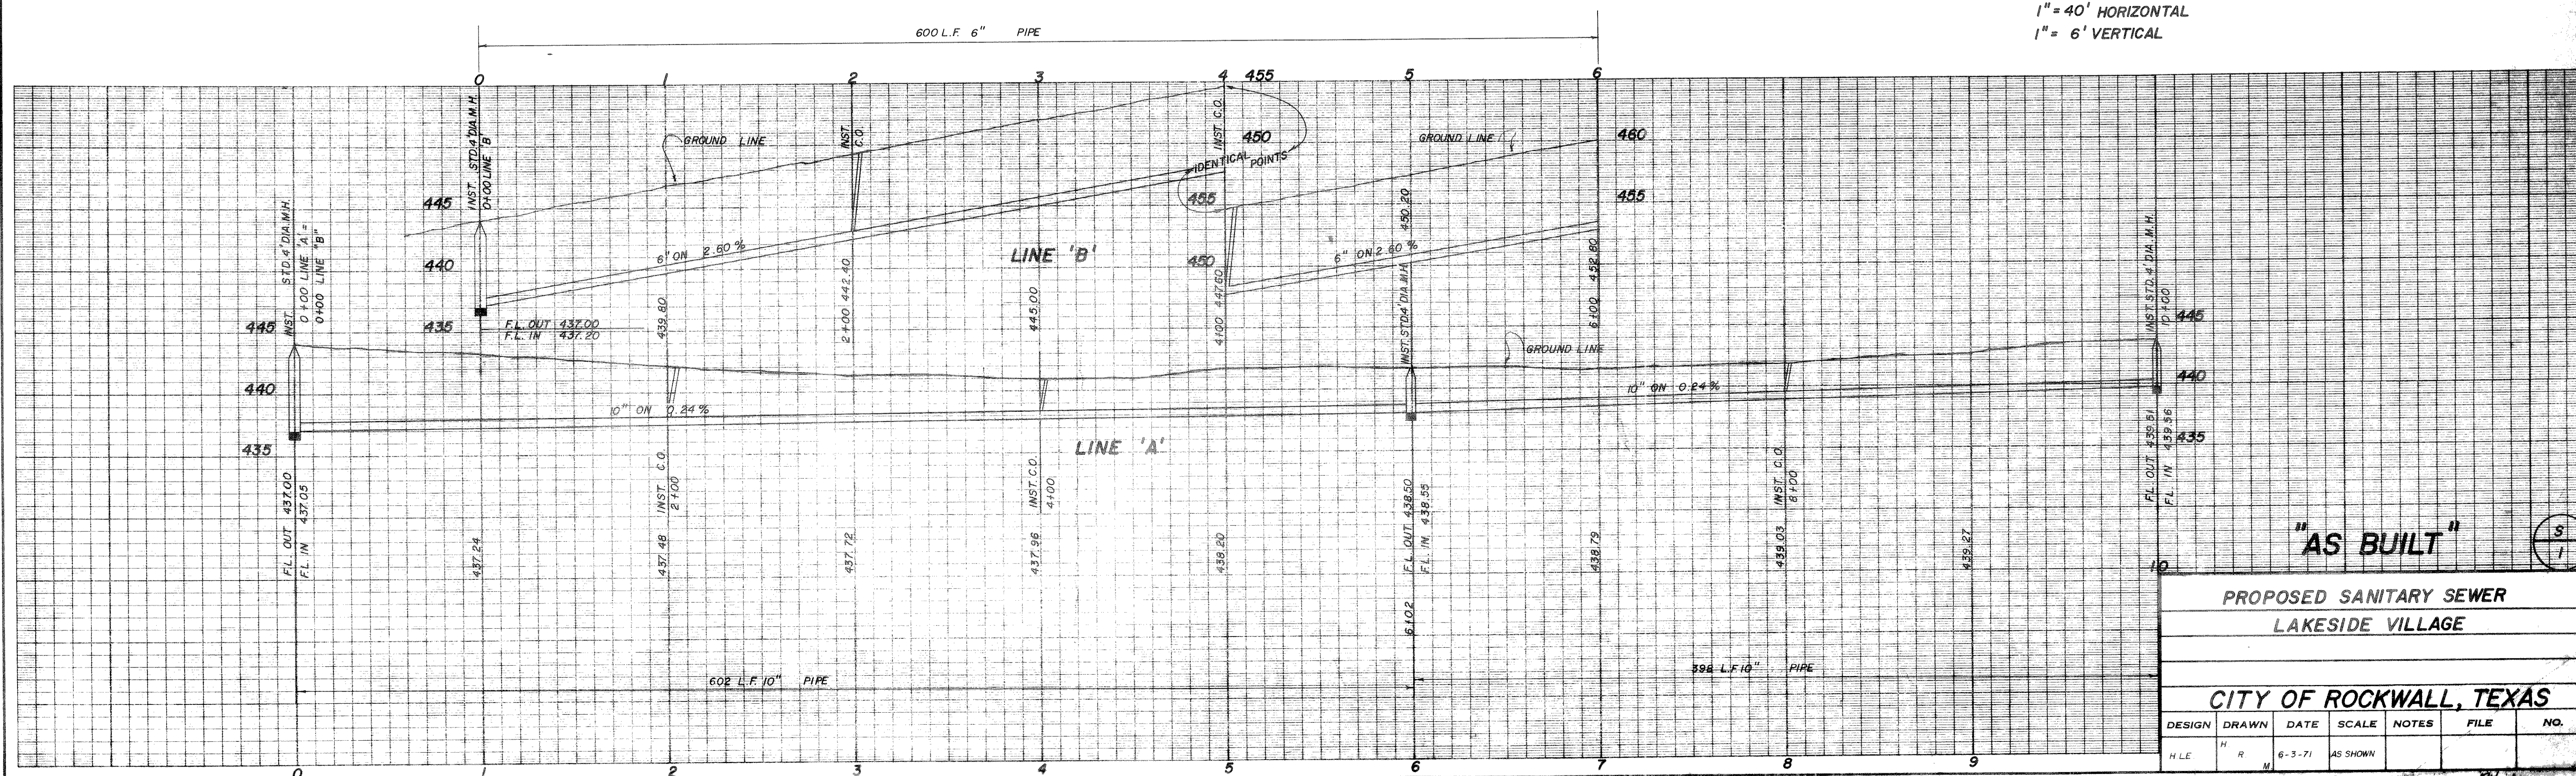

"AS BUILT"

PROPOSED SANITARY SEWER
 LAKESIDE VILLAGE

CITY OF ROCKWALL, TEXAS

DESIGN	DRAWN	DATE	SCALE	NOTES	FILE	NO.
H.L.E.	R.M.	6-3-71	AS SHOWN			

