


SCALE: 1" = 40' HORIZONTAL
1" = 6' VERTICAL

NOTE:
1. ALL LOTS SHOWN ON S/3 ARE 15'x54'
2. SINGLE SERVICES ARE LOCATED IN CENTER OF LOT FOR 15' WIDE LOT, 7.5' FROM EACH CORNER
3. DOUBLE SERVICES ARE LOCATED AT LOT CORNER

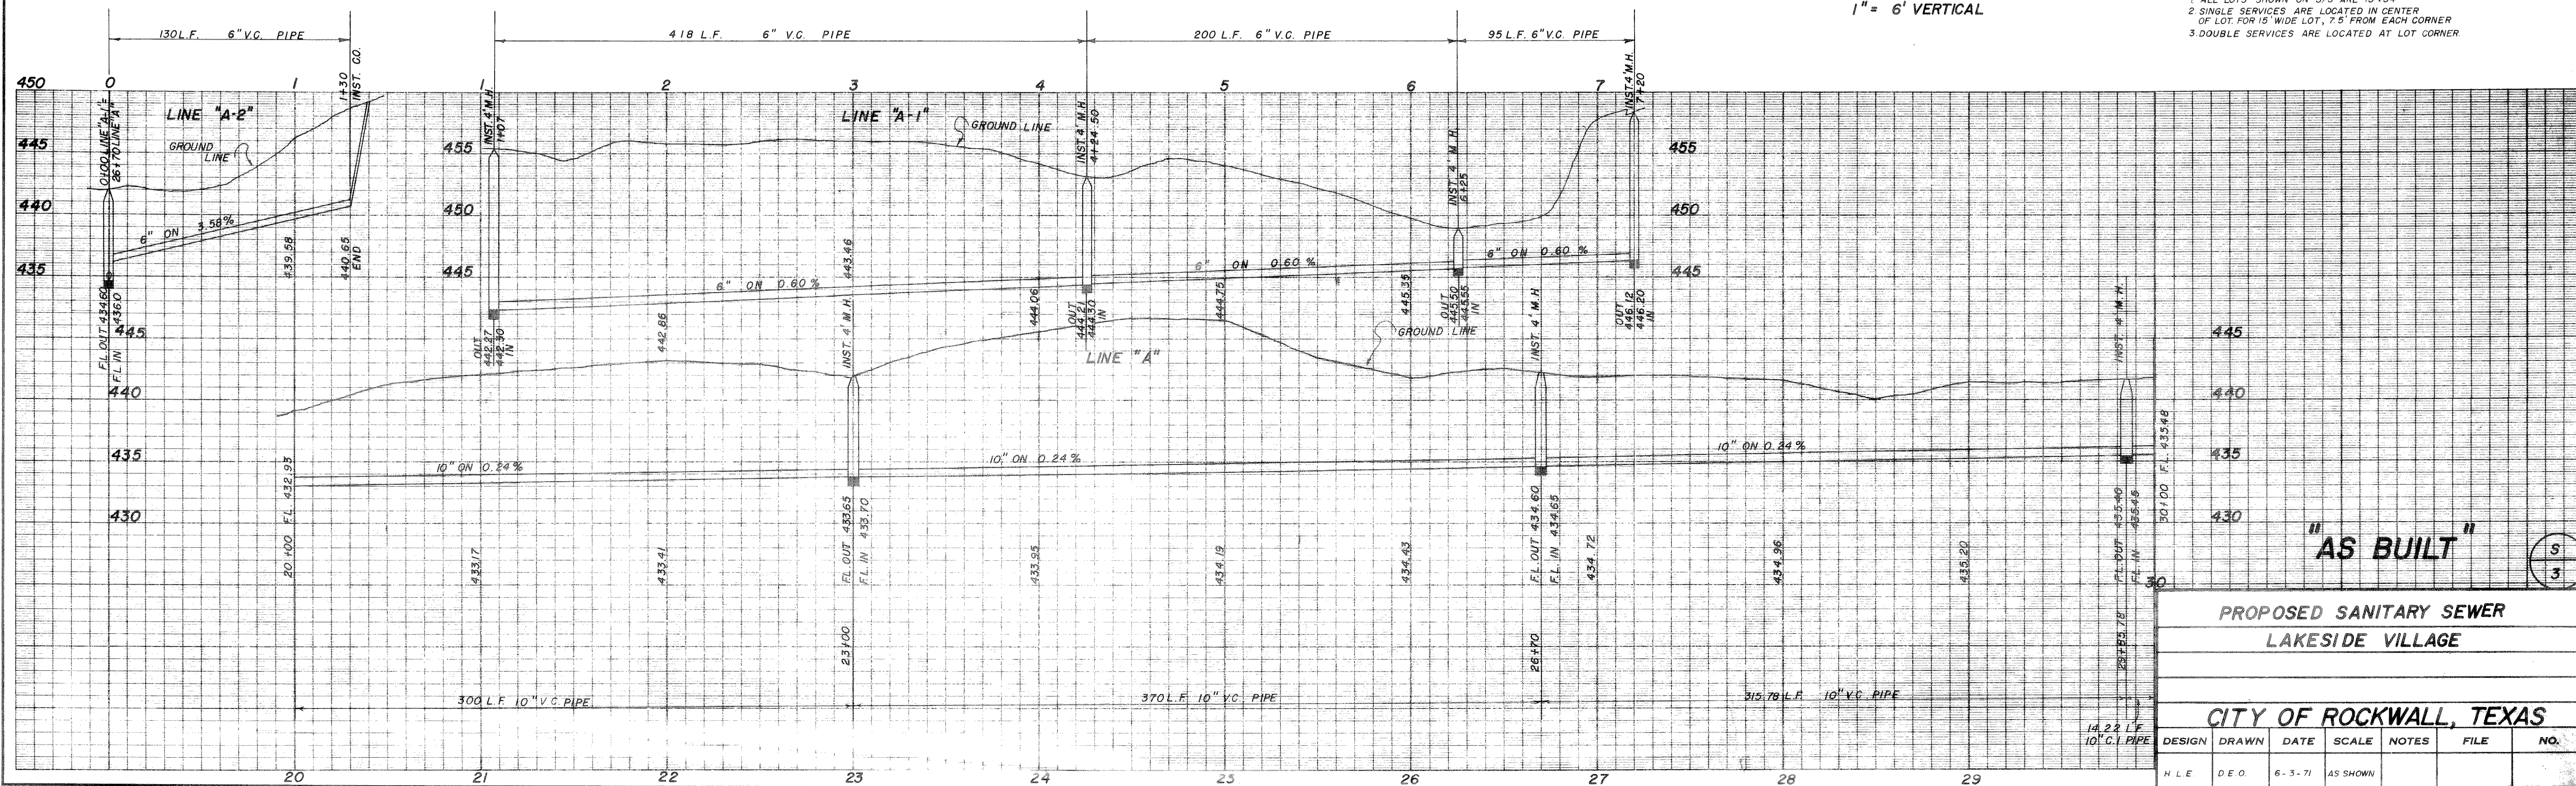

"AS BUILT"

PROPOSED SANITARY SEWER
LAKESIDE VILLAGE

CITY OF ROCKWALL, TEXAS

DESIGN	DRAWN	DATE	SCALE	NOTES	FILE	NO.
H L E	D E O	6-3-71	AS SHOWN			