
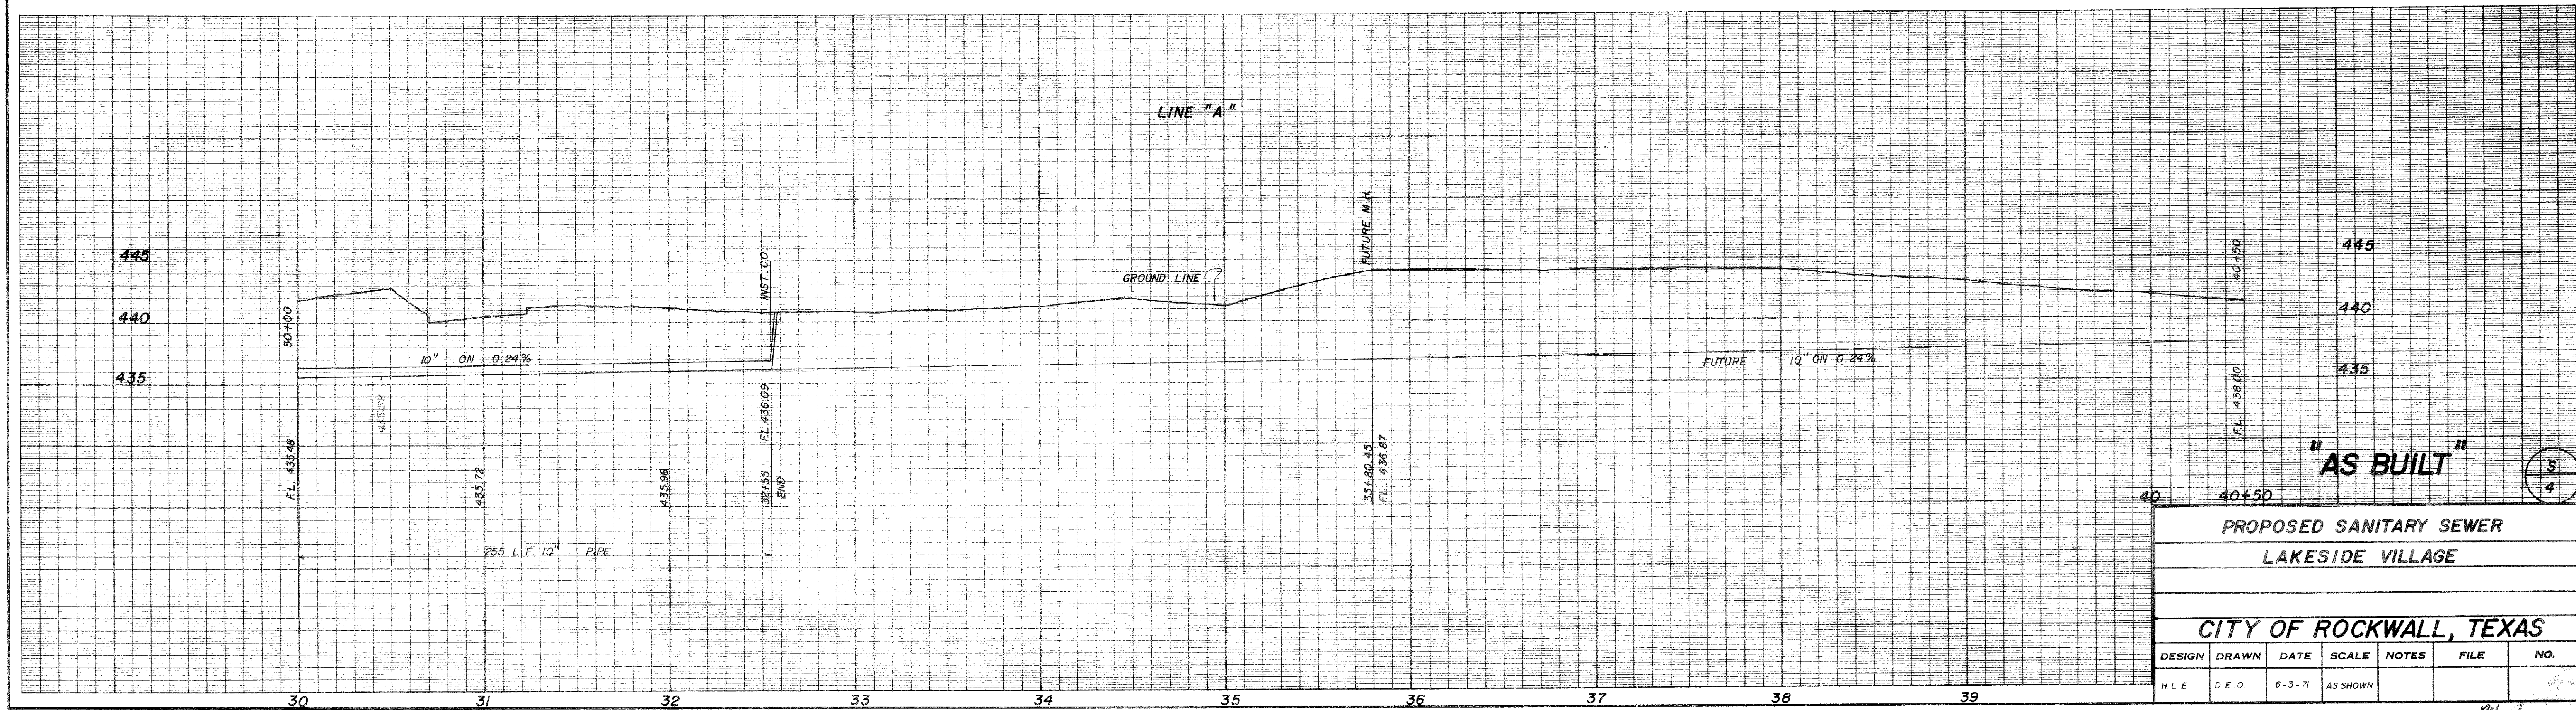


NOTE: SEWER SERVICE FOR MARINA

NOTE:
 1. ALL LOTS SHOWN ON S/3 ARE 15'x54'
 2. SINGLE SERVICES ARE LOCATED IN CENTER OF LOT. FOR 18' WIDE LOT, 7.5' FROM EACH CORNER.
 3. DOUBLE SERVICES ARE LOCATED AT LOT CORNER

SCALE: 1" = 40' HORIZONTAL
 1" = 6' VERTICAL

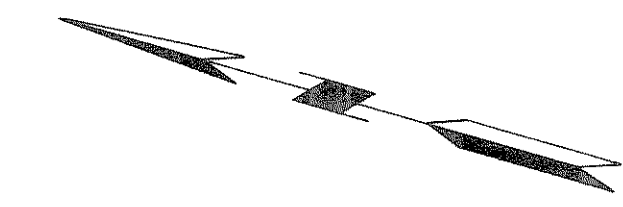

"AS BUILT"

PROPOSED SANITARY SEWER						
LAKESIDE VILLAGE						
CITY OF ROCKWALL, TEXAS						
DESIGN	DRAWN	DATE	SCALE	NOTES	FILE	NO.
HLE	DEO	6-3-71	AS SHOWN			